



CONSTRUCTION SUMMARY

Lot: 70
Model: 50-12 A WILLOWCREEK
Project/Phase: Pine Valley Forevergreen (2) / 2

FORMING

Invoice	Qty.	Description
3005 164,628 29Sep23	1	BASEMENT: S/I BACK -FLOW PREVENTER VALVE (BASEMENT)

WINDOWS - BASEMENT

Invoice	Qty.	Description
3005 164,734 29Sep23	3	BASEMENT: S/I BASEMENT WINDOW SIZE 30" X 24" IN LIEU OF STANDARD - 10" WHITE. WINDOW WELLS MAY BE REQUIRED. 50'S & 60'S


SCHEDULE 'F'



PV2-70
SEPT 26 2022

The
Willowcreek
EAGLE'S RIDGE COLLECTION

- Elevation A - 4,647 sq.ft.
4,907 sq.ft. Opt. Elevator
Plus 361 sq.ft. Fin. Basement Foyer Opt. Elevator Plan
Plus 102 sq.ft. Fin. Basement Foyer
- Elevation B - 4,637 sq.ft.
4,896 sq.ft. Opt. Elevator
Plus 361 sq.ft. Fin. Basement Foyer Opt. Elevator Plan
Plus 102 sq.ft. Fin. Basement Foyer
- Elevation C - 4,627 sq.ft.
4,887 sq.ft. Opt. Elevator
Plus 361 sq.ft. Fin. Basement Foyer Opt. Elevator Plan
Plus 102 sq.ft. Fin. Basement Foyer

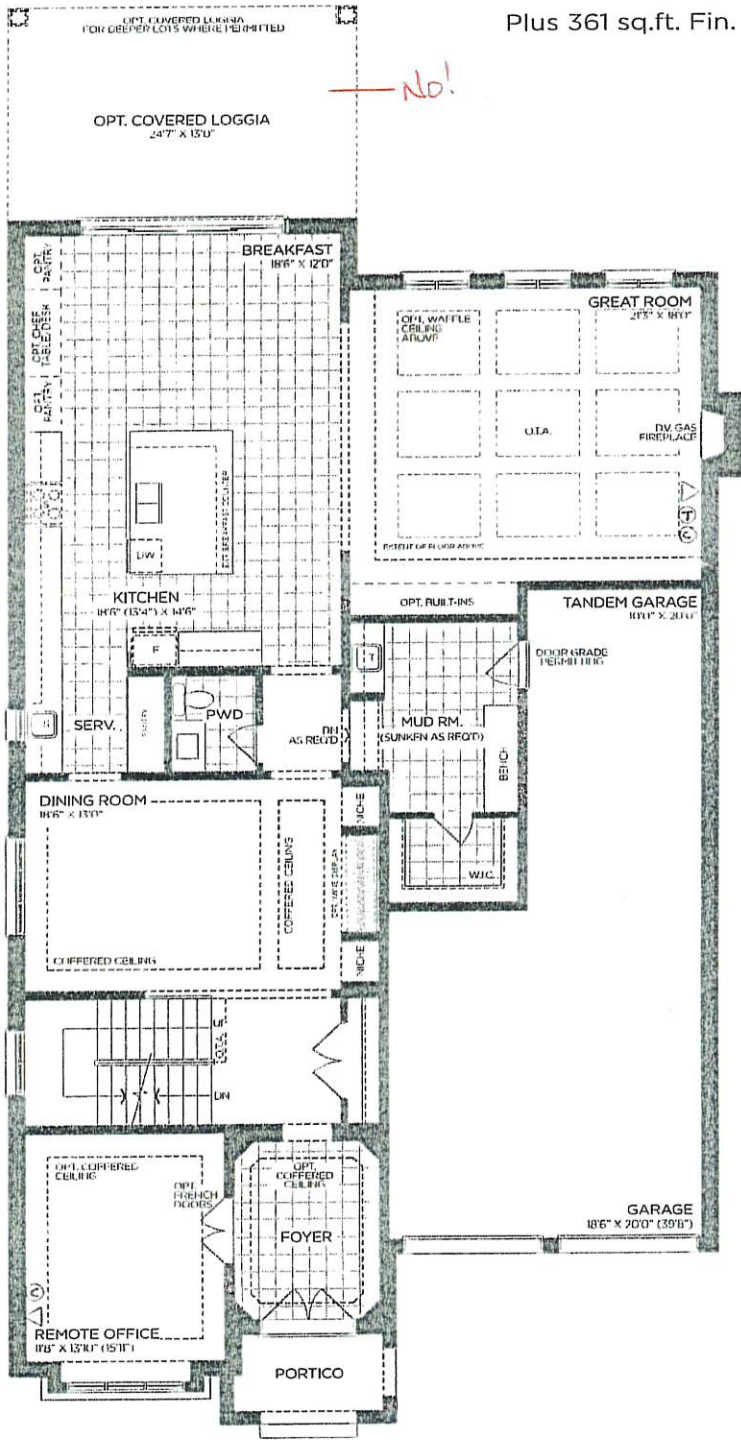

GROUND FLOOR | ELEV. A

VENDOR

PURCHASER

PURCHASER

GOLD PARK
WORTH MORE™

Prices, figures, illustrations, sizes, features and finishes are subject to change without notice. Areas and dimensions are approximate and actual usable floor space may vary from the stated area. Layout may be reverse of the unit purchased. E. & O.E. 5012


SCHEDULE 'F'

FV2-70
SEPT 26 2022



The
Willowcreek
EAGLE'S RIDGE COLLECTION

- ➡ Elevation A - 4,647 sq.ft.
4,907 sq.ft. Opt. Elevator
Plus 361 sq.ft. Fin. Basement Foyer Opt. Elevator Plan
Plus 102 sq.ft. Fin. Basement Foyer
- Elevation B - 4,637 sq.ft.
4,896 sq.ft. Opt. Elevator
Plus 361 sq.ft. Fin. Basement Foyer Opt. Elevator Plan
Plus 102 sq.ft. Fin. Basement Foyer
- Elevation C - 4,627 sq.ft.
4,887 sq.ft. Opt. Elevator
Plus 361 sq.ft. Fin. Basement Foyer Opt. Elevator Plan
Plus 102 sq.ft. Fin. Basement Foyer

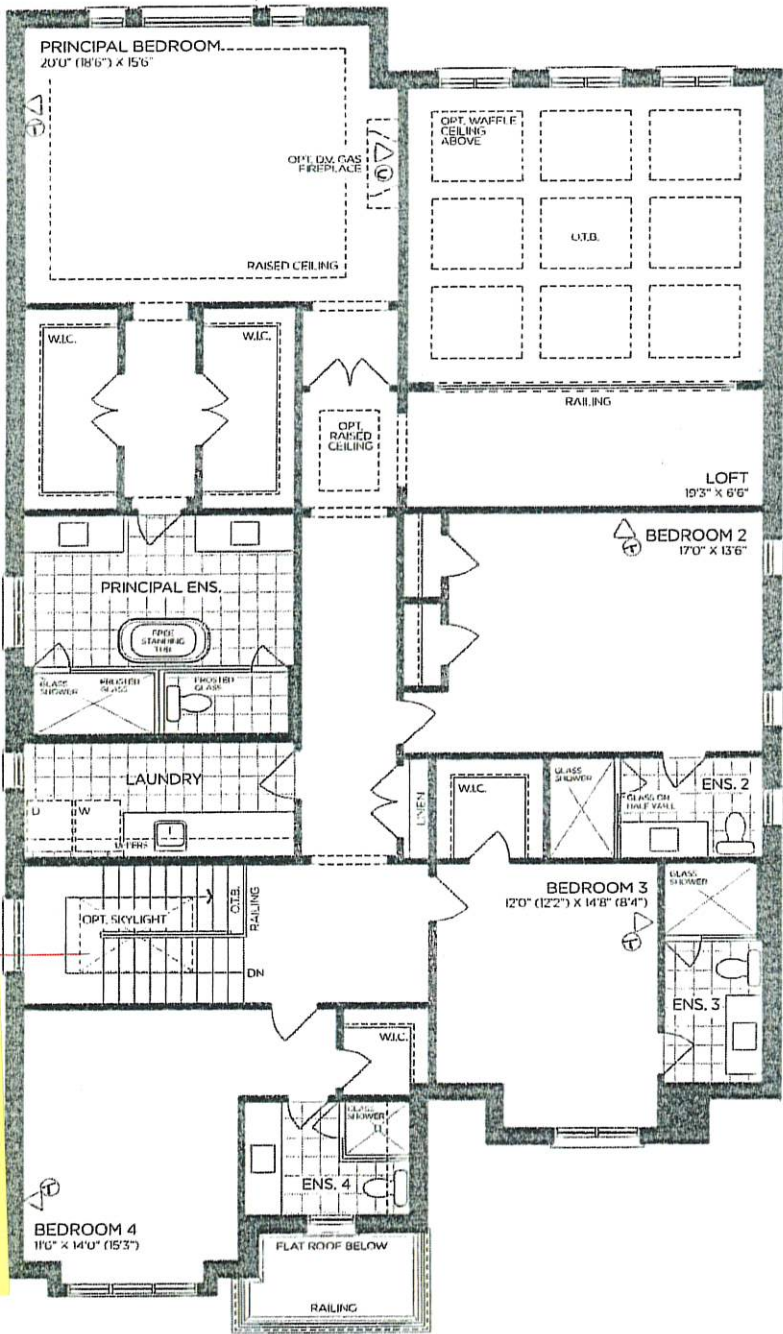

SECOND FLOOR | ELEV. A

VENDOR

PURCHASER

PURCHASER

GOLD PARK
WORTH MORE™

Prices, figures, illustrations, sizes, features and finishes are subject to change without notice. Areas and dimensions are approximate and actual usable floor space may vary from the stated area. Layout may be reverse of the unit purchased. E. & O.E. 5012


SCHEDULE 'F'

PVZ-70
SEPT 26 2022



The Willowcreek
EAGLE'S RIDGE COLLECTION

- Elevation A - 4,647 sq.ft.
4,907 sq.ft. Opt. Elevator
Plus 361 sq.ft. Fin. Basement Foyer Opt. Elevator Plan
Plus 102 sq.ft. Fin. Basement Foyer
- Elevation B - 4,637 sq.ft.
4,896 sq.ft. Opt. Elevator
Plus 361 sq.ft. Fin. Basement Foyer Opt. Elevator Plan
Plus 102 sq.ft. Fin. Basement Foyer
- Elevation C - 4,627 sq.ft.
4,887 sq.ft. Opt. Elevator
Plus 361 sq.ft. Fin. Basement Foyer Opt. Elevator Plan
Plus 102 sq.ft. Fin. Basement Foyer

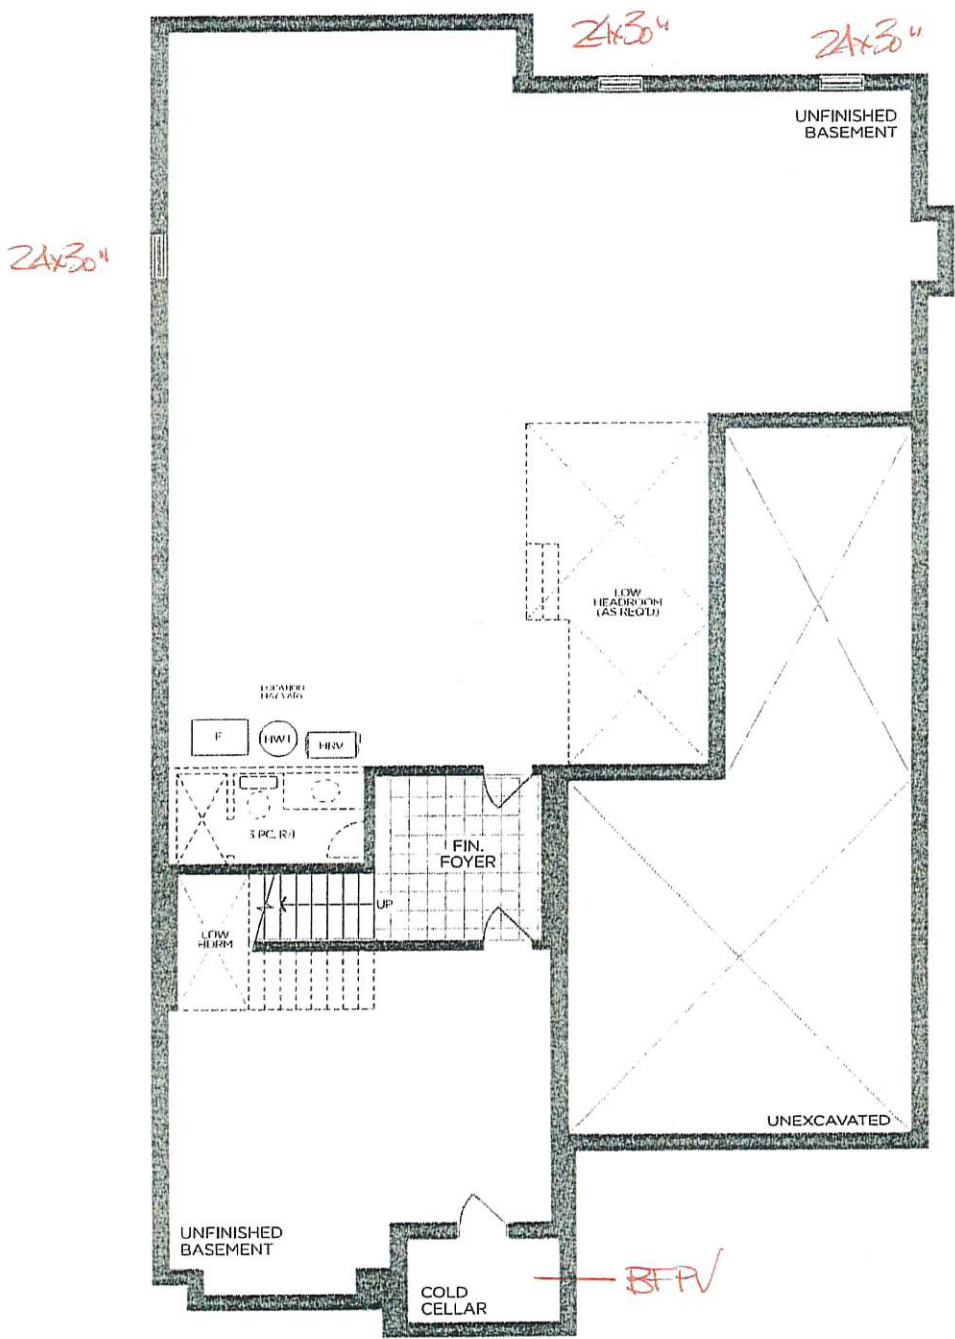

BASEMENT FLOOR | ELEV. A

VENDOR

PURCHASER

PURCHASER



Prices, figures, illustrations, sizes, features and finishes are subject to change without notice. Areas and dimensions are approximate and actual usable floor space may vary from the stated area. Layout may be reverse of the unit purchased. E. & O.E. 5012