

#### **CONSTRUCTION SUMMARY**

Lot: 1-2

Model: 31-02 A INT Stanford Manor Project/Phase: The Manors at Pine Valley / 4

# **CROWN MOULDING**

Invoice	Qty.	Description
3017	1	GREAT ROOM: ADD 9 BOX WAFFLE CEILING - MODERN STYLE #CTR-B59
04Oct23		
NoCat		

L	LLL	, I K	4L

ELECTI Invoice		AL Description
3017 164,749		BASEMENT REC ROOM: S/I 4" E/S LED INTERIOR POT LIGHT - GROUND FLOOR - EACH. WHITE
04Oct23		IN LIEU OF STANDARD CEILING LIGHTS, USE STANDARD SWITCHES. SEE PLAN FOR LOCATION
3017 164,749	6	BASEMENT HALLWAY: S/I 4" E/S LED INTERIOR POT LIGHT - GROUND FLOOR - EACH. WHITE
04Oct23		IN LIEU OF STANDARD CEILING LIGHTS, USE STANDARD SWITCHES. SEE PLAN FOR LOCATION
3017 164,749	4	MAIN HALL: S/I 4" E/S LED INTERIOR POT LIGHT - GROUND FLOOR - EACH. WHITE
04Oct23		IN LIEU OF STANDARD CEILING LIGHTS, USE STANDARD SWITCHES. SEE PLAN FOR LOCATION
3017 164,749	3	MUD ROOM: S/I 4" E/S LED INTERIOR POT LIGHT - GROUND FLOOR - EACH. WHITE
04Oct23		IN LIEU OF STANDARD CEILING LIGHTS, USE STANDARD SWITCHES. SEE PLAN FOR LOCATION
3017 164,749	5	KITCHEN: S/I 4" E/S LED INTERIOR POT LIGHT - GROUND FLOOR - EACH. WHITE
04Oct23		IN ADDITION TO STANDARD CEILING LIGHTS. SEE PLAN FOR LOCATION
3017 164,752	1	KITCHEN: S/I ADDITIONAL INTERIOR SWITCH. SINGLE POLE
04Oct23		FOR POTLIGHTS
3017 164,741	1	KITCHEN: RELOCATE STANDARD CEILING MOUNT FIXTURE
04Oct23		LOCATE APPROX CENTERED ABOVE ISLAND, SEE PLAN FOR LOCATION
3017 164,753	1	KITCHEN: S/I ADDITIONAL REINFORCED CEILING OUTLET. SUPPORTS UP TO APPROX. 40 LBS.
04Oct23		LOCATE APPROX CENTERED ABOVE ISLAND, ON SAME SWITCH AS STANDARD CEILING LIGHT. SEE PLAN FOR LOCATION
3017 164,743	1	KITCHEN: S/I 110V WALL RECEPTACLE ON SEPARATE CIRCUIT
04Oct23		FOR GAS APPLIANCE
3017 164,749	8	GREAT ROOM: S/I 4" E/S LED INTERIOR POT LIGHT - GROUND FLOOR - EACH. WHITE
04Oct23		INCLUDED IN APS, SEE PLAN FOR LOCATION. INCLUDES 1 SWITCH
3017 164,749	1	GREAT ROOM: S/I 4" E/S LED INTERIOR POT LIGHT - GROUND FLOOR - EACH. WHITE
04Oct23		ON SAME SWITCH AS OTHER POTLIGHTS. SEE PLAN FOR LOCATION

DisciplineMS.rpt 23feb21 Page 1 of 3

Printed and Sent: 04-Oct-23



#### **CONSTRUCTION SUMMARY**

Lot: 1-2

Model: 31-02 A INT Stanford Manor Project/Phase: The Manors at Pine Valley / 4

# **ELECTRICAL**

Invoice	Qty.	Description
3017 164,743	1	GREAT ROOM: S/I 110V WALL RECEPTACLE ON SEPARATE CIRCUIT
04Oct23		LOCATE APPROX 66" A.F.F. ABOVE FIREPLACE, SEE PLAN FOR LOCATION.
3017 164,749	1	POWDER ROOM: S/I 4" E/S LED INTERIOR POT LIGHT - GROUND FLOOR - EACH. WHITE
04Oct23		IN ADDITION TO STANDARD LIGHT, ON SAME SWITCH. SEE PLAN FOR LOCATION
3017	5	UPPER HALL: S/I 4" LED INTERIOR POTLIGHT
04Oct23 NoCat		IN LIEU OF STANDARD CEILING LIGHTS, USE STANDARD SWITCHES. SEE PLAN FOR LOCATION
3017	4	PRINCIPAL BEDROOM: S/I 4" INTERIOR POTLIGHT
04Oct23 NoCat		IN ADDITION TO STANDARD CEILING LIGHTS. SEE PLAN FOR LOCATION
3017 164,752	1	PRINCIPAL BEDROOM: S/I ADDITIONAL INTERIOR SWITCH. SINGLE POLE
04Oct23		FOR POTLIGHTS
3017 164,761	1	PRINCIPAL ENSUITE: S/I SHOWER POT LIGHT: 4 INCH RECESSED SHOWER POT LIGHT COMPLETE WITH SWITCH
04Oct23		IN ADDITION TO STANDARD SHOWER POTLIGHT, ON SAME SWITCH
3017 164,745	1	GARAGE: S/I 220V (50 AMP) RECEPTACLE ON A SEPARATE CIRCUIT
04Oct23		FOR FUTURE CAR CHARGER

# **FRAMING**

nvoice	Qty.	Description

3017 164,770 04Oct23	1	KITCHEN; DELETE KITCHEN BULKHEAD, IF POSSIBLE, SITE APPROVAL REQUIRED AND IF MECHANICAL LAYOUTS ALLOW. GAP ABOVE UPPER KITCHEN CABINETS WILL BE PRESENT UNLESS ADDITIONAL CABINETRY IS PURCHASED.
3017 164,775 04Oct23	1	KITCHEN: S/I TALLER UPPER, FURRING PANEL WITH CROWN MOULDING TO CEILING. OPTION ONLY AVAILBLE WITH DELETED BULKHEAD.
3017 164,774 04Oct23	1	PRINCIPAL ENSUITE: S/I RECESSED SHOWER NICHE [SHAMPOO SHELF] - COMPLETE WITH MATCHING STONE ON 4 SIDES, STANDARD TILE, APPROX. 12 X 42 INSTALLED VERTICALLY WITH STONE SHELF DIVIDERS. BASED ON STANDARD FINISHES.

#### HVAC

Invoice	Otv	Description

3017	1	KITCHEN: GAS LINE ROUGH-IN - MAIN FLOOR FOR FUTURE GAS APPLIANCE
164,780		
04Oct23		

Page 2 of 3

Printed and Sent: 04-Oct-23



#### **CONSTRUCTION SUMMARY**

Lot: 1-2

Model: 31-02 A INT Stanford Manor Project/Phase: The Manors at Pine Valley / 4

# INTERIOR DOORS AND TRIM

Invoice	Qty.	Description
3017 164,784 04Oct23		2ND FLOOR: S/I 8FT HIGH DOOR THROUGHOUT SECOND FLOOR IN LIEU OF STANDARD HEIGHT DOOR. PRICE IS PER DOOR

# NETWORK AND WIRING

Invoice	Qty.	Description
3017 164,788	1	GREAT ROOM: S/I ADDITIONAL RG6 HIGH SPEED TV / INTERNET OUTLETS
04Oct23		SEE PLAN FOR LOCATION
3017 164,789 04Oct23	1	GREAT ROOM: S/I CONDUIT PIPE FOR WALL MOUNT TV   LOCATED APPROX. 66" A.F.F. ABOVE FIREPLACE TO CABLE LOCATION. SEE PLAN FOR LOCATION.
3017 164,794 04Oct23	1	S/I SECURITY PACKAGE - ROUGH - IN WIRING FOR: 1 RING DOOR BELL + 2 CAMERAS - 1 AT FRONT AND 1 AT REAR. COMPONENTS NOT INCLUDED. (CAT6)

#### **PLUMBING**

LUMD	LUMBING			
Invoice	Qty.	Description		
3017 164,798 04Oct23	1	KITCHEN: S/I ROUGH-IN 1/4" COLD WATER LINE TO FRIDGE		
3017	1	PRINCIPAL ENSUITE: UPGRADE TO MOEN 'ALIGN' SUITE INCLUDING RAIN SHOWER + TUB FILLER + LAV FAUCET x2		
04Oct23 NoCat				

Page 3 of 3

Printed and Sent: 04-Oct-23

THE MANORS

ELEV. A 2922 SQ.FT. INCLUDES 687 SQ.FT. OF FINISHED BASEMENT

ELEV. B 2926 sq.ft. INCLUDES 687 Sq.FT. OF FINISHED BASEMENT

TM-1-2 SEPT 27, 2023 The Stanford Manor

3-4 BEDROOMS | 4.5 BATHROOMS


END 1 A 2967 sq.ft. INCLUDES 694 SQ.FT. OF FINISHED BASEMENT

END 1 B 2970 sq.ft. INCLUDES 694 SQ.FT. OF FINISHED BASEMENT

END 2 A 2954 sq.ft. INCLUDES 695 SQ.FT. OF FINISHED BASEMENT

END 2 B 2954 sq.ft. INCLUDES 695 SQ.FT. OF FINISHED BASEMENT

CORNER A 2967 SQ.FT. INCLUDES 694 SQ.FT. OF FINISHED BASEMENT

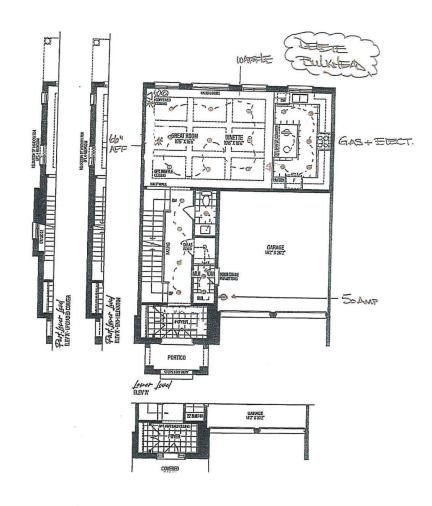

THE MANORS

The Stanford Manor 3-4 BEDROOMS | 4.5 BATHROOMS

ELEV. A 2922 SQ.FT. INCLUDES 687 SQ.FT. OF FINISHED BASEMENT

ELEV. B 2926 sq.ft. INCLUDES 687 SQ.FT. OF FINISHED BASEMENT


TM-1-2 SEPT 24, 2023 END 1 A 2967 SQ.FT. INCLUDES 694 SQ.FT. OF FINISHED BASEMENT

END 1 B 2970 sq.ft. INCLUDES 694 SQ.FT. OF FINISHED BASEMENT END 2 A 2954 sq.ft. INCLUDES 695 SQ.FT. OF FINISHED BASEMENT

END 2 B 2954 sq.ft. INCLUDES 695 SQ.FT. OF FINISHED BASEMENT

CORNER A 2967 sq.ft. INCLUDES 694 SQ.FT. OF FINISHED BASEMENT



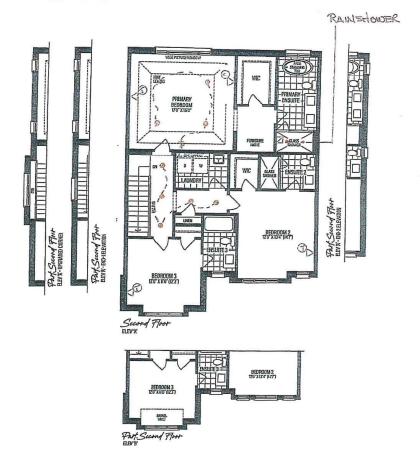

THEMANORS

THEMANORS

ELEV. A 2922 SQUET. INCLUDES 687 SQUET, OF FINISHED BASEMENT

ELEV. B 2926 SQ.FT. INCLUDES 667 SQ.FT. OF FINISHED BASEMENT

TM-HZ SEPT 27, 2023 The Stanford Manor 3-4 BEDROOMS | 4.5 BATHROOMS


END 1 A 2967 SQ.FT. INCLUDES 694 SQ.FT. OF FINISHED BASEMENT

END 1 B 2970 sq.Ft. INCLUDES 694 SQ.FT. OF FINISHED BASEMENT

END 2 A 2954 SO.FT. INCLUDES 685 SQ.FT. OF FINISHED BASEMENT

END 2 B 2954 SQ.FT. INCLUDES 895 SQ.FT. OF FINISHED BASEMENT

CORNER A 2967 SQ.FL INCLUDES 694 SQ.FL OF FINISHED BASEMENT

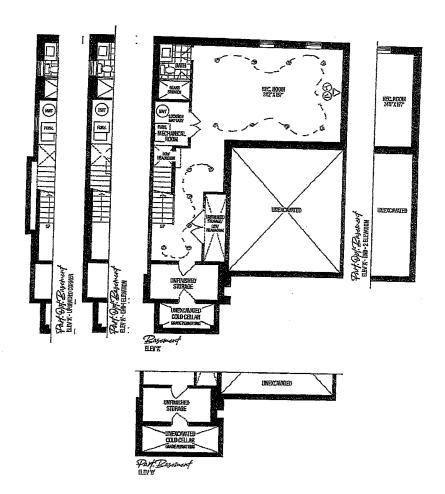



# PLUMBING UPGRADES

# **ALIGN** Ceiling Mount: 226651 (12" Arm) V **Brushed Gold Brushed Nickel** Chrome Matte Black Lot: TM-B1-2 Date: September 07,2023 Location: Principal Ensuite Signature: Signature:

Shower with 3-Function Transfer Valve/Trim and Slide Bar with Hand Shower + 7" Rain Showerhead From Ceiling on 12" Arm

(includes plumbing provision for ceiling mount showerhead) Model T2192EP/UT4191/3887EP/226651/S176/U361CI/ 62320/A725





# **ALIGN**



\*includes Tub Drain Half Kit

	Brushed Gold Brushed Nickel Chrome Matte Black	
Date: September 07,2023	Lot: TM-B1-2	
Location: Principal Ensuite		
Signature:	Signature:	-





# **ALIGN**



	Brushed Gold Brushed Nickel Chrome Matte Black	
Date: September 07, 2023	Lot: TM-81-2	
Location: Principal Ensuite		
Signature:	Signature:	

