

CROWN MOULDING

Invoice	Qty.	Description
3022 04Oct23 NoCat	1	GREAT ROOM: ADD 9-BOX WAFFLE CTR-B07

ELECTRICAL

Invoice	Qty.	Description
3022 164,749 04Oct23	8	BASEMENT: S/1 4" E/S LED INTERIOR POT LIGHT - GROUND FLOOR - EACH. WHITE IN LIEU OF STANDARD CEILING LIGHTS, USE STANDARD SWITCHES. SEE PLAN FOR LOCATION
3022 164,749 04Oct23	2	BASEMENT: S/1 4" E/S LED INTERIOR POT LIGHT - GROUND FLOOR - EACH. WHITE IN LIEU OF STANDARD CEILING LIGHTS, USE STANDARD SWITCHES. SEE PLAN FOR LOCATION
3022 164,749 04Oct23	6	KITCHEN: S/1 4" E/S LED INTERIOR POT LIGHT - GROUND FLOOR - EACH. WHITE IN LIEU OF STANDARD CEILING LIGHTS, USE STANDARD SWITCHES. SEE PLAN FOR LOCATION
3022 164,752 04Oct23	1	KITCHEN: S/1 ADDITIONAL INTERIOR SWITCH. SINGLE POLE FOR POTLIGHTS
3022 164,747 04Oct23	1	KITCHEN: S/1 240V (50 AMP) RECEPTACLE ON A SEPARATE CIRCUIT FOR WALL OVEN
3022 164,743 04Oct23	1	KITCHEN: S/1 110V WALL RECEPTACLE ON SEPARATE CIRCUIT FOR GAS APPLIANCE
3022 164,741 04Oct23	1	KITCHEN: RELOCATE STANDARD CEILING MOUNT FIXTURE LOCATE APPROX CENTERED ABOVE ISLAND, SEE PLAN FOR LOCATION
3022 164,753 04Oct23	1	KITCHEN: S/1 ADDITIONAL REINFORCED CEILING OUTLET. SUPPORTS UP TO APPROX. 40 LBS. LOCATE APPROX CENTERED ABOVE ISLAND, ON SAME SWITCH AS STANDARD CEILING LIGHT.
3022 164,749 04Oct23	8	GREAT ROOM: S/1 4" E/S LED INTERIOR POT LIGHT - GROUND FLOOR - EACH. WHITE INCLUDED IN APS, SEE PLAN FOR LOCATION. INCLUDES 1 SWITCH. SEE PLAN FOR LOCATION
3022 164,749 04Oct23	1	GREAT ROOM: S/1 4" E/S LED INTERIOR POT LIGHT - GROUND FLOOR - EACH. WHITE INCLUDE ON SAME SWITCH AS OTHER POTLIGHTS. SEE PLAN FOR LOCATION.
3022 164,742 04Oct23	1	GREAT ROOM: S/1 110V WALL RECEPTACLE (NOT ON SEPARATE CIRCUIT) LOCATE APPROX 66" A.F.F. ABOVE FIREPLACE FOR FUTURE TV

ELECTRICAL

Invoice	Qty.	Description
3022 164,752 04Oct23	1	GREAT ROOM: S/I ADDITIONAL INTERIOR SWITCH. SINGLE POLE
3022 164,749 04Oct23	5	MAIN HALL: S/I 4" E/S LED INTERIOR POT LIGHT - GROUND FLOOR - EACH. WHITE IN LIEU OF STANDARD CEILING LIGHTS, USE STANDARD SWITCHES. SEE PLAN FOR LOCATION
3022 164,757 04Oct23	1	FOYER: S/I HINGED SWITCH - EACH INCLUDES 1 LED POTLIGHT
3022 164,749 04Oct23	5	UPPER HALL: S/I 4" E/S LED INTERIOR POT LIGHT - EACH. WHITE IN LIEU OF STANDARD CEILING LIGHTS, USE STANDARD SWITCHES. SEE PLAN FOR LOCATION
3022 164,749 04Oct23	4	PRINCIPAL BEDROOM: S/I 4" E/S LED INTERIOR POT LIGHT - GROUND FLOOR - EACH. WHITE IN ADDITION TO STANDARD CEILING LIGHTS. SEE PLAN FOR LOCATION
3022 164,752 04Oct23	1	PRINCIPAL BEDROOM: S/I ADDITIONAL INTERIOR SWITCH. SINGLE POLE FOR POTLIGHTS
3022 164,761 04Oct23	1	PRINCIPAL ENSUITE: S/I SHOWER POT LIGHT: 4 INCH RECESSED SHOWER POT LIGHT COMPLETE WITH SWITCH IN LIEU OF STANDARD CEILING LIGHTS, USE STANDARD SWITCHES. SEE PLAN FOR LOCATION
3022 164,747 04Oct23	1	GARAGE: S/I 240V (50 AMP) RECEPTACLE ON A SEPARATE CIRCUIT FOR FUTURE CAR CHARGER

FRAMING

Invoice	Qty.	Description
3022 164,770 04Oct23	1	KITCHEN: DELETE KITCHEN BULKHEAD, IF POSSIBLE, SITE APPROVAL REQUIRED AND IF MECHANICAL LAYOUTS ALLOW. GAP ABOVE UPPER KITCHEN CABINETS WILL BE PRESENT UNLESS ADDITIONAL CABINETRY IS PURCHASED.
3022 164,775 04Oct23	1	KITCHEN: S/I TALLER UPPER, FURRING PANEL WITH CROWN MOULDING TO CEILING. OPTION ONLY AVAILBLE WITH DELETED BULKHEAD.
3022 164,774 04Oct23	1	PRINCIPAL ENSUITE: S/I RECESSED SHOWER NICHE [SHAMPOO SHELF] - COMPLETE WITH MATCHING STONE ON 4 SIDES, STANDARD TILE, APPROX. 12 X 42 INSTALLED VERTICALLY WITH STONE SHELF DIVIDERS - BASED ON STANDARD FINISHES.

HVAC

Invoice	Qty.	Description
3022 164,780 04Oct23	1	KITCHEN: GAS LINE ROUGH-IN - MAIN FLOOR FOR COOKTOP

INTERIOR DOORS AND TRIM

Invoice	Qty.	Description
3022 164,784 04Oct23	18	2ND FLOOR: S/I 8FT HIGH DOOR THROUGHOUT SECOND FLOOR IN LIEU OF STANDARD HEIGHT DOOR. PRICE IS PER DOOR

NETWORK AND WIRING

Invoice	Qty.	Description
3022 164,787 04Oct23	1	GREAT ROOM: S/I ADDITIONAL CAT6 ETHERNET OUTLET SEE PLAN FOR LOCATION
3022 164,794 04Oct23	1	EXTERIOR: S/I SECURITY PACKAGE - ROUGH - IN WIRING FOR: 1 RING DOOR BELL + 2 CAMERAS - 1 AT FRONT AND 1 AT REAR. COMPONENTS NOT INCLUDED. (CAT6)

PLUMBING

Invoice	Qty.	Description
3022 164,798 04Oct23	1	KITCHEN: S/I ROUGH-IN 1/4" COLD WATER LINE TO FRIDGE
3022 04Oct23 NoCat	1	PRINCIPAL ENSUITE: UPGRADE TO MOEN 'ALIGN' SUITE - INCLUDING RAINSHOWER + TUB FILLER + LAV FAUCETx2

ELEV. A 2825 SQ.FT.
INCLUDES 583 SQ.FT. OF FINISHED BASEMENT

ELEV. B 2813 SQ.FT.
INCLUDES 583 SQ.FT. OF FINISHED BASEMENT


END 1 A 2866 SQ.FT.
INCLUDES 587 SQ.FT. OF FINISHED BASEMENT

END 1 B 2855 SQ.FT.
INCLUDES 587 SQ.FT. OF FINISHED BASEMENT

END 2 A 2858 SQ.FT.
INCLUDES 590 SQ.FT. OF FINISHED BASEMENT

→ END 2 B 2846 SQ.FT.
INCLUDES 590 SQ.FT. OF FINISHED BASEMENT

TM-3 - 1
SEPT 26, 2023

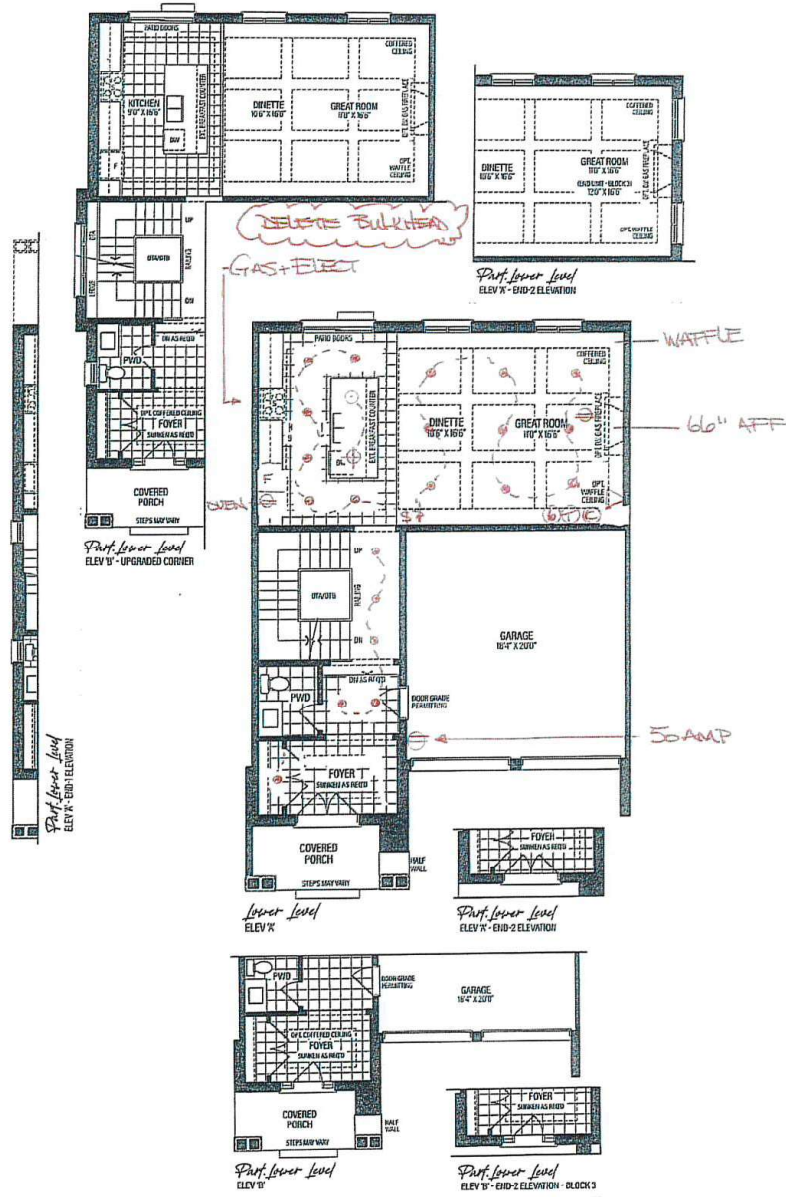

VENDOR
PURCHASER
PURCHASER

SCHEDULE 'F'

RENDERINGS ARE ARTIST'S CONCEPT, FIGURES, ILLUSTRATIONS, SIZES, FEATURES AND FINISHES ARE SUBJECT TO CHANGE WITHOUT NOTICE, AREAS AND DIMENSIONS ARE APPROXIMATE AND ACTUAL USABLE FLOOR SPACE MAY VARY FROM THE STATED AREA. LAYOUT MAY BE REVERSE OF THE UNIT PURCHASED. E. & O.E. 3103

GOLDPARK
WORTH MORE™



The Ashton Manor

3-4 BEDROOMS | 4.5 BATHROOMS

ELEV. A 2825 SQ.FT.
INCLUDES 583 SQ.FT. OF FINISHED BASEMENT

ELEV. B 2813 SQ.FT.
INCLUDES 583 SQ.FT. OF FINISHED BASEMENT


END 1 A 2866 SQ.FT.
INCLUDES 587 SQ.FT. OF FINISHED BASEMENT

END 1 B 2855 SQ.FT.
INCLUDES 587 SQ.FT. OF FINISHED BASEMENT

END 2 A 2858 SQ.FT.
INCLUDES 590 SQ.FT. OF FINISHED BASEMENT

END 2 B 2846 SQ.FT.
INCLUDES 590 SQ.FT. OF FINISHED BASEMENT

TM-3-1
SEPT 26, 2023

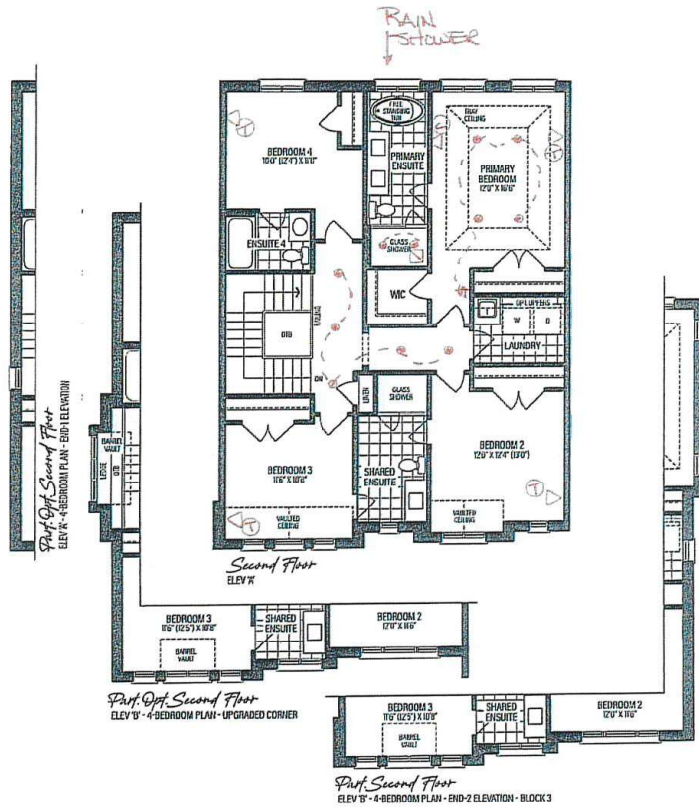

VENDOR
PURCHASER
PURCHASER

SCHEDULE 'F'

RENDERINGS ARE ARTIST'S CONCEPT, FIGURES, ILLUSTRATIONS, SIZES, FEATURES AND FINISHES ARE SUBJECT TO CHANGE WITHOUT NOTICE. AREAS AND DIMENSIONS ARE APPROXIMATE AND ACTUAL USABLE FLOOR SPACE MAY VARY FROM THE STATED AREA. LAYOUT MAY BE REVERSE OF THE UNIT PURCHASED. E. & O.E. 3103

GOLD PARK
WORTH MORE™



The Ashton Manor

3-4 BEDROOMS | 4.5 BATHROOMS

ELEV. A 2825 SQ.FT.
INCLUDES 583 SQ.FT. OF FINISHED BASEMENT

ELEV. B 2813 SQ.FT.
INCLUDES 583 SQ.FT. OF FINISHED BASEMENT


END 1 A 2866 SQ.FT.
INCLUDES 587 SQ.FT. OF FINISHED BASEMENT

END 1 B 2855 SQ.FT.
INCLUDES 587 SQ.FT. OF FINISHED BASEMENT


END 2 A 2858 SQ.FT.
INCLUDES 590 SQ.FT. OF FINISHED BASEMENT

END 2 B 2846 SQ.FT.
INCLUDES 590 SQ.FT. OF FINISHED BASEMENT

TM-3-1
SEPT 26, 2023

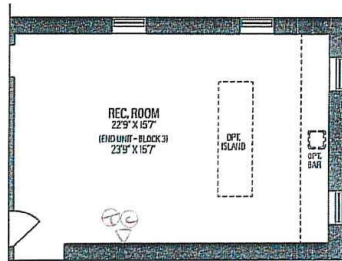

Partial Basement
ELEV 'A' & 'B' - END-2 ELEVATION

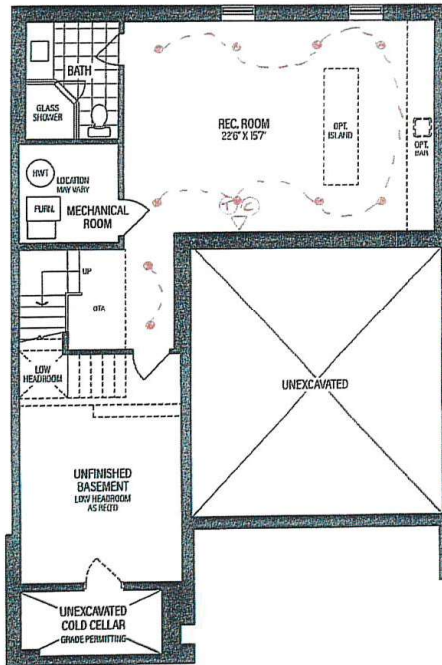

Basement
ELEV 'A' & 'B'

VENDOR
PURCHASER
PURCHASER

SCHEDULE 'F'

GOLD PARK
WORTH MORE

RENDERINGS ARE ARTIST'S CONCEPT. FIGURES, ILLUSTRATIONS, SIZES, FEATURES AND FINISHES ARE SUBJECT TO CHANGE WITHOUT NOTICE. AREAS AND DIMENSIONS ARE APPROXIMATE AND ACTUAL USABLE FLOOR SPACE MAY VARY FROM THE STATED AREA. LAYOUT MAY BE REVERSE OF THE UNIT PURCHASED. E. & O.E. 3103



THE MANORS
AT PINE VALLEY

PLUMBING UPGRADES

ALIGN

Ceiling Mount: 226651 (12" Arm)



Brushed Gold

Brushed Nickel

Chrome

Matte Black



Date: September 11, 2023	Lot: TM-83-1
Location: Principal Ensuite	
Signature:	Signature:

**Shower with 3-Function Transfer Valve/Trim
and Slide Bar with Hand Shower + 7" Rain
Showerhead From Ceiling on 12" Arm**
(includes plumbing provision for ceiling mount showerhead)
Model T2192EP/UT4191/3887EP/226651/S176/U361CI/
62320/A725

GOLDPARK
WORTH MORE™

PLUMBING UPGRADES

ALIGN



Brushed Gold

Brushed Nickel

Chrome

Matte Black

☒ *X*
☐
☐
☐

Date: <i>September 11, 2023</i>	Lot: <i>TM-23-1</i>
Location: <i>Principal Ensuite</i>	
Signature:	Signature:

Two Handle 8" Widespread Lav
Model T6193/69000

GOLDPARK
WORTH MORE™

ALIGN



*includes Tub Drain Half Kit

Brushed Gold

Brushed Nickel

Chrome

Matte Black



Date: September 11, 2023	Lot: TM-33-1
Location: Principal Ensuite	
Signature:	Signature:

Two Handle Roman Tub
Model T393/4796

GOLDPARK
WORTH MORE™