

CONSTRUCTION SUMMARY

Lot: 12-2

Model: 31-02 A CORNER Stanford Manor Project/Phase: The Manors at Pine Valley / 4

DRYWALL

Invoice	Qty.	Description
3054	1	GREAT ROOM: ADD 9 BOX WAFFLE - MODEN STYLE #CTR-B59
11Oct23 NoCat		

ELECTRICAL

100423 Season S	ELECTRICAL				
104,749 110423 IN LIEU OF STANDARD CEILING LIGHTS, USE STANDARD SWITCHES. SEE PLAN FOR LOCATION. 3054 104,749 110423 IN LIEU OF STANDARD CEILING LIGHT, EACH, WHITE 164,749 110423 IN LIEU OF STANDARD CEILING LIGHT, USE STANDARD SWITCHES. SEE PLAN FOR LOCATION. 3054 164,749 110423 IN LIEU OF STANDARD CEILING LIGHT, USE STANDARD SWITCHES. SEE PLAN FOR LOCATION. 3054 164,749 110423 IN LIEU OF STANDARD CEILING LIGHT, USE STANDARD SWITCHES. SEE PLAN FOR LOCATION. 3054 164,749 110423 IN LIEU OF STANDARD CEILING LIGHTS, USE STANDARD SWITCHES. SEE PLAN FOR LOCATION. 3054 164,749 110423 IN ADDITION OF STANDARD CEILING LIGHT, EACH, WHITE 164,749 110423 IN ADDITION OF STANDARD CEILING LIGHTS, USE STANDARD FOR LOCATION. 3054 104,752 110423 FOR POTLIGHTS 3054 104,752 110423 IN KITCHEN: SI ADDITIONAL INTERIOR SWITCH. SINGLE POLE 164,752 110423 LOCATE APPROX CENTERED ABOVE ISLAND, SEE PLAN FOR LOCATION. 3054 104,753 110423 LOCATE APPROX CENTERED ABOVE ISLAND, AS SAME SWITCH AS STANDARD LIGHT. SEE PLAN FOR LOCATION. 3054 104,753 110423 LOCATE APPROX CENTERED ABOVE ISLAND, AS SAME SWITCH AS STANDARD LIGHT. SEE PLAN FOR LOCATION. 3054 104,753 110423 LOCATE APPROX CENTERED ABOVE ISLAND, AS SAME SWITCH AS STANDARD LIGHT. SEE PLAN FOR LOCATION. 3054 104,753 110423 LOCATE APPROX CENTERED ABOVE ISLAND, AS SAME SWITCH AS STANDARD LIGHT. SEE PLAN FOR LOCATION. 3054 104,753 110423 LOCATE APPROX CENTERED ABOVE ISLAND, AS SAME SWITCH AS STANDARD LIGHT. SEE PLAN FOR LOCATION. 3054 104,753 110423 LOCATE APPROX CENTERED ABOVE ISLAND, AS SAME SWITCH AS STANDARD LIGHT. SEE PLAN FOR LOCATION. 3054 104,753 110423 LOCATE APPROX CENTERED ABOVE ISLAND, AS SAME SWITCH AS STANDARD LIGHT. SEE PLAN FOR LOCATION. 3054 104,753 104,753 106,753 1076,753 1076,754 1077,755 1077,757 1077,7	Invoice	Qty.	Description		
3054 1		8	BASEMENT: S/I 4" E/S LED INTERIOR POT LIGHT - EACH. WHITE		
104,749 1104,749	11Oct23		IN LIEU OF STANDARD CEILING LIGHTS, USE STANDARD SWITCHES. SEE PLAN FOR LOCATION.		
110ct23 IN LIEU OF STANDARD CEILING LIGHTS, USE STANDARD SWITCHES. SEE PLAN FOR LOCATION. 3054 1064,749 IN LIEU OF STANDARD CEILING LIGHT - EACH. WHITE IN LIEU OF STANDARD CEILING LIGHT - EACH. WHITE IN LIEU OF STANDARD CEILING LIGHTS, USE STANDARD SWITCHES. SEE PLAN FOR LOCATION. 3054 10 KITCHEN: S14" ES LED INTERIOR POT LIGHT - EACH. WHITE IN LIEU OF STANDARD CEILING LIGHTS, USE STANDARD SWITCHES. SEE PLAN FOR LOCATION. 3054 10 KITCHEN: S14" ES LED INTERIOR POT LIGHT - EACH. WHITE IN ADDITION OF STANDARD CEILING LIGHTS. SEE PLAN FOR LOCATION. 3054 10 KITCHEN: S1 ADDITIONAL INTERIOR SWITCH. SINGLE POLE FOR POTLIGHTS 3054 10 KITCHEN: S1 ADDITIONAL INTERIOR SWITCH. SINGLE POLE INCATED ADDITIONAL INTERIOR SWITCH. SINGLE POLE INCATED ADDITIONAL INTERIOR SWITCH. SINGLE PLAN FOR LOCATION. 3054 10 KITCHEN: S1 ADDITIONAL REINFORCED CEILING OUTLET. SUPPORTS UP TO APPROX. 40 LBS. LOCATE APPROX CENTERED ABOVE ISLAND, AS SAME SWITCH AS STANDARD LIGHT. SEE PLAN FOR LOCATION. 3054 1 KITCHEN: S1 ADDITIONAL REINFORCED CEILING OUTLET. SUPPORTS UP TO APPROX. 40 LBS. LOCATE APPROX CENTERED ABOVE ISLAND, AS SAME SWITCH AS STANDARD LIGHT. SEE PLAN FOR LOCATION. 3054 1 KITCHEN: S1 110V WALL RECEPTACLE ON SEPARATE CIRCUIT FOR GAS APPLIANCE 3054 1 KITCHEN: S1 110V WALL RECEPTACLE ON SEPARATE CIRCUIT FOR GAS APPLIANCE 3054 1 KITCHEN: S1 4" ES LED INTERIOR POT LIGHT - EACH. WHITE		6	BASEMENT: S/I 4" E/S LED INTERIOR POT LIGHT - EACH. WHITE		
104:749 1104			IN LIEU OF STANDARD CEILING LIGHTS, USE STANDARD SWITCHES. SEE PLAN FOR LOCATION.		
110-r23	l	4	MAIN HALL: S/I 4" E/S LED INTERIOR POT LIGHT - EACH. WHITE		
164,749 110ct23 10 KITCHEN: S/I 4" E/S LED INTERIOR POT LIGHT - EACH. WHITE 164,749 110ct23 11 KITCHEN: S/I ADDITIONAL INTERIOR SWITCH. SINGLE POLE 164,752 110ct23 12 KITCHEN: S/I ADDITIONAL INTERIOR SWITCH. SINGLE POLE 164,752 110ct23 13054 14 KITCHEN: S/I ADDITIONAL INTERIOR SWITCH. SINGLE POLE 164,741 110ct23 15 KITCHEN: S/I ADDITIONAL INTERIOR SWITCH. SINGLE POLE 164,741 164,741 110ct23 164,753 164,753 164,753 110ct23 164,753 110ct23 164,753 110ct23 164,743 11 KITCHEN: S/I ADDITIONAL REINFORCED CEILING OUTLET. SUPPORTS UP TO APPROX. 40 LBS. 164,753 110ct23 10 KITCHEN: S/I ADDITIONAL REINFORCED CEILING OUTLET. SUPPORTS UP TO APPROX. 40 LBS. 164,743 110ct23 110ct23 110ct23 11 KITCHEN: S/I LIOV WALL RECEPTACLE ON SEPARATE CIRCUIT 164,743 110ct23 12 KITCHEN: S/I LIOV WALL RECEPTACLE ON SEPARATE CIRCUIT 164,749 110ct23 13054 14 KITCHEN: S/I LIOV WALL RECEPTACLE ON SEPARATE CIRCUIT 164,749 110ct23 164,749 17 GREAT ROOM: S/I 4" E/S LED INTERIOR POT LIGHT - EACH. WHITE 164,749 110ct23 11 GREAT ROOM: S/I 4" E/S LED INTERIOR POT LIGHT - EACH. WHITE	, i		IN LIEU OF STANDARD CEILING LIGHTS, USE STANDARD SWITCHES. SEE PLAN FOR LOCATION.		
110ct23 IN LIEU OF STANDARD CEILING LIGHTS, USE STANDARD SWITCHES. SEE PLAN FOR LOCATION. 3054 164,749 IN ADDITION OF STANDARD CEILING LIGHT - EACH. WHITE 164,749 IN ADDITION OF STANDARD CEILING LIGHTS. SEE PLAN FOR LOCATION. 3054 1 KITCHEN: ST ADDITIONAL INTERIOR SWITCH. SINGLE POLE 164,741 110ct23 FOR POTLIGHTS 3054 1 KITCHEN: RELOCATE STANDARD CEILING MOUNT FIXTURE 164,741 110ct23 LOCATE APPROX CENTERED ABOVE ISLAND, SEE PLAN FOR LOCATION. 3054 1 KITCHEN: ST ADDITIONAL REINFORCED CEILING OUTLET. SUPPORTS UP TO APPROX. 40 LBS. 164,753 LOCATE APPROX CENTERED ABOVE ISLAND, AS SAME SWITCH AS STANDARD LIGHT. SEE PLAN FOR LOCATION. 3054 1 KITCHEN: ST 110V WALL RECEPTACLE ON SEPARATE CIRCUIT 164,743 FOR GAS APPLIANCE 3054 1 GREAT ROOM: ST 4" E/S LED INTERIOR POT LIGHT - EACH. WHITE 3054 11 GREAT ROOM: ST 4" E/S LED INTERIOR POT LIGHT - EACH. WHITE		3	MUDROOM: S/I 4" E/S LED INTERIOR POT LIGHT - EACH. WHITE		
164,749 110ct23 11 KITCHEN: S/I ADDITION OF STANDARD CEILING LIGHTS. SEE PLAN FOR LOCATION. 3054 11 KITCHEN: S/I ADDITIONAL INTERIOR SWITCH. SINGLE POLE 164,752 110ct23 12 FOR POTLIGHTS 3054 12 KITCHEN: RELOCATE STANDARD CEILING MOUNT FIXTURE 164,741 110ct23 13054 14 KITCHEN: S/I ADDITIONAL REINFORCED CEILING OUTLET. SUPPORTS UP TO APPROX. 40 LBS. 164,753 110ct23 10ct23 11 LOCATE APPROX CENTERED ABOVE ISLAND, AS SAME SWITCH AS STANDARD LIGHT. SEE PLAN FOR LOCATION. 3054 164,743 110ct23 10ct23 11 KITCHEN: S/I 110V WALL RECEPTACLE ON SEPARATE CIRCUIT 164,743 110ct23 10ct23 11 KITCHEN: S/I 110V WALL RECEPTACLE ON SEPARATE CIRCUIT 164,749 110ct23 10ct23 11 GREAT ROOM: S/I 4" E/S LED INTERIOR POT LIGHT - EACH. WHITE 3054 10ct23 3054 11 GREAT ROOM: S/I 4" E/S LED INTERIOR POT LIGHT - EACH. WHITE			IN LIEU OF STANDARD CEILING LIGHTS, USE STANDARD SWITCHES. SEE PLAN FOR LOCATION.		
110et23 IN ADDITION OF STANDARD CEILING LIGHTS. SEE PLAN FOR LOCATION. 3054 164,752 110et23 FOR POTLIGHTS 3054 1 KITCHEN: S/I ADDITIONAL INTERIOR SWITCH. SINGLE POLE 404,741 110et23 LOCATE APPROX CENTERED ABOVE ISLAND, SEE PLAN FOR LOCATION. 3054 1 KITCHEN: S/I ADDITIONAL REINFORCED CEILING OUTLET. SUPPORTS UP TO APPROX. 40 LBS. 10et23 LOCATE APPROX CENTERED ABOVE ISLAND, AS SAME SWITCH AS STANDARD LIGHT. SEE PLAN FOR LOCATION. 3054 1 KITCHEN: S/I 110V WALL RECEPTACLE ON SEPARATE CIRCUIT 164,743 110et23 FOR GAS APPLIANCE 3054 1 KITCHEN: S/I 110V WALL RECEPTACLE ON SEPARATE CIRCUIT 164,749 110et23 FOR GAS APPLIANCE 3054 1 GREAT ROOM: S/I 4" E/S LED INTERIOR POT LIGHT - EACH. WHITE	l	5	KITCHEN: S/I 4" E/S LED INTERIOR POT LIGHT - EACH. WHITE		
10ct23 FOR POTLIGHTS 3054 10ct23 LOCATE APPROX CENTERED ABOVE ISLAND, SEE PLAN FOR LOCATION. 3054 11 KITCHEN: S/I ADDITIONAL REINFORCED CEILING OUTLET. SUPPORTS UP TO APPROX. 40 LBS. 10ct23 LOCATE APPROX CENTERED ABOVE ISLAND, AS SAME SWITCH AS STANDARD LIGHT. SEE PLAN FOR LOCATION. 3054 10ct23 LOCATE APPROX CENTERED ABOVE ISLAND, AS SAME SWITCH AS STANDARD LIGHT. SEE PLAN FOR LOCATION. 3054 11 KITCHEN: S/I 110V WALL RECEPTACLE ON SEPARATE CIRCUIT 16ct23 FOR GAS APPLIANCE 3054 16ct23 REAT ROOM: S/I 4" E/S LED INTERIOR POT LIGHT - EACH. WHITE 3054 16ct24 REAT ROOM: S/I 4" E/S LED INTERIOR POT LIGHT - EACH. WHITE			IN ADDITION OF STANDARD CEILING LIGHTS. SEE PLAN FOR LOCATION.		
110ct23 FOR POTLIGHTS 3054 1 KITCHEN: RELOCATE STANDARD CEILING MOUNT FIXTURE 164,741 110ct23 LOCATE APPROX CENTERED ABOVE ISLAND, SEE PLAN FOR LOCATION. 3054 1 KITCHEN: S/I ADDITIONAL REINFORCED CEILING OUTLET. SUPPORTS UP TO APPROX. 40 LBS. LOCATE APPROX CENTERED ABOVE ISLAND, AS SAME SWITCH AS STANDARD LIGHT. SEE PLAN FOR LOCATION. 3054 1 KITCHEN: S/I 110V WALL RECEPTACLE ON SEPARATE CIRCUIT 164,743 110ct23 FOR GAS APPLIANCE 3054 8 GREAT ROOM: S/I 4" E/S LED INTERIOR POT LIGHT - EACH. WHITE 3054 164,749 110ct23		1	KITCHEN: S/I ADDITIONAL INTERIOR SWITCH. SINGLE POLE		
10ct23 LOCATE APPROX CENTERED ABOVE ISLAND, SEE PLAN FOR LOCATION. 10ct23 LOCATE APPROX CENTERED ABOVE ISLAND, SEE PLAN FOR LOCATION. 110ct23 LOCATE APPROX CENTERED ABOVE ISLAND, AS SAME SWITCH AS STANDARD LIGHT. SEE PLAN FOR LOCATION. 10ct23 LOCATE APPROX CENTERED ABOVE ISLAND, AS SAME SWITCH AS STANDARD LIGHT. SEE PLAN FOR LOCATION. 10ct23 FOR GAS APPLIANCE 10ct23 FOR GAS APPLIANCE 3054 8 GREAT ROOM: S/I 4" E/S LED INTERIOR POT LIGHT - EACH. WHITE 10ct23 GREAT ROOM: S/I 4" E/S LED INTERIOR POT LIGHT - EACH. WHITE			FOR POTLIGHTS		
11Oct23 LOCATE APPROX CENTERED ABOVE ISLAND, SEE PLAN FOR LOCATION. 3054 1 KITCHEN: S/I ADDITIONAL REINFORCED CEILING OUTLET. SUPPORTS UP TO APPROX. 40 LBS. LOCATE APPROX CENTERED ABOVE ISLAND, AS SAME SWITCH AS STANDARD LIGHT. SEE PLAN FOR LOCATION. 3054 1 KITCHEN: S/I 110V WALL RECEPTACLE ON SEPARATE CIRCUIT FOR GAS APPLIANCE 3054 164,749 11Oct23		1	KITCHEN: RELOCATE STANDARD CEILING MOUNT FIXTURE		
10ct23 LOCATE APPROX CENTERED ABOVE ISLAND, AS SAME SWITCH AS STANDARD LIGHT. SEE PLAN FOR LOCATION. 3054 1 KITCHEN: S/I 110V WALL RECEPTACLE ON SEPARATE CIRCUIT 164,743 110ct23 FOR GAS APPLIANCE 3054 8 GREAT ROOM: S/I 4" E/S LED INTERIOR POT LIGHT - EACH. WHITE 10ct23 GREAT ROOM: S/I 4" E/S LED INTERIOR POT LIGHT - EACH. WHITE			LOCATE APPROX CENTERED ABOVE ISLAND, SEE PLAN FOR LOCATION.		
LOCATE APPROX CENTERED ABOVE ISLAND, AS SAME SWITCH AS STANDARD LIGHT. SEE PLAN FOR LOCATION. 3054 164,743 110ct23 FOR GAS APPLIANCE 8 GREAT ROOM: S/I 4" E/S LED INTERIOR POT LIGHT - EACH. WHITE 10ct23 1 GREAT ROOM: S/I 4" E/S LED INTERIOR POT LIGHT - EACH. WHITE		1	KITCHEN: S/I ADDITIONAL REINFORCED CEILING OUTLET. SUPPORTS UP TO APPROX. 40 LBS.		
164,743 110ct23 FOR GAS APPLIANCE 3054 164,749 110ct23 8 GREAT ROOM: S/I 4" E/S LED INTERIOR POT LIGHT - EACH. WHITE 3054 164,749 110ct23 1 GREAT ROOM: S/I 4" E/S LED INTERIOR POT LIGHT - EACH. WHITE			·		
11Oct23 FOR GAS APPLIANCE 3054 8 GREAT ROOM: S/I 4" E/S LED INTERIOR POT LIGHT - EACH. WHITE 11Oct23		1	KITCHEN: S/I 110V WALL RECEPTACLE ON SEPARATE CIRCUIT		
164,749 11Oct23			FOR GAS APPLIANCE		
11Oct23 3054 1 GREAT ROOM: S/I 4" E/S LED INTERIOR POT LIGHT - EACH. WHITE		8	GREAT ROOM: S/I 4" E/S LED INTERIOR POT LIGHT - EACH. WHITE		
164,749					
		1	GREAT ROOM: S/I 4" E/S LED INTERIOR POT LIGHT - EACH. WHITE		
			INCLUDE ON SAME SWITCH AS OTHER POTLIGHTS. SEE PLAN FOR LOCATION.		

Page 1 of 3

Printed and Sent: 11-Oct-23



CONSTRUCTION SUMMARY

Lot: 12-2

Model: 31-02 A CORNER Stanford Manor Project/Phase: The Manors at Pine Valley / 4

ELECTRICAL

Invoice	Qty.	Description
3054 164,743	1	GREAT ROOM: S/I 110V WALL RECEPTACLE ON SEPARATE CIRCUIT
11Oct23		LOCATE APPROX 66" A.F.F. ABOVE FIREPLACE. SEE PLAN FOR LOCATION.
3054 164,749	1	POWDER ROOM: S/I 4" E/S LED INTERIOR POT LIGHT - EACH. WHITE
11Oct23		IN ADDITION TO STANDARD LIGHTS, SAME SWITCH AS STANDARD VANITY LIGHT. SEE PLAN FOR LOCATION.
3054 164,749	5	UPPER HALL: S/I 4" E/S LED INTERIOR POT LIGHT - EACH. WHITE
11Oct23		IN LIEU OF STANDARD CEILING LIGHTS, USE STANDARD SWITCHES. SEE PLAN FOR LOCATION.
3054 164,749	4	PRINCIPAL BEDROOM: S/I 4" E/S LED INTERIOR POT LIGHT - EACH. WHITE
11Oct23		IN ADDITION TO STANDARD CEILING LIGHTS. SEE PLAN FOR LOCATION.
3054 164,752	1	PRINCIPAL BEDROOM: S/I ADDITIONAL INTERIOR SWITCH. SINGLE POLE
11Oct23		FOR POTLIGHTS
3054 164,761	1	PRINCIPAL ENSUITE: S/I SHOWER POT LIGHT: 4 INCH RECESSED SHOWER POT LIGHT COMPLETE WITH SWITCH
11Oct23		IN ADDITION TO STANDARD SHOWER POTLIGHT, ON SAME SWITCH.
3054 164,745	1	GARAGE: S/I 220V (50 AMP) RECEPTACLE ON A SEPARATE CIRCUIT
11Oct23		FOR FUTURE CAR CHARGER

FRAMING

Invoice	Qty.	Description
3054 164,770 11Oct23	1	KITCHEN: DELETE KITCHEN BULKHEAD, IF POSSIBLE, SITE APPROVAL REQUIRED AND IF MECHANICAL LAYOUTS ALLOW. GAP ABOVE UPPER KITCHEN CABINETS WILL BE PRESENT UNLESS ADDITIONAL CABINETRY IS PURCHASED.
3054 164,775 11Oct23	1	KITCHEN: S/I TALLER UPPER, FURRING PANEL WITH CROWN MOULDING TO CEILING. OPTION ONLY AVAILBLE WITH DELETED BULKHEAD.
3054 164,774	1	PRINCIPAL ENSUITE: S/I RECESSED SHOWER NICHE [SHAMPOO SHELF] - COMPLETE WITH MATCHING STONE ON 4 SIDES, STANDARD TILE, APPROX. 12 X 42 INSTALLED VERTICALLY WITH STONE SHELF DIVIDERS - MUST SPECIEV LOCATION, PASED ON STANDARD FINISHES

HVAC

11Oct23

Invoice	Qty.	Description
3054 164,780 11Oct23	1	KITCHEN: GAS LINE ROUGH-IN - MAIN FLOOR FOR APPLIANCE

Page 2 of 3



CONSTRUCTION SUMMARY

Lot: 12-2

Model: 31-02 A CORNER Stanford Manor Project/Phase: The Manors at Pine Valley / 4

INTERIOR DOORS AND TRIM

Invoice	Qty.	Description		
3054 164,784 11Oct23		2ND FLOOR: S/I 8FT HIGH DOOR THROUGHOUT SECOND FLOOR IN LIEU OF STANDARD HEIGHT DOOR. PRICE IS PER DOOR		

NETWORK AND WIRING

Invoice	Qty.	Description
3054 164,788	1	GREAT ROOM: S/I ADDITIONAL RG6 HIGH SPEED TV / INTERNET OUTLETS
11Oct23		SEE PLAN FOR LOCATION.
3054 164,789 11Oct23	1	GREAT ROOM: S/I CONDUIT PIPE FOR WALL MOUNT TV LOCATED APPROX. 66" A.F.F. ABOVE FIREPLACE THROUGH BASEMENT TO CABLE LOCATION. SEE PLAN FOR LOCATION.
3054 164,794 11Oct23	1	EXTERIOR: S/I SECURITY PACKAGE - ROUGH - IN WIRING FOR: 1 RING DOOR BELL + 2 CAMERAS - 1 AT FRONT AND 1 AT REAR. COMPONENTS NOT INCLUDED. (CAT6)

PLUMBING

PLUMBING				
Invoice	Qty.	Description		
3054 164,798 11Oct23	1	KITCHEN: S/I ROUGH-IN 1/4" COLD WATER LINE TO FRIDGE		
3054 11Oct23 NoCat	1	PRINCIPAL ENSUITE: UPGRADE TO MOEN 'ALIGN' SUITE INCLUDING RAIN SHOWER + TUB FILLER + LAV FAUCET x2		

DisciplineMS.rpt 23feb21

Printed and Sent: 11-Oct-23

THE MANORS

The Stanford Manor 3-4 BEDROOMS | 4.5 BATHROOMS

ELEV. A 2922 SQ.FT. INCLUDES 687 SQ.FT. OF FINISHED BASEMENT

ELEV. B 2926 sq.ft. INCLUDES 687 SQ.FT. OF FINISHED BASEMENT


TM-SEPT 2 2023 END 1 A 2967 SQ.FT. INCLUDES 694 SQ.FT. OF FINISHED BASEMENT

END 1 B 2970 sq.ft. INCLUDES 694 SQ.FT. OF FINISHED BASEMENT

END 2 A 2954 SQ.FT. INCLUDES 695 SQ.FT. OF FINISHED BASEMENT

END 2 B 2954 sq.ft.
INCLUDES 695 SQ.FT. OF FINISHED BASEMENT

CORNER A 2967 SQ.FT. INCLUDES 694 SQ.FT. OF FINISHED BASEMENT

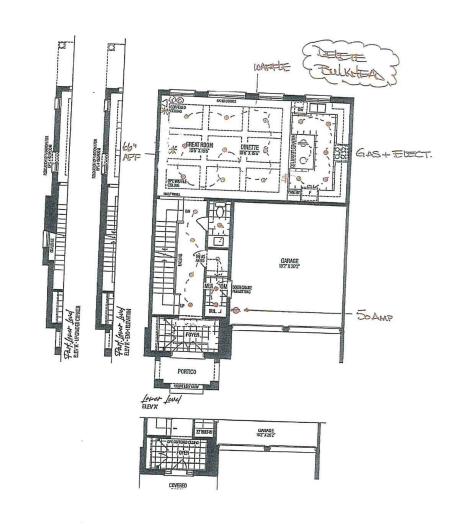

THE MANORS

The Stanford Manor 3-4 BEDROOMS | 4.5 BATHROOMS

ELEV. A 2922 SQ.FT. INCLUDES 687 SQ.FT. OF PINISHED BASEMENT

ELEV. B 2926 SQ.FT. INCLUDES 887 SQ.FT. OF FINISHED BASEMENT

END 1 A 2967 SQ.FT. INCLUDES 684 SQ.FT. OF FINISHED BASEMENT

END 2 A 2954 SQ.FT. INCLUDES 695 SQ.FT. OF FINISHED BASEMENT

TM-

SEPT


END 1 B 2970 SQ.FT. INCLUDES 694 SQ.FT. OF FINISHED BASEMENT

END 2 B 2954 sq.ft. INCLUDES 695 SQ.FT. OF FINISHED BASEMENT

CORNER A 2967 SQ.FT. INCLUDES 594 SQ.FT. OF FINISHED BASEMENT

(8' books on ZNO Floor)

2023

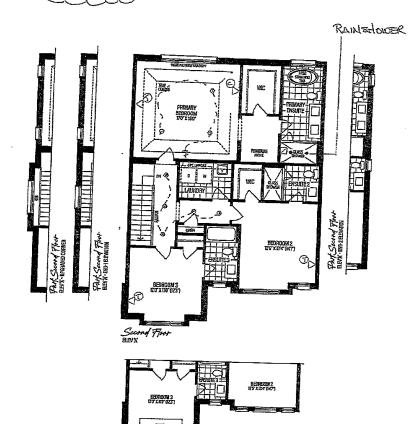

THE MANORS

The Stanford Manor 3-4 BEDROOMS | 4.5 BATHROOMS

ELEV. A 2922 SQ.FT. INCLUDES 687 SQ.FT. OF FINISHED BASEMENT

ELEV. B 2926 SQ.FT. INCLUDES 667 SQ.FT. OF FINISHED BASEMENT


TM-SEPT 2023 END 1 A 2967 SQ.FT. INCLUDES 694 SQ.FT. OF HINISHED BASEMENT

END 1 B 2970 SQ.FT. INCLUDES 694 SQ.FT. OF FINISHED BASSEMENT

END 2 A 2954 SOLFI. INCLUDES 695 SOLFI. OF FINISHED BASEMENT

END 2 B 2954 SQ.FT. OF FINISHED BASEMENT

CORNER A 2967 SQ.FT. INCLUDES 684 SQ.FT. OF FINISHED BASEMENT

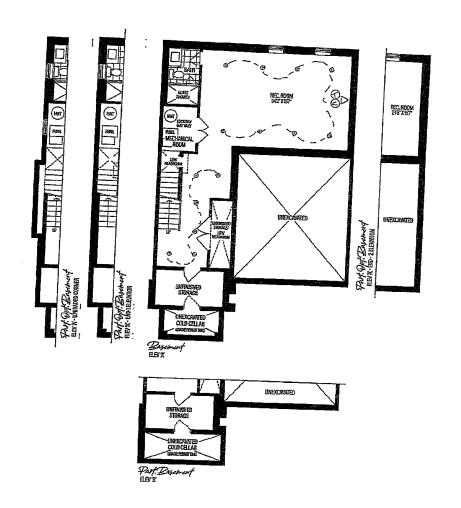



PLUMBING UPGRADES

ALIGN

Ceiling Mount: 226651 (12" Arm)	Brushed Go Brushed Nic Chrome	
	Matte Black	
Date:	Lot:	
Location:		
Signature:	Signature:	

Shower with 3-Function Transfer Valve/Trim and Slide Bar with Hand Shower + 7" Rain Showerhead From Ceiling on 12" Arm

(includes plumbing provision for ceiling mount showerhead) Model T2192EP/UT4191/3887EP/226651/S176/U361CI/ 62320/A725





ALIGN



	Brushed Gold Brushed Nickel Chrome Matte Black	x2
Date:	Lot:	
Location:		
Signature:	Signature:	

Two Handle 8" Widespread Lav Model T6193/69000





ALIGN



*includes Tub Drain Half Kit

	Brushed Gold Brushed Nickel Chrome Matte Black	
Date:	Lot:	
Location:		
Signature:	Signature:	

Two Handle Roman Tub Model T393/4796

