

**CROWN MOULDING**

Invoice	Qty.	Description
3017 04Oct23 NoCat	1	GREAT ROOM: ADD 9 BOX WAFFLE CEILING - MODERN STYLE #CTR-B59

**ELECTRICAL**

Invoice	Qty.	Description
3017 164,749 04Oct23	8	BASEMENT REC ROOM: S/1 4" E/S LED INTERIOR POT LIGHT - GROUND FLOOR - EACH. WHITE IN LIEU OF STANDARD CEILING LIGHTS, USE STANDARD SWITCHES. SEE PLAN FOR LOCATION
3017 164,749 04Oct23	6	BASEMENT HALLWAY: S/1 4" E/S LED INTERIOR POT LIGHT - GROUND FLOOR - EACH. WHITE IN LIEU OF STANDARD CEILING LIGHTS, USE STANDARD SWITCHES. SEE PLAN FOR LOCATION
3017 164,749 04Oct23	4	MAIN HALL: S/1 4" E/S LED INTERIOR POT LIGHT - GROUND FLOOR - EACH. WHITE IN LIEU OF STANDARD CEILING LIGHTS, USE STANDARD SWITCHES. SEE PLAN FOR LOCATION
3017 164,749 04Oct23	3	MUD ROOM: S/1 4" E/S LED INTERIOR POT LIGHT - GROUND FLOOR - EACH. WHITE IN LIEU OF STANDARD CEILING LIGHTS, USE STANDARD SWITCHES. SEE PLAN FOR LOCATION
3017 164,749 04Oct23	5	KITCHEN: S/1 4" E/S LED INTERIOR POT LIGHT - GROUND FLOOR - EACH. WHITE IN ADDITION TO STANDARD CEILING LIGHTS. SEE PLAN FOR LOCATION
3017 164,752 04Oct23	1	KITCHEN: S/1 ADDITIONAL INTERIOR SWITCH. SINGLE POLE FOR POTLIGHTS
3017 164,741 04Oct23	1	KITCHEN: RELOCATE STANDARD CEILING MOUNT FIXTURE LOCATE APPROX CENTERED ABOVE ISLAND, SEE PLAN FOR LOCATION
3017 164,753 04Oct23	1	KITCHEN: S/1 ADDITIONAL REINFORCED CEILING OUTLET. SUPPORTS UP TO APPROX. 40 LBS. LOCATE APPROX CENTERED ABOVE ISLAND, ON SAME SWITCH AS STANDARD CEILING LIGHT. SEE PLAN FOR LOCATION
3017 164,743 04Oct23	1	KITCHEN: S/1 110V WALL RECEPTACLE ON SEPARATE CIRCUIT FOR GAS APPLIANCE
3017 164,749 04Oct23	8	GREAT ROOM: S/1 4" E/S LED INTERIOR POT LIGHT - GROUND FLOOR - EACH. WHITE INCLUDED IN APS, SEE PLAN FOR LOCATION. INCLUDES 1 SWITCH
3017 164,749 04Oct23	1	GREAT ROOM: S/1 4" E/S LED INTERIOR POT LIGHT - GROUND FLOOR - EACH. WHITE ON SAME SWITCH AS OTHER POTLIGHTS. SEE PLAN FOR LOCATION

**ELECTRICAL**

Invoice	Qty.	Description
3017 164,743 04Oct23	1	GREAT ROOM: S/I 110V WALL RECEPTACLE ON SEPARATE CIRCUIT  LOCATE APPROX 66" A.F.F. ABOVE FIREPLACE, SEE PLAN FOR LOCATION.
3017 164,749 04Oct23	1	POWDER ROOM: S/I 4" E/S LED INTERIOR POT LIGHT - GROUND FLOOR - EACH. WHITE  IN ADDITION TO STANDARD LIGHT, ON SAME SWITCH. SEE PLAN FOR LOCATION
3017 04Oct23 NoCat	5	UPPER HALL: S/I 4" LED INTERIOR POTLIGHT  IN LIEU OF STANDARD CEILING LIGHTS, USE STANDARD SWITCHES. SEE PLAN FOR LOCATION
3017 04Oct23 NoCat	4	PRINCIPAL BEDROOM: S/I 4" INTERIOR POTLIGHT  IN ADDITION TO STANDARD CEILING LIGHTS. SEE PLAN FOR LOCATION
3017 164,752 04Oct23	1	PRINCIPAL BEDROOM: S/I ADDITIONAL INTERIOR SWITCH. SINGLE POLE  FOR POTLIGHTS
3017 164,761 04Oct23	1	PRINCIPAL ENSUITE: S/I SHOWER POT LIGHT: 4 INCH RECESSED SHOWER POT LIGHT COMPLETE WITH SWITCH  IN ADDITION TO STANDARD SHOWER POTLIGHT, ON SAME SWITCH
3017 164,745 04Oct23	1	GARAGE: S/I 220V (50 AMP) RECEPTACLE ON A SEPARATE CIRCUIT  FOR FUTURE CAR CHARGER

**FRAMING**

Invoice	Qty.	Description
3017 164,770 04Oct23	1	KITCHEN; DELETE KITCHEN BULKHEAD, IF POSSIBLE, SITE APPROVAL REQUIRED AND IF MECHANICAL LAYOUTS ALLOW. GAP ABOVE UPPER KITCHEN CABINETS WILL BE PRESENT UNLESS ADDITIONAL CABINETRY IS PURCHASED.
3017 164,775 04Oct23	1	KITCHEN: S/I TALLER UPPER, FURRING PANEL WITH CROWN MOULDING TO CEILING. OPTION ONLY AVAILBLE WITH DELETED BULKHEAD.
3017 164,774 04Oct23	1	PRINCIPAL ENSUITE: S/I RECESSED SHOWER NICHE [SHAMPOO SHELF] - COMPLETE WITH MATCHING STONE ON 4 SIDES, STANDARD TILE, APPROX. 12 X 42 INSTALLED VERTICALLY WITH STONE SHELF DIVIDERS. BASED ON STANDARD FINISHES.

**HVAC**

Invoice	Qty.	Description
3017 164,780 04Oct23	1	KITCHEN: GAS LINE ROUGH-IN - MAIN FLOOR FOR FUTURE GAS APPLIANCE

**INTERIOR DOORS AND TRIM**

Invoice	Qty.	Description
3017 164,784 04Oct23	11	2ND FLOOR: S/I 8FT HIGH DOOR THROUGHOUT SECOND FLOOR IN LIEU OF STANDARD HEIGHT DOOR. PRICE IS PER DOOR

**NETWORK AND WIRING**

Invoice	Qty.	Description
3017 164,788 04Oct23	1	GREAT ROOM: S/I ADDITIONAL RG6 HIGH SPEED TV / INTERNET OUTLETS  SEE PLAN FOR LOCATION
3017 164,789 04Oct23	1	GREAT ROOM: S/I CONDUIT PIPE FOR WALL MOUNT TV   LOCATED APPROX. 66" A.F.F. ABOVE FIREPLACE TO CABLE LOCATION. SEE PLAN FOR LOCATION.
3017 164,794 04Oct23	1	S/I SECURITY PACKAGE - ROUGH - IN WIRING FOR: 1 RING DOOR BELL + 2 CAMERAS - 1 AT FRONT AND 1 AT REAR. COMPONENTS NOT INCLUDED. (CAT6)

**PLUMBING**

Invoice	Qty.	Description
3017 164,798 04Oct23	1	KITCHEN: S/I ROUGH-IN 1/4" COLD WATER LINE TO FRIDGE
3017 04Oct23 NoCat	1	PRINCIPAL ENSUITE: UPGRADE TO MOEN 'ALIGN' SUITE INCLUDING RAIN SHOWER + TUB FILLER + LAV FAUCET x2

M  
THE MANORS

# The Stanford Manor

3-4 BEDROOMS | 4.5 BATHROOMS

ELEV. A 2922 SQ.FT.  
INCLUDES 687 SQ.FT. OF FINISHED BASEMENT

ELEV. B 2926 SQ.FT.  
INCLUDES 687 SQ.FT. OF FINISHED BASEMENT

END 1 A 2967 SQ.FT.  
INCLUDES 684 SQ.FT. OF FINISHED BASEMENT


END 1 B 2970 SQ.FT.  
INCLUDES 684 SQ.FT. OF FINISHED BASEMENT

END 2 A 2954 SQ.FT.  
INCLUDES 695 SQ.FT. OF FINISHED BASEMENT

END 2 B 2954 SQ.FT.  
INCLUDES 695 SQ.FT. OF FINISHED BASEMENT

CORNER A 2967 SQ.FT.  
INCLUDES 694 SQ.FT. OF FINISHED BASEMENT

TM-1-2  
SEPT 27, 2023

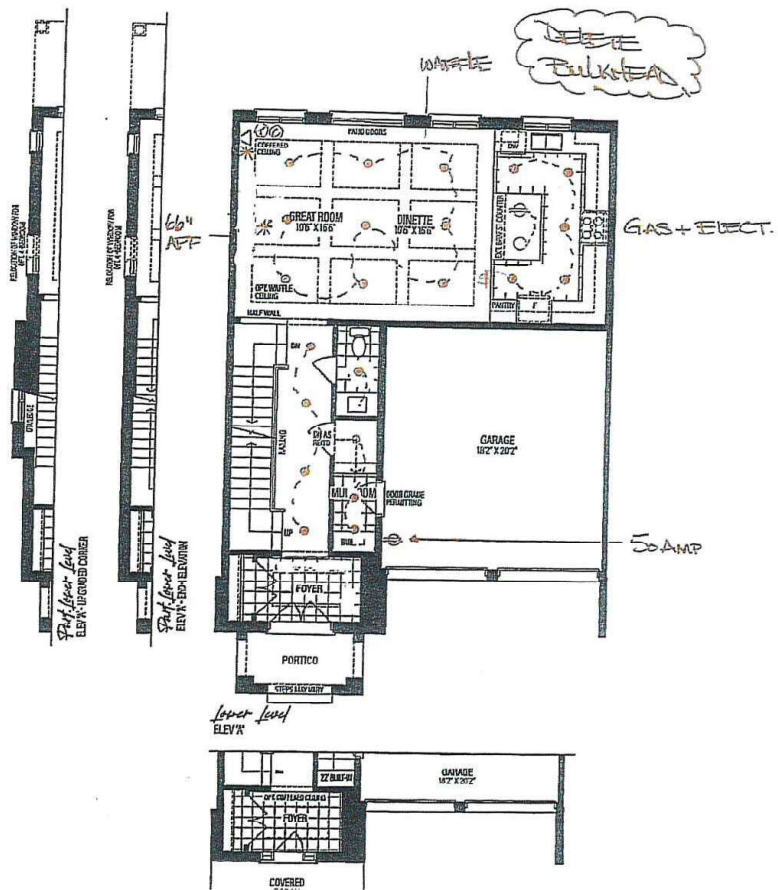



# The Stanford Manor

3-4 BEDROOMS | 4.5 BATHROOMS

**ELEV. A 2922** SQ.FT.  
INCLUDES 687 SQ.FT. OF FINISHED BASEMENT

**ELEV. B 2926** SQ.FT.  
INCLUDES 687 SQ.FT. OF FINISHED BASEMENT

TM- 1-2  
SEPT 27, 2023

**END 1 A 2967** SQ.FT.  
INCLUDES 694 SQ.FT. OF FINISHED BASEMENT



**END 1 B 2970** SQ.FT.  
INCLUDES 694 SQ.FT. OF FINISHED BASEMENT

**END 2 A 2954** SQ.FT.  
INCLUDES 695 SQ.FT. OF FINISHED BASEMENT

**END 2 B 2954** SQ.FT.  
INCLUDES 695 SQ.FT. OF FINISHED BASEMENT

**CORNER A 2967** SQ.FT.  
INCLUDES 694 SQ.FT. OF FINISHED BASEMENT

8' DOORS  
ON 2ND FLOOR

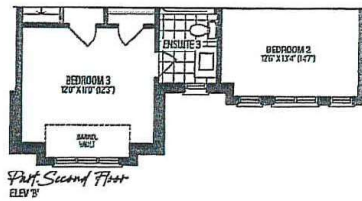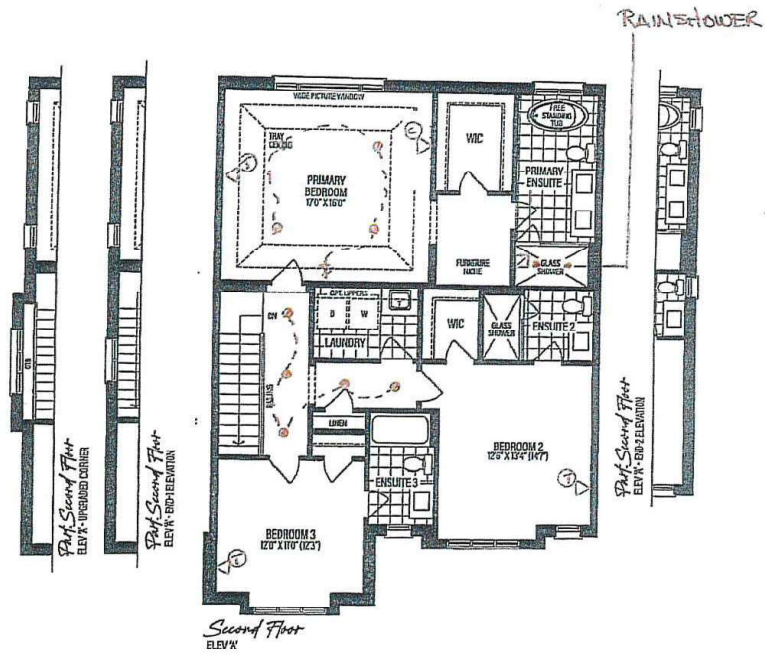

**ELEV. A 2922** SQ.FT.  
INCLUDES 687 SQ.FT. OF FINISHED BASEMENT

**ELEV. B 2926** SQ.FT.  
INCLUDES 687 SQ.FT. OF FINISHED BASEMENT

TM-12  
SEPT 27, 2023


**END 1 A 2967** SQ.FT.  
INCLUDES 694 SQ.FT. OF FINISHED BASEMENT

**END 1 B 2970** SQ.FT.  
INCLUDES 694 SQ.FT. OF FINISHED BASEMENT

**END 2 A 2954** SQ.FT.  
INCLUDES 695 SQ.FT. OF FINISHED BASEMENT

**END 2 B 2954** SQ.FT.  
INCLUDES 695 SQ.FT. OF FINISHED BASEMENT

**CORNER A 2967** SQ.FT.  
INCLUDES 694 SQ.FT. OF FINISHED BASEMENT

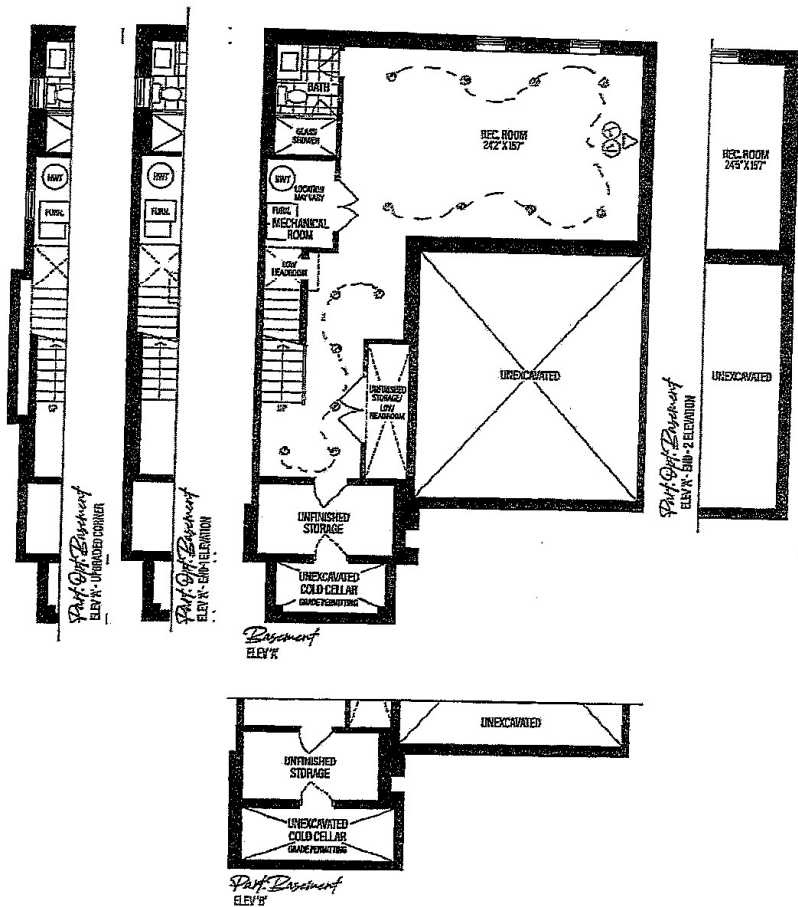



THE MAÑORS  
AT PINE VALLEY

## PLUMBING UPGRADES

### ALIGN

Ceiling Mount: 226651 (12" Arm)



**Brushed Gold**



Brushed Nickel



Chrome



Matte Black



Date: <i>September 07, 2023</i>	Lot: <i>TM-B1-2</i>
Location: <i>Principal Ensuite</i>	
Signature:	Signature:

**Shower with 3-Function Transfer Valve/Trim and Slide Bar with Hand Shower + 7" Rain Showerhead From Ceiling on 12" Arm**  
 (includes plumbing provision for ceiling mount showerhead)  
 Model T2192EP/UT4191/3887EP/226651/S176/U361CI/  
 62320/A725

**GOLDPARK**  
 WORTH MORE™

# ALIGN



\*includes Tub Drain Half Kit

- Brushed Gold
- Brushed Nickel
- Chrome
- Matte Black

Date: September 07, 2023	Lot: TM-BT-2
Location: Principal Ensuite	
Signature:	Signature:

Two Handle Roman Tub  
Model T393/4796



# ALIGN



- Brushed Gold  x 2.
- Brushed Nickel
- Chrome
- Matte Black

Date: September 08, 2023	Lot: TM-21-2
Location: Principal Ensuite	
Signature:	Signature: