

**CROWN MOULDING**

Invoice	Qty.	Description
3124 13Nov23 NoCat	1	GREAT ROOM: ADD 9-BOX WAFFLE CEILING. MODERN STYLE #CTR-B59

**ELECTRICAL**

Invoice	Qty.	Description
3124 164,749 13Nov23	8	BASEMENT REC ROOM: S/I 4" E/S LED INTERIOR POT LIGHT - EACH. WHITE  IN LIEU OF STANDARD CEILING LIGHTS, USE STANDARD SWITCHES. SEE PLAN FOR LOCATION
3124 164,749 13Nov23	6	BASEMENT HALLWAY: S/I 4" E/S LED INTERIOR POT LIGHT - EACH. WHITE  IN LIEU OF STANDARD CEILING LIGHTS, USE STANDARD SWITCHES. SEE PLAN FOR LOCATION
3124 164,749 13Nov23	4	MAIN HALL: S/I 4" E/S LED INTERIOR POT LIGHT -EACH. WHITE  IN LIEU OF STANDARD CEILING LIGHTS, USE STANDARD SWITCHES. SEE PLAN FOR LOCATION
3124 164,749 13Nov23	3	MUD ROOM: S/I 4" E/S INTERIOR POT LIGHT - EACH. WHITE  IN LIEU OF STANDARD CEILING LIGHTS, USE STANDARD SWITCHES. SEE PLAN FOR LOCATION
3124 164,749 13Nov23	5	KITCHEN: S/I 4" E/S LED INTERIOR POT LIGHT - EACH. WHITE  IN ADDITION TO STANDARD CEILING LIGHTS. SEE PLAN FOR LOCATION
3124 164,752 13Nov23	1	KITCHEN: S/I ADDITIONAL INTERIOR SWITCH. SINGLE POLE  FOR POTLIGHTS
3124 164,741 13Nov23	1	KITCHEN: RELOCATE STANDARD CEILING MOUNT FIXTURE  LOCATE APPROX CENTERED ABOVE ISLAND, SEE PLAN FOR LOCATION
3124 164,753 13Nov23	1	KITCHEN: S/I ADDITIONAL REINFORCED CEILING OUTLET. SUPPORTS UP TO APPROX. 40 LBS.  LOCATE APPROX CENTERED ABOVE ISLAND, ON SAME SWITCH AS STANDARD CEILING LIGHT, SEE PLAN FOR LOCATION
3124 164,743 13Nov23	1	KITCHEN: S/I 110V WALL RECEPTACLE ON SEPARATE CIRCUIT  FOR GAS APPLIANCE
3124 164,749 13Nov23	8	GREAT ROOM: S/I 4" E/S LED INTERIOR POT LIGHT - GROUND FLOOR - EACH. WHITE  INCLUDED IN APS, SEE PLAN FOR LOCATION. INCLUDES 1 SWITCH
3124 164,749 13Nov23	1	GREAT ROOM: S/I 4" E/S LED INTERIOR POT LIGHT - EACH. WHITE  ON SAME SWITCH AS OTHER POTLIGHTS. SEE PLAN FOR LOCATION

**ELECTRICAL**

Invoice	Qty.	Description
3124 164,743 13Nov23	1	GREAT ROOM: S/I 110V WALL RECEPTACLE ON SEPARATE CIRCUIT  LOCATE APPROX 66" A.F.F. SEE PLAN FOR LOCATION
3124 164,749 13Nov23	1	POWDER ROOM: S/I 4" E/S LED INTERIOR POT LIGHT - EACH. WHITE  IN ADDITION TO STANDARD LIGHT, ON SAME SWITCH, SEE PLAN FOR LOCATION
3124 164,749 13Nov23	5	UPPER HALL: S/I 4" E/S LED INTERIOR POT LIGHT - EACH. WHITE  IN LIEU OF STANDARD CEILING LIGHTS, USE STANDARD SWITCHES. SEE PLAN FOR LOCATION
3124 164,749 13Nov23	4	PRINCIPAL BEDROOM: S/I 4" E/S LED INTERIOR POT LIGHT - EACH. WHITE  IN ADDITION TO STANDARD CEILING LIGHTS. SEE PLAN FOR LOCATION
3124 164,752 13Nov23	1	PRINCIPAL BEDROOM: S/I ADDITIONAL INTERIOR SWITCH. SINGLE POLE  FOR POTLIGHTS
3124 164,761 13Nov23	1	PRINCIPAL ENSUITE: S/I SHOWER POT LIGHT: 4 INCH RECESSED SHOWER POT LIGHT COMPLETE WITH SWITCH  IN ADDITION TO STANDARD SHOWER POTLIGHT, ON SAME SWITCH
3124 164,747 13Nov23	1	GARAGE: S/I 240V (50 AMP) RECEPTACLE ON A SEPARATE CIRCUIT  FOR FUTURE CAR CHARGER

**FORMING**

Invoice	Qty.	Description
3123 164,803 13Nov23	1	BASEMENT: S/I BACK -FLOW PREVENTER VALVE (BASEMENT)

**FRAMING**

Invoice	Qty.	Description
3124 164,770 13Nov23	1	KITCHEN: DELETE KITCHEN BULKHEAD, IF POSSIBLE. SITE APPROVAL REQUIRED AND IF MECHANICAL LAYOUTS ALLOW. GAP ABOVE UPPER KITCHEN CABINETS WILL BE PRESENT UNLESS ADDITIONAL CABINETRY IS PURCHASED.
3124 164,775 13Nov23	1	KITCHEN: S/I TALLER UPPER, FURRING PANEL WITH CROWN MOULDING TO CEILING. OPTION ONLY AVAILABLE WITH DELETED BULKHEAD.
3124 164,774 13Nov23	1	PRINCIPAL ENSUITE: S/I RECESSED SHOWER NICHE [SHAMPOO SHELF] - COMPLETE WITH MATCHING STONE ON 4 SIDES, STANDARD TILE, APPROX. 12 X 42" INSTALLED VERTICALLY WITH STONE SHELF DIVIDERS. BASED ON STANDARD FINISHES.

**HVAC**

Invoice	Qty.	Description
3124 164,780 13Nov23	1	KITCHEN: GAS LINE ROUGH-IN - MAIN FLOOR FOR FUTURE GAS APPLIANCE

**INTERIOR DOORS AND TRIM**

Invoice	Qty.	Description
3124 164,784 13Nov23	11	2ND FLOOR: S/I 8FT HIGH DOOR THROUGHOUT SECOND FLOOR IN LIEU OF STANDARD HEIGHT DOOR. PRICE IS PER DOOR

**NETWORK AND WIRING**

Invoice	Qty.	Description
3124 164,788 13Nov23	1	GREAT ROOM: S/I ADDITIONAL RG6 HIGH SPEED TV / INTERNET OUTLETS  SEE PLAN FOR LOCATION
3124 164,789 13Nov23	1	GREAT ROOM: S/I CONDUIT PIPE FOR WALL MOUNT TV   LOCATED APPROX. 66" A.F.F. TO CABLE LOCATION. SEE PLAN FOR LOCATION.
3124 164,794 13Nov23	1	EXTERIOR: S/I SECURITY PACKAGE - ROUGH - IN WIRING FOR: 1 RING DOOR BELL + 2 CAMERAS - 1 AT FRONT AND 1 AT REAR. COMPONENTS NOT INCLUDED. (CAT6)

**PLUMBING**

Invoice	Qty.	Description
3124 164,798 13Nov23	1	KITCHEN: S/I ROUGH-IN 1/4" COLD WATER LINE TO FRIDGE
3124 13Nov23 NoCat	1	PRINCIPAL ENSUITE: UPGRADE TO MOEN 'ALIGN' SUITE INCLUDING RAIN SHOWER + TUB FILLER + LAV FAUCET x2

**WINDOWS - BASEMENT**

Invoice	Qty.	Description
3123 164,801 13Nov23	2	BASEMENT: S/I BASEMENT WINDOW SIZE 30" X 24" IN LIEU OF STANDARD - WHITE. WINDOW WELLS MAY BE REQUIRED.



THE MANORS  
AT PINE VALLEY

## PLUMBING UPGRADES

### ALIGN

Ceiling Mount: 226651 (12" Arm)



Brushed Gold



Brushed Nickel



Chrome



Matte Black



Date: Nov 9 2023	Lot: TM-2-3
Location: Principal Ensuite	
Signature:	Signature:

**Shower with 3-Function Transfer Valve/Trim  
and Slide Bar with Hand Shower + 7" Rain  
Showerhead From Ceiling on 12" Arm**  
(includes plumbing provision for ceiling mount showerhead)  
Model T2192EP/UT4191/3887EP/226651/S176/U361CI/  
62320/A725

**GOLDPARK**  
WORTH MORE™

ALIGN



\*includes Tub Drain Half Kit

- Brushed Gold ☐
- Brushed Nickel ☐
- Chrome ☐
- Matte Black ☒

Date: Nov 9 2023	Lot: TM-2-3
Location: Principal Ensuite	
Signature:	Signature:



THE MANORS  
AT PINE VALLEY

## PLUMBING UPGRADES

### ALIGN



Brushed Gold



Brushed Nickel



Chrome



Matte Black



Date: Nov 9 2023	Lot: TM-2-3
Location: Principal Ensuite	
Signature:	Signature:

Two Handle 8" Widespread Lav  
Model T6193/69000

**GOLDPARK**  
WORTH MORE™

THE MANORS  
AT FINE HOUSES

The Stanford Manor

3-4 BEDROOMS | 4.5 BATHROOMS

**ELEV. A 2922** SQ.FT.  
INCLUDES 687 SQ.FT. OF FINISHED BASEMENT

**ELEV. B 2926<sub>SQ.FT.</sub>**  
**INCLUDES 687 SQ.FT. OF FINISHED BASEMENT**

TM-2-3

NOV 9 2023

**END 1 A 2967** SQ.FT.  
INCLUDES 694 SQ.FT. OF FINISH

**INCLUDES 694 SQ.FT. OF FINISHED BASEMENT**

**END 1 B 2970** SQ.FT.  
INCLUDES 694 SQ.FT. OF FINISH

INCLUDES 694 SQ.FT. OF FINISHED BASEMENT

**END 2 A 2954** SQ.FT.  
INCLUDES 695 SQ.FT. OF FINISHED BASEMENT


INCLUDES 695 SQ.FT. OF FINISHED BASEMENT

END 2 B 2954 SQ.FT.  
INCLUDES 695 SQ.FT. OF FINISHED BASEMENT

INCLUDES 695 SQ.FT. OF FINISHED BASEMENT

**CORNER A 2967 SQ.FT.**  
INCLUDES 694 SQ.FT. OF FINISHED BASEMENT

INCLUDES 694 SQ.FT. OF FINISHED BASEMENT

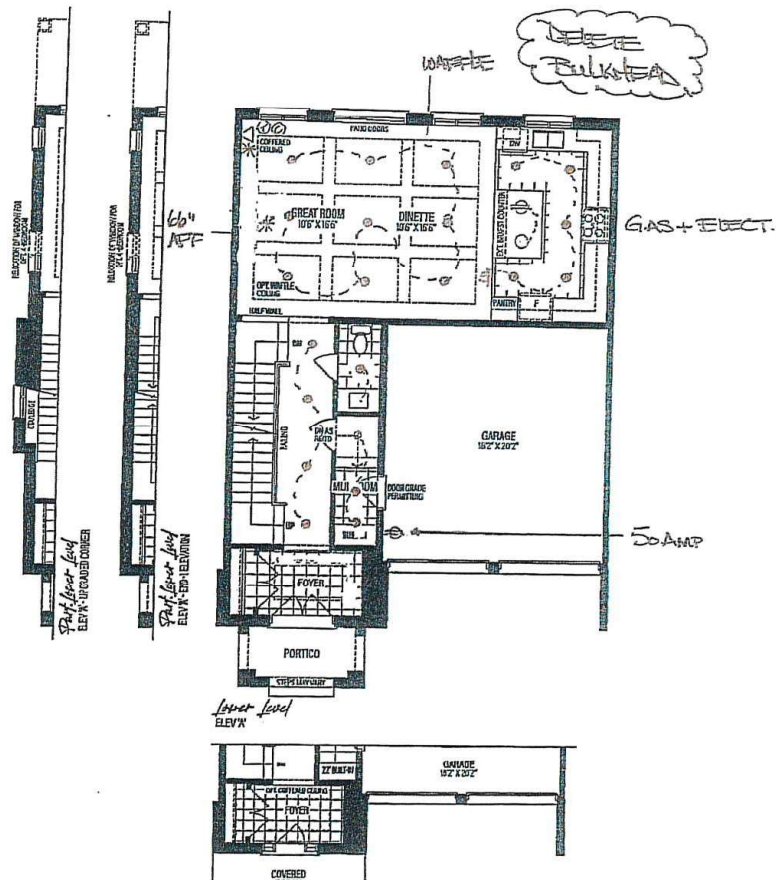

*M*  
THE MANORS  
AT FINE VALLEY

# The Stanford Manor

3-4 BEDROOMS | 4.5 BATHROOMS

ELEV. A 2922 SQ.FT.  
INCLUDES 687 SQ.FT. OF FINISHED BASEMENT

ELEV. B 2926 SQ.FT.  
INCLUDES 687 SQ.FT. OF FINISHED BASEMENT

TM-2-3  
NOV 9 2023

END 1 A 2967 SQ.FT.  
INCLUDES 694 SQ.FT. OF FINISHED BASEMENT


END 1 B 2970 SQ.FT.  
INCLUDES 694 SQ.FT. OF FINISHED BASEMENT

END 2 A 2954 SQ.FT.  
INCLUDES 695 SQ.FT. OF FINISHED BASEMENT

END 2 B 2954 SQ.FT.  
INCLUDES 695 SQ.FT. OF FINISHED BASEMENT

CORNER A 2967 SQ.FT.  
INCLUDES 694 SQ.FT. OF FINISHED BASEMENT

8' DOORS  
ON 2ND FLOOR

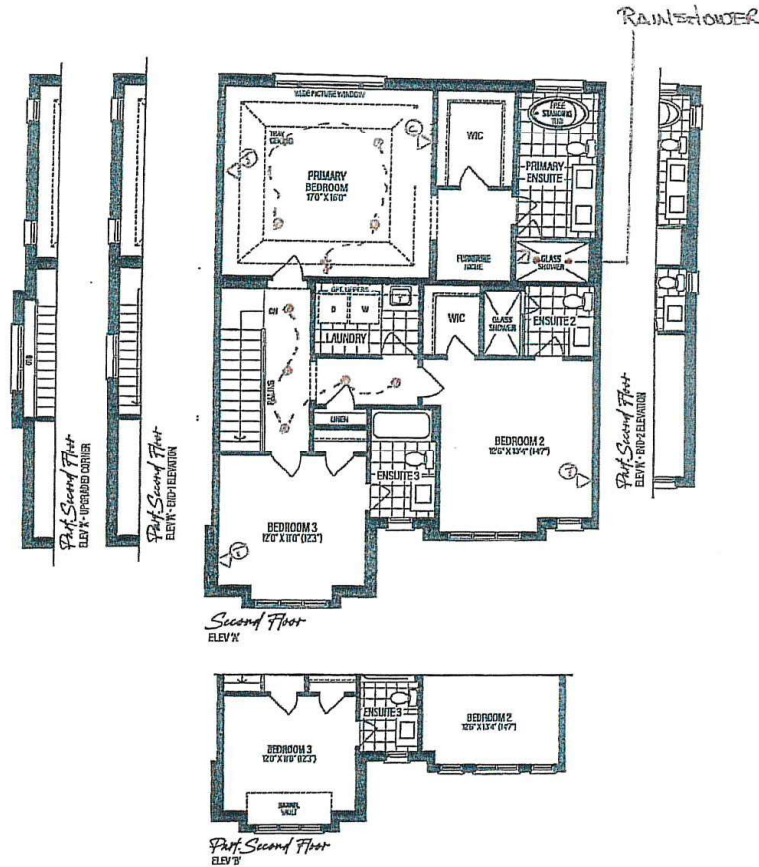



*M*  
THE MANORS  
AT FIRST GALLERY

# The Stanford Manor

3-4 BEDROOMS | 4.5 BATHROOMS

ELEV. A 2922 SQ.FT.  
INCLUDES 687 SQ.FT. OF FINISHED BASEMENT

→ ELEV. B 2926 SQ.FT.  
INCLUDES 687 SQ.FT. OF FINISHED BASEMENT

TM-2-3  
NOV 9 2023

END 1 A 2967 SQ.FT.  
INCLUDES 694 SQ.FT. OF FINISHED BASEMENT

END 1 B 2970 SQ.FT.  
INCLUDES 694 SQ.FT. OF FINISHED BASEMENT

END 2 A 2954 SQ.FT.  
INCLUDES 695 SQ.FT. OF FINISHED BASEMENT

END 2 B 2954 SQ.FT.  
INCLUDES 695 SQ.FT. OF FINISHED BASEMENT

CORNER A 2967 SQ.FT.  
INCLUDES 694 SQ.FT. OF FINISHED BASEMENT

