

CROWN MOULDING

Invoice	Qty.	Description
3049 28Nov23 NoCat	1	GREAT ROOM: ADD 9-BOX WAFFLE CEILING - CTR-BO7

DRYWALL

Invoice	Qty.	Description
3049 164,468 28Nov23	1	GREAT ROOM: S/I COFFERED CEILING (OPTIONAL PER ROOM) DOUBLE HEIGHT

ELECTRICAL

Invoice	Qty.	Description
3049 164,494 28Nov23	1	KITCHEN: S/I 240V (50 AMP) RECEPTACLE ON A SEPARATE CIRCUIT FOR WALL OVEN
3049 164,498 28Nov23	8	KITCHEN: S/I 4" E/S LED INTERIOR POT LIGHT - GROUND FLOOR - EACH. WHITE INCLUDED IN APS, SEE PLAN FOR LOCATION - INCLUDES 1 SWITCH
3049 164,480 28Nov23	1	KITCHEN: RELOCATE STANDARD CEILING MOUNT FIXTURE LOCATE APPROX CENTERED ABOVE ISLAND, SEE PLAN FOR LOCATION
3049 164,510 28Nov23	1	KITCHEN: S/I ADDITIONAL REINFORCED CEILING OUTLET. SUPPORTS UP TO APPROX. 40 LBS. LOCATE APPROX CENTERED ABOVE ISLAND, SAME SWITCH AS STANDARD. SEE PLAN FOR LOCATION
3049 164,484 28Nov23	1	KITCHEN: S/I 110V WALL RECEPTACLE ON SEPARATE CIRCUIT FOR GAS APPLIANCE
3049 164,498 28Nov23	4	BREAKFAST ROOM: S/I 4" E/S LED INTERIOR POT LIGHT - GROUND FLOOR - EACH. WHITE IN ADDITION TO STANDARD CEILING LIGHT, SEE PLAN FOR LOCATION
3049 164,484 28Nov23	1	GREAT ROOM: S/I 110V WALL RECEPTACLE ON SEPARATE CIRCUIT LOCATE APPROX 66" A.F.F. FOR FUTURE TV ABOVE FIREPLACE
3049 164,498 28Nov23	4	SERVERY: S/I 4" E/S LED INTERIOR POT LIGHT - GROUND FLOOR - EACH. WHITE IN LIEU OF STANDARD CEILING LIGHT, USE STANDARD SWITCH. SEE PLAN FOR LOCATION
3049 164,508 28Nov23	1	BREAKFAST: S/I ADDITIONAL INTERIOR SWITCH. SINGLE POLE FOR POTLIGHTS
3049 164,508 28Nov23	1	GREAT ROOM: S/I ADDITIONAL INTERIOR SWITCH. SINGLE POLE FOR POTLIGHTS

ELECTRICAL

Invoice	Qty.	Description
3049 164,498 28Nov23	8	GREAT ROOM: S/I 4" E/S LED INTERIOR POT LIGHT - HIGH-LITES - EACH. WHITE IN ADDITION TO STANDARD CEILING LIGHT. SEE PLAN FOR LOCATION
3049 164,498 28Nov23	6	MAIN HALL: S/I 4" E/S LED INTERIOR POT LIGHT - GROUND FLOOR - EACH. WHITE IN LIEU OF STANDARD CEILING LIGHT, USE STANDARD SWITCH. SEE PLAN FOR LOCATION
3049 164,498 28Nov23	4	LIBRARY: S/I 4" E/S LED INTERIOR POT LIGHT - GROUND FLOOR - EACH. WHITE IN LIEU OF STANDARD CEILING LIGHT, USE STANDARD SWITCH. SEE PLAN FOR LOCATION
3049 164,530 28Nov23	1	FOYER: S/I HINGED SWITCH - EACH INCLUDES 1 LED POTLIGHT
3049 164,494 28Nov23	1	GARAGE: S/I 240V (50 AMP) RECEPTACLE ON A SEPARATE CIRCUIT FOR FUTURE CAR CHARGER
3049 164,500 28Nov23	5	UPPER HALL: S/I 4" E/S LED INTERIOR POT LIGHT (INSULATED CEILING) - SECOND FLOOR - EACH. WHITE IN LIEU OF STANDARD CEILING LIGHT, USE STANDARD SWITCH. SEE PLAN FOR LOCATION
3049 164,500 28Nov23	8	PRINCIPAL BEDROOM: S/I 4" E/S LED INTERIOR POT LIGHT (INSULATED CEILING) - SECOND FLOOR - EACH. WHITE SEE PLAN FOR LOCATION
3049 164,508 28Nov23	1	PRINCIPAL BEDROOM: S/I ADDITIONAL INTERIOR SWITCH. SINGLE POLE FOR POTLIGHTS
3049 164,510 28Nov23	1	PRINCIPAL ENSUITE: S/I ADDITIONAL REINFORCED CEILING OUTLET. SUPPORTS UP TO APPROX. 40 LBS. LOCATE APPROX CENTERED ABOVE TUB
3049 164,508 28Nov23	1	PRINCIPAL ENSUITE: S/I ADDITIONAL INTERIOR SWITCH. SINGLE POLE FOR LIGHT ABOVE TUB
3049 164,500 28Nov23	6	PRINCIPAL ENSUITE WIC: S/I 4" E/S LED INTERIOR POT LIGHT (INSULATED CEILING) - SECOND FLOOR - EACH. WHITE IN ADDITION TO STANDARD CEILING LIGHT, ON SAME SWITCH. SEE PLAN FOR LOCATION
3049 164,500 28Nov23	8	PRINCIPAL BEDROOM WIC: S/I 4" E/S LED INTERIOR POT LIGHT (INSULATED CEILING) - SECOND FLOOR - EACH. WHITE IN LIEU OF STANDARD CEILING LIGHT, USE STANDARD SWITCH. SEE PLAN FOR LOCATION
3049 164,540 28Nov23	1	PRINCIPAL ENSUITE: S/I SHOWER POT LIGHT: 4 INCH RECESSED SHOWER POT LIGHT COMPLETE WITH SWITCH IN ADDITION TO STANDARD SHOWER POTLIGHT, ON SAME SWITCH

ELECTRICAL

Invoice	Qty.	Description
3049 164,498 28Nov23	4	DINING ROOM: S/I 4" E/S LED INTERIOR POT LIGHT - GROUND FLOOR - EACH. WHITE IN ADDITION TO STANDARD CEILING LIGHT, SEE PLAN FOR LOCATION
3049 164,484 28Nov23	1	SERVERY: S/I 110V WALL RECEPTACLE ON SEPARATE CIRCUIT FOR FUTURE WINE FRIDGE
3049 164,508 28Nov23	1	DINING ROOM: S/I ADDITIONAL INTERIOR SWITCH. SINGLE POLE FOR POTLIGHTS

FORMING

Invoice	Qty.	Description
3048 164,628 04Oct23	1	BASEMENT: S/I BACK -FLOW PREVENTER VALVE (BASEMENT)

FRAMING

Invoice	Qty.	Description
3049 28Nov23 NoCat	1	**CUSTOM LAYOUT** DINING/MAIN HALL: DELETE STANDARD COFFERED CEILING AT DINING AND MAIN HALL - SEE PLAN FOR LOCATION
3049 164,638 28Nov23	2	PRINCIPAL ENSUITE: S/I RECESSED SHOWER NICHE [SHAMPOO SHELF] - COMPLETE WITH MATCHING STONE ON 4 SIDES, STANDARD TILE, APPROX. 12 X 42 INSTALLED VERTICALLY WITH STONE SHELF DIVIDERS - BASED ON STANDARD FINISHES.

HVAC

Invoice	Qty.	Description
3049 164,652 28Nov23	1	KITCHEN: GAS LINE ROUGH-IN - MAIN FLOOR FOR COOKTOP
3049 164,660 28Nov23	1	KITCHEN: S/I KITCHEN - UPGRADE TO 8" DUCT IN LIEU OF STANDARD OFFERING

INTERIOR DOORS AND TRIM

Invoice	Qty.	Description
3049 164,672 28Nov23	17	2ND FLOOR: S/I 8FT HIGH DOOR THROUGHOUT SECOND FLOOR IN LIEU OF STANDARD HEIGHT DOOR. PRICE IS PER DOOR

NETWORK AND WIRING

Invoice	Qty.	Description
3049 164,694 28Nov23	1	GREAT ROOM: S/I ADDITIONAL CAT6 ETHERNET OUTLET SEE PLAN FOR LOCATION
3049 164,698 28Nov23	1	GREAT ROOM: S/I CONDUIT PIPE FOR WALL MOUNT TV LOCATED APPROX. 66" A.F.F. ABOVE FIREPLACE THROUGH BASEMENT TO CABLE LOCATION. SEE PLAN FOR LOCATION.
3049 164,694 28Nov23	1	LIBRARY: S/I ADDITIONAL CAT6 ETHERNET OUTLET
3049 164,704 28Nov23	1	EXTERIOR: S/I - SECURITY PACKAGE: ROUGH IN WIRING FOR 4 CAMERAS + VIDEO DOOR BELL. COMPONENTS NOT INCLUDED. (CAT6)

PLUMBING

Invoice	Qty.	Description
3049 28Nov23 NoCat	1	PRINCIPAL ENSUITE: UPGRADE TO MOEN 'ALIGN' SUITE INCLUDING RAIN SHOWER + TUB FILLER + LAV FAUCETx2

WINDOWS - BASEMENT

Invoice	Qty.	Description
3048 164,734 04Oct23	6	BASEMENT: S/I BASEMENT WINDOW SIZE 30" X 24" IN LIEU OF STANDARD - 10" WHITE. WINDOW WELLS MAY BE REQUIRED. 50'S & 60'S

WINDOWS AND DOORS

Invoice	Qty.	Description
3049 164,736 28Nov23	1	BREAKFAST: INCREASE EXISTING PATIO SLIDING DOOR TO APPROX 96"- TRANSOM MAY BE REQUIRED

SCHEDULE 'F'




TJ2-72
Nov 27 2023

The Timberland

Elevation A = 5,034 sq.ft.

LOT 72

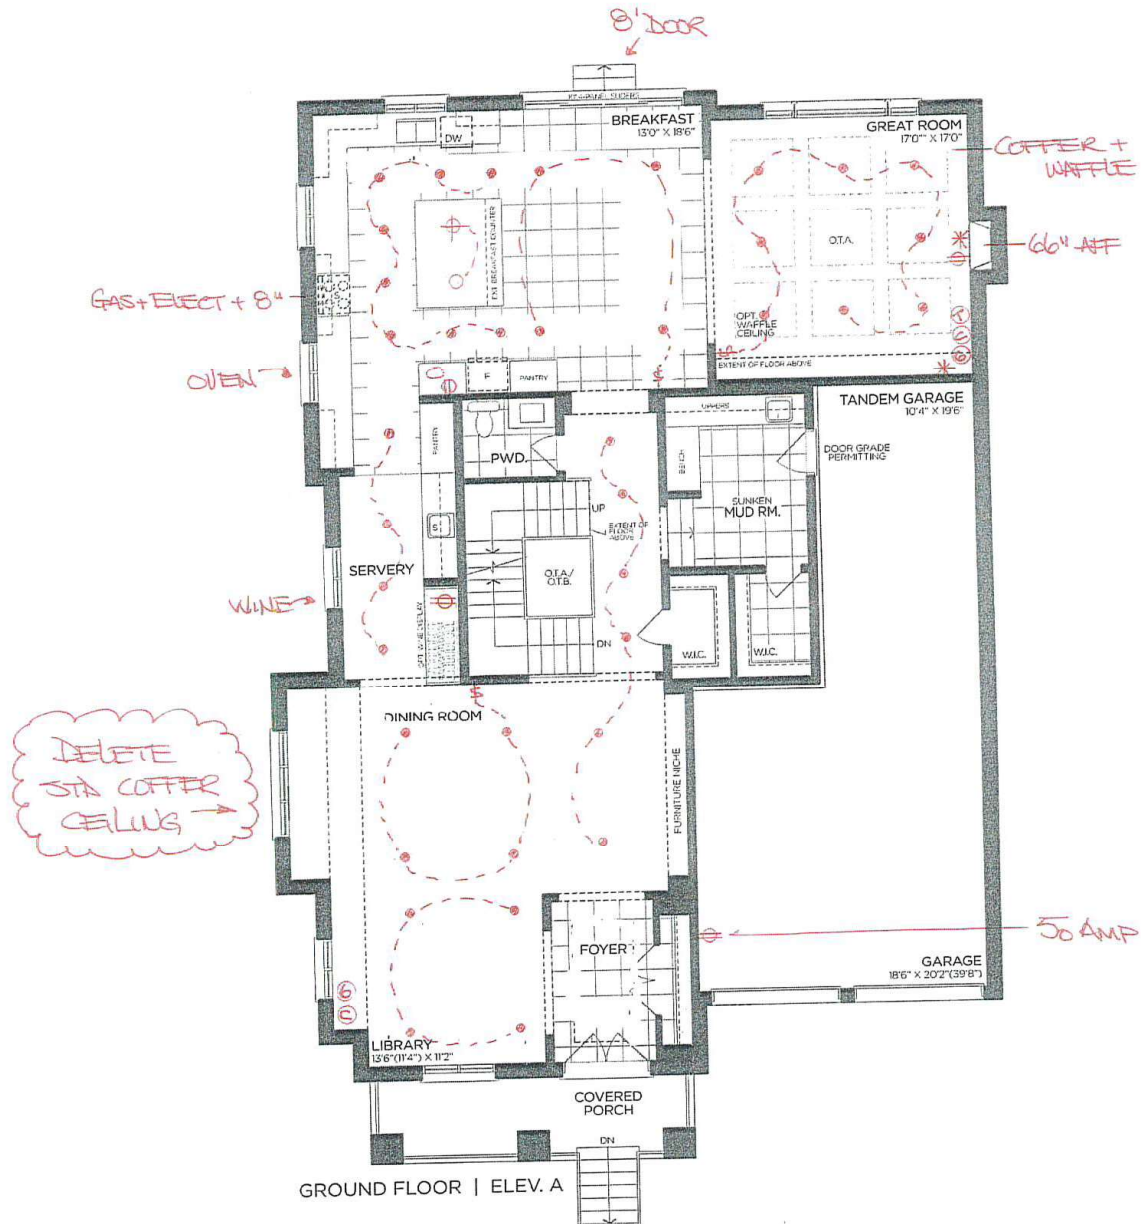

VENDOR

PURCHASER

PURCHASER

GOLD PARK
WORTH MORE™

Prices, figures, illustrations, sizes, features and finishes are subject to change without notice. Areas and dimensions are approximate and actual usable floor space may vary from the stated area. Layout may be reverse of the unit purchased. E. & O.E. 5011

SCHEDULE 'F'

PV-72
Nov 27 2023




The Timberland

Elevation A • 5,034 sq.ft.

LOT 72

8' Doors
2nd Floor

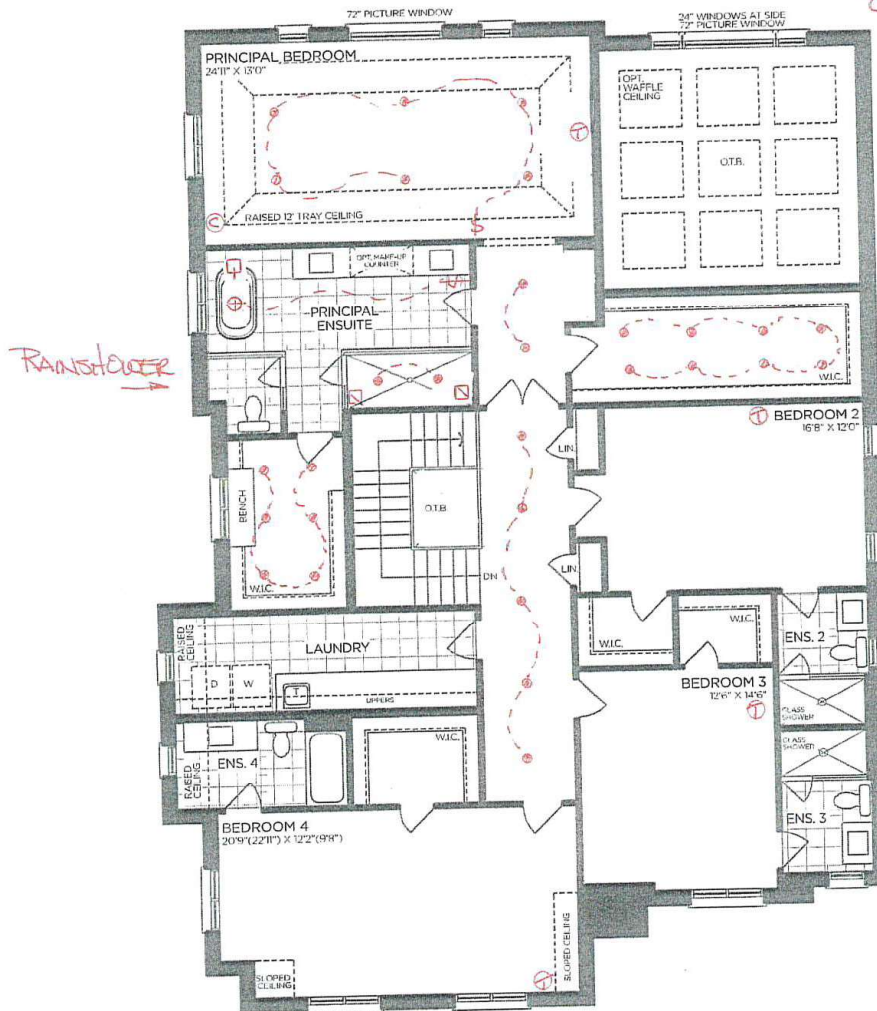

SECOND FLOOR | ELEV. A

VENDOR

PURCHASER

PURCHASER

GOLD PARK
WORTH MORE™


Prices, figures, illustrations, sizes, features and finishes are subject to change without notice. Areas and dimensions are approximate and actual usable floor space may vary from the stated area. Layout may be reverse of the unit purchased. E. & O.E. 5011

SCHEDULE 'F'

PV2-72
Nov 27 2023

The Timberland
Elevation A • 5,034 sq.ft.

LOT 72

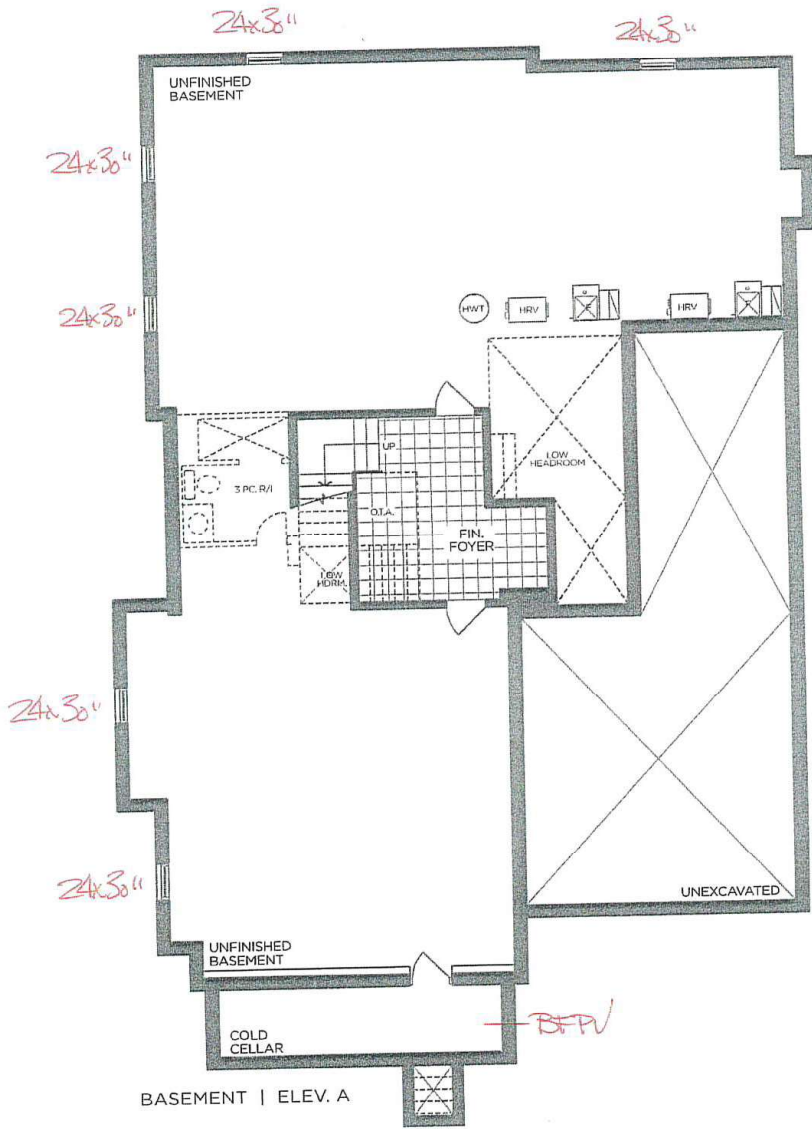

VENDOR

PURCHASER

PURCHASER

GOLDPARK
WORTH MORE™

Prices, figures, illustrations, sizes, features and finishes are subject to change without notice. Areas and dimensions are approximate and actual usable floor space may vary from the stated area. Layout may be reverse of the unit purchased. E. & O.E. 5011

PLUMBING UPGRADES

ALIGN

Ceiling Mount: 226651 (12" Arm)



Brushed Gold

Brushed Nickel

Chrome

Matte Black



Date: Nov 14, 2023	Lot: PV2- 72
Location: Principal Ensuite	
Signature:	Signature:

**Shower with 3-Function Transfer Valve/Trim
 and Slide Bar with Hand Shower + 7" Rain
 Showerhead From Ceiling on 12" Arm**
 (includes plumbing provision for ceiling mount showerhead)
 Model T2192EP/UT4191/3887EP/226651/S176/U361CI/
 62320/A725

GOLDPARK
WORTH MORE™



PINE VALLEY
FOREVERGREEN

PLUMBING UPGRADES

ALIGN



Brushed Gold

Brushed Nickel

Chrome

Matte Black

☐☐☐☒

Date: Nov 14, 2023	Lot: PV2 - 72
Location: Principal Ensuite	
Signature:	Signature:

Freestanding Floor-Mounted Tub Filler
Model 395/TS50100

GOLDPARK
WORTH MORE™





PINE VALLEY
FOREVERGREEN

PLUMBING UPGRADES

ALIGN



Brushed Gold

Brushed Nickel

Chrome

Matte Black



Date: Nov 14, 2023	Lot: PV2-72
Location: Principal Ensuite	
Signature:	Signature:

Two Handle 8" Widespread Lav
Model T6193/69000

GOLD PARK
WORTH MORE™