



CONSTRUCTION SUMMARY

Lot: 15-1

Model: 31-04 B UPG Rosecliff Manor
Project/Phase: The Manors at Pine Valley / 4

ELECTRICAL

Invoice	Qty.	Description
3070 164,749 20Dec23	8	KITCHEN: S/I 4" E/S LED INTERIOR POT LIGHT - EACH. WHITE INCLUDED IN APS, SEE PLAN FOR LOCATION. INCLUDES 1 SWITCH
3070 164,741 20Dec23	1	KITCHEN: RELOCATE STANDARD CEILING MOUNT FIXTURE LOCATE APPROX CENTERED ABOVE ISLAND, SEE PLAN FOR LOCATION
3070 164,753 20Dec23	1	KITCHEN; S/I ADDITIONAL REINFORCED CEILING OUTLET. SUPPORTS UP TO APPROX. 40 LBS. LOCATE APPROX CENTRED ABOVE ISLAND, ON SAME SWITCH AS STANDARD CEILING LIGHT. SEE PLAN FOR LOCATION
3070 164,743 20Dec23	1	KITCHEN: S/I 110V WALL RECEPTACLE ON SEPARATE CIRCUIT FOR GAS APPLIANCE
3070 164,743 20Dec23	1	KITCHEN: S/I S/I 240V (50AMP) RECEPTABLE ON A SEPARATE CIRCUIT FOR WALL OVEN
3070 164,749 20Dec23	1	KITCHEN: S/I 4" E/S LED INTERIOR POT LIGHT - EACH. WHITE ON SAME SWITCH AS STANDARD POTLIGHTS. SEE PLAN FOR LOCATION
3070 164,749 20Dec23	2	POWDER ROOM: S/I 4" E/S LED INTERIOR POT LIGHT - EACH. WHITE IN ADDITION TO STANDARD VANITY LIGHT, ON SAME SWITCH
3070 164,749 20Dec23	4	PRIMARY BEDROOM: S/I 4" E/S LED INTERIOR POT LIGHT - EACH. WHITE IN ADDITION TO STANDARD CEILING LIGHT. SEE PLAN FOR LOCATION
3070 164,752 20Dec23	1	PRIMARY BEDROOM: S/I ADDITIONAL INTERIOR SWITCH. SINGLE POLE FOR POTLIGHTS
3070 164,761 20Dec23	1	PRIMARY ENSUITE: S/I SHOWER POT LIGHT: 4 INCH RECESSED SHOWER POT LIGHT ON SAME SWITCH AS STANDARD SHOWER POT LIGHT. SEE PLAN FOR LOCATION
3070 164,749 20Dec23	6	GREAT ROOM: S/I 4" E/S LED INTERIOR POT LIGHT - EACH. WHITE IN LIEU OF STANDARD CEILING LIGHTS, USE STANDARD SWITCHES. SEE PLAN FOR LOCATION
3070 164,747 20Dec23	1	GARAGE:S/I 240V (50 AMP) RECEPTACLE ON A SEPARATE CIRCUIT FOR CAR CHARGER
3070 164,757 20Dec23	1	FOYER: S/I HINGED SWITCH - EACH INCLUDES 1 LED POTLIGHT



CONSTRUCTION SUMMARY

Lot: 15-1

Model: 31-04 B UPG Rosecliff Manor

Project/Phase: The Manors at Pine Valley / 4

ELECTRICAL

Invoice	Qty.	Description
3070 164,759 20Dec23	4	DINETTE: S/I LED POT LIGHT AT OPEN TO BELOW HIGH CEILING IN LIEU OF STANDARD CEILING LIGHTS, USE STANDARD SWITCHES. SEE PLAN FOR LOCATION
3070 164,749 20Dec23	2	PRIMARY ENSUITE: S/I 4" E/S LED INTERIOR POT LIGHT - EACH. WHITE IN ADDITION TO STANDARD VANITY LIGHT, ON SAME SWITCH
3070 164,749 20Dec23	6	UPPER HALL: S/I 4" E/S LED INTERIOR POT LIGHT - EACH. WHITE IN LIEU OF STANDARD CEILING LIGHTS, USE STANDARD SWITCHES. SEE PLAN FOR LOCATION
3070 164,749 20Dec23	5	BASEMENT: S/I 4" E/S LED INTERIOR POT LIGHT - EACH. WHITE IN LIEU OF STANDARD CEILING LIGHTS, USE STANDARD SWITCHES. SEE PLAN FOR LOCATION
3070 164,749 20Dec23	10	BASEMENT: S/I 4" E/S LED INTERIOR POT LIGHT - EACH. WHITE IN LIEU OF STANDARD CEILING LIGHTS, USE STANDARD SWITCHES. SEE PLAN FOR LOCATION

FORMING

Invoice	Qty.	Description
3070 164,803 20Dec23	1	BASEMENT: S/I BACK -FLOW PREVENTER VALVE (BASEMENT)

FRAMING

Invoice	Qty.	Description
3070 164,775 20Dec23	1	KITCHEN: S/I TALLER UPPER, FURRING PANEL WITH CROWN MOULDING TO CEILING. OPTION ONLY AVAILABLE WITH DELETED BULKHEAD.
3070 164,774 20Dec23	1	PRIMARY ENSUITE: S/I RECESSED SHOWER NICHE [SHAMPOO SHELF] - COMPLETE WITH MATCHING STONE ON 4 SIDES, STANDARD TILE, APPROX. 12 X 42 INSTALLED VERTICALLY WITH STONE SHELF DIVIDERS - MUST SPECIFY LOCATION. BASED ON STANDARD FINISHES.
3070 164,770 20Dec23	1	KITCHEN: DELETE KITCHEN BULKHEAD, IF POSSIBLE. SITE APPROVAL REQUIRED AND IF MECHANICAL LAYOUTS ALLOW. GAP ABOVE UPPER KITCHEN CABINETS WILL BE PRESENT UNLESS ADDITIONAL CABINETRY IS PURCHASED.

HVAC

Invoice	Qty.	Description
3070 164,780 20Dec23	1	KITCHEN: GAS LINE ROUGH-IN - MAIN FLOOR FOR APPLIANCE



CONSTRUCTION SUMMARY

Lot: 15-1

Model: 31-04 B UPG Rosecliff Manor
Project/Phase: The Manors at Pine Valley / 4

INTERIOR DOORS AND TRIM

Invoice	Qty.	Description
3070 164,784 20Dec23	8	2ND FLOOR: S/I 8FT HIGH DOOR THROUGHOUT SECOND FLOOR IN LIEU OF STANDARD HEIGHT DOOR. PRICE IS PER DOOR

NETWORK AND WIRING

Invoice	Qty.	Description
3070 164,787 20Dec23	1	GREAT ROOM: S/I ADDITIONAL CAT6 ETHERNET OUTLET SEE PLAN FOR LOCATION
3070 164,789 20Dec23	1	GREAT ROOM: S/I CONDUIT PIPE FOR WALL MOUNT TV LOCATED APPROX. 66" A.F.F. TERMINATING AT CABLE LOCATION. SEE PLAN FOR LOCATION.
3070 164,794 20Dec23	1	EXTERIOR: S/I SECURITY PACKAGE - ROUGH - IN WIRING FOR: 1 RING DOOR BELL + 2 CAMERAS - 1 AT FRONT AND 1 AT REAR. COMPONENTS NOT INCLUDED. (CAT6)

PLUMBING

Invoice	Qty.	Description
3070 164,798 20Dec23	1	KITCHEN: S/I ROUGH-IN 1/4" COLD WATER LINE TO FRIDGE
3070 20Dec23 NoCat	1	PRINCIPAL ENSUITE: UPGRADE TO MOEN 'ALIGN' SUITE INCLUDING RAIN SHOWER + LAV FAUCET SEE ATTACHED SPEC

WINDOWS - BASEMENT


Invoice	Qty.	Description
3070 164,802 20Dec23	3	BASEMENT: UPGRADE BASEMENT WINDOW TO 24" X 30" IN LIEU OF STANDARD - WHITE. WINDOW WELLS MAY BE REQUIRED.

M
THE MANORS
AT FINE VALLEY

The Rosecliff Manor
3 BEDROOMS | 3.5 BATHROOMS

2856 SQ.FT. ELEV. A&B
INCLUDES 894 SQ.FT. OF FINISHED BASEMENT
2862 SQ.FT. CORNER A
INCLUDES 894 SQ.FT. OF FINISHED BASEMENT

TM-15-1
DEC 15 2023

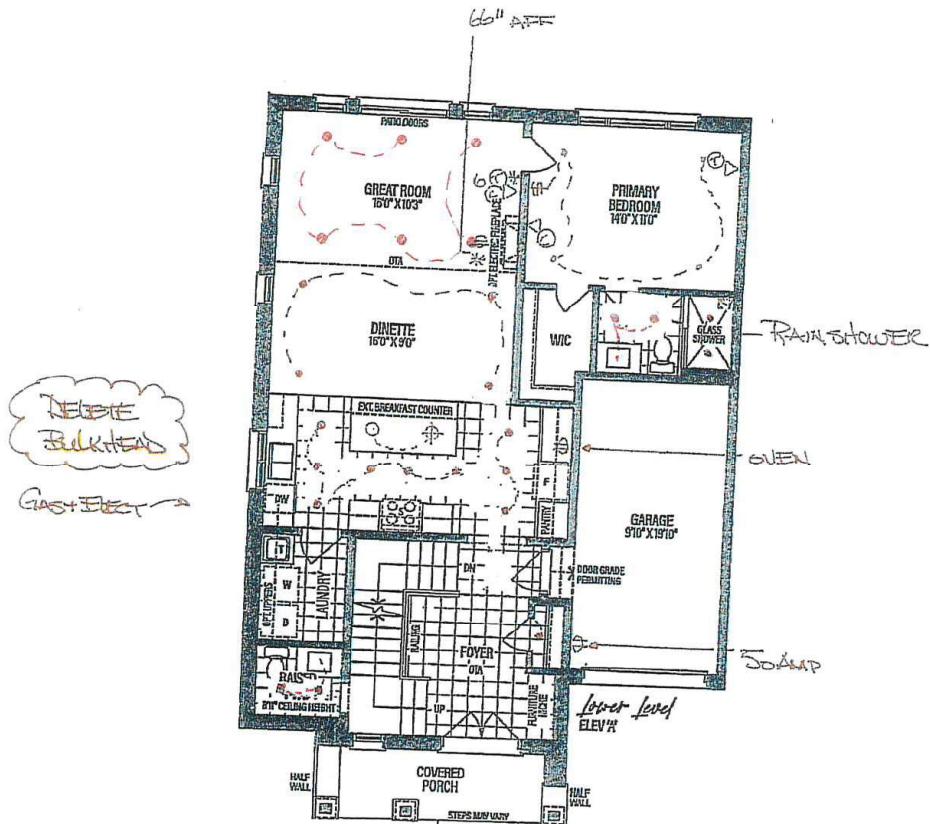




The Rosecliffe Manor

3 BEDROOMS | 3.5 BATHROOMS

2856 SQ.FT. ELEV. A&B
INCLUDES 894 SQ.FT. OF FINISHED BASEMENT
2862 SQ.FT. CORNER A
INCLUDES 894 SQ.FT. OF FINISHED BASEMENT

TH-15-1
Dec 15 2023

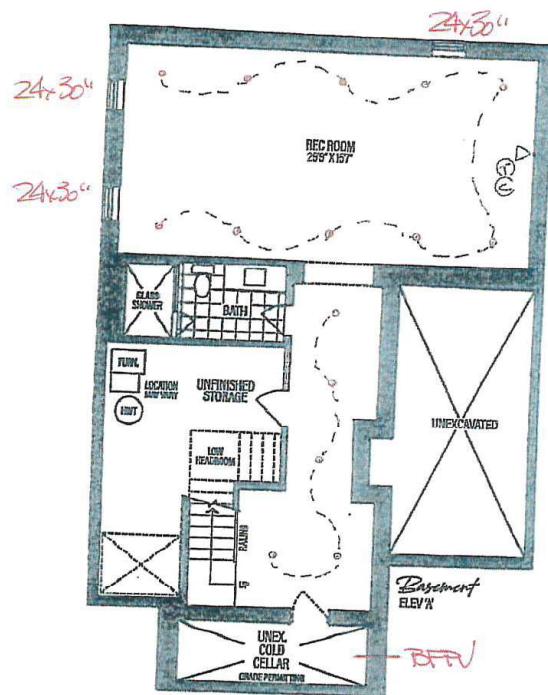


M
THE MANORS
AT FINE VALLEY

The Rosecliffe Manor
3 BEDROOMS | 3.5 BATHROOMS

2856 SQ.FT. ELEV. A&B
INCLUDES 694 SQ.FT. OF FINISHED BASEMENT
2862 SQ.FT. CORNER A
INCLUDES 894 SQ.FT. OF FINISHED BASEMENT

TN-15-1
DEC 15 2023

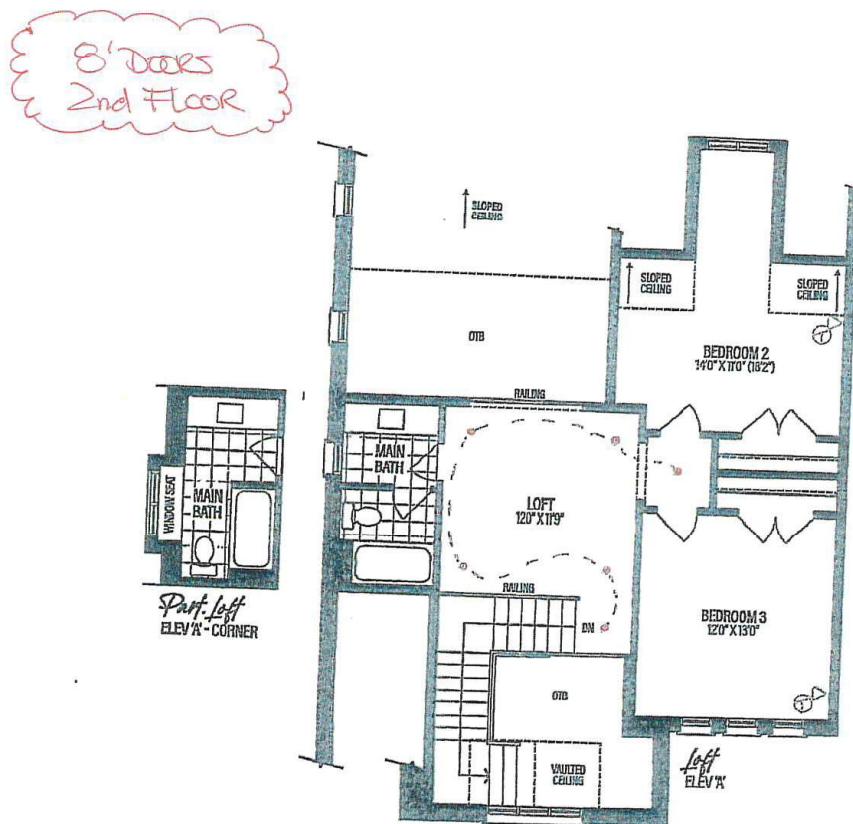

M

THE MANORS
AT PINE VALLEY

PLUMBING UPGRADES

ALIGN

Ceiling Mount: 226651 (12" Arm)



Brushed Gold

Brushed Nickel

Chrome

Matte Black

Date: Dec 15 2023	Lot: TM-15-1
Location: Principal Ensuite	
Signature:	Signature:

**Shower with 3-Function Transfer Valve/Trim
and Slide Bar with Hand Shower + 7" Rain
Showerhead From Ceiling on 12" Arm**
(includes plumbing provision for ceiling mount showerhead)
Model T2192EP/UT4191/3887EP/226651/S176/U361CI/
62320/A725

GOLD PARK
WORTH MORE™



THE MANORS
AT PINE VALLEY

PLUMBING UPGRADES

ALIGN



Brushed Gold



Brushed Nickel



Chrome



Matte Black



Date: Dec 15 2023	Lot: TM-15-1
Location: Principal Ensuite	
Signature:	Signature:

Two Handle 8" Widespread Lav
Model T6193/69000

GOLD PARK
WORTH MORE™