

**CERAMIC**

| Invoice                  | Qty. | Description                                                                                                                           |
|--------------------------|------|---------------------------------------------------------------------------------------------------------------------------------------|
| 3174<br>22Mar24<br>NoCat | 1    | FOYER: UPGRADE 5 FLOOR TILE - 24X24" ETERNITY ONYX POLISHED<br><br>LAID IN STRAIGHT, STACKED PATTERN.                                 |
| 3174<br>22Mar24<br>NoCat | 1    | FOYER & POWDER ROOM: UPGRADE GROUT: BONE                                                                                              |
| 3174<br>22Mar24<br>NoCat | 1    | POWDER ROOM: UPGRADE 5 FLOOR TILE - 24X24" ETERNITY ONYX POLISHED<br><br>LAID IN STRAIGHT STACKED PATTERN.                            |
| 3174<br>22Mar24<br>NoCat | 1    | MUD ROOM: UPGRADE 5 FLOOR TILE - 24X24" ETERNITY 'ONYX' POLISHED<br><br>LAID IN STRAIGHT, STACKED PATTERN.                            |
| 3174<br>22Mar24<br>NoCat | 1    | MUD ROOM: UPGRAGE GROUT: BONE                                                                                                         |
| 3174<br>22Mar24<br>NoCat | 1    | BASEMENT FOYER: STANDARD FLOOR TILE - 12X24" MADISON 'WHITE'<br><br>LAID IN STRAIGHT, STACKED PATTERN. SEE PLAN FOR TILE DIRECTION    |
| 3174<br>22Mar24<br>NoCat | 1    | PRINCIPAL ENSUITE: STANDARD FLOOR TILE - 12X24" MADISON 'WHITE'<br><br>LAID IN STRAIGHT, STACKED PATTERN. SEE PLAN FOR TILE DIRECTION |
| 3174<br>22Mar24<br>NoCat | 1    | PRINCIPAL ENSUITE: STANDARD 8X10" UNIWALL 'WHITE' SHOWER WALL TILE                                                                    |
| 3174<br>22Mar24<br>NoCat | 1    | PRINCIPAL ENSUITE: STANDARD 2X2" ONTARIO SHOWER FLOOR TILE - SNOW WHITE                                                               |
| 3174<br>22Mar24<br>NoCat | 1    | ENSUITE 2: UPGRADE 4 FLOOR TILE - 24X24" ETERNA VOLKAS POLISHED<br><br>LAID IN STRAIGHT, STACKED PATTERN.                             |
| 3174<br>22Mar24<br>NoCat | 1    | ENSUITE 2: UPGRADE 3 TUB ENCLOSURE WALL TILE 12X24" ETERNA VOLKAS POLISHED<br><br>LAID IN HORIZONTAL STACKED PATTERN.                 |
| 3174<br>22Mar24<br>NoCat | 1    | ENSUITE 3/4: STANDARD FLOOR TILE - 12X24" MADISON WHITE<br><br>LAID IN STRAIGHT, STACKED PATTERN. SEE PLAN FOR TILE DIRECTION         |
| 3174<br>22Mar24<br>NoCat | 1    | ENSUITE 3/4: STANDARD SHOWER WALL TILE - 8X10" UNIWALL WHITE                                                                          |

**CERAMIC**

| Invoice                  | Qty. | Description                                          |
|--------------------------|------|------------------------------------------------------|
| 3174<br>22Mar24<br>NoCat | 1    | ENSUITE 3/4: STANDARD SHOWER FLOOR TILE - 2X2" WHITE |
| 3174<br>22Mar24<br>NoCat | 1    | ENSUITE 2: UPGRADE GROUT - FLOOR AND WALL: BONE      |

**ELECTRICAL**

| Invoice                    | Qty. | Description                                                                                                                                                                                                                                                      |
|----------------------------|------|------------------------------------------------------------------------------------------------------------------------------------------------------------------------------------------------------------------------------------------------------------------|
| 3172<br>164,498<br>14Mar24 | 4    | BREAKFAST ROOM: S/I 4" E/S LED INTERIOR POT LIGHT - EACH. WHITE<br><br>PLEASE LOCATE IN LINE WITH KITCHEN POT LIGHTS. SEE PLAN FOR LOCATION                                                                                                                      |
| 3172<br>164,508<br>14Mar24 | 1    | BREAKFAST ROOM: S/I ADDITIONAL INTERIOR SWITCH. SINGLE POLE<br><br>FOR POT LIGHTS                                                                                                                                                                                |
| 3172<br>164,490<br>14Mar24 | 1    | KITCHEN: S/I 240V (30 AMP) RECEPTACLE ON A SEPARATE CIRCUIT<br><br>FOR SPEED OVEN (ABOVE WALL OVEN), SEE PLAN FOR LOCATION                                                                                                                                       |
| 3172<br>164,498<br>14Mar24 | 4    | STUDY: S/I 4" E/S LED INTERIOR POT LIGHT - EACH. WHITE<br><br>IN ADDITION TO STANDARD CEILING LIGHT, SEE PLAN FOR LOCATION                                                                                                                                       |
| 3172<br>164,508<br>14Mar24 | 1    | STUDY: S/I ADDITIONAL INTERIOR SWITCH. SINGLE POLE<br><br>FOR POTLIGHTS                                                                                                                                                                                          |
| 3172<br>164,498<br>14Mar24 | 6    | DINING ROOM: S/I 4" E/S LED INTERIOR POT LIGHT - EACH. WHITE<br><br>IN ADDITION TO STANDARD CEILING LIGHT, SEE PLAN FOR LOCATION<br>4@CEILING<br>2@NICHE                                                                                                         |
| 3172<br>164,508<br>14Mar24 | 1    | DINING ROOM: S/I ADDITIONAL INTERIOR SWITCH. SINGLE POLE<br><br>FOR POTLIGHTS                                                                                                                                                                                    |
| 3172<br>164,498<br>14Mar24 | 1    | POWDER ROOM: S/I 4" E/S LED INTERIOR POT LIGHT - EACH. WHITE<br><br>LOCATE IN APPROX CENTER OF ROOM, SEE PLAN FOR LOCATION<br>ON SAME SWITCH AS WALL SCONCES                                                                                                     |
| 3172<br>164,504<br>14Mar24 | 1    | POWDER ROOM: S/I ADDITIONAL EXTERIOR GFI RECEPTACLE WITH PLASTIC COVER<br><br>LOCATE BEHIND TOILET FOR FUTURE WASHLET                                                                                                                                            |
| 3172<br>164,538<br>14Mar24 | 1    | POWDER ROOM: S/I ROUGH-IN FOR WALL SCONCE - INCLUDED (1) CAPPED OUTLET- EACH FIXTURE NOT INCLUDED. SWITCH NOT INCLUDED.<br><br>IN ADDITION TO STANDARD VANITY LIGHT, USE STANDARD SWITCH.<br>1 STANDARD + 1 EXTRA - LOCATE APPROX 72" A.F.F, CENTERED TO VANITY. |
| 3172<br>164,538<br>14Mar24 | 2    | PRINCIPAL BEDROOM: S/I ROUGH-IN FOR WALL SCONCE - INCLUDED (1) CAPPED OUTLET- EACH FIXTURE NOT INCLUDED. SWITCH NOT INCLUDED.<br><br>LOCATE APPROX 116" APART, CENTERED ON WALL AND APPROX 66" A.F.F.<br>SEE PLAN FOR LOCATION                                   |
| 3172<br>164,496<br>14Mar24 | 1    | PRINCIPAL BEDROOM: S/I 3-WAY SWITCH (LIGHT OPERATED BY 2 DIFFERENT SWITCHES)<br><br>FOR WALL SCONCES, SEE PLAN FOR LOCATION                                                                                                                                      |
| 3172<br>164,534<br>14Mar24 | 1    | PRINCIPAL ENSUITE: S/I INTERIOR WALL OUTLET: ADDITIONAL INTERIOR GFI RECEPTACLE<br><br>LOCATE BEHIND TOILET FOR FUTURE WASHLET                                                                                                                                   |

**ELECTRICAL**

| Invoice                    | Qty. | Description                                                                                                                                                                                                             |
|----------------------------|------|-------------------------------------------------------------------------------------------------------------------------------------------------------------------------------------------------------------------------|
| 3172<br>164,534<br>14Mar24 | 1    | ENSUITE 2: S/I INTERIOR WALL OUTLET: ADDITIONAL INTERIOR GFI RECEPTACLE<br><br>LOCATE BEHIND TOILET FOR FUTURE WASHLET                                                                                                  |
| 3172<br>164,534<br>14Mar24 | 1    | SHARED ENSUITE: S/I INTERIOR WALL OUTLET: ADDITIONAL INTERIOR GFI RECEPTACLE<br><br>LOCATE BEHIND TOILET FOR FUTURE WASHLET                                                                                             |
| 3172<br>164,482<br>14Mar24 | 1    | PRINCIPAL BEDROOM: S/I 110V WALL RECEPTACLE (NOT ON SEPARATE CIRCUIT)<br><br>LOCATE APPROX 66" A.F.F.<br>SEE PLAN FOR LOCATION                                                                                          |
| 3172<br>164,482<br>14Mar24 | 1    | BEDROOM 2: S/I 110V WALL RECEPTACLE (NOT ON SEPARATE CIRCUIT)<br><br>LOCATE APPROX 66" A.F.F.<br>SEE PLAN FOR LOCATION                                                                                                  |
| 3172<br>164,476<br>14Mar24 | 1    | BEDROOM 3: S/I 110V WALL RECEPTACLE (NOT ON SEPARATE CIRCUIT)<br><br>LOCATE APPROX 66" A.F.F.<br>SEE PLAN FOR LOCATION                                                                                                  |
| 3172<br>164,482<br>14Mar24 | 1    | BEDROOM 4: S/I 110V WALL RECEPTACLE (NOT ON SEPARATE CIRCUIT)<br><br>LOCATE APPROX 66" A.F.F.<br>SEE PLAN FOR LOCATION                                                                                                  |
| 3172<br>164,482<br>14Mar24 | 1    | LOWER MEDIA ROOM: S/I 110V WALL RECEPTACLE (NOT ON SEPARATE CIRCUIT)<br><br>LOCATE APPROX 66" A.F.F.<br>SEE PLAN FOR LOCATION                                                                                           |
| 3172<br>164,526<br>14Mar24 | 8    | EXTERIOR: S/I EXTERIOR LED SOFFIT POT LIGHT - EACH<br>1@FRONT CENTER OF GARAGE ABOVE ADDRESS<br>4@FRONT UPPER SOFFIT<br>1@RIGHT SIDE, FRONT CORNER<br>1@LEFT SIDE, FRONT CORNER<br>1@REAR, RIGHT CORNER<br>*BLACK TRIM* |
| 3172<br>164,526<br>14Mar24 | 4    | EXTERIOR LOGGIA: S/I EXTERIOR LED SOFFIT POT LIGHT - EACH<br><br>SEE PLAN FOR LOCATION<br>*BLACK TRIM*<br>note: soffit lights installed on ribbed soffit                                                                |
| 3172<br>164,508<br>14Mar24 | 1    | BREAKFAST ROOM: S/I ADDITIONAL INTERIOR SWITCH. SINGLE POLE<br><br>FOR LOGGIA SOFFIT LIGHTS                                                                                                                             |
| 3172<br>164,508<br>14Mar24 | 1    | FOYER: S/I ADDITIONAL INTERIOR SWITCH. SINGLE POLE<br><br>FOR SOFFIT LIGHTS                                                                                                                                             |

**FIREPLACE - GAS**

| Invoice                  | Qty. | Description                                                                                                   |
|--------------------------|------|---------------------------------------------------------------------------------------------------------------|
| 3172<br>14Mar24<br>NoCat | 1    | **NOTE** GREAT ROOM: PLEASE LOCATE SWITCH FOR FIREPLACE ON NIBB WALL NEAR FRENCH DOORS, SEE PLAN FOR LOCATION |

**GRANITE MARBLE QUARTZ**

| Invoice                  | Qty. | Description                                                 |
|--------------------------|------|-------------------------------------------------------------|
| 3182<br>22Mar24<br>NoCat | 1    | POWDER ROOM: STANDARD QUARTZ COUNTER 'ICE SNOW'             |
| 3174<br>22Mar24<br>NoCat | 1    | KITCHEN: STANDARD QUARTZ COUNTER TOP 'OCEAN FOAM'           |
| 3174<br>22Mar24<br>NoCat | 1    | PRINCIPAL ENSUITE: STANDARD QUARTZ COUNTER TOP - OCEAN FOAM |
| 3174<br>22Mar24<br>NoCat | 1    | ENSUITE 2: STANDARD QUARTZ COUNTER TOP 'OCEAN FOAM'         |
| 3174<br>22Mar24<br>NoCat | 1    | ENSUITE 3/4: STANDARD QUARTZ COUNTER TOP - OCEAN FOAM       |

**HARDWOOD**

| Invoice                  | Qty. | Description                                                                                          |
|--------------------------|------|------------------------------------------------------------------------------------------------------|
| 3174<br>22Mar24<br>NoCat | 1    | THRU OUT STANDARD AREAS: UPGRADE 5 HARDWOOD - 3/4 X 6-1/2" VINTAGE 'NAUTILUS' WHITE OAK WIRE BRUSHED |
| 3174<br>22Mar24<br>NoCat | 1    | KITCHEN/BREAKFAST: UPGRADE 5 HARDWOOD - 3/4 X 6-1/2" VINTAGE 'NAUTILUS' WHITE OAK WIRE BRUSHED       |

**INTERIOR TRIM AND DOORS**

| Invoice          | Qty. | Description                                                                        |
|------------------|------|------------------------------------------------------------------------------------|
| 3172             | 1    | BASEMENT: ADD AN ADDITIONAL STANDARD DOOR AT BASEMENT FOYER, SEE PLAN FOR LOCATION |
| 14Mar24<br>NoCat |      | COMPLETE WITH STANDARD FINISHES, INCLUDED IN APS                                   |
| 3174             | 1    | THRU OUT STANDARD AREAS: INTERIOR DOOR PROFILE - STANDARD CARRARA                  |
| 22Mar24<br>NoCat |      |                                                                                    |
| 3174             | 1    | THRU OUT STANDARD AREAS: STANDARD INTERIOR DOOR HARDWARE AND HINGES                |
| 22Mar24<br>NoCat |      |                                                                                    |
| 3174             | 1    | THRU OUT STANDARD AREAS: STANDARD INTERIOR TRIM PACKAGE                            |
| 22Mar24<br>NoCat |      |                                                                                    |

**KITCHEN AND BATH CABINETRY**

| Invoice          | Qty. | Description                               |
|------------------|------|-------------------------------------------|
| 3174             | 1    | THRU OUT: SEE ATTACHED CABINETRY SCHEDULE |
| 22Mar24<br>NoCat |      |                                           |

**MISC.**

| Invoice          | Qty. | Description                                                                                                                                                                                     |
|------------------|------|-------------------------------------------------------------------------------------------------------------------------------------------------------------------------------------------------|
| 3174             | 1    | NOTE: STANDARD KITCHEN CABINETRY WILL HAVE CUT OUTS FOR ELECTRICAL FOR FUTURE APPLIANCES. (STANDARD KITCHEN LAYOUT WILL NOT MATCH APPLIANCE SPECS) HOMEOWNER WILL REPLACE KITCHEN AFTER CLOSING |
| 22Mar24<br>NoCat |      |                                                                                                                                                                                                 |

**NETWORK AND WIRING**

| Invoice                      | Qty. | Description                                                                                                                                                                                                                                                                              |
|------------------------------|------|------------------------------------------------------------------------------------------------------------------------------------------------------------------------------------------------------------------------------------------------------------------------------------------|
| 3172<br>164,694<br>14Mar24   | 9    | EXTERIOR: S/I ADDITIONAL CAT6 ETHERNET OUTLET<br><br>2@LOGGIA<br>1@REAR, RIGHT CORNER<br>1@LEFT SIDE, NEAR REAR OF HOUSE<br>1@RIGHT SIDE, NEAR FIREPLACE BUMP OUT<br>1@GARAGE INTERIOR<br>1@GARAGE EXTERIOR<br>1@PORTICO<br>*(FOR FUTURE CAMERAS)<br><br>1@PORTICO (FOR VIDEO DOOR BELL) |
| 3172<br>164,694<br>14Mar24   | 1    | UPPER HALL: S/I ADDITIONAL CAT6 ETHERNET OUTLET<br><br>LOCATE ON CEILING FOR WIFI ACCESS POINT<br>SEE PLAN FOR LOCATION                                                                                                                                                                  |
| 3172<br><br>14Mar24<br>NoCat | 1    | **NOTE** BASEMENT: RUN ALL CAT 6 WIRING TO BASEMENT, SEE PLAN FOR LOCATION                                                                                                                                                                                                               |
| 3172<br>164,694<br>14Mar24   | 2    | GREAT ROOM: S/I ADDITIONAL CAT6 ETHERNET OUTLET<br><br>LOCATE ABOVE FIREPLACE, APPROX 66" A.F.F.                                                                                                                                                                                         |
| 3172<br>164,694<br>14Mar24   | 2    | STUDY: S/I ADDITIONAL CAT6 ETHERNET OUTLET<br><br>SEE PLAN FOR LOCATION                                                                                                                                                                                                                  |
| 3172<br>164,694<br>14Mar24   | 2    | PRINCIPAL BEDROOM: S/I ADDITIONAL CAT6 ETHERNET OUTLET<br><br>LOCATE APPROX 66" A.F.F., SEE PLAN FOR LOCATION<br>(LOCATE STANDARD CABLE AT 66" A.F.F. TOO)                                                                                                                               |
| 3172<br>164,694<br>14Mar24   | 2    | BEDROOM 2: S/I ADDITIONAL CAT6 ETHERNET OUTLET<br><br>LOCATE APPROX 66" A.F.F.<br>SEE PLAN FOR LOCATION                                                                                                                                                                                  |
| 3172<br>164,694<br>14Mar24   | 2    | BEDROOM 3: S/I ADDITIONAL CAT6 ETHERNET OUTLET<br><br>LOCATE APPROX 66" A.F.F.<br>SEE PLAN FOR LOCATION                                                                                                                                                                                  |
| 3172<br>164,694<br>14Mar24   | 2    | BEDROOM 4: S/I ADDITIONAL CAT6 ETHERNET OUTLET<br><br>LOCATE APPROX 66" A.F.F.<br>SEE PLAN FOR LOCATION                                                                                                                                                                                  |
| 3172<br>164,694<br>14Mar24   | 2    | LOWER MEDIA ROOM: S/I ADDITIONAL CAT6 ETHERNET OUTLET<br><br>LOCATE APPROX 66" A.F.F.<br>SEE PLAN FOR LOCATION<br><br>MOVE STANDARD CABLE TO APPROX 66" A.F.F. TOO                                                                                                                       |
| 3172<br><br>14Mar24<br>NoCat | 1    | THRU OUT 2ND FLOOR AND BASEMENT: ADD ROUGH-IN ALARM WIRING AT ALL WINDOWS                                                                                                                                                                                                                |

**NETWORK AND WIRING**

| Invoice                      | Qty. | Description                                                                                                                                                                                                                     |
|------------------------------|------|---------------------------------------------------------------------------------------------------------------------------------------------------------------------------------------------------------------------------------|
| 3172<br>164,694<br>14Mar24   | 1    | MAIN HALL: S/I ADDITIONAL CAT6 ETHERNET OUTLET<br><br>LOCATE ON CEILING FOR WIFI ACCESS POINT<br>SEE PLAN FOR LOCATION                                                                                                          |
| 3172<br><br>14Mar24<br>NoCat | 6    | THRU OUT: ADD RECESSED MEDIA BOX FOR ELECTRICAL AND DATA - LOCATE APPROX 66" A.F.F.<br>GREAT ROOM / PRINCIPAL BEDROOM / BEDROOM 2 / BEDROOM 3 / BEDROOM 4 / LOWER MEDIA ROOM<br><br>CAT 6 AND ELECTRICAL TO BE WIRED TO THE BOX |

**PAINT**

| Invoice                      | Qty. | Description                                          |
|------------------------------|------|------------------------------------------------------|
| 3174<br><br>22Mar24<br>NoCat | 1    | MAIN STAIRS: STAIN STAIRS **colour to be confirmed** |
| 3174<br><br>22Mar24<br>NoCat | 1    | THRU OUT STANDARD AREAS: WALL PAINT: COOL WHITE      |

**STAIRS AND RAILINGS**

| Invoice                      | Qty. | Description                                                                    |
|------------------------------|------|--------------------------------------------------------------------------------|
| 3174<br><br>22Mar24<br>NoCat | 1    | MAIN STAIRS: UPGRADE RAILING TO 'MANHATTAN' -GLASS RAILING WITH GOLD FASTENERS |

PV2-17 Cabinetry Schedule

| ROOM               | LEVEL | DESCRIPTION                           | PRICE | QTY | TOTAL |
|--------------------|-------|---------------------------------------|-------|-----|-------|
| KITCHEN:           |       | STD FLAT PANEL MELAMINE LARICE BIANCO | -     | 1   | \$ -  |
| ISLAND:            |       | STD FLAT PANEL MELAMINE LARICE BIANCO | -     | 1   | \$ -  |
| HARDWARE:          |       | STD NONE, NO HOLES                    | -     | 1   | \$ -  |
|                    |       |                                       | -     | 1   | \$ -  |
| POWDER ROOM:       |       | STD FLAT PANEL MELAMINE LARICE BIANCO | -     | 1   | \$ -  |
| HARDWARE:          |       | STD NONE, NO HOLES                    | -     | 1   | \$ -  |
|                    |       |                                       | -     | 1   | \$ -  |
| MUD ROOM:          |       | STD FLAT PANEL MELAMINE LARICE BIANCO | -     | 1   | \$ -  |
| HARDWARE:          |       | STD SEE ATTACHED                      | -     | 1   | \$ -  |
| P-LAM COUNTER:     |       | STD P-LAM: WHITE                      | -     | 1   | \$ -  |
|                    |       |                                       | -     | 1   | \$ -  |
| PRINCIPAL ENSUITE: |       | STD FLAT PANEL MELAMINE LARICE BIANCO | -     | 1   | \$ -  |
| HARDWARE:          |       | STD SEE ATTACHED                      | -     | 1   | \$ -  |
|                    |       |                                       | -     | 1   | \$ -  |
| ENSUITE 2:         |       | STD FLAT PANEL MELAMINE LARICE BIANCO | -     | 1   | \$ -  |
| HARDWARE:          |       | STD SEE ATTACHED                      | -     | 1   | \$ -  |
|                    |       |                                       | -     | 1   | \$ -  |
| ENSUITE 3:         |       | STD FLAT PANEL MELAMINE LARICE BIANCO | -     | 1   | \$ -  |
| HARDWARE:          |       | STD SEE ATTACHED                      | -     | 1   | \$ -  |
|                    |       |                                       | -     | 1   | \$ -  |
| CABINERY TOTAL:    |       |                                       | \$    | -   | -     |

LOT #: 17

DATE: MARCH 21 2024

SIGNATURE:

SIGNATURE:

**EUROCHOICE  
KITCHENS INC.**

2 Watson Rd. S., RR#2  
Guelph, On, N1L 1E2  
Phone: 519-821-3670  
Fax: 519-821-3613

PAGE 1 OF 5

ORDER #

CUSTOMER:  
**GOLDPARK HOMES**  
MODEL: THE BROOKSIDE

SHIPPING DIRECTIONS:

UNIT 4003 PINE VALLEY, PHASE 2  
VAUGHAN, ON

DATE ORDERED:

DATE REQUIRED:

KITCHEN:

INTERIOR: WHITE MELAMINE

DESIGN:

STAIN:

HDWE:

C-TOP:


CROWN: # 11 W/ EXTENDED CLEAT  
LIGHT VALANCE:

DRAWER TRACKS: DOVETAIL & QUADRO  
DOOR HINGES: SOFT CLOSE  
CEILING HEIGHT: 108" H  
CABINETS HEIGHT: 45" H UPPERS,  
HANG @ 101" H W/ CROWN TO CEILING

DRAWN DATE: NOV 7/22

DESIGNER: KRISTIN

SALES REP: TOM

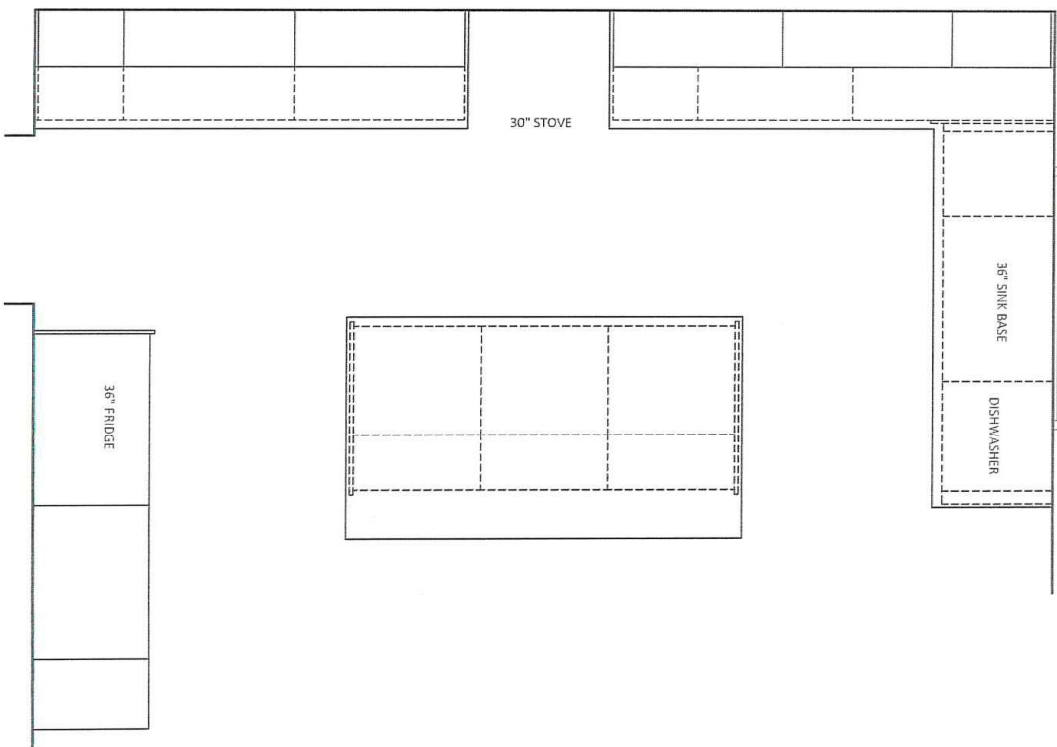

PV2-17  
3/21/24



**EUROCHOICE  
KITCHENS INC.**

2 Watson Rd. S. RR#2  
Guelph, On. N1L 1E2  
Phone: 519-821-3670  
Fax: 519-821-3613

PAGE 2 OF 5

ORDER #

CUSTOMER:

GOLDPARK HOMES  
MODEL: THE BROOKSIDE

SHIPPING DIRECTIONS:

UNIT 4003 PINE VALLEY, PHASE 2  
VAUGHAN, ON

DATE ORDERED:

DATE REQUIRED:

DRAWN DATE: NOV 1/22

DESIGNER: KRISTIN

SALES REP: TOM



PV2-17  
3/21/24



**EUROCHOICE  
KITCHENS INC.**

2 Watson Rd. S., RR#2  
Guelph, On, N1L 1E2  
Phone: 519-821-3670  
Fax: 519-821-3613

PAGE 3 OF 5

ORDER #

CUSTOMER:  
**GOLDPARK HOMES**  
MODEL: THE BROOKSIDE

SHIPPING DIRECTIONS:  
UNIT 4003 PINE VALLEY, PHASE 2  
VAUGHAN, ON


DATE ORDERED:

DATE REQUIRED:


DRAWN DATE: NOV 7/2

DESIGNER: KRISTIN

SALES REP: TOM

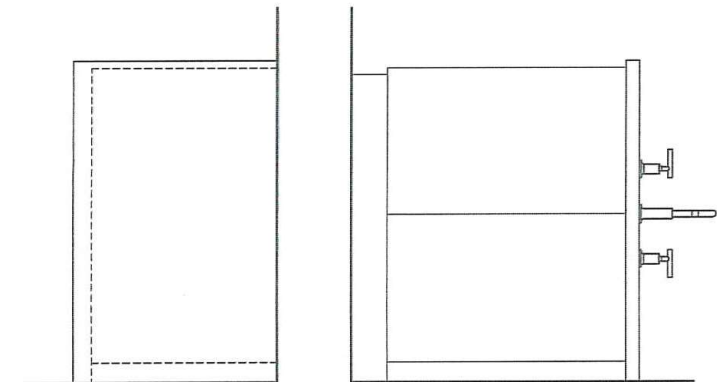

**POWDER ROOM:**  
INTERIOR: WHITE MELAMINE  
DESIGN:  
STAIN:  
HDWE:  
C-TOP:  
DOOR HINGES: STANDARD  
CABINETS HEIGHT: 32" H VANITY

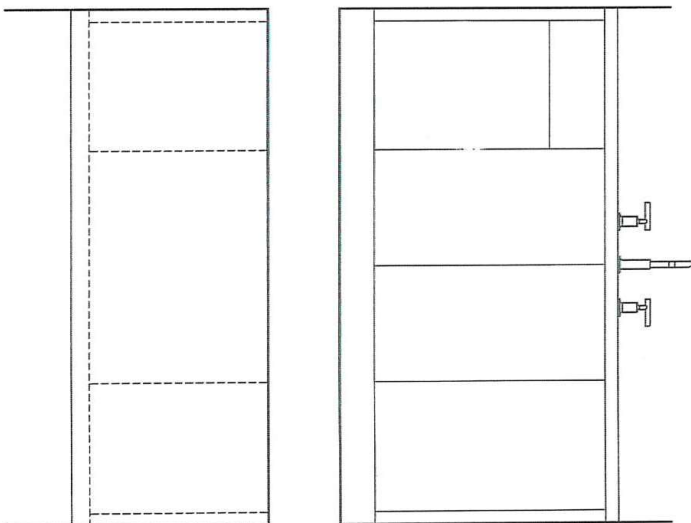

**ENSUITE 2:**  
INTERIOR: WHITE MELAMINE  
DESIGN:  
STAIN:  
HDWE:  
C-TOP:  
DRAWER TRACKS: STANDARD  
DOOR HINGES: STANDARD  
CABINETS HEIGHT: 32" H VANITY

PV2-17

03/21/2024



**EUROCHOICE  
KITCHENS INC.**

2 Watson Rd. S., RR#2  
Guelph, On. N1L 1E2  
Phone: 519-821-3670  
Fax: 519-821-3613

PAGE 4 OF 5

ORDER #

CUSTOMER:  
**GOLDPARK HOMES**  
MODEL: THE BROOKSIDE

SHIPPING DIRECTIONS:  
UNIT 4003 PINE VALLEY, PHASE 2  
VAUGHAN, ON

DATE ORDERED:  
DATE REQUIRED:





DRAWN DATE: NOV 7/2

DESIGNER: KRISTIN

SALES REP: TOM

PRIMARY ENSUITE:  
INTERIOR: WHITE MELAMINE  
DESIGN:  
STAIN:  
H/DWE:  
C-TOP:

DRAWER TRACKS: STANDARD  
DOOR HINGES: STANDARD  
CABINETS HEIGHT: 32" H VANITY

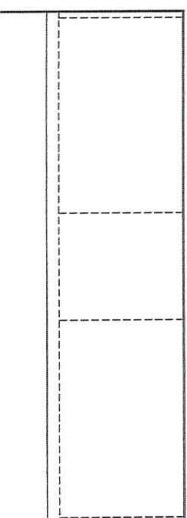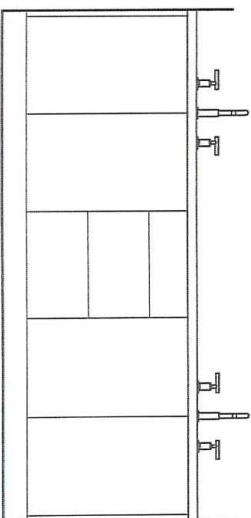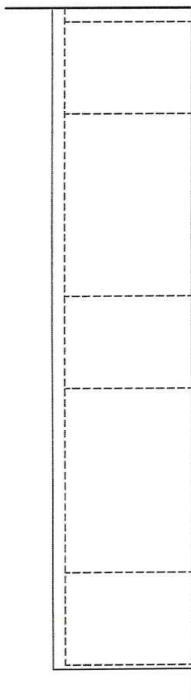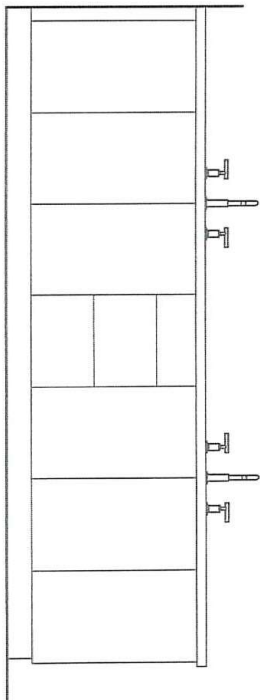

ENSUITE 3/4:  
INTERIOR: WHITE MELAMINE  
DESIGN:  
STAIN:  
H/DWE:  
C-TOP:

DRAWER TRACKS: STANDARD  
DOOR HINGES: STANDARD  
CABINETS HEIGHT: 32" H VANITY

PN2-17

03/21/2024

A handwritten signature in blue ink, followed by a circular date stamp containing the date 03/21/2024.

# EUROCHOICE KITCHENS INC.

2 Watson Rd. S., RR#2  
Guelph, On, N1L 1E2  
Phone: 519-821-3670  
Fax: 519-821-3613

PAGE 5 OF 5



ORDER #

CUSTOMER:  
GOLDPARK HOMES  
MODEL: THE BROOKSIDE

SHIPPING DIRECTIONS:  
UNIT 4003 PINE VALLEY, PHASE 2  
VAUGHAN, ON



DATE ORDERED:

DATE REQUIRED:

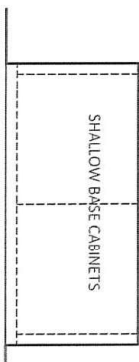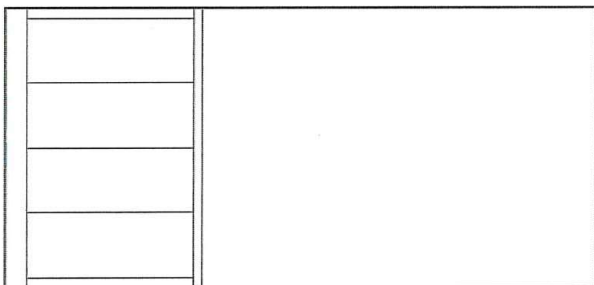

**BUFFET NICHE:**  
INTERIOR: WHITE MELAMINE  
DESIGN:  
STAIN:  
HDWE:  
C-TOP:

DRAWER TRACKS: STANDARD  
SOFT CLOSE DOORS  
CABINET HEIGHT: 36" H BASE UNIT

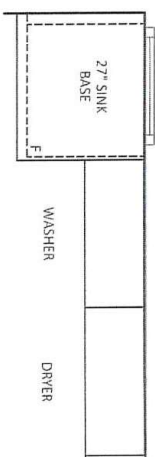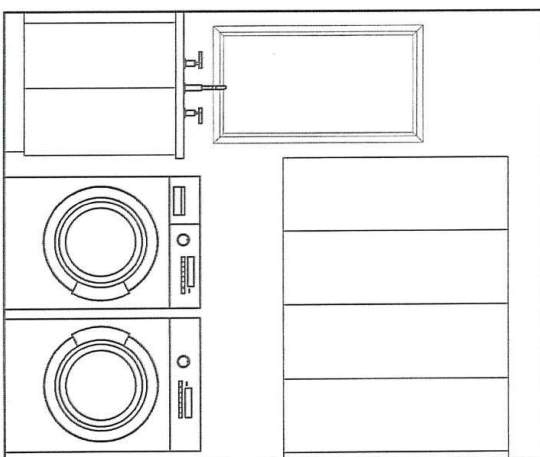

**MUDROOM:**  
INTERIOR: WHITE MELAMINE  
DESIGN:  
STAIN:  
HDWE:  
C-TOP:  
EDGE: REGENCY  
CROWN:  
LIGHT VALANCE:

DRAWER TRACKS: STANDARD  
SOFT CLOSE DOORS  
CEILING HEIGHT: 108" H  
CABINETS HEIGHT: 45" H UPPEERS,  
HANG @ 101" - OPEN TO CEILING

DRAWN DATE: NOV 1/2

DESIGNER: KRISTIN

SALES REP: TOM

PV2-17  
3/21/24

Handwritten signature/initials.

Handwritten signature/initials.

# SCHEDULE 'F'



7/2-17  
SEPT 26 2022

Feb 7 2023

MARCH 8 2024

MARCH 12 2024

MARCH 21 2024

## The Brookside

### DEER RUN COLLECTION

Elevation A - 3,370 sq.ft.

3,362 sq.ft. Opt. Ground Floor Side Entry

Plus 93 sq.ft. Fin. Basement Foyer

Elevation B - 3,338 sq.ft.


3,330 sq.ft. Opt. Ground Floor Side Entry

Plus 93 sq.ft. Fin. Basement Foyer

Elevation C - 3,312 sq.ft.

3,303 sq.ft. Opt. Ground Floor Side Entry

Plus 93 sq.ft. Fin. Basement Foyer

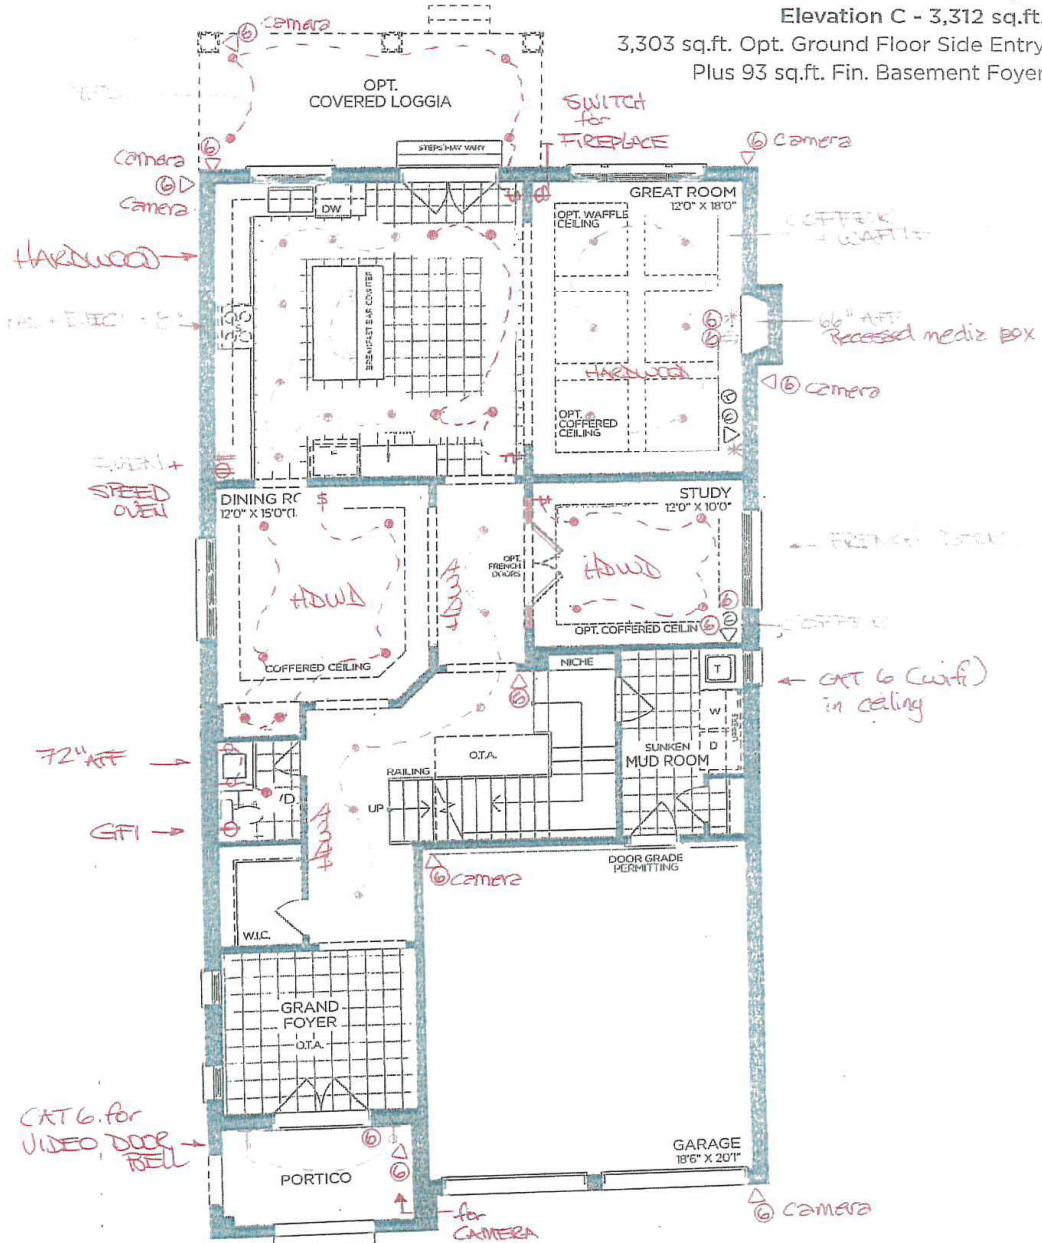

GROUND FLOOR | ELEV. A

VENDOR

PURCHASER

PURCHASER

**GOLDPARK**  
WORTH MORE™

Prices, figures, illustrations, sizes, features and finishes are subject to change without notice. Areas and dimensions are approximate and actual usable floor space may vary from the stated area. Layout may be reverse of the unit purchased. E. & O.E. 4003


# SCHEDULE 'F'



PV2-17  
SEPT 26 2022  
FEB 7, 2023  
MAR 8 2024  
MAR 12 2024  
MARCH 21 2024

## The Brookside DEER RUN COLLECTION

Elevation A - 3,370 sq.ft.  
3,362 sq.ft. Opt. Ground Floor Side Entry  
Plus 93 sq.ft. Fin. Basement Foyer  
Elevation B - 3,338 sq.ft.  
3,330 sq.ft. Opt. Ground Floor Side Entry  
Plus 93 sq.ft. Fin. Basement Foyer  
Elevation C - 3,312 sq.ft.  
3,303 sq.ft. Opt. Ground Floor Side Entry  
Plus 93 sq.ft. Fin. Basement Foyer

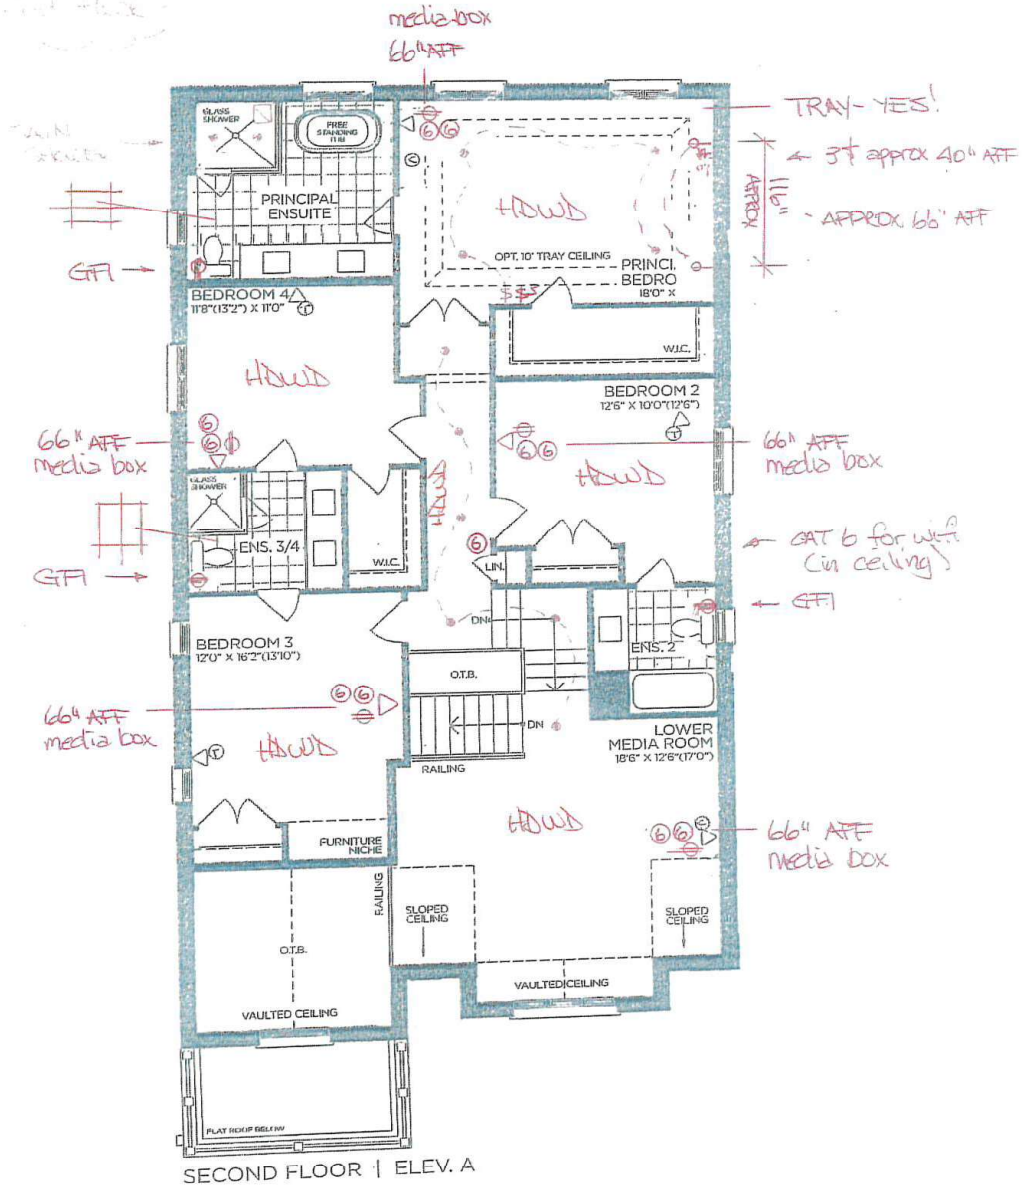

SECOND FLOOR - ELEV. A

VENDOR  
PURCHASER  
PURCHASER

|  |
|--|
|  |
|  |
|  |

**GOLDPARK**  
WORTH MORE™

Prices, figures, illustrations, sizes, features and finishes are subject to change without notice. Areas and dimensions are approximate and actual usable floor space may vary from the stated area. Layout may be reverse of the unit purchased. E. & O.E. 4003

# SCHEDULE 'F'




PV2-17  
 SEPT 26 2022  
 FEB 7 2023  
 MARCH 8 2024  
 MAR 12 2024  
 MARCH 21 2024


## The Brookside

### DEER RUN COLLECTION


Elevation A - 3,370 sq.ft.  
 3,362 sq.ft. Opt. Ground Floor Side Entry  
 Plus 93 sq.ft. Fin. Basement Foyer  
 Elevation B - 3,338 sq.ft.  
 3,330 sq.ft. Opt. Ground Floor Side Entry  
 Plus 93 sq.ft. Fin. Basement Foyer  
 Elevation C - 3,312 sq.ft.  
 3,303 sq.ft. Opt. Ground Floor Side Entry  
 Plus 93 sq.ft. Fin. Basement Foyer

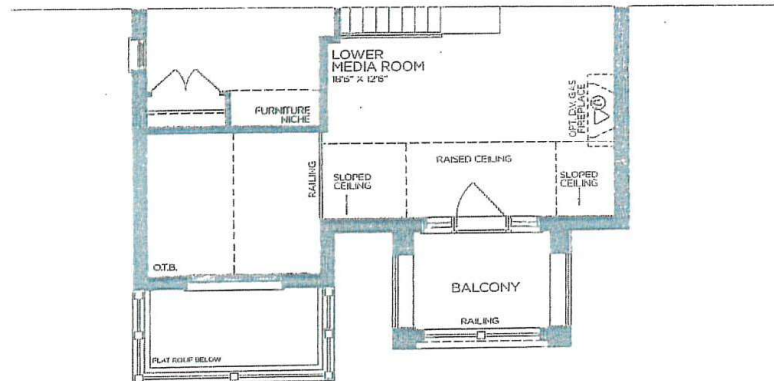


PART. SECOND FLOOR | ELEV. B

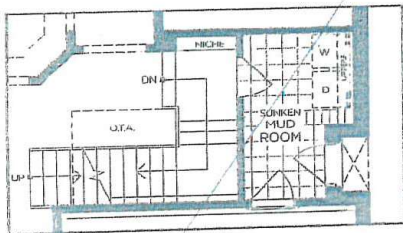

PART. OPT. GROUND FLOOR  
 W/ OPT. SIDE ENTRANCE | ELEV. A  
 (ELEV. B SIMILAR)

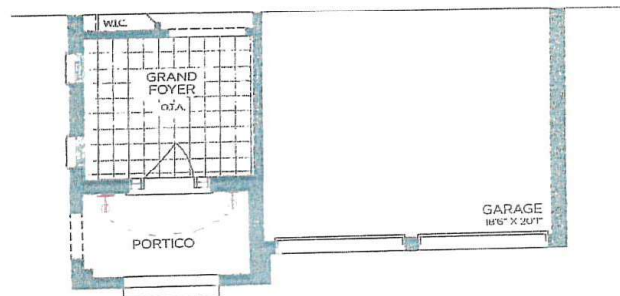

PART. GROUND FLOOR | ELEV. B

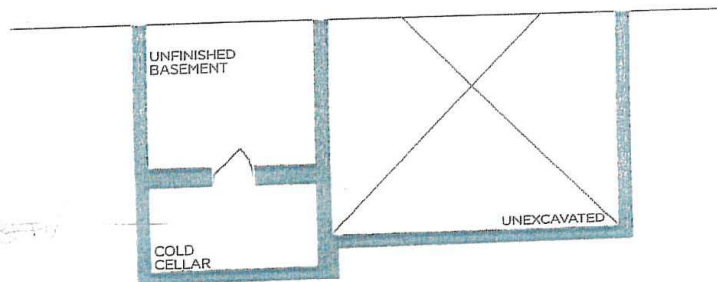

PART. BASEMENT | ELEV. B

VENDOR

PURCHASER

PURCHASER

**GOLDPARK**  
 WORTH MORE™

Prices, figures, illustrations, sizes, features and finishes are subject to change without notice. Areas and dimensions are approximate and actual usable floor space may vary from the stated area. Layout may be reverse of the unit purchased. E. & O.E. 4003

# SCHEDULE 'F'




7/2-17  
SEPT 26 2022  
FEB 7 2023

MARCH 8 2024  
MAR 12 2024  
MARCH 21 2024

## The Brookside

### DEER RUN COLLECTION

Elevation A - 3,370 sq.ft.  
3,362 sq.ft. Opt. Ground Floor Side Entry  
Plus 93 sq.ft. Fin. Basement Foyer  
Elevation B - 3,338 sq.ft.  
3,330 sq.ft. Opt. Ground Floor Side Entry  
Plus 93 sq.ft. Fin. Basement Foyer  
Elevation C - 3,312 sq.ft.  
3,303 sq.ft. Opt. Ground Floor Side Entry  
Plus 93 sq.ft. Fin. Basement Foyer

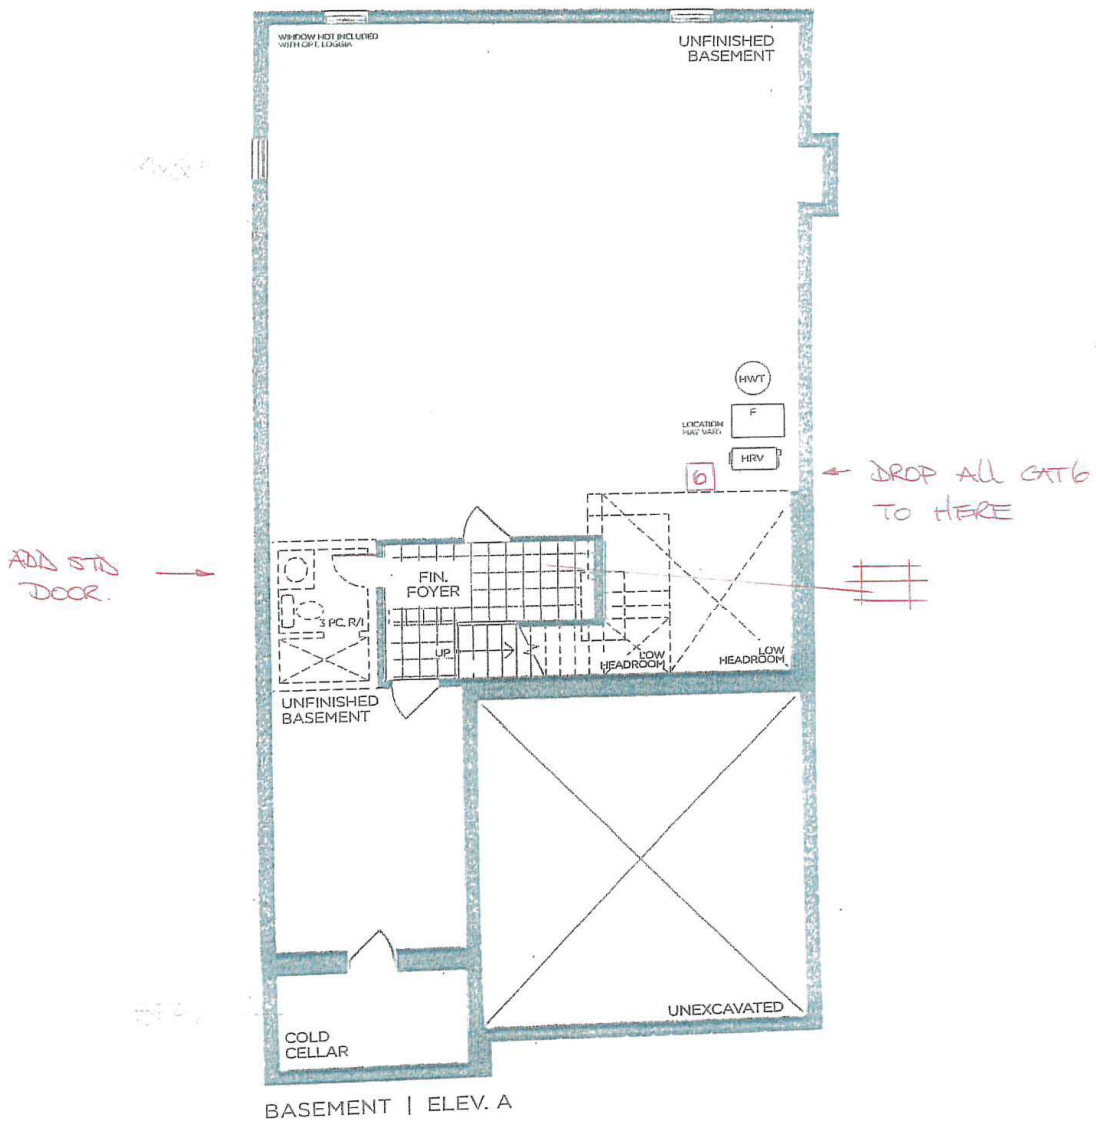

BASEMENT | ELEV. A

VENDOR

PURCHASER

PURCHASER

**GOLDPARK**  
WORTH MORE™

Prices, figures, illustrations, sizes, features and finishes are subject to change without notice. Areas and dimensions are approximate and actual usable floor space may vary from the stated area. Layout may be reverse of the unit purchased. E. & O.E. 4003

## COUNTER EDGE PROFILES

### THICKNESS

STANDARD - 2CM ☒


UPGRADE - 3CM ☐

### EDGE PROFILE - STANDARDS




STANDARD EASED ☒

### EDGE PROFILE - UPGRADES

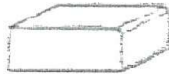

MICRO BEVEL ☐

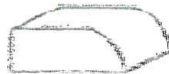

BULLNOSE EDGE ☐




MITER EDGE ☐  
(2CM ONLY)



KNIFE EDGE ☐



SINGLE BEVEL ☐

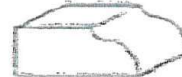

OGEE EDGE ☐



QUIRK MITER EDGE ☐

|                  |             |
|------------------|-------------|
| Date: 03/21/2024 | Lot: PV2-17 |
|------------------|-------------|

|                                                                                                |                                                                                                 |
|------------------------------------------------------------------------------------------------|-------------------------------------------------------------------------------------------------|
| Signature:  | Signature:  |
|------------------------------------------------------------------------------------------------|-------------------------------------------------------------------------------------------------|

## STANDARD CABINETRY HARDWARE



Brushed Nickel

Satin Nickel

Matte Black

Brushed Nickel



Brushed Nickel

Brushed Nickel

Matte Black



Brushed Nickel

Brushed Nickel

Matte Black

Brushed Nickel



\*NONE\* ☐

Brushed Nickel

Brushed Nickel

Polished Chrome

NO HOLES


|                  |             |
|------------------|-------------|
| Date: 03/21/2024 | Lot: PV2-17 |
|------------------|-------------|

|                      |
|----------------------|
| Location: throughout |
|----------------------|

|                                                                                                |                                                                                                |
|------------------------------------------------------------------------------------------------|------------------------------------------------------------------------------------------------|
| Signature:  | Signature:  |
|------------------------------------------------------------------------------------------------|------------------------------------------------------------------------------------------------|

STANDARD INTERIOR DOOR

CARRARA DOOR

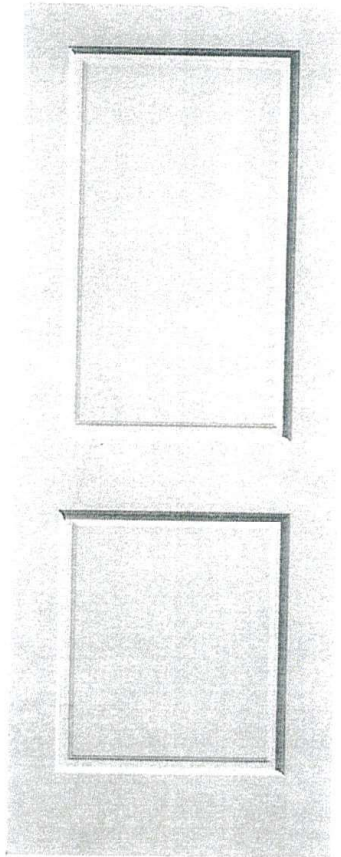

LOCATION:

Then out

LOT # PV2-17

DATE: 03/21/2024

SIGNATURE:



SIGNATURE:






PINE VALLEY  
FOREVERGREEN

FIREPLACE MANTLE

Cast Stone Mantle

MEDITERRANEAN

(Fireplace sold separately)

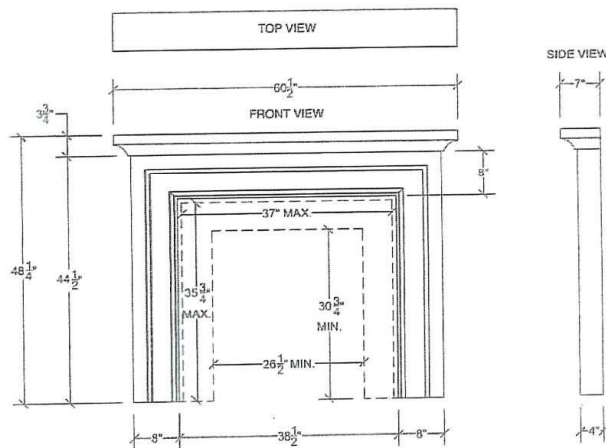

|            |        |       |            |       |            |
|------------|--------|-------|------------|-------|------------|
| Lot#       | PV2-17 | Date: | 03/21/2024 | Room: | GREAT ROOM |
| Signature: |        |       |            |       |            |
| Signature: |        |       |            |       |            |

**BATHROOM ACCESSORIES**

---



☐ INSTALL STANDARD BATHROOM ACCESSORIES THRU-OUT (tissue holder + towel bar) *\*to be installed after closing by customer service\**

☒ *\*DO NOT\** INSTALL STANDARD BATHROOM ACCESSORIES THRU-OUT

|                                                                                                       |                                                                                                       |
|-------------------------------------------------------------------------------------------------------|-------------------------------------------------------------------------------------------------------|
| Date: <u>Thurs. March 21, 2024</u>                                                                    | Lot: <u>PV2-17</u>                                                                                    |
| Location: <u></u>  |                                                                                                       |
| Signature: <u></u> | Signature: <u></u> |