

NETWORK AND WIRING

Invoice	Qty.	Description
3195 164,804 15May24	1	EXTERIOR: S/I SECURITY PACKAGE - ROUGH - IN WIRING FOR: 1 VIDEO DOOR BELL + 4 CAMERAS. COMPONENTS NOT INCLUDED. (Location Determined by Vendor)

Spec Lot Addendum(s)

Project: Pine Valley Forevergreen - Ph 2, Model: 4205(B) - BROADVIEW, Lot: 0042
69, Terravista Crescent, Vaughan, ONTARIO

Addendum 04/[04]

STRUCTURAL EXTRA'S

Principal Bedroom		
Category	Attribute	Opt. Quantity
FRAMING		1.00
Opt. Description		
PRINCIPAL BEDROOM APPROX. 10 FOOT TRAY CEILING		
Notes		
Prin Bedroom Sitting Room		
Category	Attribute	Opt. Quantity
FRAMING		1.00
Opt. Description		
PRINCIPAL BEDROOM SITTING AREA APPROX. 10 FOOT TRAY CEILING		
Notes		

Spec Lot Addendum(s)

Project: Pine Valley Forevergreen - Ph 2, Model: 4205(B) - BROADVIEW, Lot: 0042
69, Terravista Crescent, Vaughan, ONTARIO

Addendum 03/[03] | STRUCTURAL ORDER

STRUCTURAL EXTRA'S

Principal Bedroom		
Category	Attribute	Opt. Quantity
ELECTRICAL		8.00
Opt. Description		
S/I 4" E/S LED INTERIOR POT LIGHT - EACH. WHITE		
Notes		
IN ADDITION TO STANDARD CEILING LIGHT, SEE PLAN FOR LOCATION		
ELECTRICAL SWITCHES		1.00
Opt. Description		
S/I ADDITIONAL INTERIOR SWITCH. SINGLE POLE		
Notes		
FOR POTLIGHTS		
Breakfast Room		
Category	Attribute	Opt. Quantity
ELECTRICAL		2.00
Opt. Description		
S/I 4" E/S LED INTERIOR POT LIGHT - EACH. WHITE		
Notes		
ELECTRICAL SWITCHES		1.00
Opt. Description		
S/I ADDITIONAL INTERIOR SWITCH. SINGLE POLE		
Notes		
FOR POTLIGHTS		
EXT, WINDOWS AND DOORS		1.00
Opt. Description		
INCREASE EXSITING REAR GARDEN DOOR OR FRENCH GARDEN DOOR HEIGHT TO APPROX. 96" - NO TRANSOM IF APPLICABLE.		
Notes		
Dining Room		
Category	Attribute	Opt. Quantity
ELECTRICAL		4.00
Opt. Description		
S/I 4" E/S LED INTERIOR POT LIGHT - EACH. WHITE		
Notes		
IN ADDITION TO STANDARD CEILING LIGHTS		
ELECTRICAL SWITCHES		1.00
Opt. Description		
S/I DIMMER SWITCH: DECORA DIMMER SWITCH - EACH		
Notes		

Spec Lot Addendum(s)

Project: Pine Valley Forevergreen - Ph 2, Model: 4205(B) - BROADVIEW, Lot: 0042
69, Terravista Crescent, Vaughan, ONTARIO

Ensuite 4		
Category	Attribute	Opt. Quantity
FRAMING		1.00
Opt. Description	S/I RECESSED SHOWER NICHE [SHAMPOO SHELF]. COMPLETE WITH QUARTZ ON 4 SIDES, APPROX. 12 X 18 INSTALLED VERTICALLY. BASED ON STANDARD FINISHES.	
Notes		
Principal Ensuite		
Category	Attribute	Opt. Quantity
FRAMING		1.00
Opt. Description	S/I RECESSED SHOWER NICHE [SHAMPOO SHELF] - COMPLETE WITH QUARTZ ON 4 SIDES, STANDARD TILE, APPROX. 12 X 42 INSTALLED VERTICALLY WITH QUARTZ SHELF DIVIDERS. BASED ON STANDARD FINISHES	
Notes		
FIXTURES		2.00
Opt. Description	Align 2-Handle Widespread Lav - BG	
Notes		
FIXTURES		1.00
Opt. Description	Align 3-Function Rain Shwr/Hand Shwr/S.Bar - BG	
Notes		
FIXTURES		1.00
Opt. Description	Align Free Standing Tub Filler - BG	
Notes		
Exterior		
Category	Attribute	Opt. Quantity
ELECTRICAL		1.00
Opt. Description	Ext Coach Light, S/Switch	
Notes	FRONT PORCH: ADD ANOTHER, SAME HEIGHT AND SWITCH AS STANDARD (OPPOSITE SIDE OF FRONT DOOR)	
Great Room		
Category	Attribute	Opt. Quantity
ELECTRICAL OUTLETS		1.00
Opt. Description	S/I 110V WALL RECEPTACLE (NOT ON SEPARATE CIRCUIT)	
Notes	LOCATE APPROX 66" A.F.F. ABOVE FIREPLACE, SEE PLAN FOR LOCATION	
ELECTRICAL		6.00
Opt. Description	S/I 4" E/S LED INTERIOR POT LIGHT - EACH. WHITE	
Notes	IN LIEU OF STANDARD CEILING LIGHT, USE STANDARD SWITCH	
FRAMING		1.00
Opt. Description		

Spec Lot Addendum(s)

Project: Pine Valley Forevergreen - Ph 2, Model: 4205(B) - BROADVIEW, Lot: 0042
69, Terravista Crescent, Vaughan, ONTARIO

Category	Attribute	Opt. Quantity
S/I COFFERED CEILING (OPTIONAL PER ROOM)		
Notes		
NETWORK AND WIRING		1.00
Opt. Description		
S/I CONDUIT PIPE FOR WALL MOUNT TV LOCATED APPROX. 66" A.F.F. ABOVE FIREPLACE THROUGH BASEMENT TO CABLE LOCATION. SEE PLAN FOR LOCATION.		
Notes		
WAFFLE CEILING		1.00
Opt. Description		
WAFFLE CEILING, BEAM DETAIL AS PER PLAN (6 BOXES) OPTION # 1 CTRB07		
Notes		
Hall Main Floor		
Category	Attribute	Opt. Quantity
ELECTRICAL		7.00
Opt. Description		
S/I 4" E/S LED INTERIOR POT LIGHT - EACH. WHITE		
Notes		
IN LIEU OF STANDARD CEILING LIGHT, USE STANDARD SWITCHES		
ELECTRICAL SWITCHES		1.00
Opt. Description		
S/I HINGE SWITCH - EACH INCLUDES 1 LED POTLIGHT (DOOR ACTIVATED)		
Notes		
Hall 2nd Level		
Category	Attribute	Opt. Quantity
ELECTRICAL		4.00
Opt. Description		
S/I 4" E/S LED INTERIOR POT LIGHT - EACH. WHITE		
Notes		
IN LIEU OF STANDARD CEILING LIGHT, USE STANDARD SWITCHES		
ELECTRICAL SWITCHES		1.00
Opt. Description		
S/I HINGE SWITCH - EACH INCLUDES 1 LED POTLIGHT (DOOR ACTIVATED)		
Notes		
Kitchen		
Category	Attribute	Opt. Quantity
ELECTRICAL OUTLETS		1.00
Opt. Description		
S/I 110V WALL RECEPTACLE (NOT ON SEPARATE CIRCUIT)		
Notes		
FOR FUTURE GAS COOKTOP		
ELECTRICAL OUTLETS		1.00
Opt. Description		
S/I 240V (40 AMP) RECEPTACLE ON A SEPARATE CIRCUIT		

Spec Lot Addendum(s)

Project: Pine Valley Forevergreen - Ph 2, Model: 4205(B) - BROADVIEW, Lot: 0042
69, Terravista Crescent, Vaughan, ONTARIO

Category	Attribute	Opt. Quantity
Notes	FOR FUTURE WALL OVEN	
ELECTRICAL OUTLETS		1.00
Opt. Description	Capped Ceiling Outlet	
Notes	LOCATE APPROX CENTERED ABOVE ISLAND, SAME SWITCH AS STANDARD CEILING LIGHT	
ELECTRICAL		1.00
Opt. Description	BASE STND - 8 INCLUDED 4" WHITE E/S LED POT LIGHTS with (1) SWITCH. TO BE LOCATED ON MAIN FLOOR IN (1) ROOM ONLY.	
Notes		
ELECTRICAL		1.00
Opt. Description	Kit/Serv Led Valance Fixture - 42" Series only	
Notes		
ELECTRICAL		1.00
Opt. Description	RELOCATE STANDARD CEILING MOUNT FIXTURE	
Notes	LOCATE APPROX CENTERED ABOVE ISLAND, SEE PLAN FOR LOCATION	
GASLINE		1.00
Opt. Description	GAS LINE ROUGH-IN - MAIN FLOOR FOR APPLIANCE	
Notes	FOR GAS COOKTOP	
Library		
Category	Attribute	Opt. Quantity
ELECTRICAL		4.00
Opt. Description	S/I 4" E/S LED INTERIOR POT LIGHT - EACH. WHITE	
Notes	IN ADDITION TO STANDARD CEILING LIGHT	
ELECTRICAL SWITCHES		1.00
Opt. Description	S/I ADDITIONAL INTERIOR SWITCH. SINGLE POLE	
Notes	FOR POTLIGHTS	
FRAMING		1.00
Opt. Description	S/I COFFERED CEILING (OPTIONAL PER ROOM)	
Notes		
INTERIOR DOORS AND TRIM		1.00
Opt. Description		

Spec Lot Addendum(s)

Project: Pine Valley Forevergreen - Ph 2, Model: 4205(B) - BROADVIEW, Lot: 0042
69, Terravista Crescent, Vaughan, ONTARIO

Category	Attribute	Opt. Quantity
S/I - NEW ENCLOSURE W/ DOUBLE FRENCH DOORS		
Notes		
Mud Room		
Category	Attribute	Opt. Quantity
ELECTRICAL SWITCHES		1.00
Opt. Description		
S/I HINGE SWITCH - EACH INCLUDES 1 LED POTLIGHT (DOOR ACTIVATED)		
Notes		
Whole House		
Category	Attribute	Opt. Quantity
INTERIOR DOORS AND TRIM		17.00
Opt. Description		
S/I 8FT HIGH DOOR THROUGHOUT SECOND FLOOR IN LIEU OF STANDARD HEIGHT DOOR. PRICE IS PER DOOR		
Notes		

Spec Lot Addendum(s)

Project: Pine Valley Forevergreen - Ph 2, Model: 4205(B) - BROADVIEW, Lot: 0042
69, Terravista Crescent, Vaughan, ONTARIO

Addendum 02/[02] | PRE-STRUCTURAL ORDER

STRUCTURAL EXTRA'S

Basement (Unfinished) Area		
Category	Attribute	Opt. Quantity
CONCRETE AND DRAIN		1.00
Opt. Description		
S/I BACK -FLOW PREVENTER VALVE (BASEMENT)		
Notes		
BASEMENT WINDOWS		5.00
Opt. Description		
S/I BASEMENT WINDOW SIZE 30" X 24" IN LIEU OF STANDARD 10" - WHITE. WINDOW WELLS MAY BE REQUIRED.		
Notes		
Hall 2nd Level		
Category	Attribute	Opt. Quantity
EXT, WINDOWS AND DOORS		1.00
Opt. Description		
ADD SKYLIGHT - FIXED (AS PER PLAN)		
Notes		
APPROX 48X48" FLARED		

Spec Lot Addendum(s)

Project: Pine Valley Forevergreen - Ph 2, Model: 4205(B) - BROADVIEW, Lot: 0042
69, Terravista Crescent, Vaughan, ONTARIO

This is your direction to install the above extras in accordance with the following terms and conditions:

1. In the event the work on the house has progressed beyond the point where the items covered by this extra agreement cannot be installed without entailing any unusual expense, this order is to be cancelled and any deposit paid in connection with same is to be refunded to the purchaser.
2. The Vendor will undertake to incorporate the work covered by the sales extra in the construction of the house but will not be liable to the purchaser in anyway, if for any reason the work covered by the extra is not carried out. In that event, any monies paid in connection with same shall be returned to the purchaser.
3. It is understood and agreed that if for any reason whatsoever the transaction of the Purchase and Sale is not completed, the total cost of the extras ordered are not refundable to the Purchaser(s).
4. Extras or changes will not be processed unless signed by the Vendor.
5. These extras may not be amended without the written consent of Gold Park Homes.
6. The purchaser(s) and the builder acknowledge and agree that this "Purchaser Extra" form shall not be part of the Agreement of Purchase and Sale entered into between them, nor an addendum thereto.
7. Prices are estimates only and guaranteed for a period of 5 business days.
8. Post-dated cheques with NOT be accepted.
9. Estimates or orders will NOT be accepted once construction has commenced.
10. All extras/selections are final, checked and approved by purchaser. Purchaser has reviewed and confirmed there are no missing or outstanding items.
11. Any inquiry to re-open a file and/or request a change to any extra or selection is subject to a minimum fee of \$1500.00 (fifteen hundred dollars).
12. No estimates will be considered an official order until submitted as a signed Purchaser Extra order, accompanied by payment in full.
13. Purchaser has reviewed this addendum for accuracy. There are no outstanding items.
14. Once extras/selections are signed, they are considered final. Absolutely no changes or deletions will be accepted regardless of when selections are finalized or the stage of construction.

SCHEDULE 'F'




PV2-42
 SEPT 22 2022
 OCT 11 2022
 NOV. 1, 2022

The Broadview

DEER RUN COLLECTION

Elevation A - 3,461 sq.ft.
 Plus 132 sq.ft. Fin. Basement Foyer
 Elevation B - 3,468 sq.ft.
 Plus 132 sq.ft. Fin. Basement Foyer
 Elevation C - 3,487 sq.ft.
 Plus 132 sq.ft. Fin. Basement Foyer

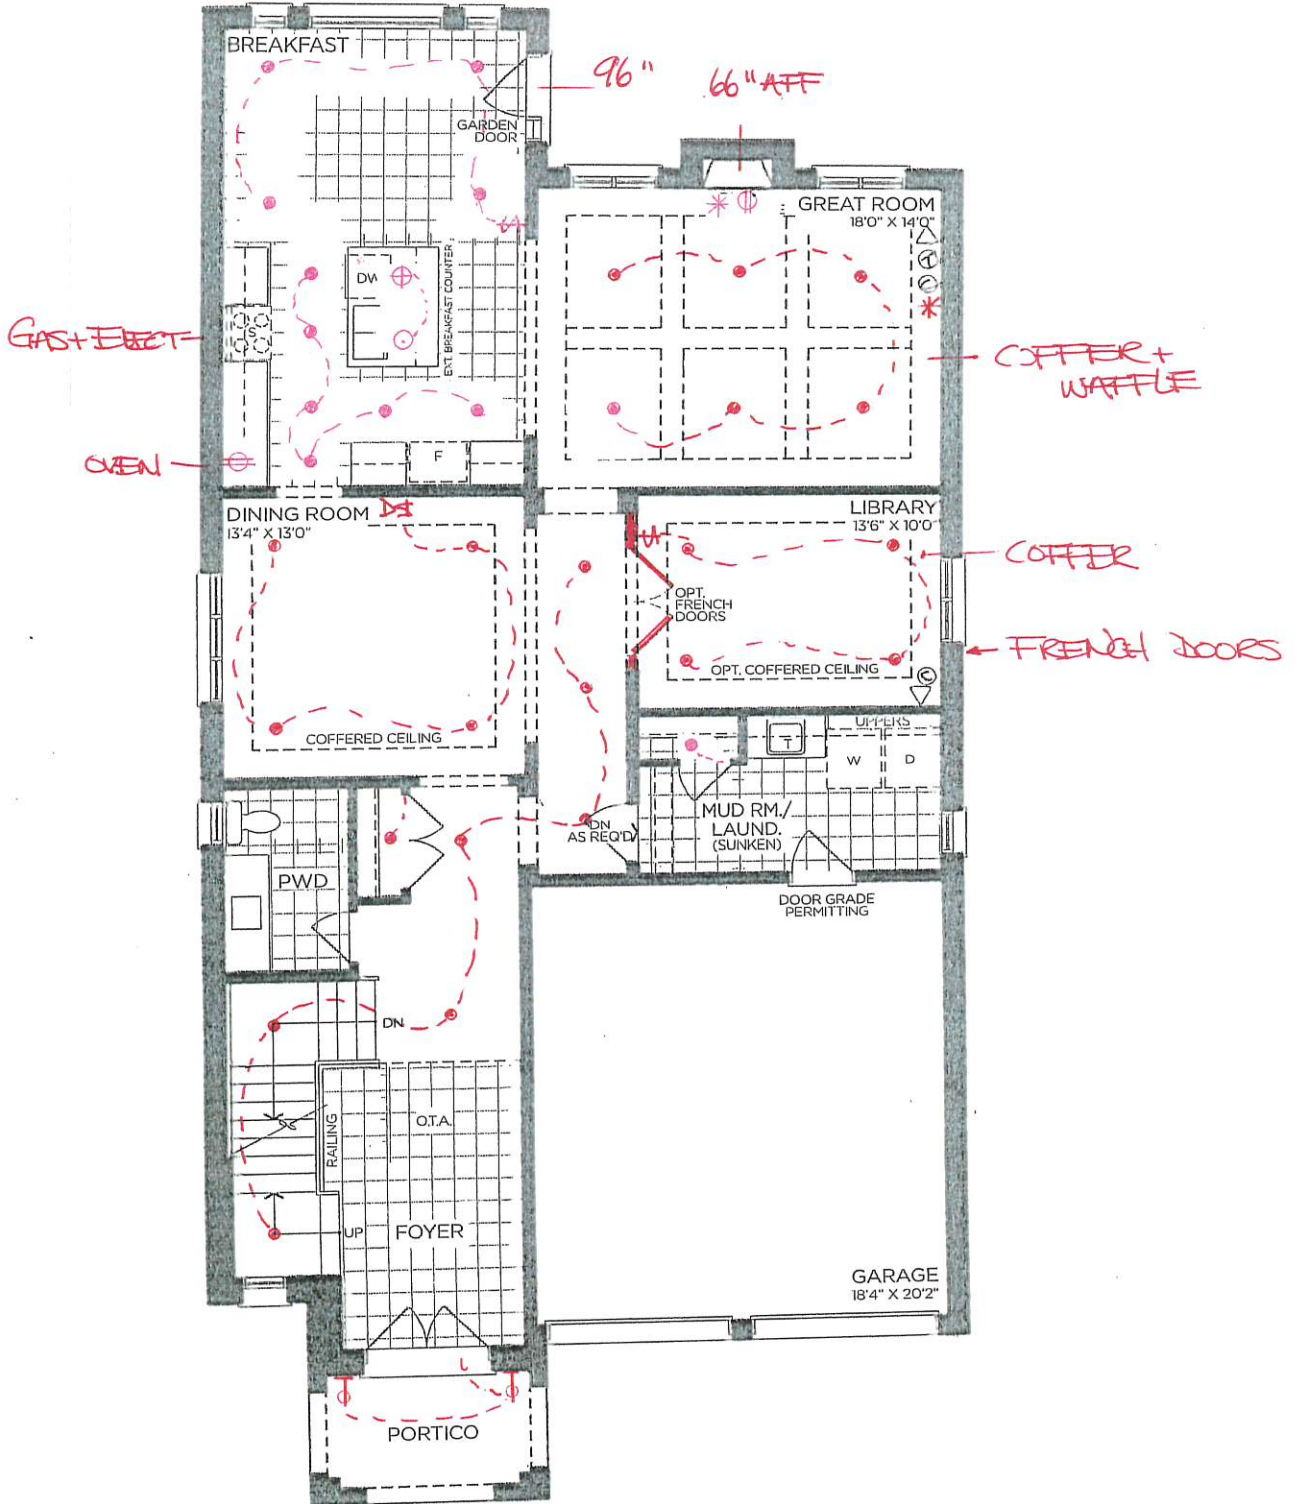

GROUND FLOOR | ELEV. A

VENDOR

PURCHASER

PURCHASER

GOLDPARK
 WORTH MORE™

Prices, figures, illustrations, sizes, features and finishes are subject to change without notice. Areas and dimensions are approximate and actual usable floor space may vary from the stated area. Layout may be reverse of the unit purchased. E. & O.E. 4205


SCHEDULE 'F'



PV2-42
 SEPT 22 2022
 OCT 11 2022
 NOV. 1, 2020

The
Broadview
 DEER RUN COLLECTION

Elevation A - 3,461 sq.ft.
 Plus 132 sq.ft. Fin. Basement Foyer
 → Elevation B - 3,468 sq.ft.
 Plus 132 sq.ft. Fin. Basement Foyer
 Elevation C - 3,487 sq.ft.
 Plus 132 sq.ft. Fin. Basement Foyer

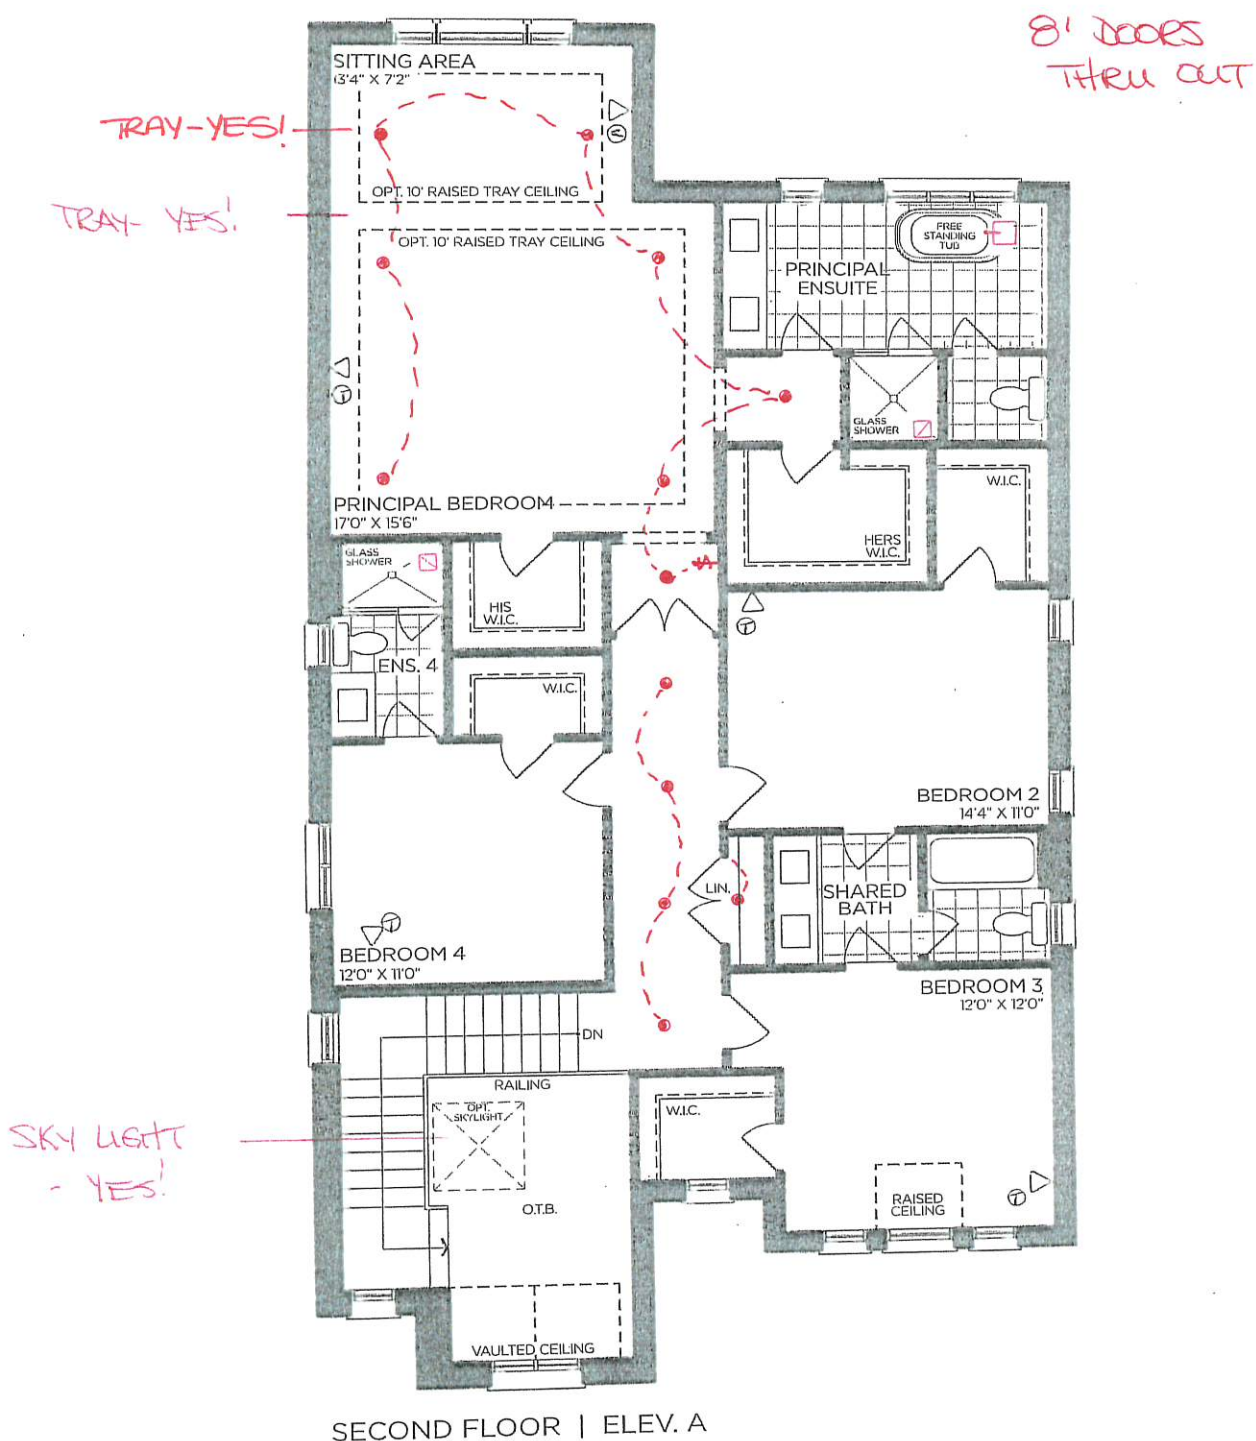

SECOND FLOOR | ELEV. A

VENDOR

PURCHASER

PURCHASER

GOLDPARK
 WORTH MORE™

Prices, figures, illustrations, sizes, features and finishes are subject to change without notice. Areas and dimensions are approximate and actual usable floor space may vary from the stated area. Layout may be reverse of the unit purchased. E. & O.E. 4205

SCHEDULE 'F'




PV2-42
 SEPT 22 2022
 OCT 11 2022
 NOV. 1, 2022

The Broadview

DEER RUN COLLECTION

Elevation A - 3,461 sq.ft.
 Plus 132 sq.ft. Fin. Basement Foyer
 → Elevation B - 3,468 sq.ft.
 Plus 132 sq.ft. Fin. Basement Foyer
 Elevation C - 3,487 sq.ft.
 Plus 132 sq.ft. Fin. Basement Foyer

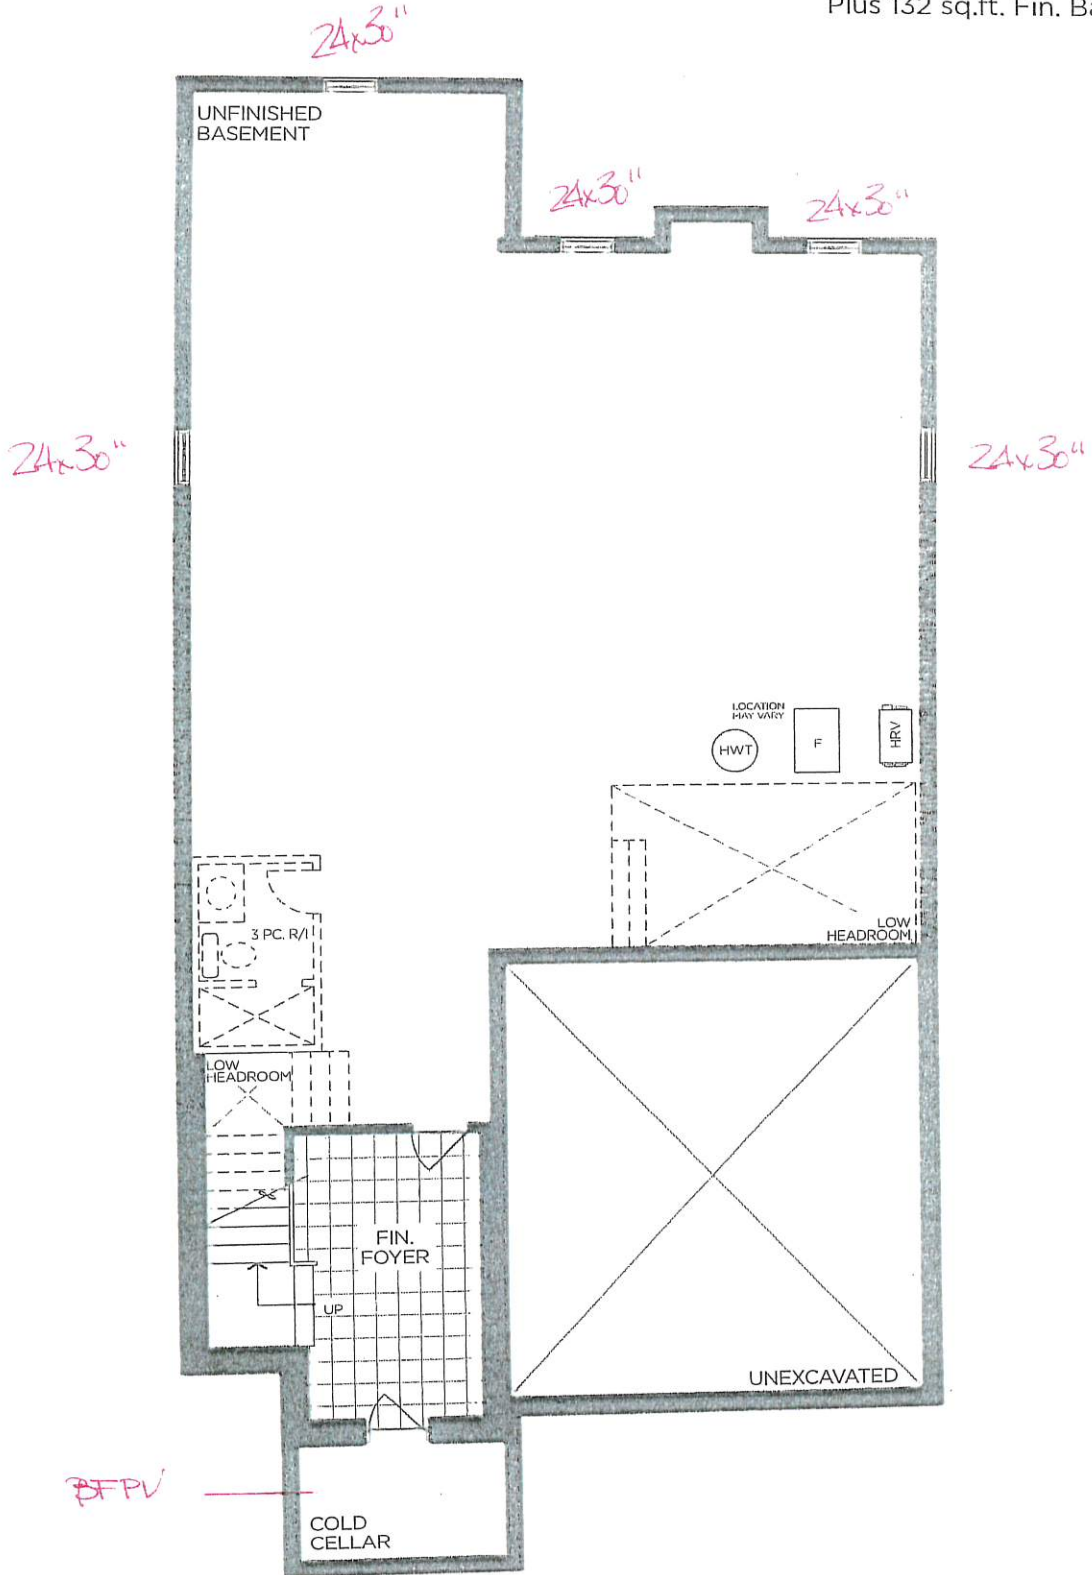

BASEMENT | ELEV. A & B

VENDOR

PURCHASER

PURCHASER

GOLDPARK
 WORTH MORE™

Prices, figures, illustrations, sizes, features and finishes are subject to change without notice. Areas and dimensions are approximate and actual usable floor space may vary from the stated area. Layout may be reverse of the unit purchased. E. & O.E. 4205

SCHEDULE 'F'




PV2-42
 SEPT 22 2022
 OCT 11 2022
 NOV. 1, 2022


The Broadview

DEER RUN COLLECTION


Elevation A - 3,461 sq.ft.
 Plus 132 sq.ft. Fin. Basement Foyer
 Elevation B - 3,468 sq.ft.
 Plus 132 sq.ft. Fin. Basement Foyer
 Elevation C - 3,487 sq.ft.
 Plus 132 sq.ft. Fin. Basement Foyer

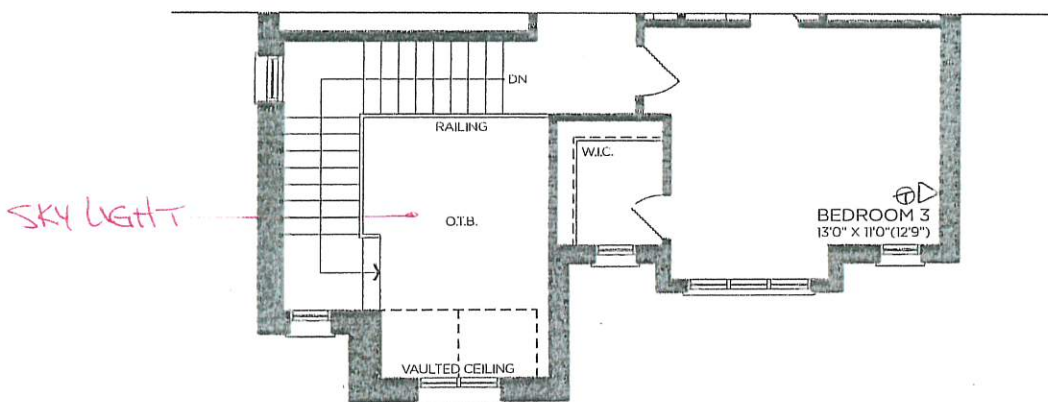

PART. SECOND FLOOR | ELEV. B

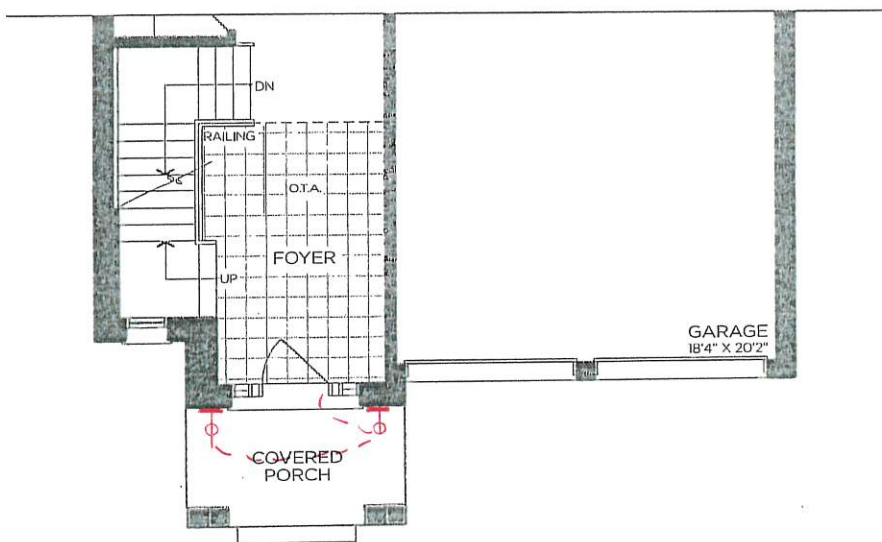

PART. GROUND FLOOR | ELEV. B

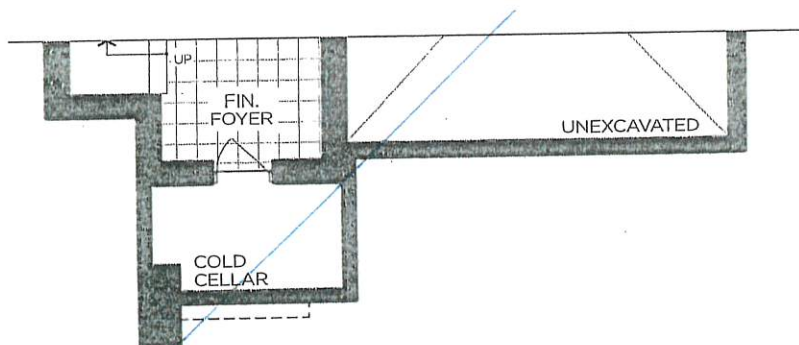

PART. BASEMENT | ELEV. C

VENDOR

PURCHASER

PURCHASER

GOLDPARK
 WORTH MORE™

Prices, figures, illustrations, sizes, features and finishes are subject to change without notice. Areas and dimensions are approximate and actual usable floor space may vary from the stated area. Layout may be reverse of the unit purchased. E. & O.E. 4205

SCHEDULE 'F'




PV2-42
 SEPT 22 2022
 OCT 11 2022

The Broadview

DEER RUN COLLECTION

Elevation A - 3,461 sq.ft.
 Plus 132 sq.ft. Fin. Basement Foyer
 Elevation B - 3,468 sq.ft.
 Plus 132 sq.ft. Fin. Basement Foyer
 Elevation C - 3,487 sq.ft.
 Plus 132 sq.ft. Fin. Basement Foyer

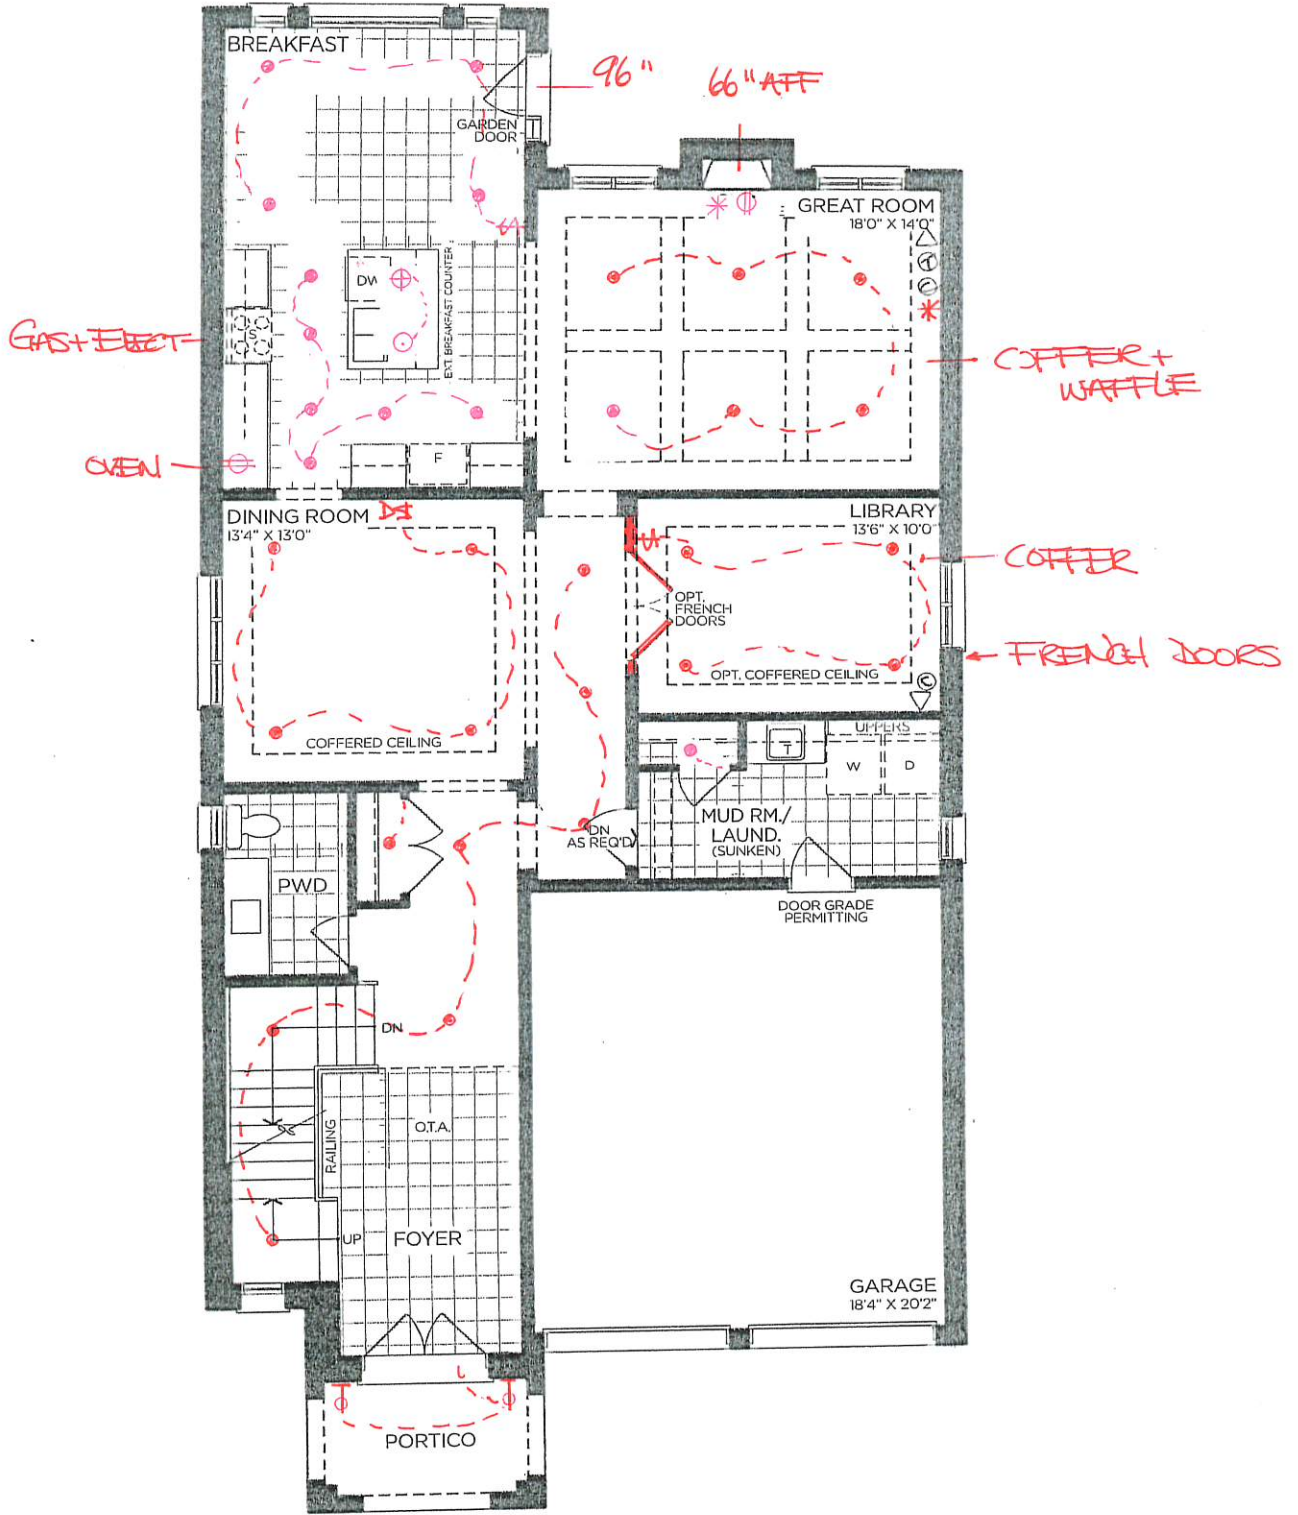

GROUND FLOOR | ELEV. A

VENDOR

PURCHASER

PURCHASER

GOLDPARK
 WORTH MORE™

Prices, figures, illustrations, sizes, features and finishes are subject to change without notice. Areas and dimensions are approximate and actual usable floor space may vary from the stated area. Layout may be reverse of the unit purchased. E. & O.E. 4205

SCHEDULE 'F'




PV2-42
 SEPT 22 2022
 OCT 11 2022

The Broadview

DEER RUN COLLECTION

Elevation A - 3,461 sq.ft.
 Plus 132 sq.ft. Fin. Basement Foyer
 → Elevation B - 3,468 sq.ft.
 Plus 132 sq.ft. Fin. Basement Foyer
 Elevation C - 3,487 sq.ft.
 Plus 132 sq.ft. Fin. Basement Foyer

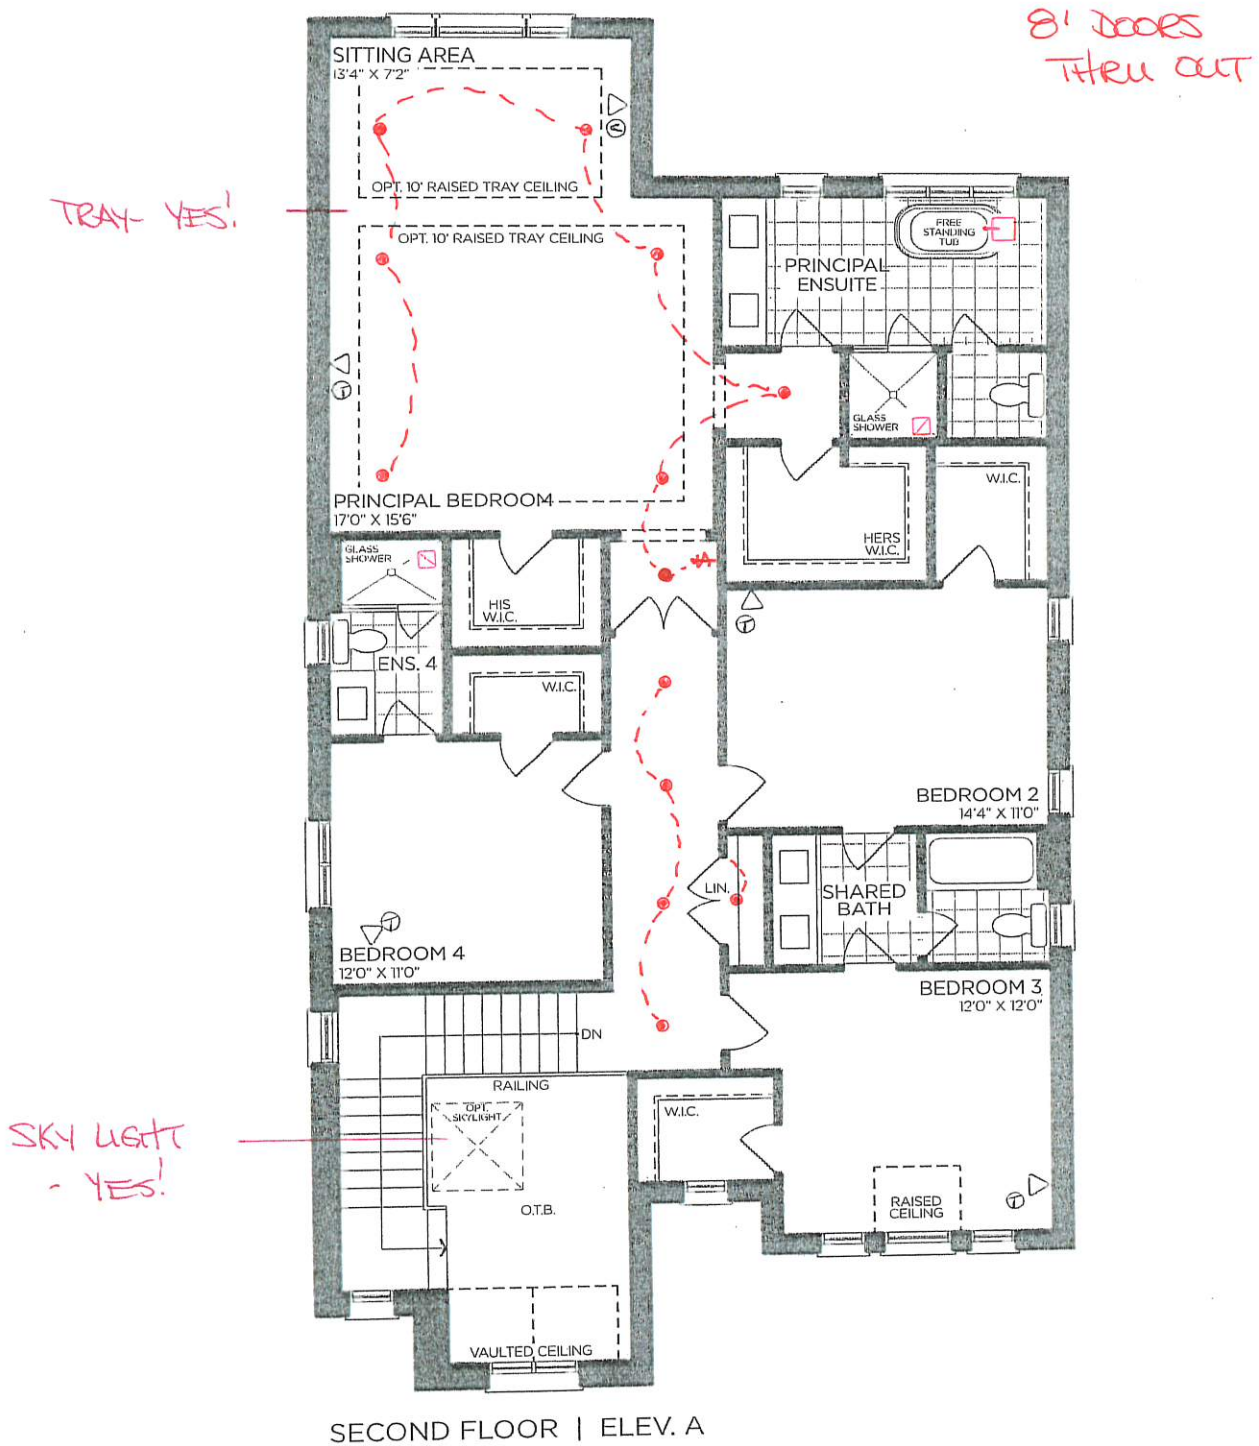

SECOND FLOOR | ELEV. A

VENDOR

PURCHASER

PURCHASER

GOLDPARK
 WORTH MORE™

Prices, figures, illustrations, sizes, features and finishes are subject to change without notice. Areas and dimensions are approximate and actual usable floor space may vary from the stated area. Layout may be reverse of the unit purchased. E. & O.E. 4205

SCHEDULE 'F'




PV2-42
 SEPT 22 2022
 OCT 11 2022

The Broadview

DEER RUN COLLECTION

Elevation A - 3,461 sq.ft.
 Plus 132 sq.ft. Fin. Basement Foyer
 → Elevation B - 3,468 sq.ft.
 Plus 132 sq.ft. Fin. Basement Foyer
 Elevation C - 3,487 sq.ft.
 Plus 132 sq.ft. Fin. Basement Foyer

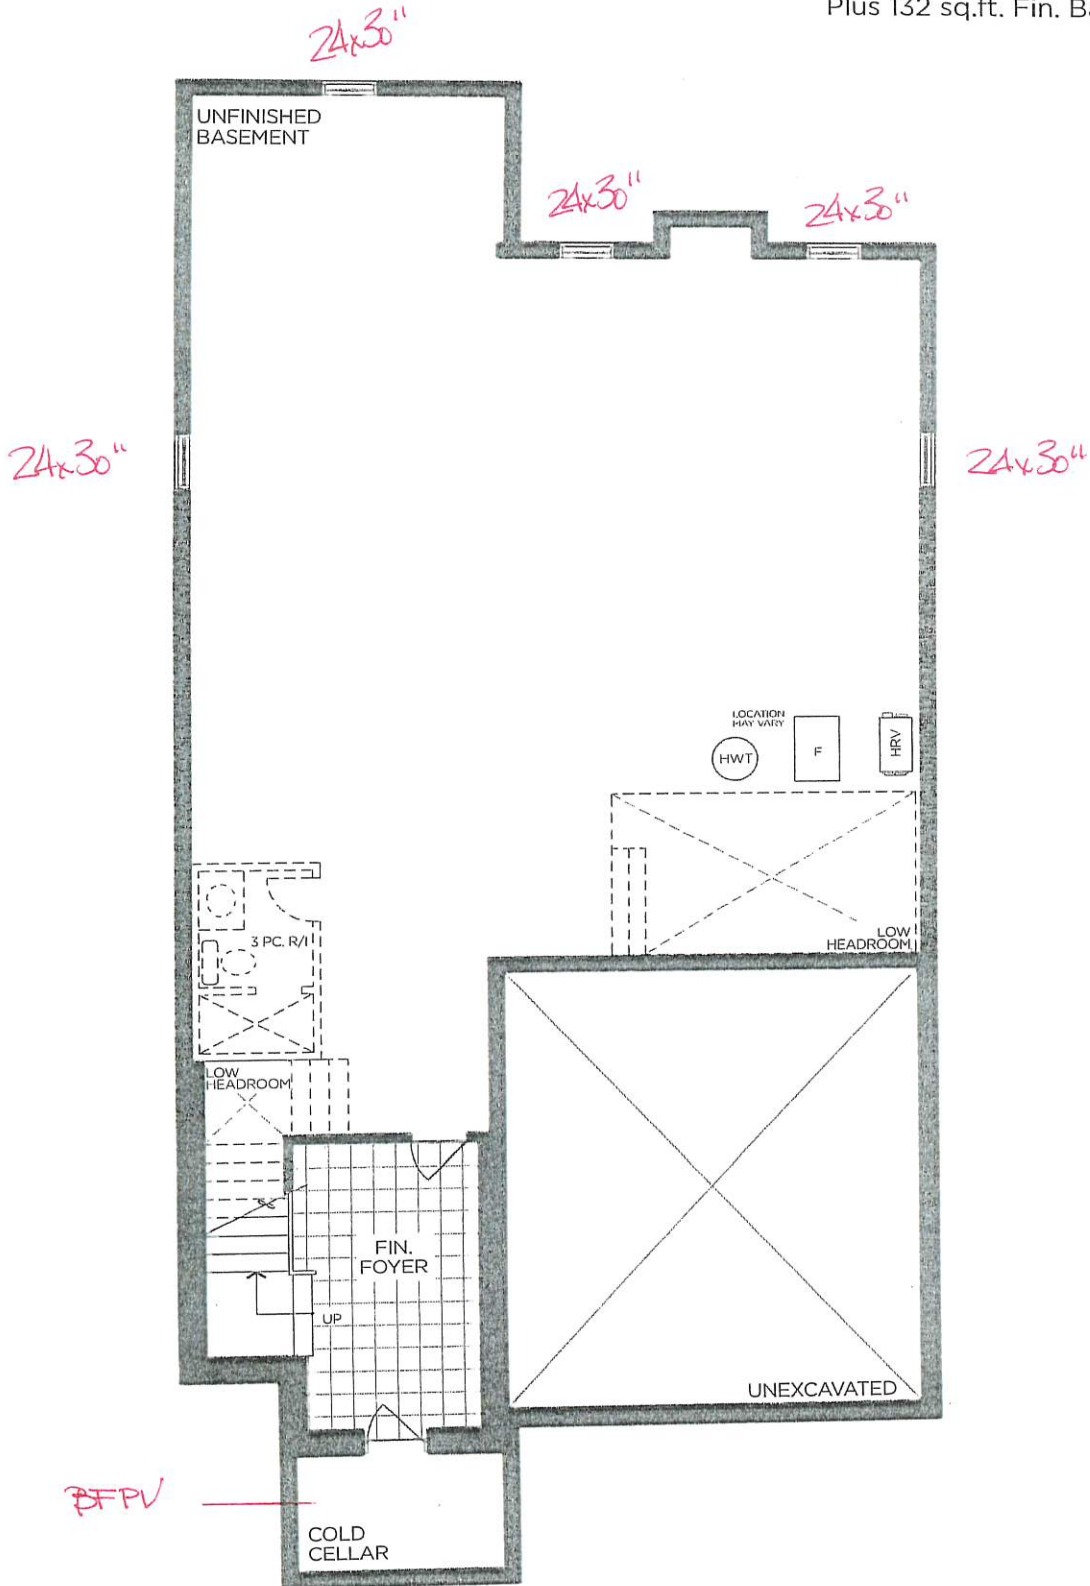

BASEMENT | ELEV. A & B

VENDOR

PURCHASER

PURCHASER

GOLDPARK
 WORTH MORE™

Prices, figures, illustrations, sizes, features and finishes are subject to change without notice. Areas and dimensions are approximate and actual usable floor space may vary from the stated area. Layout may be reverse of the unit purchased. E. & O.E. 4205


SCHEDULE 'F'




PV2-42
 SEPT 22 2022
 OCT 11 2022

The
Broadview
 DEER RUN COLLECTION


Elevation A - 3,461 sq.ft.
 Plus 132 sq.ft. Fin. Basement Foyer
 Elevation B - 3,468 sq.ft.
 Plus 132 sq.ft. Fin. Basement Foyer
 Elevation C - 3,487 sq.ft.
 Plus 132 sq.ft. Fin. Basement Foyer

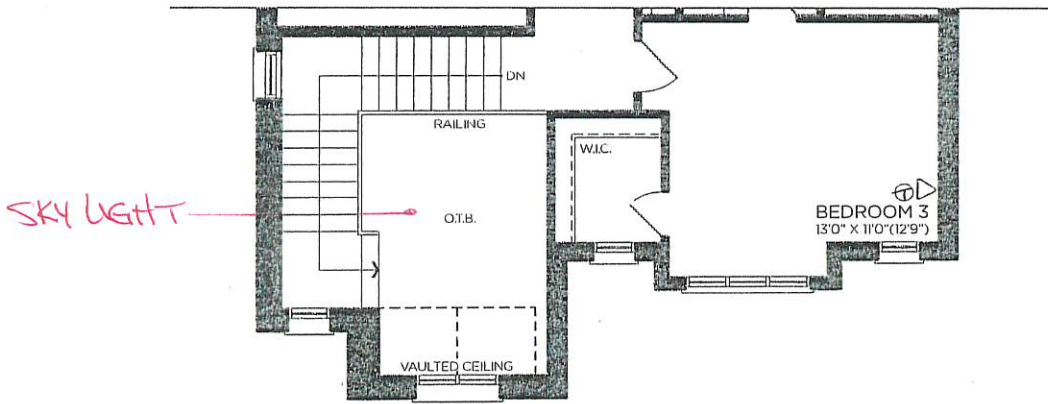

PART. SECOND FLOOR | ELEV. B

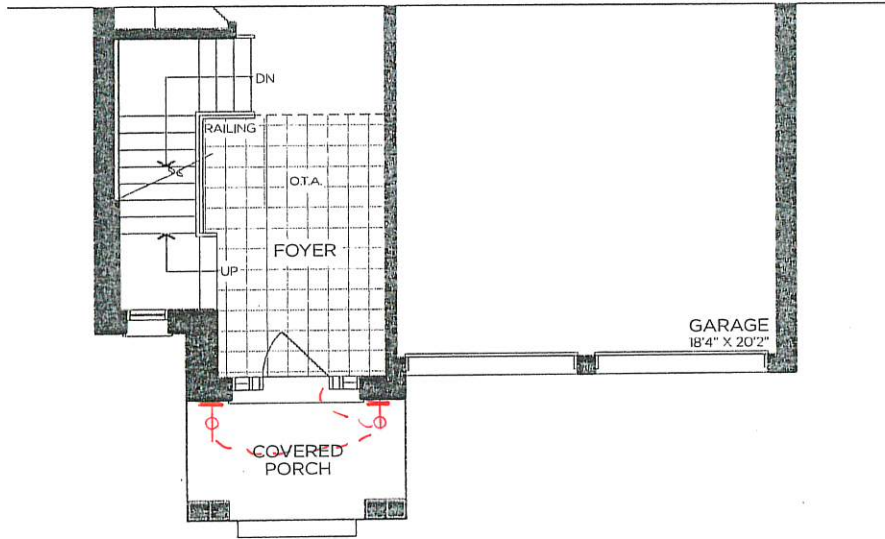

PART. GROUND FLOOR | ELEV. B

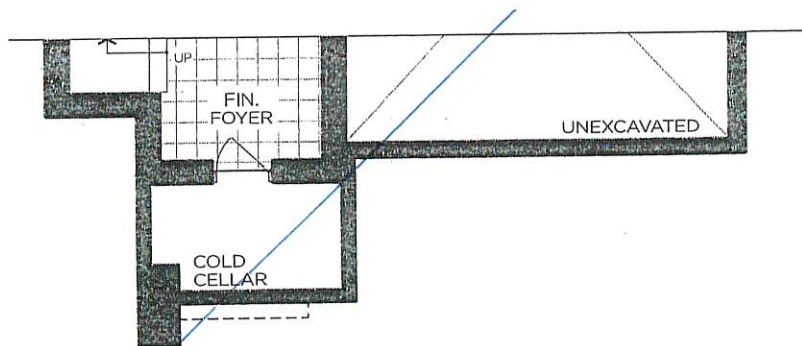

PART. BASEMENT | ELEV. C

VENDOR

PURCHASER

PURCHASER

GOLDPARK
 WORTH MORE™

Prices, figures, illustrations, sizes, features and finishes are subject to change without notice. Areas and dimensions are approximate and actual usable floor space may vary from the stated area. Layout may be reverse of the unit purchased. E. & O.E. 4205



PINE VALLEY
FOREVERGREEN

PLUMBING UPGRADES

ALIGN



- Brushed Gold
- Brushed Nickel
- Chrome
- Matte Black

Date: OCT 11 2022	Lot: 42
Location: PRINCIPAL ENSUITE	
Signature:	Signature:

Freestanding Floor-Mounted Tub Filler
Model 395/TS50100

GOLDPARK
WORTH MORE™



PLUMBING UPGRADES

ALIGN

Ceiling Mount: 226651 (12" Arm)



Brushed Gold



Brushed Nickel



Chrome



Matte Black



Date: OCT 11 2022	Lot: 42
----------------------	------------

Location: PRINCIPAL ENSUITE

Signature:	Signature:
------------	------------


Shower with 3-Function Transfer Valve/Trim and Slide Bar with Hand Shower + 7" Rain Showerhead From Ceiling on 12" Arm
 (includes plumbing provision for ceiling mount showerhead)
 Model T2192EP/UT4191/3887EP/226651/S176/U361CI/
 62320/A725



PINE VALLEY
FOREVERGREEN

PLUMBING UPGRADES

ALIGN

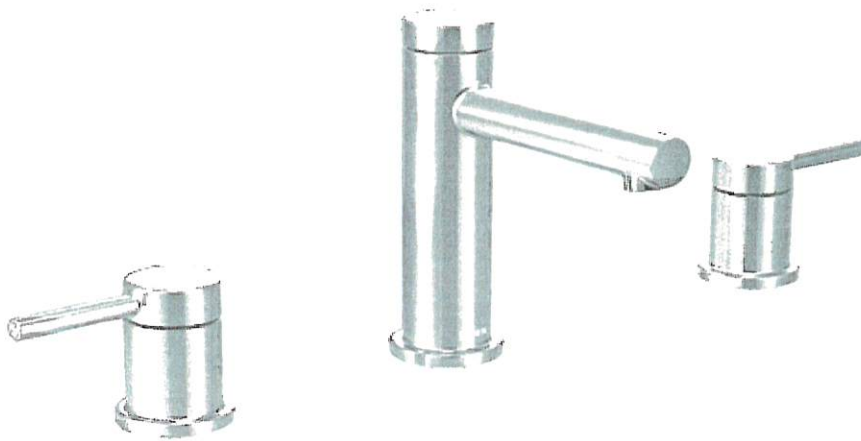

- Brushed Gold x2
- Brushed Nickel
- Chrome
- Matte Black

Date: OCT 11 2022	Lot: 42
Location: PRINCIPAL ENSUITE	
Signature:	Signature:

Two Handle 8" Widespread Lav
Model T6193/69000

GOLD PARK
WORTH MORE™

SCHEDULE 'F'




PV2-42
 SEPT 22 2022

The Broadview

DEER RUN COLLECTION

Elevation A - 3,461 sq.ft.
 Plus 132 sq.ft. Fin. Basement Foyer
 ———> Elevation B - 3,468 sq.ft.
 Plus 132 sq.ft. Fin. Basement Foyer
 Elevation C - 3,487 sq.ft.
 Plus 132 sq.ft. Fin. Basement Foyer

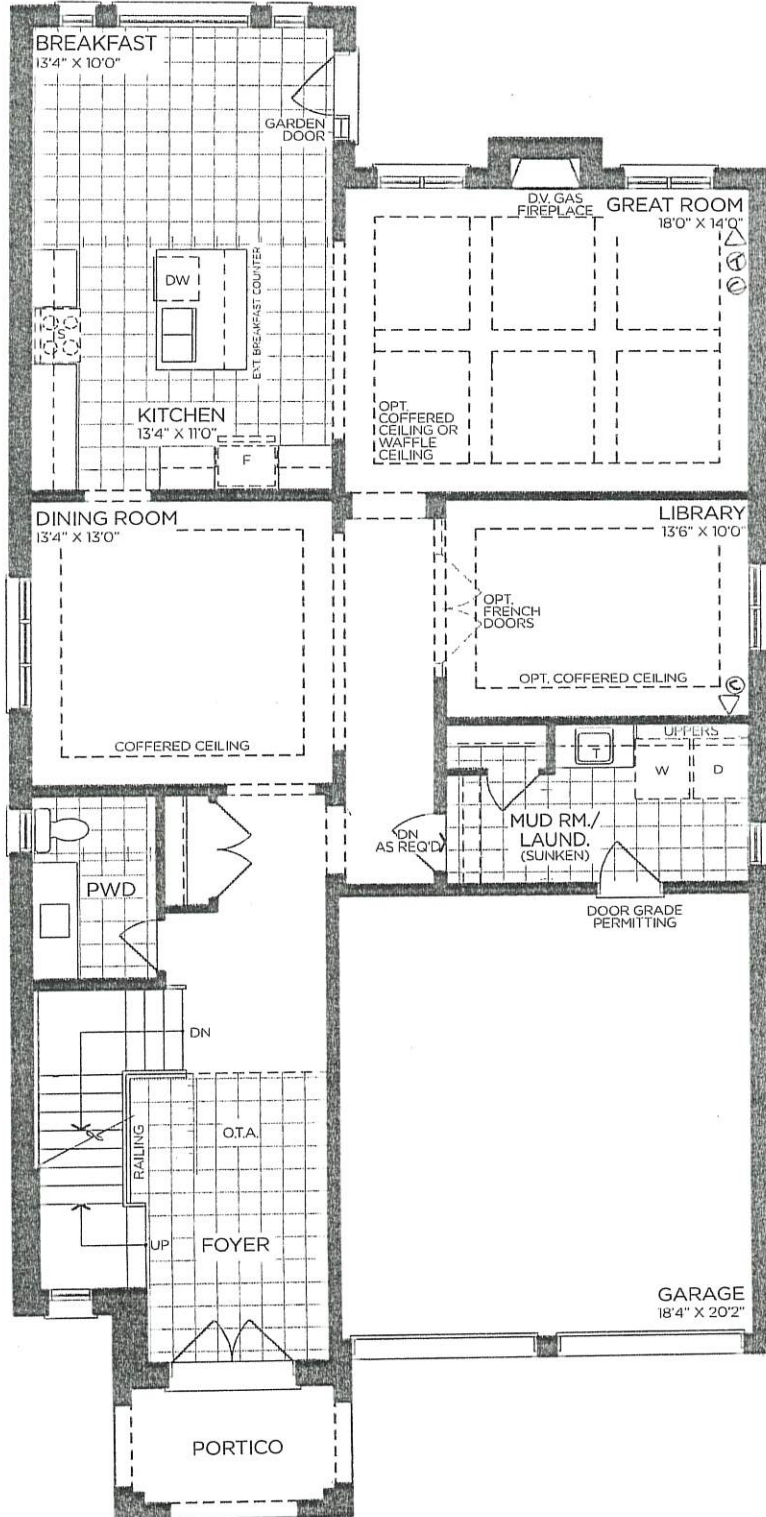

GROUND FLOOR | ELEV. A

VENDOR

PURCHASER

PURCHASER

GOLDPARK
 WORTH MORE™

Prices, figures, illustrations, sizes, features and finishes are subject to change without notice. Areas and dimensions are approximate and actual usable floor space may vary from the stated area. Layout may be reverse of the unit purchased. E. & O.E. 4205

SCHEDULE 'F'



PV2-42
 SEPT 22 2022


The Broadview

DEER RUN COLLECTION

Elevation A - 3,461 sq.ft.
 Plus 132 sq.ft. Fin. Basement Foyer
 → Elevation B - 3,468 sq.ft.
 Plus 132 sq.ft. Fin. Basement Foyer
 Elevation C - 3,487 sq.ft.
 Plus 132 sq.ft. Fin. Basement Foyer

TRAY YES!

SKY LIGHT - YES!

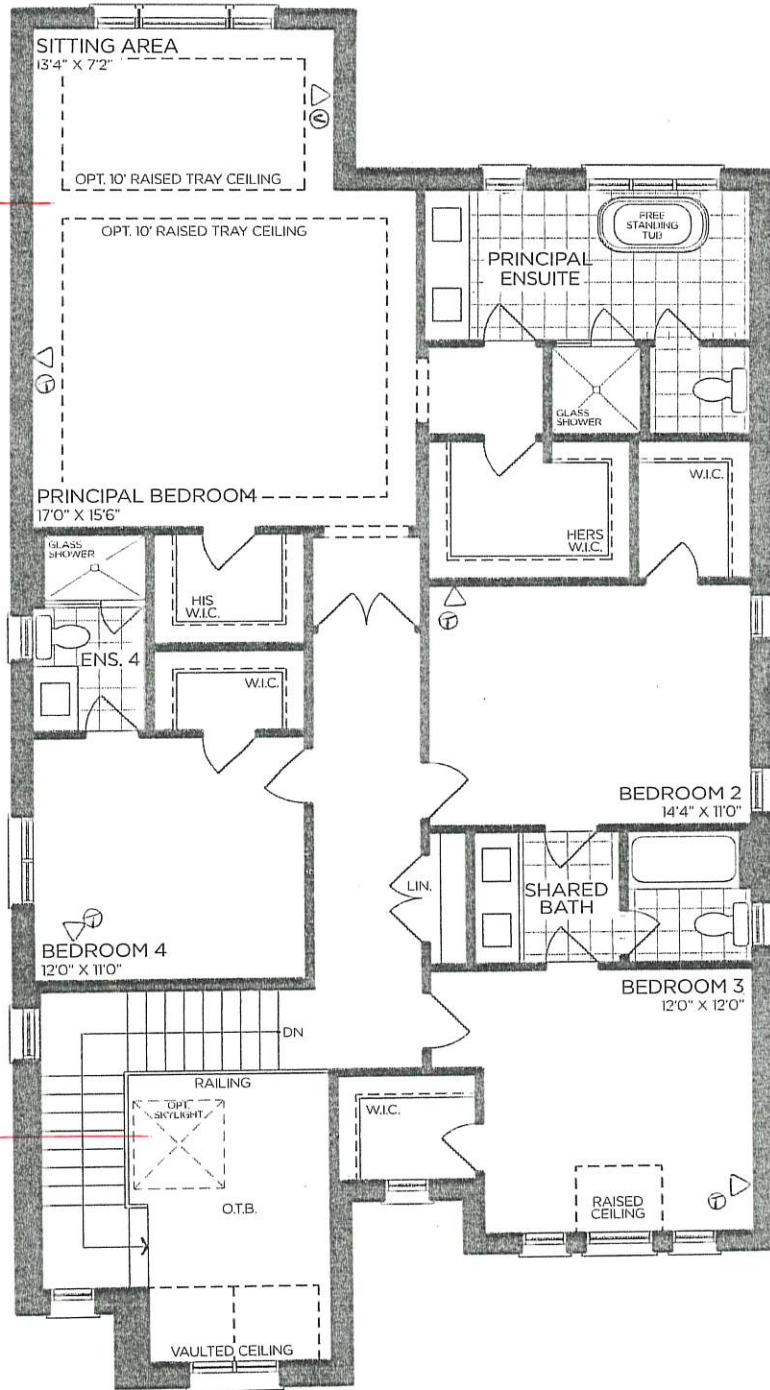

SECOND FLOOR | ELEV. A

VENDOR

PURCHASER

PURCHASER

GOLDPARK
 WORTH MORE™

Prices, figures, illustrations, sizes, features and finishes are subject to change without notice. Areas and dimensions are approximate and actual usable floor space may vary from the stated area. Layout may be reverse of the unit purchased. E. & O.E. 4205

SCHEDULE 'F'




PV2-42
~~SEP~~ 22 2022

The Broadview

DEER RUN COLLECTION

- Elevation A - 3,461 sq.ft.
 Plus 132 sq.ft. Fin. Basement Foyer
- Elevation B - 3,468 sq.ft.
 Plus 132 sq.ft. Fin. Basement Foyer
- Elevation C - 3,487 sq.ft.
 Plus 132 sq.ft. Fin. Basement Foyer

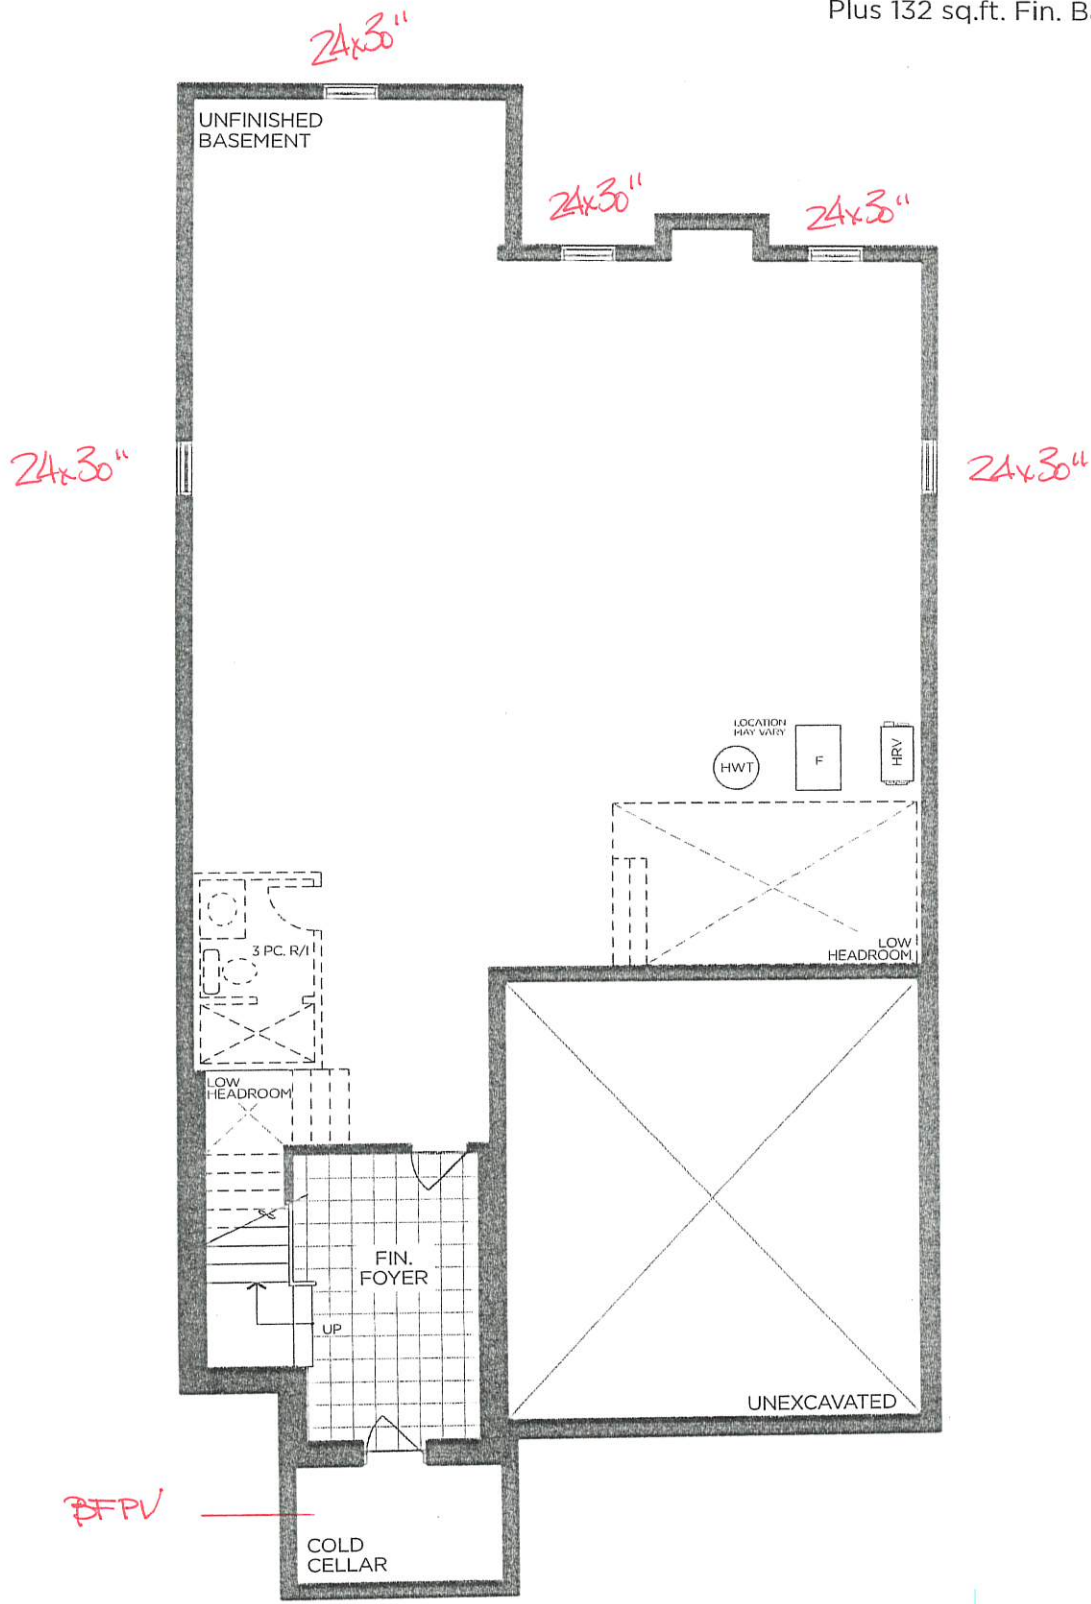

BASEMENT | ELEV. A & B

VENDOR

PURCHASER

PURCHASER

GOLDPARK
 WORTH MORE™

Prices, figures, illustrations, sizes, features and finishes are subject to change without notice. Areas and dimensions are approximate and actual usable floor space may vary from the stated area. Layout may be reverse of the unit purchased. E. & O.E. 4205

SCHEDULE 'F'




PV2-42
SEPT 22 2022


The Broadview

DEER RUN COLLECTION


Elevation A - 3,461 sq.ft.
Plus 132 sq.ft. Fin. Basement Foyer
→ Elevation B - 3,468 sq.ft.
Plus 132 sq.ft. Fin. Basement Foyer
 Elevation C - 3,487 sq.ft.
Plus 132 sq.ft. Fin. Basement Foyer

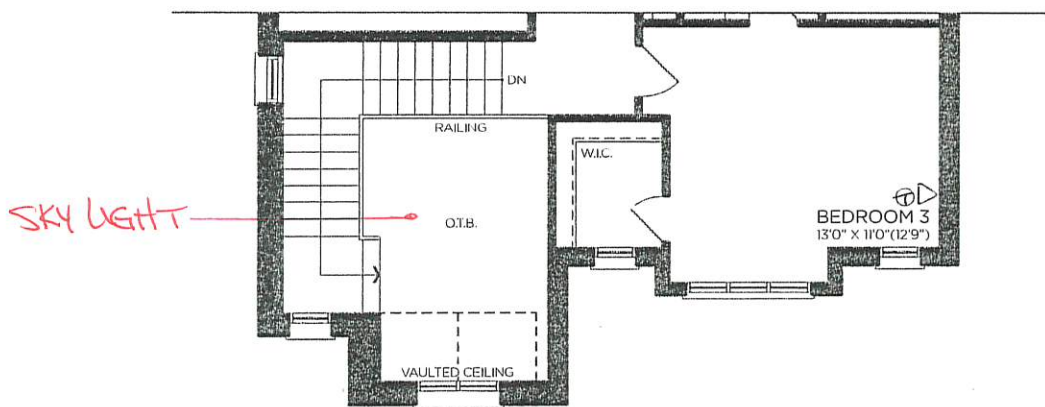

PART. SECOND FLOOR | ELEV. B

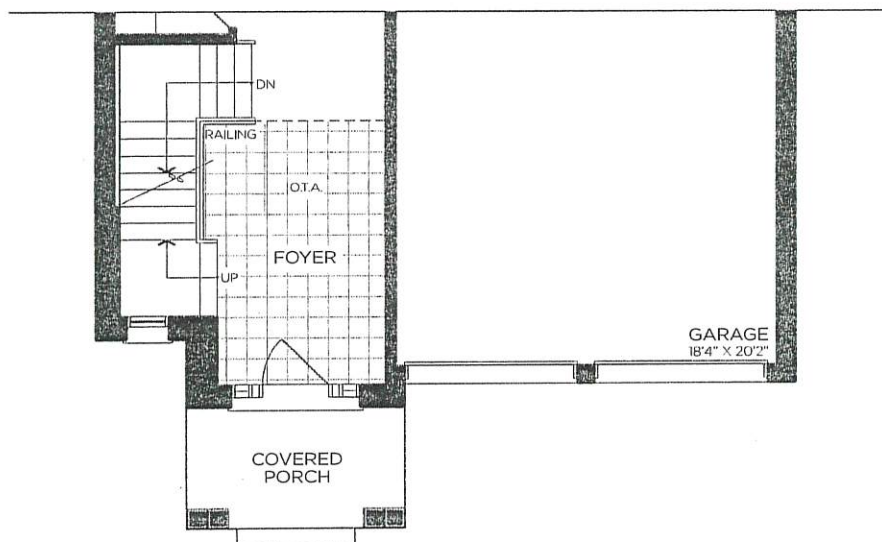

PART. GROUND FLOOR | ELEV. B

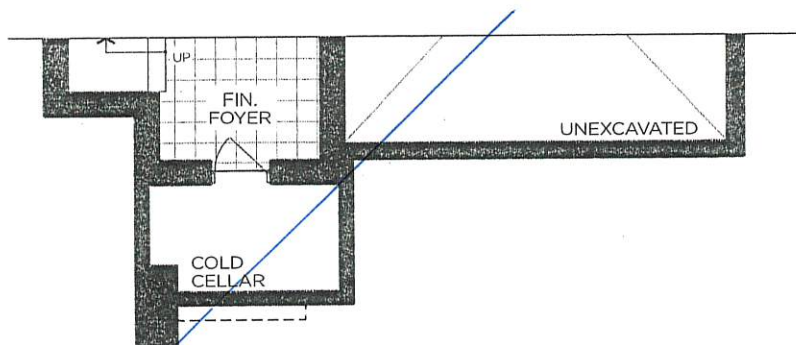

PART. BASEMENT | ELEV. C

VENDOR

PURCHASER

PURCHASER

GOLDPARK
WORTH MORE™

Prices, figures, illustrations, sizes, features and finishes are subject to change without notice. Areas and dimensions are approximate and actual usable floor space may vary from the stated area. Layout may be reverse of the unit purchased. E. & O.E. 4205