

M

THE MANORS
AT FOUR VALLEY

The Stanford Manor

3-4 BEDROOMS | 4.5 BATHROOMS

ELEV. A 2922 SQ.FT.
INCLUDES 687 SQ.FT. OF FINISHED BASEMENT

ELEV. B 2926 SQ.FT.
INCLUDES 687 SQ.FT. OF FINISHED BASEMENT

END1 A 2967 SQ.FT.
INCLUDES 694 SQ.FT. OF FINISHED BASEMENT

END1 B 2970 SQ.FT.
INCLUDES 694 SQ.FT. OF FINISHED BASEMENT

END 2 A 2954 SQ.FT.
INCLUDES 696 SQ.FT. OF FINISHED BASEMENT

END 2 B 2954 SQ.FT.
INCLUDES 696 SQ.FT. OF FINISHED BASEMENT


CORNER A 2967 SQ.FT.
INCLUDES 696 SQ.FT. OF FINISHED BASEMENT

T-1-1

October 2023

8' DOORS
on 2ND Floor

APRIL 17 2025

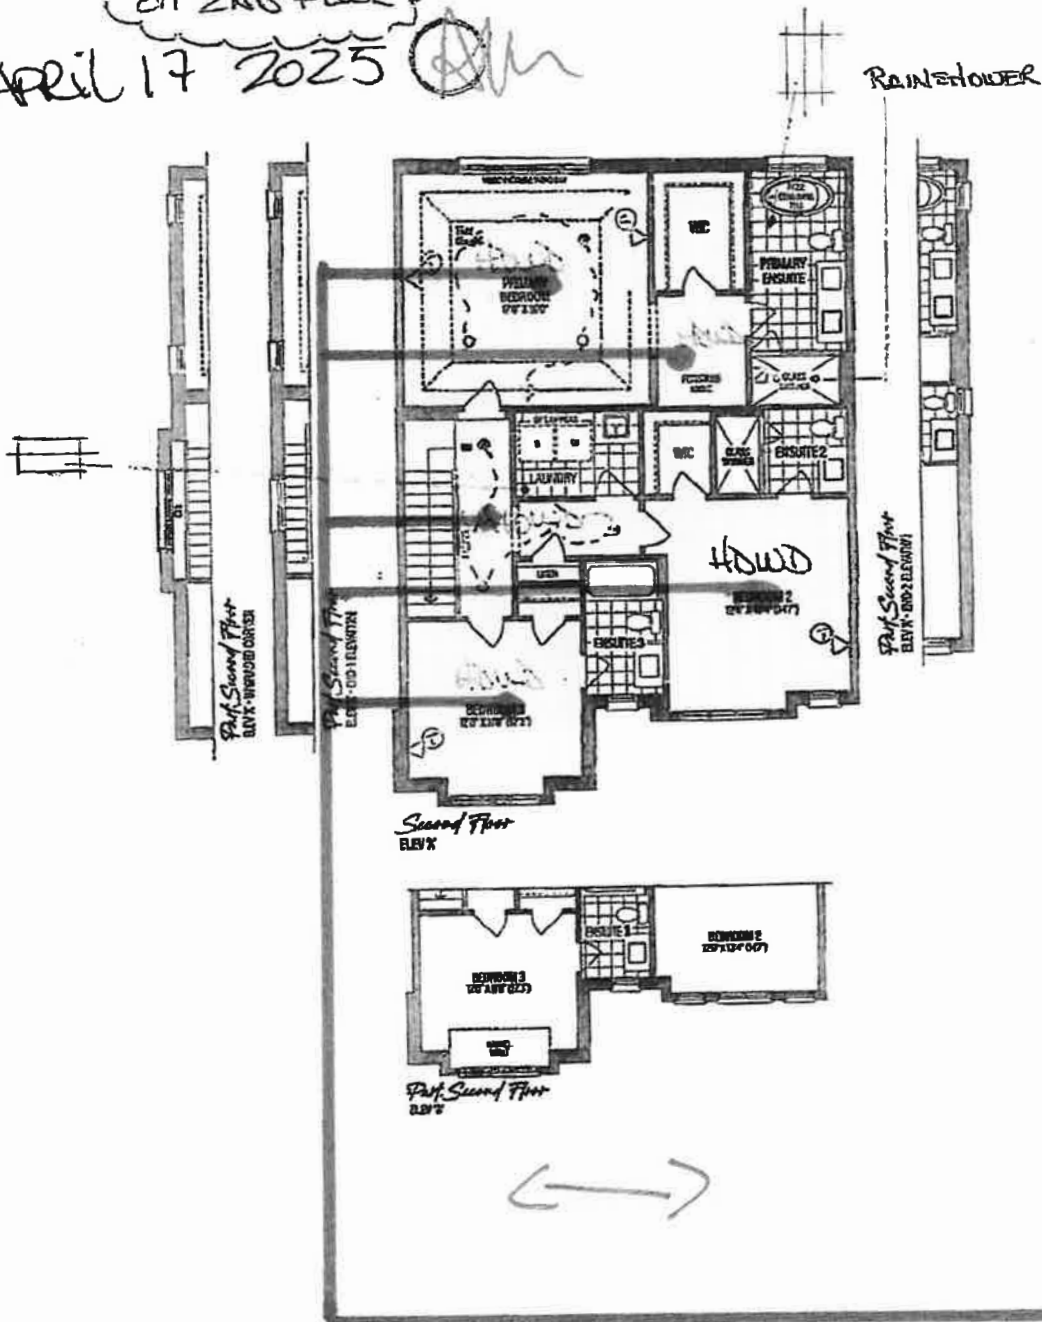

All hardwood areas on 2nd Floor
to Run Side to Side

Please Sign

May 1, 2025



The Stanford Manor

3-4 BEDROOMS | 4.5 BATHROOMS

ELEV. A 2922 SQ.FT.
INCLUDES 687 SQ.FT. OF FINISHED BASEMENT

ELEV. B 2926 SQ.FT.
INCLUDES 687 SQ.FT. OF FINISHED BASEMENT

END 1 A 2967 SQ.FT.
INCLUDES 694 SQ.FT. OF FINISHED BASEMENT

END 1 B 2970 SQ.FT.
INCLUDES 694 SQ.FT. OF FINISHED BASEMENT

END 2 A 2954 SQ.FT.
INCLUDES 695 SQ.FT. OF FINISHED BASEMENT

END 2 B 2954 SQ.FT.
INCLUDES 695 SQ.FT. OF FINISHED BASEMENT

CORNER A 2967 SQ.FT.
INCLUDES 694 SQ.FT. OF FINISHED BASEMENT

T -14-1
October 6, 2023

APRIL 17 2025

All hardwood areas main floor
to Run Side to Side.

Phase Sign

May 1, 2025

