



CONSTRUCTION SUMMARY

Lot: 19

Model: 40-03 A BROOKSIDE

Project/Phase: Pine Valley Forevergreen (2) / 2

CERAMIC

| Invoice                      | Qty. | Description                                                                                                                                                              |
|------------------------------|------|--------------------------------------------------------------------------------------------------------------------------------------------------------------------------|
| 3241<br><br>09Jun25<br>NoCat | 1    | FOYER: UPGRADE FLOOR TILE - 24X24" ETERNITY POLISHED 'RIVIERA WHITE' + BONE GROUT<br><br>LAID IN STRAIGHT, STACKED PATTERN.                                              |
| 3241<br><br>09Jun25<br>NoCat | 1    | POWDER ROOM: UPGRADE FLOOR TILE - 12X24" ETERNA PIASINTINA POLISHED + OCEAN GREY GROUT<br><br>LAID IN STRAIGHT STACKED PATTERN, SEE PLAN FOR TILE DIRECTION              |
| 3241<br><br>09Jun25<br>NoCat | 1    | MUD ROOM: UPGRADE FLOOR TILE - 12X24" MADISON 'LIGHT GREY' MATTE, INCLUDES BLIZZARD GROUT<br><br>LAID IN STRAIGHT, STACKED PATTERN. SEE PLAN FOR TILE DIRECTION          |
| 3241<br><br>09Jun25<br>NoCat | 1    | BASEMENT FOYER: UPGRADE FLOOR TILE - 12X24" MADISON 'LIGHT GREY' MATTE, INCLUDES BLIZZARD GROUT<br><br>LAID IN STRAIGHT, STACKED PATTERN. SEE PLAN FOR TILE DIRECTION    |
| 3241<br><br>09Jun25<br>NoCat | 1    | PRINCIPAL ENSUITE: UPGRADE FLOOR TILE - 12X24" ETERNA VOLKAS POLISHED 'WHITE'<br><br>LAID IN STRAIGHT, STACKED PATTERN. SEE PLAN FOR TILE DIRECTION. INCLUDES BONE GROUT |
| 3241<br><br>09Jun25<br>NoCat | 1    | PRINCIPAL ENSUITE: UPGRADE SHOWER WALL TILE - 4X12" CHESS 'TENDER GREY' GLOSSY<br><br>LAID IN HORIZONTAL STACKED PATTERN. INCLUDES BONE GROUT                            |
| 3241<br><br>09Jun25<br>NoCat | 1    | PRINCIPAL ENSUITE: STANDARD SHOWER FLOOR TILE - 2X2" ONTARIO SNOW WHITE MATTE, INCLUDES BONE GROUT                                                                       |
| 3241<br><br>09Jun25<br>NoCat | 1    | ENSUITE 2 - STANDARD FLOOR TILE - 13X13" COSTA WHITE, INCLUDES BONE GROUT                                                                                                |
| 3241<br><br>09Jun25<br>NoCat | 1    | ENSUITE 2: STANDARD TUB SURROUND WALL TILE - 8X10" WEAVE POLISHED 'WHITE', INCLUDES BONE GROUT                                                                           |
| 3241<br><br>09Jun25<br>NoCat | 1    | SHARED ENSUITE: STANDARD FLOOR TILE - 13X13" SEMPRE WHITE, INCLUDES BONE GROUT<br><br>LAID IN STRAIGHT, STACKED PATTERN                                                  |
| 3241<br><br>09Jun25<br>NoCat | 1    | SHARED ENSUITE: STANDARD SHOWER WALL TILE - 8X10" SPLENDOUR POLISHED 'WHITE', INCLUDES BONE GROUT                                                                        |
| 3241<br><br>09Jun25<br>NoCat | 1    | SHARED ENSUITE: STANDARD SHOWER FLOOR TILE - 2X2" ONTARIO SNOW WHITE MATTE, INCLUDES BONE GROUT                                                                          |



CONSTRUCTION SUMMARY

Lot: 19

Model: 40-03 A BROOKSIDE

Project/Phase: Pine Valley Forevergreen (2) / 2

FIREPLACE - MANTEL

| Invoice          | Qty. | Description                                       |
|------------------|------|---------------------------------------------------|
| 3241             | 1    | GREAT ROOM: INSTALL STANDARD MEDITERRANEAN MANTLE |
| 09Jun25<br>NoCat |      |                                                   |

GLASS AND MIRROR

| Invoice          | Qty. | Description                                              |
|------------------|------|----------------------------------------------------------|
| 3241             | 1    | PRINCIPAL ENSUITE: UPGRADE SHOWER DOOR HANDLE AND HINGES |
| 09Jun25<br>NoCat |      |                                                          |
| 3241             | 1    | SHARED ENSUITE: UPGRADE SHOWER DOOR HANDLE               |
| 09Jun25<br>NoCat |      |                                                          |

GRANITE MARBLE QUARTZ

| Invoice          | Qty. | Description                                                                |
|------------------|------|----------------------------------------------------------------------------|
| 3241             | 1    | POWDER ROOM: UPGRADE QUARTZ COUNTER TOP 'WHITE ARABESQUE'                  |
| 09Jun25<br>NoCat |      |                                                                            |
| 3241             | 1    | KITCHEN: UPGRADE QUARTZ COUNTER TOP 'MISTY CARRARA'                        |
| 09Jun25<br>NoCat |      |                                                                            |
| 3241             | 1    | KITCHEN: UPGRADE COUNTER TOP EDGE PROFILE                                  |
| 09Jun25<br>NoCat |      |                                                                            |
| 3241             | 1    | KITCHEN: UPGRADE TO FULL HEIGHT QUARTZ SLAB BACKSPLASH 'STATUARIO MAXIMUS' |
| 09Jun25<br>NoCat |      | INCLUDES APPROX 20" HIGH AT WINDOW WALL                                    |
| 3241             | 1    | PRINCIPAL ENSUITE: UPGRADE QUARTZ COUNTER TOP 'ATERRA BLANCA'              |
| 09Jun25<br>NoCat |      |                                                                            |
| 3241             | 1    | ENSUITE 2: STANDARD QUARTZ COUNTER TOP ICE SNOW                            |
| 09Jun25<br>NoCat |      |                                                                            |
| 3241             | 1    | SHARED ENSUITE: STANDARD ICE SNOW QUARTZ COUNTER                           |
| 09Jun25<br>NoCat |      |                                                                            |



CONSTRUCTION SUMMARY

Lot: 19

Model: 40-03 A BROOKSIDE

Project/Phase: Pine Valley Forevergreen (2) / 2

HARDWOOD

| Invoice          | Qty. | Description                                                                                    |
|------------------|------|------------------------------------------------------------------------------------------------|
| 3241             | 1    | THRU OUT STANDARD AREAS: UPGRADE HARDWOOD TO 3/4X5" VINTAGE WIREBRUSHED WHITE OAK 'ATLANTIS'   |
| 09Jun25<br>NoCat |      |                                                                                                |
| 3241             | 1    | KITCHEN/BREAKFAST: UPGRADE TO HARDWOOD FLOOR - 3/4X5" VINTAGE WIREBRUSHED WHITE OAK 'ATLANTIS' |
| 09Jun25<br>NoCat |      |                                                                                                |

INTERIOR TRIM AND DOORS

| Invoice          | Qty. | Description                                                                                 |
|------------------|------|---------------------------------------------------------------------------------------------|
| 3241             | 1    | THRU OUT STANDARD AREAS: STANDARD INTERIOR DOOR 'CARRARA' + STANDARD INTERIOR DOOR HARDWARE |
| 09Jun25<br>NoCat |      |                                                                                             |
| 3241             | 1    | THRU OUT STANDARD AREAS: STANDARD INTERIOR TRIM PACKAGE - BASEBOARD AND CASING              |
| 09Jun25<br>NoCat |      |                                                                                             |

KITCHEN AND BATH CABINETRY

| Invoice          | Qty. | Description                               |
|------------------|------|-------------------------------------------|
| 3241             | 1    | THRU OUT: SEE ATTACHED CABINETRY SCHEDULE |
| 09Jun25<br>NoCat |      |                                           |

PAINT

| Invoice          | Qty. | Description                                                                      |
|------------------|------|----------------------------------------------------------------------------------|
| 3241             | 1    | MAIN STAIRS: 2ND FLOOR TO BASEMENT: STAIN STAIRS 'VINTAGE 'ATLANTIS' ON RED OAK' |
| 09Jun25<br>NoCat |      |                                                                                  |
| 3241             | 1    | THRU OUT STANDARD LOCATIONS: PAINT SELECTION 'WARM GREY'                         |
| 09Jun25<br>NoCat |      |                                                                                  |

PLUMBING

| Invoice          | Qty. | Description                                                                          |
|------------------|------|--------------------------------------------------------------------------------------|
| 3241             | 1    | KITCHEN: UPGRADE KITCHEN SINK                                                        |
| 09Jun25<br>NoCat |      |                                                                                      |
| 3241             | 1    | PRINCIPAL ENSUITE: CHANGE TRIM TO ALIGN SUITE (SHOWER/TUB/LAVx2) TO 'BRUSHED NICKEL' |
| 09Jun25<br>NoCat |      |                                                                                      |



CONSTRUCTION SUMMARY

Lot: 19

Model: 40-03 A BROOKSIDE

Project/Phase: Pine Valley Forevergreen (2) / 2


STAIRS AND RAILINGS


| Invoice          | Qty. | Description                                                             |
|------------------|------|-------------------------------------------------------------------------|
| 3241             | 1    | MAIN STAIRS: 2ND FLOOR TO BASEMENT<br>STANDARD 'SIENNA' RAILING PACKAGE |
| 09Jun25<br>NoCat |      |                                                                         |

PV2-19 Cabinetry Schedule

| ROOM               | LEVEL | DESCRIPTION                                                                                                                                                                                                                                                                                                                                                                                                                        |
|--------------------|-------|------------------------------------------------------------------------------------------------------------------------------------------------------------------------------------------------------------------------------------------------------------------------------------------------------------------------------------------------------------------------------------------------------------------------------------|
| KITCHEN:           | UPG   | PERIMETER: SHAKER MDF 'DECORATOR WHITE'                                                                                                                                                                                                                                                                                                                                                                                            |
| ISLAND:            | UPG   | ISLAND: SHAKER MDF 'WROUGHT IRON'                                                                                                                                                                                                                                                                                                                                                                                                  |
| HARDWARE:          | UPG   | SEE ATTACHED                                                                                                                                                                                                                                                                                                                                                                                                                       |
| EXTRAS:            |       | COOKTOP CABINET WITH DRAWERS BELOW + DOUBLE APPLIANCE CABINET<br>SKINNY CABINET WITH SWING DOOR FLANKING COOK TOP DRAWERS (NO SPICE ACCESSORIES)<br>LEAVE APPROX 42" FOR FUTURE 36" CHIMNEY-STYLE HOOD FAN<br>RECYCLE CENTER - 2 BIN<br>POTS AND PANS DRAWERS<br>RECESSED SHAKER LIGHT VALANCE (NOT INCLUDING ELECTRICAL)<br>SHAKER FURNITURE BASE AT ISLAND<br>TOP DRAWER AT ISLAND ABOVE RECYCLE CENTER<br>EXTENDED SHAKER POSTS |
| POWDER ROOM:       | UPG   | SHAKER MDF 'WROUGHT IRON'                                                                                                                                                                                                                                                                                                                                                                                                          |
| HARDWARE:          | STD   | SEE ATTACHED                                                                                                                                                                                                                                                                                                                                                                                                                       |
| MUD ROOM:          | STD   | FLAT PANEL MEL LA RICE BIANCO                                                                                                                                                                                                                                                                                                                                                                                                      |
| HARDWARE:          | STD   | SEE ATTACHED                                                                                                                                                                                                                                                                                                                                                                                                                       |
| P-LAM:             |       | SHALESTONE                                                                                                                                                                                                                                                                                                                                                                                                                         |
| PRINCIPAL ENSUITE: | UPG   | SHAKER MAPLE BLACK WALNUT                                                                                                                                                                                                                                                                                                                                                                                                          |
| HARDWARE:          | STD   | SEE ATTACHED                                                                                                                                                                                                                                                                                                                                                                                                                       |
| ENSUITE 2:         | STD   | FLAT PANEL 'ROLE AZABACHE'                                                                                                                                                                                                                                                                                                                                                                                                         |
| HARDWARE:          | STD   | SEE ATTACHED                                                                                                                                                                                                                                                                                                                                                                                                                       |
| SHARED ENSUITE:    | STD   | FLAT PANEL MELAMINE 'ESPIGA PIMENTA'                                                                                                                                                                                                                                                                                                                                                                                               |
| HARDWARE:          | STD   | SEE ATTACHED                                                                                                                                                                                                                                                                                                                                                                                                                       |

|           |                   |
|-----------|-------------------|
| LOT #: 19 | DATE: JUNE 5 2025 |
|-----------|-------------------|
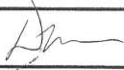
|            |                                                                                                                                                                         |
|------------|-------------------------------------------------------------------------------------------------------------------------------------------------------------------------|
| SIGNATURE: |   |
|------------|-------------------------------------------------------------------------------------------------------------------------------------------------------------------------|
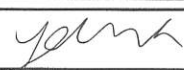
|            |                                                                                                                                                                         |
|------------|-------------------------------------------------------------------------------------------------------------------------------------------------------------------------|
| SIGNATURE: |   |
|------------|-------------------------------------------------------------------------------------------------------------------------------------------------------------------------|

EURO CHOICE  
KITCHENS INC.

2 Watson Rd. S.  
Guelph, On. N1L 1E2  
Phone: 519-821-3670  
Fax: 519-821-3613

PAGE 1 OF 4

ORDER #

CUSTOMER:  
**GOLD PARK HOMES**  
MODEL: THE BROOKSIDE

SHIPPING DIRECTIONS:  
PV2-19  
212 SILVER CREEK DRIVE,  
VAUGHAN, ONTARIO

DATE ORDERED:

DATE REQUIRED:  
KITCHEN PERIMETER  
INTERIOR: WHITE MELAMINE  
DESIGN: SHAKER MDF  
STAIN: BM. **DEC WHITE**

ISLAND  
DESIGN: SHAKER MDF  
STAIN: BM. 2124-10 WROUGHT IRON  
HDWE: 1254-1BPN-P  
CTOP: 3/4" SLAB BY OTHERS


CROWN: #11 LARGE W/WOOD DROP  
DRAWER TRACKS: QUADRO ON MELAMINE  
SOFT CLOSE DOORS  
CEILING HEIGHT: 108" TO DROP  
CABINET HEIGHT: 44 1/2" UPPERS-HANG @ 100 1/2" TO DROP W/CROWN

THIS IS AN ARTIST'S RENDITION. THE  
DRAWINGS ARE FOR PRESENTATION  
PURPOSES ONLY, MAY NOT BE EXACTLY AS  
SHOWN.

DRAWN DATE: MAY 26/25

DESIGNER: CLARA

SALES REP: TOM

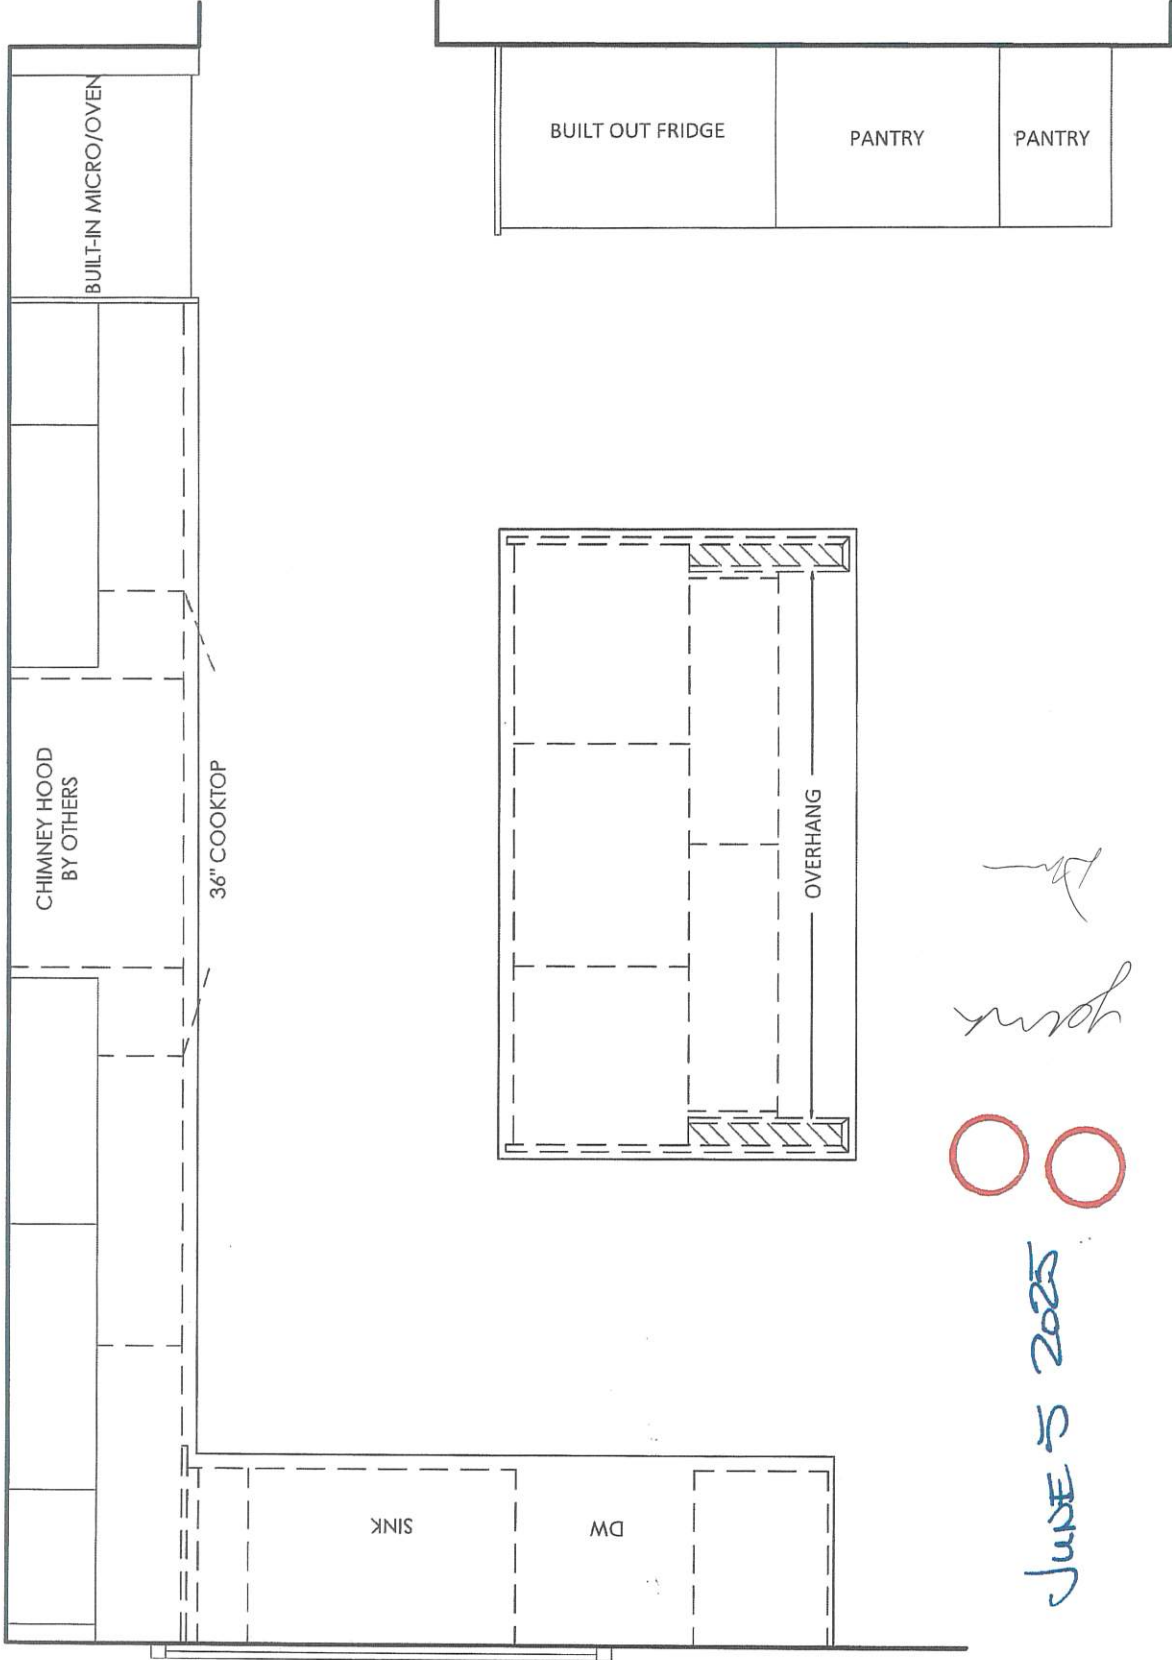

**EURO CHOICE  
KITCHENS INC.**

2 Watson Rd. S.  
Guelph, On. N1L 1E2  
Phone: 519-821-3670  
Fax: 519-821-3613

PAGE 2 OF 4

ORDER #

CUSTOMER: **GOLD PARK HOMES**  
MODEL: THE BROOKSIDE

SHIPPING DIRECTIONS:  
PV2-19  
212 SILVER CREEK DRIVE,  
VAUGHAN, ONTARIO

DATE ORDERED:

DATE REQUIRED:

JUNE 5 2025


Handwritten initials and date: "June 5 2025" and "John" with a signature.

THIS IS AN ARTIST'S RENDITION. THE  
DRAWINGS ARE FOR PRESENTATION  
PURPOSES ONLY, MAY NOT BE EXACTLY AS  
SHOWN.

DRAWN DATE: MAY 26/25

DESIGNER: CLARA

SALES REP: TOM

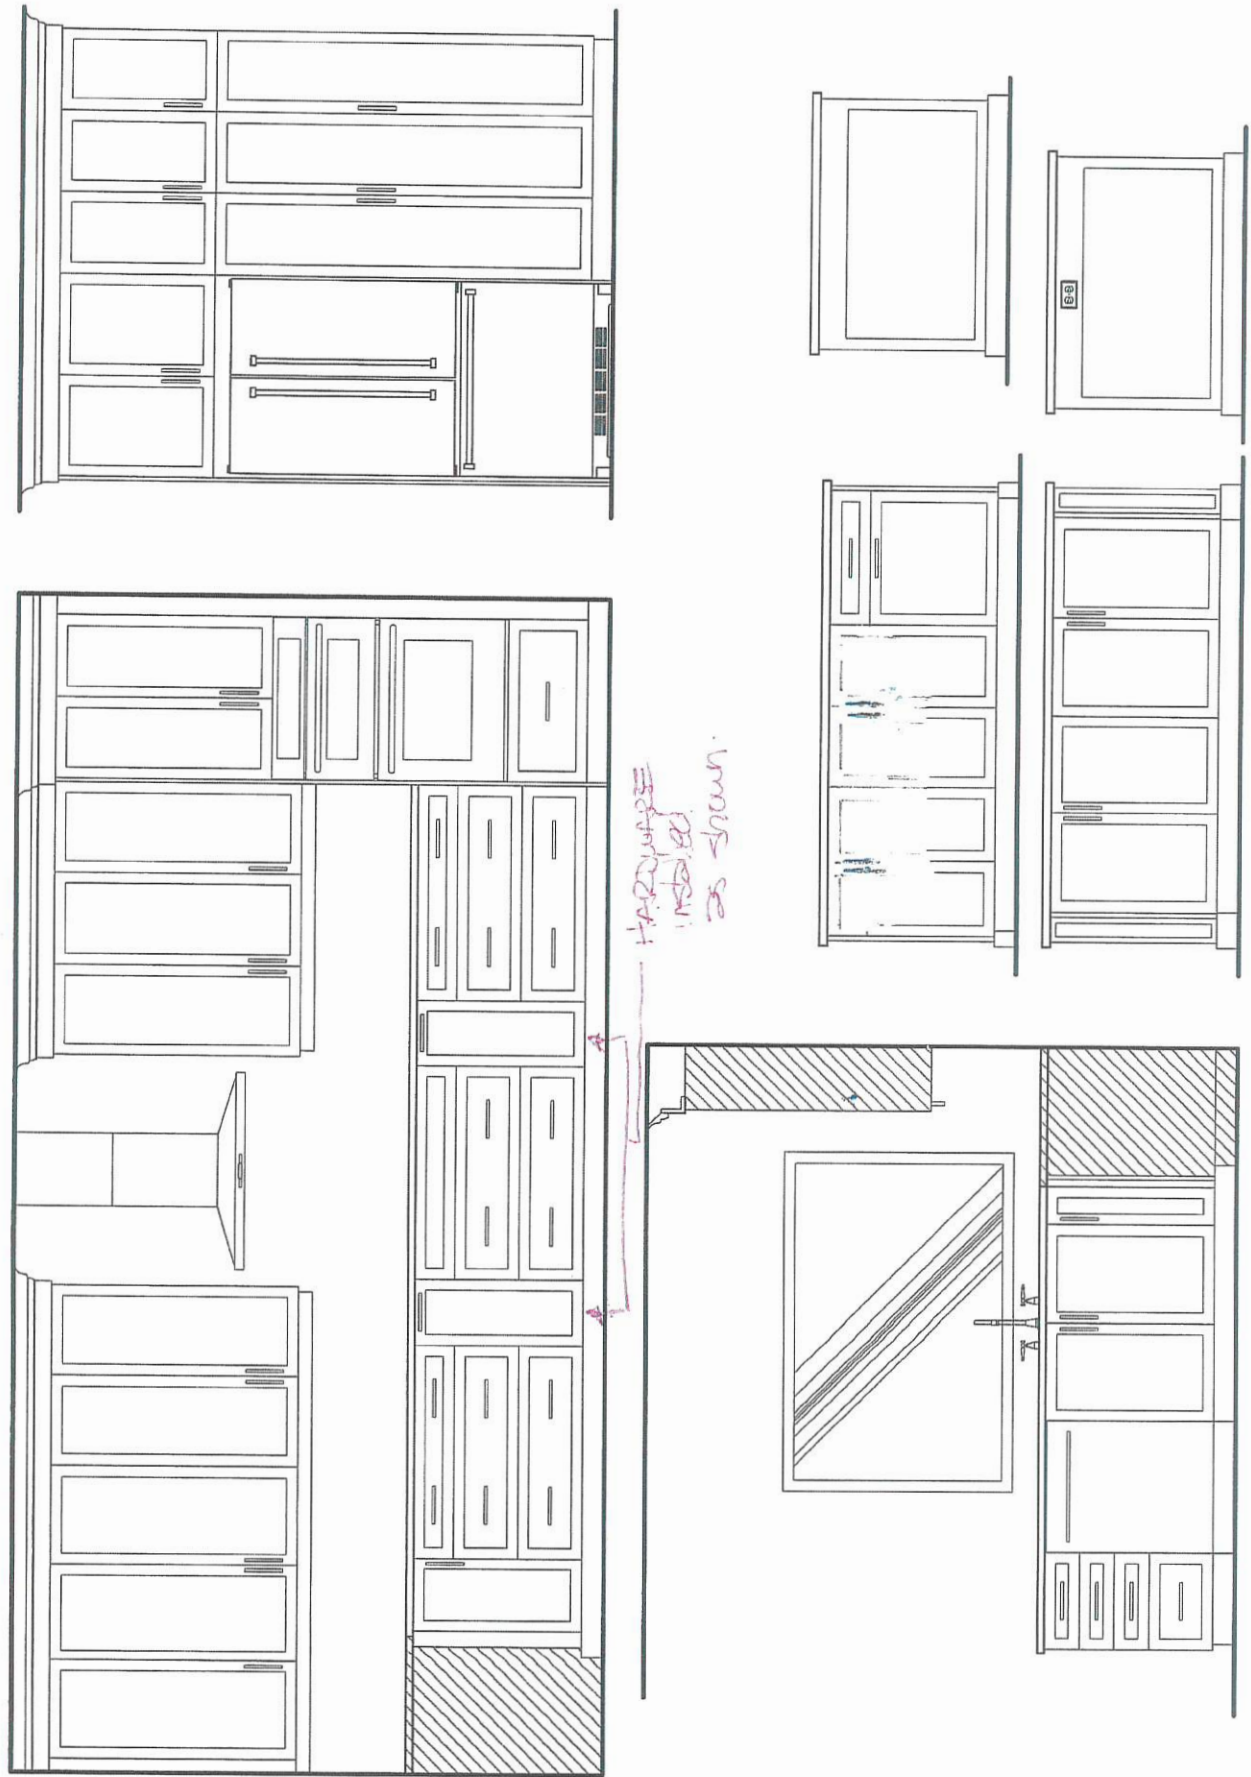

EURO CHOICE  
KITCHENS INC.

2 Watson Rd. S.  
Guelph, On. N1L 1E2  
Phone: 519-821-3670  
Fax: 519-821-3613

PAGE 3 OF 4

ORDER #

CUSTOMER:  
GOLD PARK HOMES  
MODEL: THE BROOKSIDE

SHIPPING DIRECTIONS:

PV2-19  
212 SILVER CREEK DRIVE,  
VAUGHAN, ONTARIO

DATE ORDERED:

DATE REQUIRED:

LAUNDRY/MUDROOM

INTERIOR: WHITE MELAMINE  
DESIGN: SLAB MELAMINE  
STAIN: RU-05 LARICE BIANCO  
HDWE: 1258.BSN  
CTOP: 9525-34 WHILE SHALESTONE SCOVATO  
EDGE: REGENCY BKSP: NO

CEILING HEIGHT: 119<sup>1</sup>/<sub>2</sub>"  
CABINET HEIGHT: 44<sup>1</sup>/<sub>2</sub>" UPPERS-HANG @100<sup>1</sup>/<sub>2</sub>"  
OPEN TO CEILING


THIS IS AN ARTIST'S RENDITION. THE  
DRAWINGS ARE FOR PRESENTATION  
PURPOSES ONLY, MAY NOT BE EXACTLY AS  
SHOWN.

DRAWN DATE: MAY 26/25


DESIGNER: CLARA

SALES REP: TOM

JUNE 5 2025

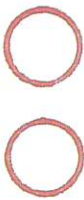

*Handwritten signature/initials.*

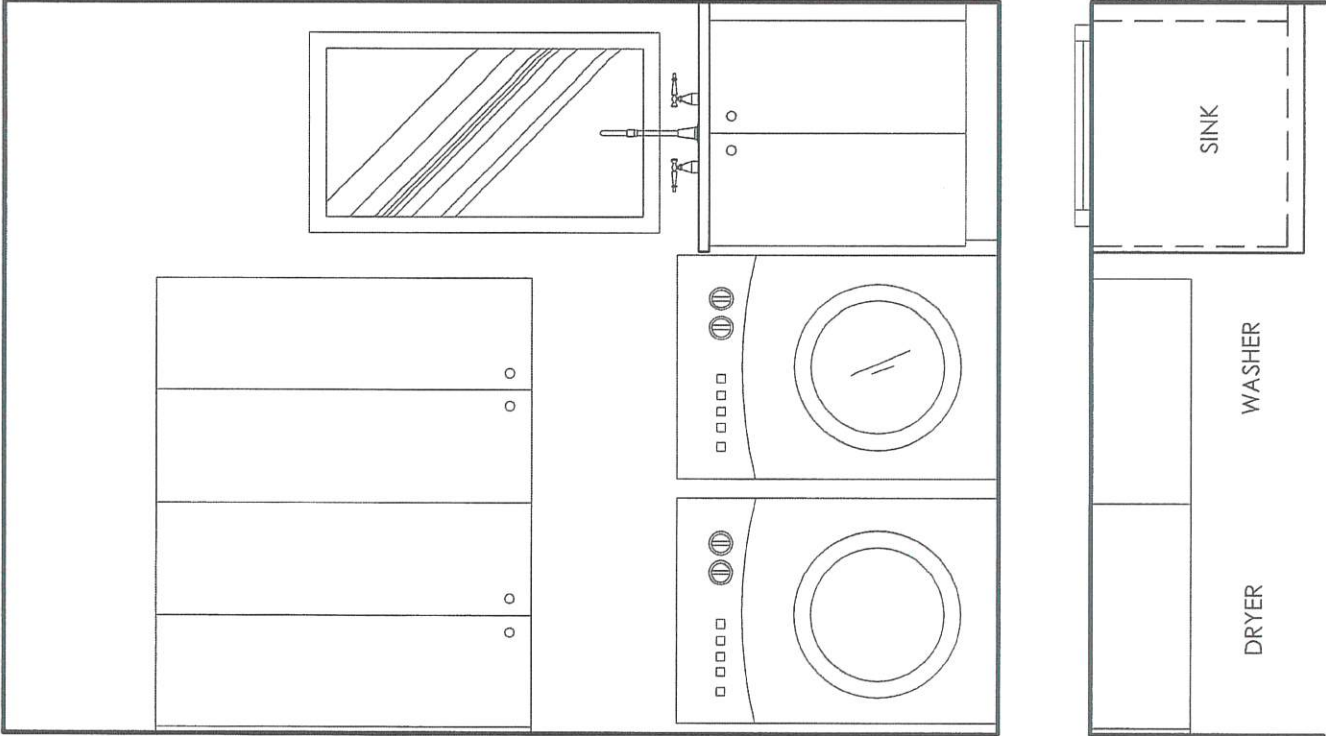

EURO CHOICE  
KITCHENS INC.

2 Watson Rd. S.  
Guelph, On. N1L 1E2  
Phone: 519-821-3670  
Fax: 519-821-3613

PAGE 4 OF 4

ORDER #

CUSTOMER:

GOLD PARK HOMES  
MODEL: THE BROOKSIDE

SHIPPING DIRECTIONS:

PV2-19  
212 SILVER CREEK DRIVE,  
VAUGHAN, ONTARIO

DATE ORDERED:

DATE REQUIRED:

JUNE 5 2025




THIS IS AN ARTIST'S RENDITION. THE  
DRAWINGS ARE FOR PRESENTATION  
PURPOSES ONLY, MAY NOT BE EXACTLY AS  
SHOWN.

DRAWN DATE: MAY 26/25



DESIGNER: CLARA

SALES REP: TOM

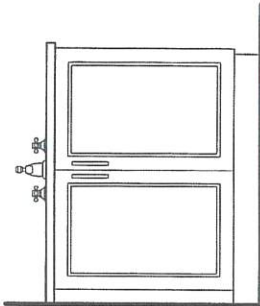



POWDER ROOM

INTERIOR: WHITE MELAMINE  
DESIGN: BMDF **SHAKER**  
STAIN: BM. 2124-10 WROUGHT IRON  
HDWE: 1796.BSN  
CTOP: 3/4" SLAB BY OTHERS  
CABINET HEIGHT: 32" HIGH

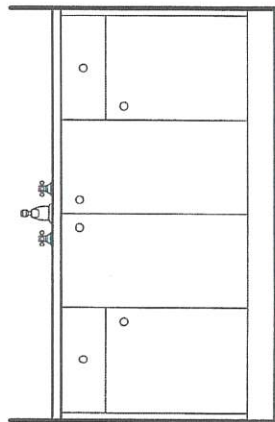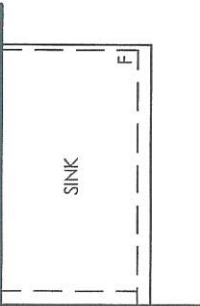



ENSUITE 2

INTERIOR: WHITE MELAMINE  
DESIGN: SLAB MELAMINE  
STAIN: 75V ROBLE AZABACHE  
HDWE: 9375-1BPN-P  
CTOP: 3/4" SLAB BY OTHERS  
DRAWER TRACKS: STANDARD  
CABINET HEIGHT: 32" HIGH

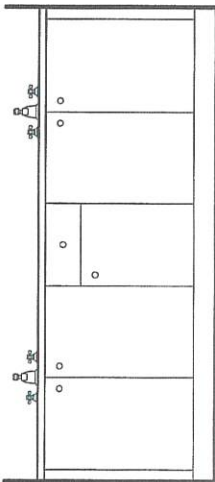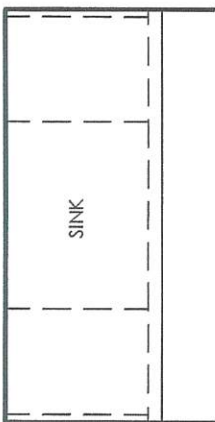


ENSUITE 3/4

INTERIOR: WHITE MELAMINE  
DESIGN: SLAB MELAMINE  
STAIN: 97Q ESPIGA PIMENTA  
HDWE: 9431-1055-P  
CTOP: 3/4" SLAB BY OTHERS  
DRAWER TRACKS: STANDARD  
CABINET HEIGHT: 32" HIGH

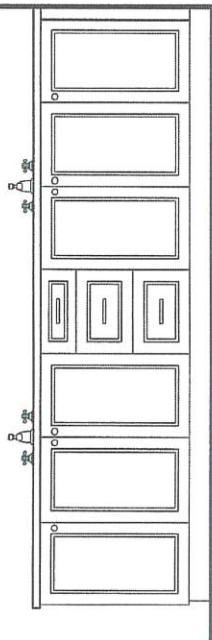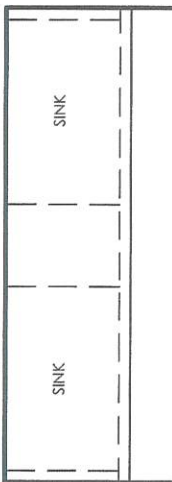

PRIMARY ENSUITE

INTERIOR: WHITE MELAMINE  
DESIGN: MAPLE **SHAKER**  
STAIN: BLACK WALNUT  
HDWE: 9375-1BPN-P  
DRAWERS: 1696.BSN  
CTOP: 3/4" SLAB BY OTHERS  
DRAWER TRACKS: STANDARD  
CABINET HEIGHT: 32" HIGH

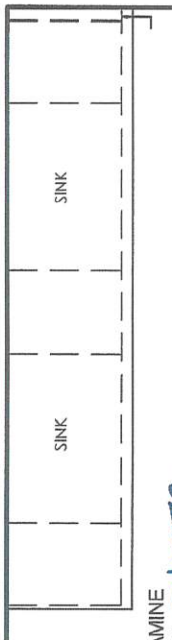

SCHEDULE 'F'



FV2-19  
SEPT 23 2022

March 01, 2023


JUNE 5 2025

*Am York*

# The Brookside

## DEER RUN COLLECTION

- Elevation A - 3,370 sq.ft.  
3,362 sq.ft. Opt. Ground Floor Side Entry  
Plus 93 sq.ft. Fin. Basement Foyer
- Elevation B - 3,338 sq.ft.  
3,330 sq.ft. Opt. Ground Floor Side Entry  
Plus 93 sq.ft. Fin. Basement Foyer
- Elevation C - 3,312 sq.ft.  
3,303 sq.ft. Opt. Ground Floor Side Entry  
Plus 93 sq.ft. Fin. Basement Foyer

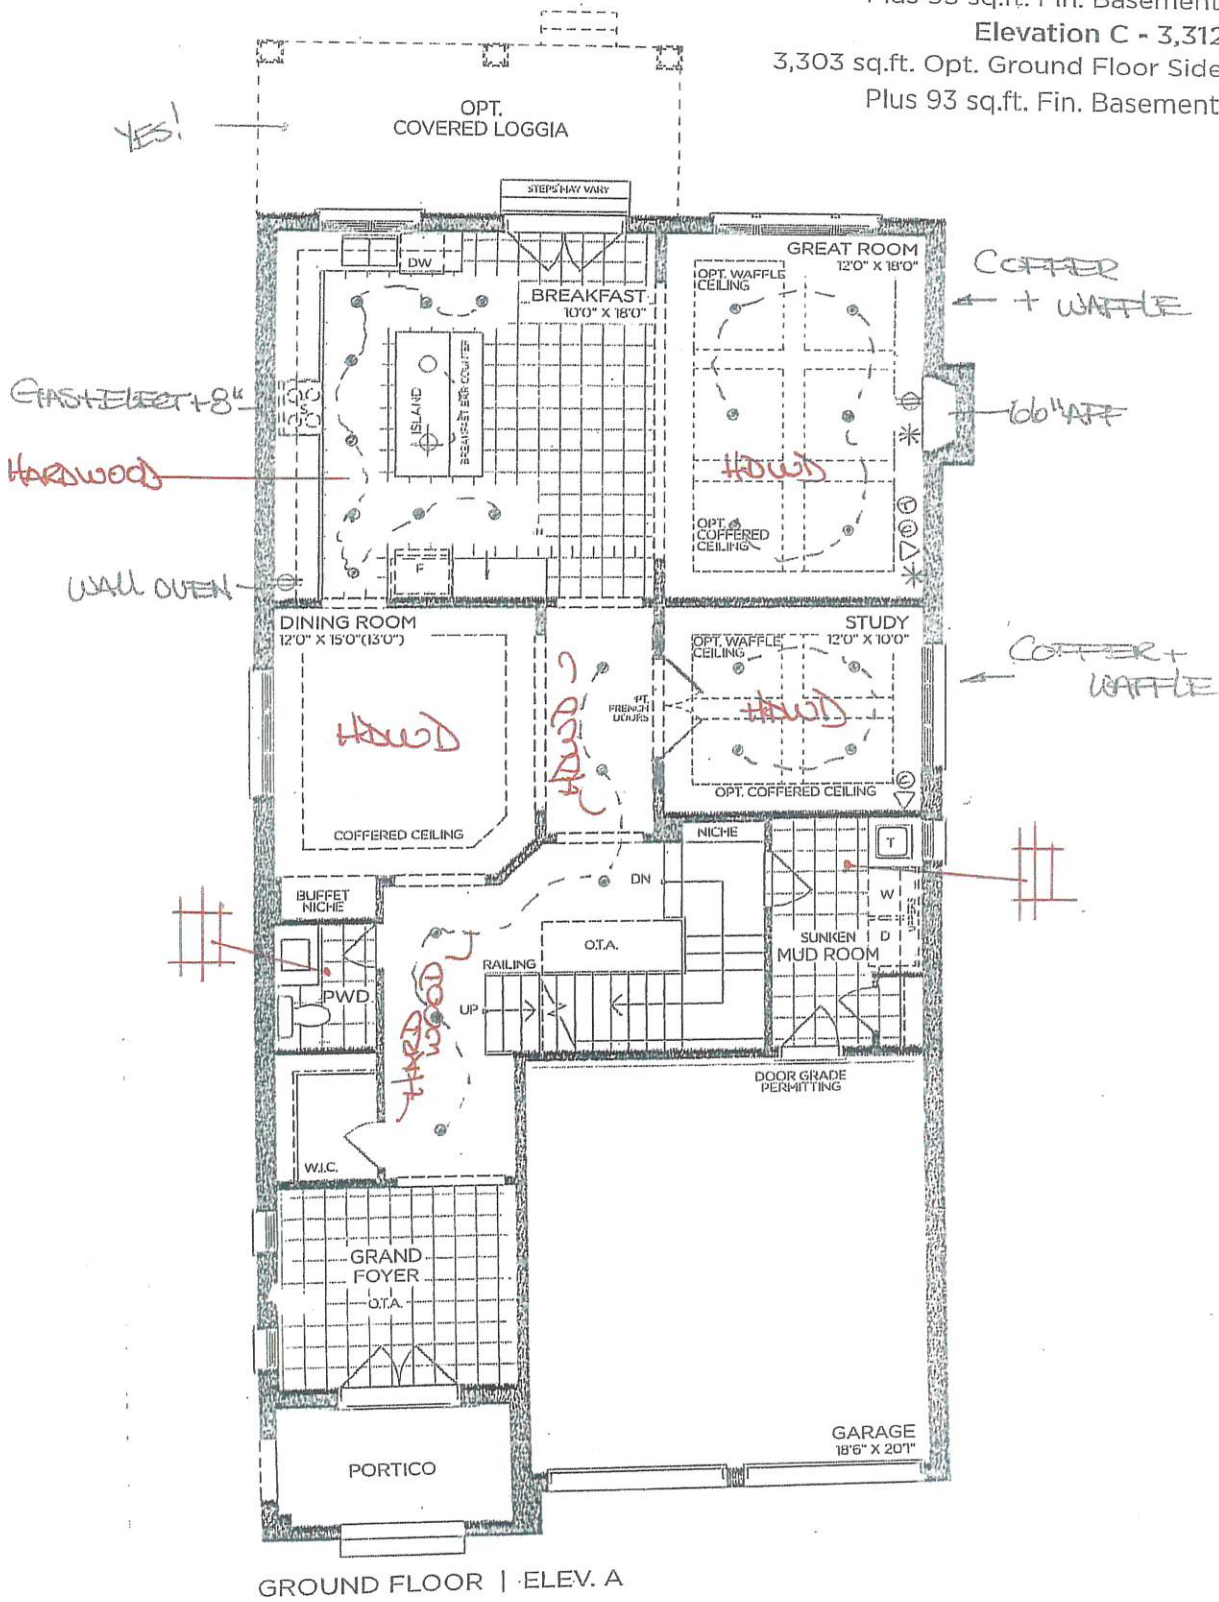

VENDOR

PURCHASER

PURCHASER

**GOLD PARK**  
WORTH MORE™

Prices, figures, illustrations, sizes, features and finishes are subject to change without notice. Areas and dimensions are approximate and actual usable floor space may vary from the stated area. Layout may be reverse of the unit purchased. E. & O.E. 4003

# SCHEDULE 'F'




7/2-19  
 SEPT 23 2022  
 March 01, 2023

JUNE 5 2025  
*DM*  
*you*

## The Brookside DEER RUN COLLECTION

→ Elevation A - 3,370 sq.ft.  
 3,362 sq.ft. Opt. Ground Floor Side Entry  
 Plus 93 sq.ft. Fin. Basement Foyer  
 Elevation B - 3,338 sq.ft.  
 3,330 sq.ft. Opt. Ground Floor Side Entry  
 Plus 93 sq.ft. Fin. Basement Foyer  
 Elevation C - 3,312 sq.ft.  
 3,303 sq.ft. Opt. Ground Floor Side Entry  
 Plus 93 sq.ft. Fin. Basement Foyer

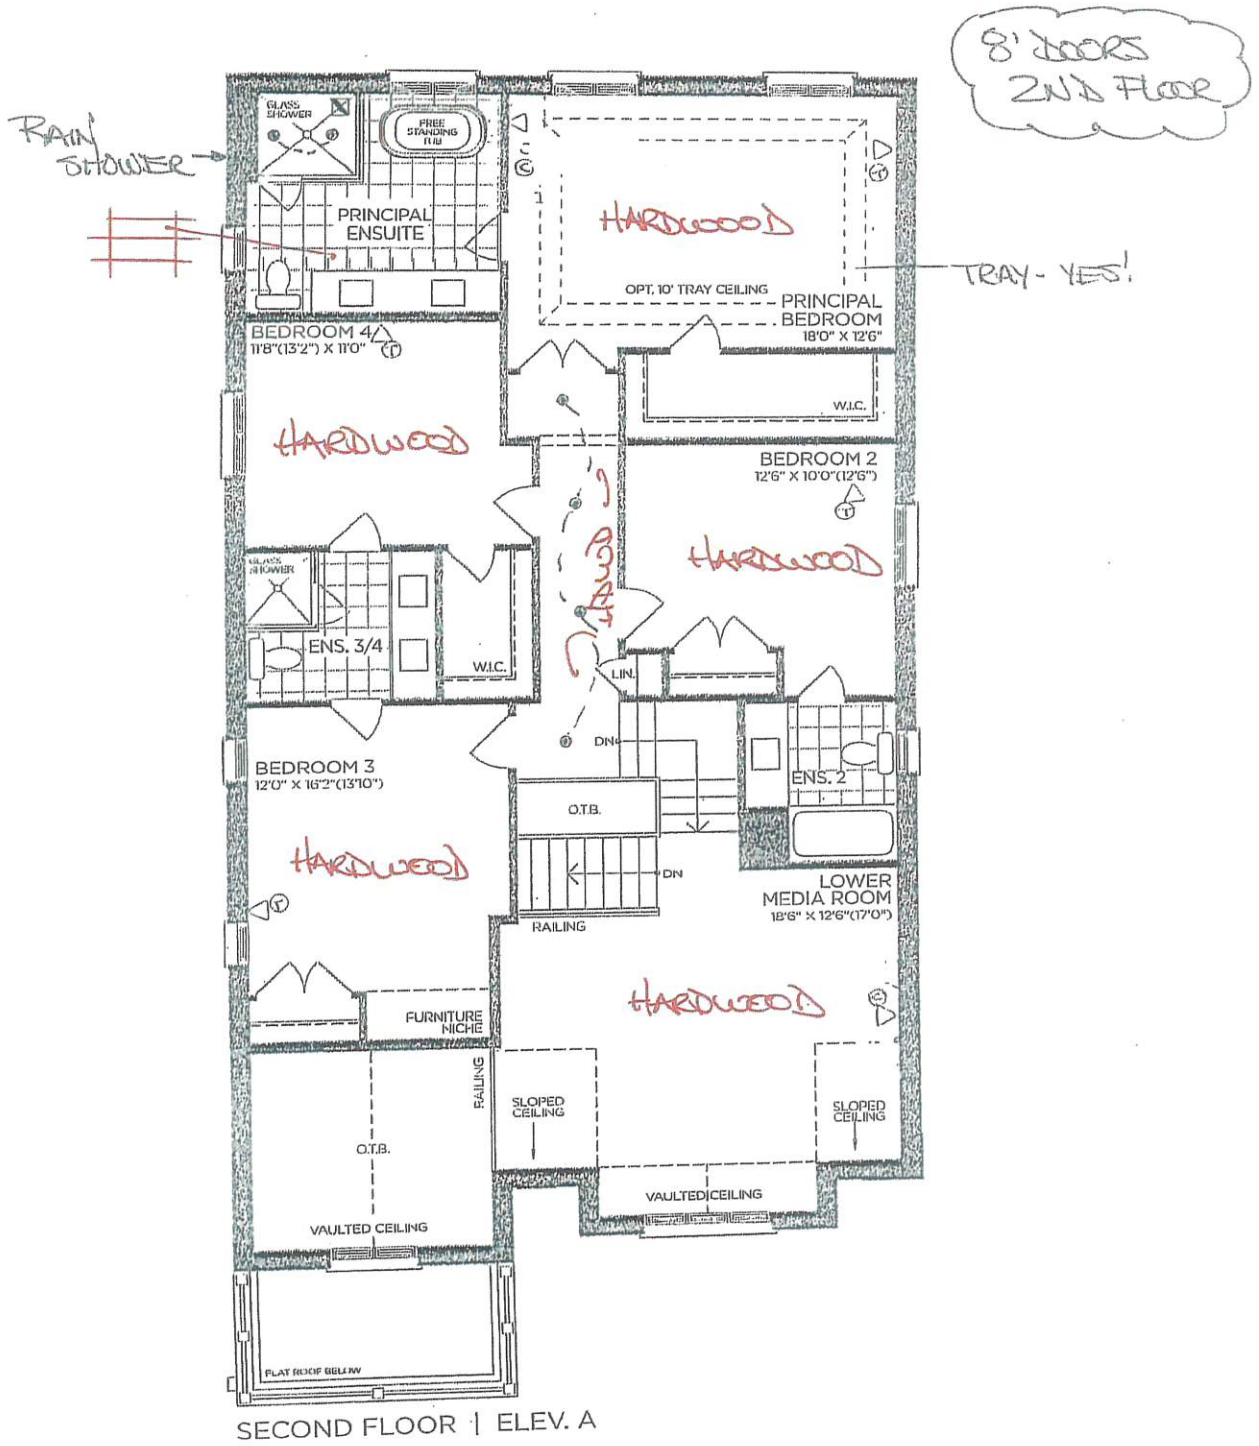

SECOND FLOOR | ELEV. A

VENDOR

PURCHASER

PURCHASER

**GOLD PARK**  
 WORTH MORE™

Prices, figures, illustrations, sizes, features and finishes are subject to change without notice. Areas and dimensions are approximate and actual usable floor space may vary from the stated area. Layout may be reverse of the unit purchased. E. & O.E. 4003

SCHEDULE 'F'



PV2-19  
SEPT 23 2022  
March 01, 2023


JUNE 5 2025

*John  
york*

# The Brookside

## DEER RUN COLLECTION

- Elevation A - 3,370 sq.ft.  
3,362 sq.ft. Opt. Ground Floor Side Entry  
Plus 93 sq.ft. Fin. Basement Foyer
- Elevation B - 3,338 sq.ft.  
3,330 sq.ft. Opt. Ground Floor Side Entry  
Plus 93 sq.ft. Fin. Basement Foyer
- Elevation C - 3,312 sq.ft.  
3,303 sq.ft. Opt. Ground Floor Side Entry  
Plus 93 sq.ft. Fin. Basement Foyer

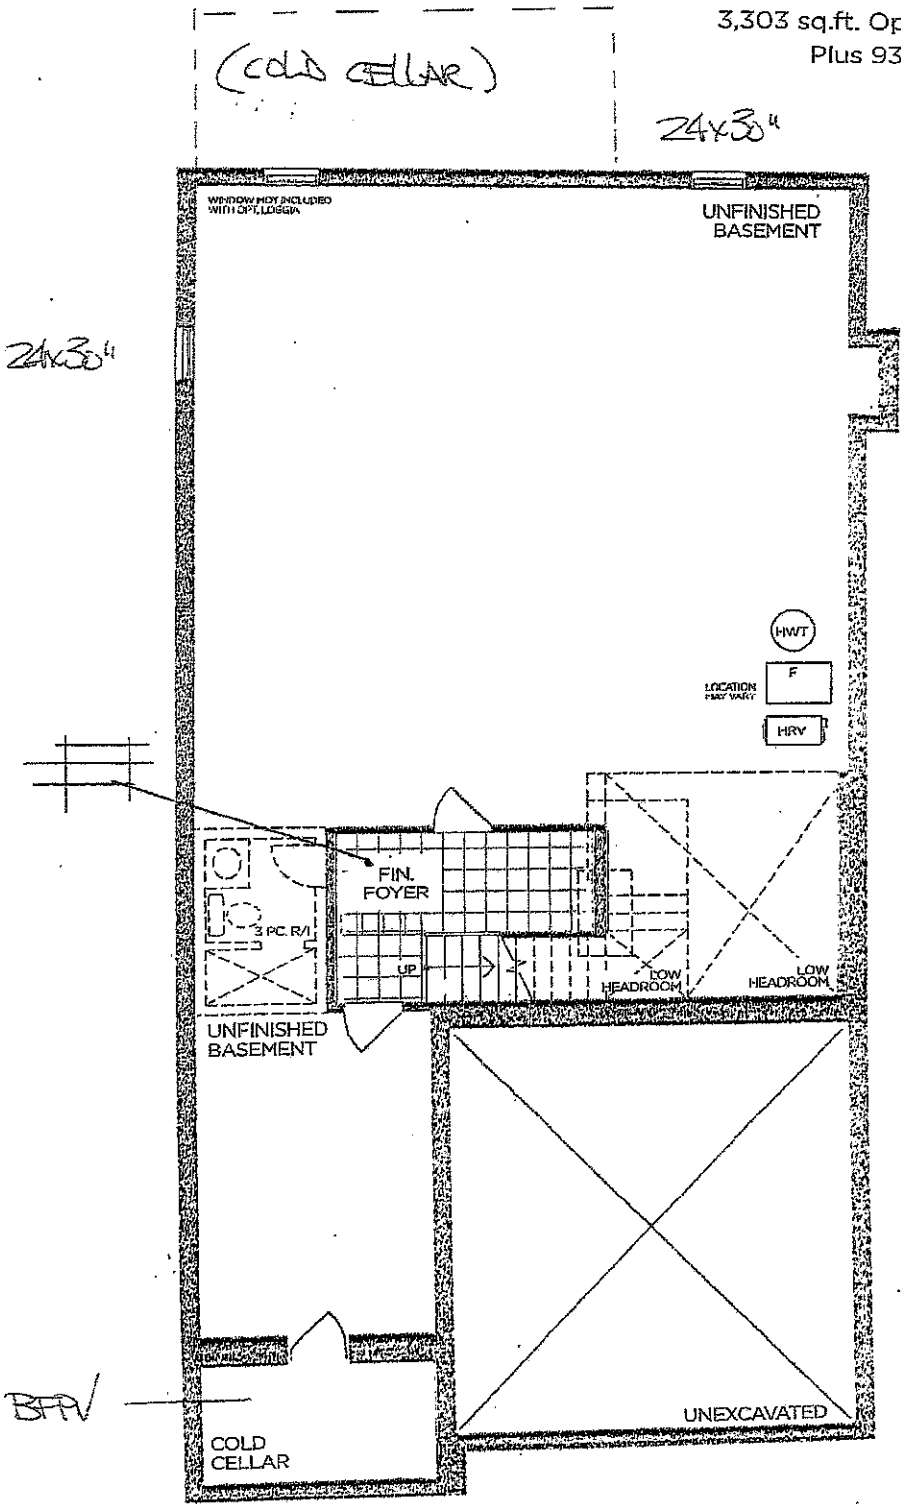

BASEMENT | ELEV. A

VENDOR

PURCHASER

PURCHASER

**GOLDPARK**  
WORTH MORE™

Prices, figures, illustrations, sizes, features and finishes are subject to change without notice. Areas and dimensions are approximate and actual usable floor space may vary from the stated area. Layout may be reverse of the unit purchased. E. & O.E. 4003

## COUNTER EDGE PROFILES

### THICKNESS

STANDARD - 2CM ☒

UPGRADE - 3CM ☐

### EDGE PROFILE - STANDARDS




STANDARD EASED ☒

*THRU OUT EXCEPT KITCHEN*

### EDGE PROFILE - UPGRADES



MICRO BEVEL ☐

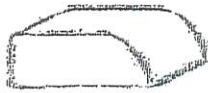

BULLNOSE EDGE ☐



MITER EDGE ☒  
(2CM ONLY)

*KITCHEN*




KNIFE EDGE ☐



SINGLE BEVEL ☐



OGEE EDGE ☐

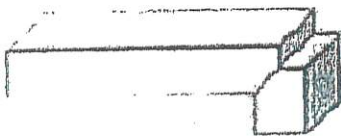

QUIRK MITER EDGE ☐

Date: *JUNE 5 2025*

Lot: *19*

Signature: *[Signature]*

Signature: *[Signature]*

PLUMBING UPGRADES

---

BLANCO



|                                                                                                                                                                                    |                                                                                                                                                                                     |
|------------------------------------------------------------------------------------------------------------------------------------------------------------------------------------|-------------------------------------------------------------------------------------------------------------------------------------------------------------------------------------|
| Date: JUNE 5 2025                                                                                                                                                                  | Lot: 19                                                                                                                                                                             |
| Location: KITCHEN                                                                                                                                                                  |                                                                                                                                                                                     |
| Signature:   | Signature:   |

BLANCO QUATRUS R15  
u/mount ss sink  
Model 401518

GOLDPARK  
WORTH MORE™



PINE VALLEY  
FOREVER GREEN

## CABINETRY HARDWARE UPGRADES

### Subtle Surge



Brushed Nickel



Modern Brushed Gold



|                          |                |
|--------------------------|----------------|
| Date: <u>JUNE 5 2025</u> | Lot: <u>19</u> |
|--------------------------|----------------|

|                          |
|--------------------------|
| Location: <u>KITCHEN</u> |
|--------------------------|

|                               |                               |
|-------------------------------|-------------------------------|
| Signature: <u>[Signature]</u> | Signature: <u>[Signature]</u> |
|-------------------------------|-------------------------------|

Pull 160mm CC

GOLD PARK  
WORTH MORE™



PINE VALLEY  
FOREVERGREEN

## STANDARD CABINETRY HARDWARE



Brushed Nickel



Satin Nickel



shaded

Matte Black



MUD  
Room

Brushed Nickel



Brushed Nickel



ENS 2

P.ENS-(DOORS)

Brushed Nickel



Matte Black



Brushed Nickel



Brushed Nickel



Matte Black



Brushed Nickel



Brushed Nickel



P.ENSUITE  
(DRAWERS)

Brushed Nickel



Polished Chrome

\*NONE\* ☐

NO HOLES

Date: JUNE 5 2025

Lot: 19

Location: SEE ABOVE


Signature:  

Signature:  

GOLDPARK  
WORTH MORE™


STANDARD INTERIOR DOOR

CARRARA DOOR

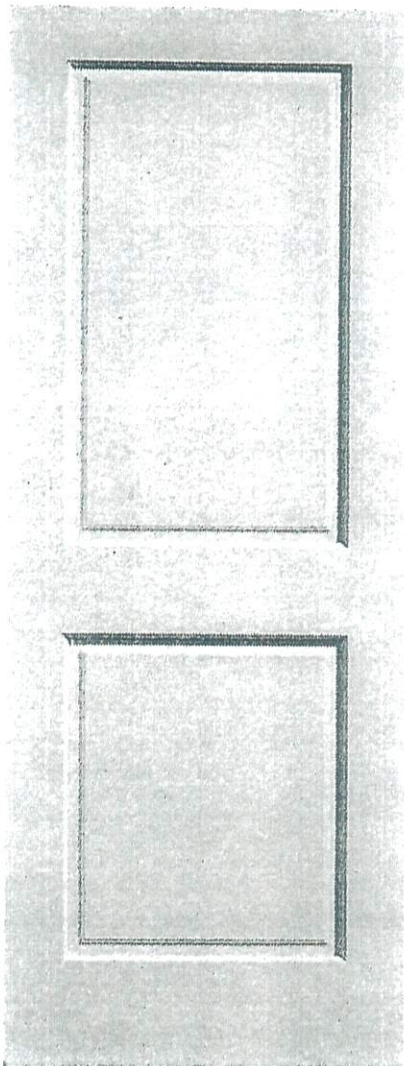

LOCATION:

Then at  
STANDARD LOCATIONS
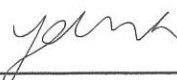
|                                                                                                                                                                                    |                      |
|------------------------------------------------------------------------------------------------------------------------------------------------------------------------------------|----------------------|
| LOT #<br>19                                                                                                                                                                        | DATE:<br>JUNE 5 2025 |
| SIGNATURE:   |                      |
| SIGNATURE:   |                      |




PINE VALLEY  
FOREVERGREEN

## UPGRADE SHOWER HARDWARE

### MT6X6

Shower Door Handle

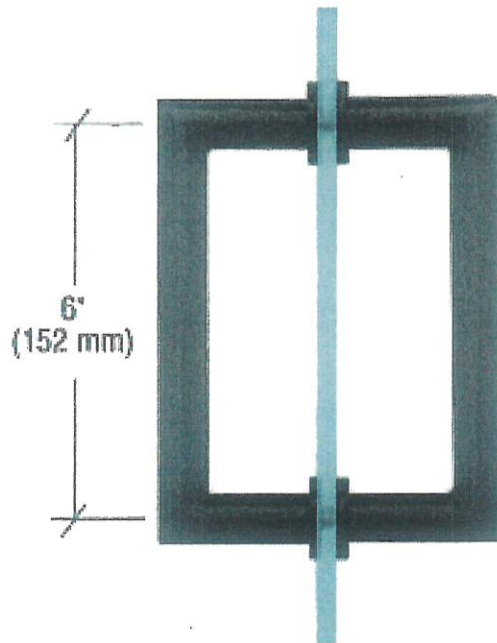

6 x 6" Back-to-Back  
3/4" Diameter Tube  
Cut and Mitred Corners with Washers

Satin Brass

Brushed Nickel

Chrome

Matte Black

☐☒☐☐

+ HINGES

|                           |                        |
|---------------------------|------------------------|
| Date: JUNE 5 2025         | Lot: 19                |
| Location: PRINCIPAL SUITE |                        |
| Signature: [Signature]    | Signature: [Signature] |

GOLDPARK  
WORTH MORE™

Model MT6X6




PINE VALLEY  
FOREVERGREEN

## UPGRADE SHOWER HARDWARE

### MT6X6

Shower Door Handle

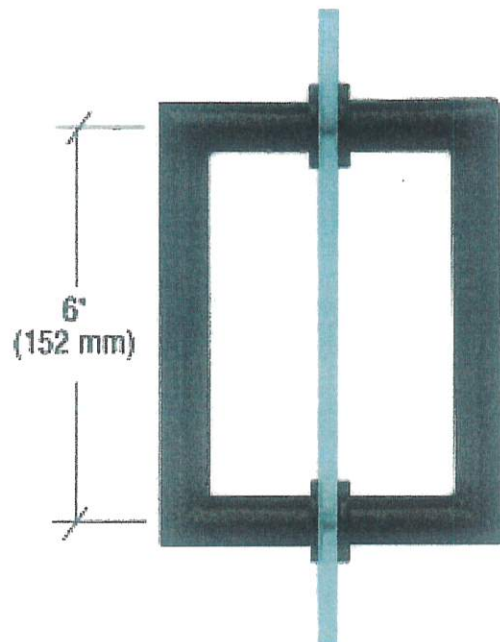

6 x 6" Back-to-Back  
3/4" Diameter Tube  
Cut and Mitred Corners with Washers

Satin Brass

Brushed Nickel

Chrome

Matte Black

☐☐☒☐

|                                 |                               |
|---------------------------------|-------------------------------|
| Date: <u>JUNE 5 2025</u>        | Lot: <u>19</u>                |
| Location: <u>SHARED ENROUTE</u> |                               |
| Signature: <u>[Signature]</u>   | Signature: <u>[Signature]</u> |

GOLDPARK  
WORTH MORE™

Model MT6X6



Project: Pine Valley Phase 2


Lot: PV 19

Purchaser(s): DAVID MA & JENNY KANG

#### Standard Hood Fan Deletion

We acknowledge that the builder's standard hood fan will not be installed. Do not supply, install and/or credit. We will install our own hood fan after closing.

Signature:  

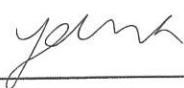Signature:  

Date: JUNE 5 2025