

Lot: 7-1

Model: 31-03 B END2 Ashton Manor Project/Phase: The Manors at Pine Valley / 4

CERAMIC

Invoice	Qty.	Description
3246	1	FOYER & POWDER ROOM: UPGRADE TILE TO CHECKERBOARD PATTERN 13X13" TORINO 'VANIZIO' AND 'GRIGIO'
01Aug25 NoCat		ON 45* ANGLE, LIKE MODEL HOME INCLUDES BONE GROUT
3246	1	BASEMENT BATH: STANDARD FLOOR TILE - 13X13" COSTA 'WHITE'
01Aug25 NoCat		LAID IN STRAIGHT, STACKED PATTERN.
3246	1	BASEMENT BATH: STANDARD SHOWER WALL TILE - 8X10" UNIWALL 'WHITE' GLOSSY
01Aug25 NoCat		
3246	1	BASEMENT BATH: STANDARD SHOWER FLOOR TILE - 2X2" ONTARIO SNOW WHITE MATTE
01Aug25 NoCat		
3246	1	LAUNDRY ROOM: UPGRADE 1 FLOOR TILE - 12X24" MADISON 'LIGHT GREY' MATTE
01Aug25 NoCat		LAID IN STRAIGHT, STACKED PATTERN. SEE PLAN FOR TILE DIRECTION
3246	1	PRINCIPAL ENSUITE: UPGRADE FLOOR TILE - 12X24" MADISON 'LIGHT GREY' MATTE
01Aug25 NoCat		LAID IN STRAIGHT, STACKED PATTERN. SEE PLAN FOR TILE DIRECTION
3246	1	PRINCIPAL ENSUITE: STANDARD SHOWER WALL TILE - 8X10" UNIWALL WHITE POLISHED
01Aug25 NoCat		
3246	1	PRINCIPAL ENSUITE: STANDARD SHOWER FLOOR TILE - 2X2" ONTARIO 'SNOW WHITE' MATTE
01Aug25 NoCat		
3246	1	SHARED ENSUITE: STANDARD FLOOR TILE - 13X13" COSTA 'WHITE'
01Aug25 NoCat		LAID IN STRAIGHT STACKED PATTERN.
3246	1	SHARED ENSUITE: STANDARD SHOWER WALL TILE - 8X10" UNIWALL 'WHITE'
01Aug25 NoCat		
3246	1	SHARED ENSUITE: STANDARD SHOWER FLOOR TILE - 2X2" ONTARIO 'SNOW WHITE' MATTE
01Aug25 NoCat		
3246	1	ENSUITE 4: STANDARD FLOOR TILE - 13X13" COSTA 'WHITE' MATTE
01Aug25 NoCat		LAID IN STRAIGHT, STACKED PATTERN.
3246	1	ENSUITE 4: STANDARD TUB ENCLOSURE WALL TILE - 8X10" UNIWALL 'WHITE' GLOSSY
01Aug25 NoCat		

DisciplineMS.rpt 23feb21

Page 1 of 7



Lot: 7-1

Model: 31-03 B END2 Ashton Manor Project/Phase: The Manors at Pine Valley / 4

DRYWALL

DIXI WA	DK1 WALL		
Invoice	Qty.	Description	
3029	1	GREAT ROOM: ADD 9-BOX WAFFLE CEILING CTR-B07.	
05Oct23 NoCat			

DisciplineMS.rpt 23feb21 Page 2 of 7



Lot: 7-1

Model: 31-03 B END2 Ashton Manor Project/Phase: The Manors at Pine Valley / 4

ELECTRICAL

ELECTRICAL Invoice Qty. Description			
3029 164,749 05Oct23	8	BASEMENT: S/I 4" E/S LED INTERIOR POT LIGHT - EACH. WHITE IN LIEU OF STANDARD CEILING LIGHTS, USE STANDARD SWITCHES. SEE PLAN FOR LOCATION.	
3029 164,749	2	BASEMENT HALLWAY: S/I 4" E/S LED INTERIOR POT LIGHT - EACH. WHITE	
05Oct23		IN LIEU OF STANDARD CEILING LIGHTS, USE STANDARD SWITCHES. SEE PLAN FOR LOCATION.	
3029 164,749	6	KITCHEN: S/I 4" E/S LED INTERIOR POT LIGHT - EACH. WHITE	
05Oct23		IN ADDITION TO STANDARD CEILING LIGHT. SEE PLAN FOR LOCATION.	
3029 164,752	1	KITCHEN: S/I ADDITIONAL INTERIOR SWITCH. SINGLE POLE	
05Oct23		FOR POTLIGHTS	
3029 164,741	1	KITCHEN: RELOCATE STANDARD CEILING MOUNT FIXTURE	
05Oct23		LOCATE APPROX CENTERED ABOVE ISLAND, SEE PLAN FOR LOCATION.	
3029 164,753	1	KITCHEN: S/I ADDITIONAL REINFORCED CEILING OUTLET. SUPPORTS UP TO APPROX. 40 LBS.	
05Oct23		LOCATE APPROX CENTERED ABOVE ISLAND, AS SAME SWITCH AS STANDARD LIGHT.	
3029 164,747	1	KITCHEN: S/I 240V (50 AMP) RECEPTACLE ON A SEPARATE CIRCUIT	
05Oct23		FOR WALL OVEN	
3029 164,743	1	KITCHEN: S/I 110V WALL RECEPTACLE ON SEPARATE CIRCUIT	
05Oct23		FOR GAS APPLIANCE.	
3029 164,749	8	GREAT ROOM: S/I 4" E/S LED INTERIOR POT LIGHT - EACH. WHITE	
05Oct23		INCLUDED IN APS. SEE PLAN FOR LOCATION. INCLUDES 1 SWITCH.	
3029 164,749	1	GREAT ROOM: S/I 4" E/S LED INTERIOR POT LIGHT - EACH. WHITE	
05Oct23		INCLUDE ON SAME SWITCH AS OTHER POTLIGHTS. SEE PLAN FOR LOCATION.	
3029 164,752 05Oct23	1	GREAT ROOM: S/I ADDITIONAL INTERIOR SWITCH. SINGLE POLE	
3029	1	GREAT ROOM: S/I 110V WALL RECEPTACLE (NOT ON SEPARATE CIRCUIT)	
164,742 05Oct23		LOCATE APPROX 66" ABOVE FIREPLACE	
3029	5	MAIN HALL: S/I 4" E/S LED INTERIOR POT LIGHT - EACH. WHITE	
164,749 05Oct23		IN LIEU OF STANDARD CEILING LIGHTS, USE STANDARD SWITCHES. SEE PLAN FOR LOCATION.	

DisciplineMS.rpt 23feb21 Page 3 of 7



Lot: 7-1

Model: 31-03 B END2 Ashton Manor **Project/Phase: The Manors at Pine Valley / 4**

ELECTRICAL

Invoice	Qty.	Description
3029 164,757 05Oct23	1	FOYER: S/I HINGED SWITCH - EACH INCLUDES 1 LED POTLIGHT
3029 164,749 05Oct23	5	UPPER HALL: S/I 4" E/S LED INTERIOR POT LIGHT - EACH. WHITE IN LIEU OF STANDARD CEILING LIGHTS, USE STANDARD SWITCHES. SEE PLAN FOR LOCATION.
3029 164,749 05Oct23	4	PRINCIPAL BEDROOM: S/I 4" E/S LED INTERIOR POT LIGHT - EACH. WHITE IN ADDITION TO STANDARD CEILING LIGHT. SEE PLAN FOR LOCATION.
3029 164,752 05Oct23	1	PRINCIPAL ENSUITE: S/I ADDITIONAL INTERIOR SWITCH. SINGLE POLE FOR POTLIGHTS.
3029 164,761 05Oct23	1	PRINCIPAL ENSUITE: S/I SHOWER POT LIGHT: 4 INCH RECESSED SHOWER POT LIGHT COMPLETE WITH SWITCH IN ADDITION TO STANDARD, ON SAME SWITCH.
3029 164,747 05Oct23	1	GARAGE: S/I 240V (50 AMP) RECEPTACLE ON A SEPARATE CIRCUIT
3246 01Aug25 NoCat	1	KITCHEN: ADD LED VALANCE LIGHT

FORMING

Invoice	Qty.	Description
3101	1	BASEMENT: S/I BACK-FLOW PREVENTER VALVE (BASEMENT)
24Oct23		
NoCat		

FRAMING		
Invoice	Qty.	Description
3029 164,770 05Oct23	1	KITCHEN: DELETE KITCHEN BULKHEAD, IF POSSIBLE, SITE APPROVAL REQUIRED AND IF MECHANICAL LAYOUTS ALLOW. GAP ABOVE UPPER KITCHEN CABINETS WILL BE PRESENT UNLESS ADDITIONAL CABINETRY IS PURCHASED. KITCHEN:
3029 164,775 05Oct23	1	KITCHEN: S/I TALLER UPPER, FURRING PANEL WITH CROWN MOULDING TO CEILING. OPTION ONLY AVAILBLE WITH DELETED BULKHEAD.
3029 164,774 05Oct23	1	PRINCIPAL ENSUITE: S/I RECESSED SHOWER NICHE [SHAMPOO SHELF] - COMPLETE WITH MATCHING STONE ON 4 SIDES, STANDARD TILE, APPROX. 12 X 42 INSTALLED VERTICALLY WITH STONE SHELF DIVIDERS - MUST SPECIFY LOCATION. BASED ON STANDARD FINISHES.

DisciplineMS.rpt 23feb21 Page 4 of 7



Lot: 7-1

Model: 31-03 B END2 Ashton Manor Project/Phase: The Manors at Pine Valley / 4

GLASS AND MIRROR

Invoice	Qty.	Description
3246	1	BASEMENT BATH: UPGRADE SHOWER DOOR HARDWARE
01Aug25 NoCat		
3246	1	PRINCIPAL ENSUITE: UPGRADE SHOWER DOOR HANDLE AND HINGES
01Aug25 NoCat		
3246	1	SHARED ENSUITE: UPGRADE SHOWER DOOR HANDLE
01Aug25 NoCat		

GRANITE MARBLE QUARTZ

GKANI I Invoice		MARBLE QUARTZ Description
3246	1	POWDER ROOM: STANDARD QUARTZ 'ICE SNOW'
01Aug25 NoCat		
3246	1	KITCHEN: UPGRADE COUNTER TOP TO PORCELAIN 'CALACATTA LUXE' POLISHED, COMPLETE WITH 2" EDGE DETAIL
01Aug25 NoCat		
3246	1	KITCHEN: WATERFALL LEGS AT ISLAND - PORCELAIN 'CALACATTA LUXE' POLISHED
01Aug25 NoCat		
3246	1	KITCHEN: ADD FULL HEIGHT SLAB BACKSPLASH - CALACATTA LUXE POLISHED
01Aug25 NoCat		
3246	1	BASEMENT BATH: STANDARD QUARTZ COUNTER TOP 'ICE SNOW'
01Aug25 NoCat		
3246	1	PRINCIPAL ENSUITE: STANDARD QUARTZ COUNTER TOP 'ICE SNOW'
01Aug25 NoCat		
3246	1	SHARED ENSUITE: STANDARD QUARTZ COUNTER TOP 'ICE SNOW'
01Aug25 NoCat		
3246	1	ENSUITE 4: STANDARD QUARTZ COUNTER TOP - ICE SNOW
01Aug25 NoCat		

DisciplineMS.rpt 23feb21 Page 5 of 7



Lot: 7-1

Model: 31-03 B END2 Ashton Manor Project/Phase: The Manors at Pine Valley / 4

HARDWOOD

Invoice	Qty.	Description
3246	1	THRU OUT STANDARD AREAS: UPGRADE HARDWOOD FLOOR TO VINTAGE 3/4X5" WHITE OAK WIREBRUSHED 'ATLANTIS'
01Aug25 NoCat		
3246	1	KITCHEN: UPGRADE TO HARDWOOD FLOOR - VINTAGE 3/4X5" WHITE OAK WIREBRUSHED 'ATLANTIS'
01Aug25 NoCat		
3246	1	BASEMENT: UPGRADE TO LAMINATE FLOOR - HAVANA OAK NATURAL
01Aug25 NoCat		INCLUDED IN APS

HVAC

	1110		
Invo	ice	Qty.	Description
16	3029 54,780 5Oct23	1	KITCHEN: GAS LINE ROUGH-IN - MAIN FLOOR FOR APPLIANCE

INTERIOR DOORS AND TRIM

Invoice	Qty.	Description
3029 164,784 05Oct23		UPPER HALL: S/I 8FT HIGH DOOR THROUGHOUT SECOND FLOOR IN LIEU OF STANDARD HEIGHT DOOR. PRICE IS PER DOOR

INTERIOR TRIM AND DOORS

Invoice	Qty.	Description
3246	1	THRU OUT: STANDARD INTERIOR TRIM PACKAGE
01Aug25 NoCat		
3246	1	THRU OUT: STANDARD INTERIOR DOORS 'CARRARA'
01Aug25 NoCat		
3246	1	THRU OUT: STANDARD INTERIOR DOOR HANDLES AND HINGES
01Aug25 NoCat		

KITCHEN AND BATH CABINETRY

Invoice	Qty. Description				
3246	1	THRU OUT - SEE ATTACHED CABINETRY SCHEDULE			
01Aug25					
NoCat					

DisciplineMS.rpt 23feb21 Page 6 of 7



Lot: 7-1

Model: 31-03 B END2 Ashton Manor Project/Phase: The Manors at Pine Valley / 4

NETWORK AND WIRING

Invoice	Qty.	Description
3029 164,787	1	GREAT ROOM: S/I ADDITIONAL CAT6 ETHERNET OUTLET
05Oct23		SEE PLAN FOR LOCATION
3029 164,794 05Oct23	1	EXTERIOR: S/I SECURITY PACKAGE - ROUGH - IN WIRING FOR: 1 RING DOOR BELL + 2 CAMERAS - 1 AT FRONT AND 1 AT REAR. COMPONENTS NOT INCLUDED. (CAT6)
05Oct23		

PAINT

Invoice	Qty.	Description
3246	1	MAIN STAIRS - 2ND FLOOR TO BASEMENT: STAIN STAIRS AND HAND RAIL - VINTAGE ATLANTIS ON RED OAK
01Aug25 NoCat		
3246	1	THRU OUT STANDARD AREAS: WALL PAINT 'WARM GREY'
01Aug25 NoCat		

PLUMBING

Invoice		Description
3029 164,798 05Oct23	1	KITCHEN: S/I ROUGH-IN 1/4" COLD WATER LINE TO FRIDGE
3029	1	PRINCIPAL ENSUITE: UPGRADE TO MOEN 'ALIGN' SUITE INCLUDING RAIN SHOWER + TUB FILLER + LAV FAUCET x2
05Oct23 NoCat		
3246	1	KITCHEN: UPGRADE SINK
01Aug25 NoCat		
3246	1	PRINCIPAL ENSUITE: CHANGE PLUMBING TRIM COLOUR
01Aug25 NoCat		

STAIRS AND RAILINGS

Invoice	Qty.	Description
3246	1	MAIN STAIRS - 2ND FLOOR TO BASEMENT: UPGRADE RAILING TO 'ODESSA'
01Aug25 NoCat		

WINDOWS - BASEMENT

EMENT: S/I BASEMENT WINDOW SIZE 30" X 24" IN LIEU OF STANDARD – 10" WHITE. WINDOW WELLS MAY BE JUIRED. 50'S & 60'S

DisciplineMS.rpt 23feb21 Page 7 of 7



OM	LEVEL	DESCRIPTION
TCHEN WALL: MIDDLE		
SECTION BASE/UPPER:	UPG	SLAB MDF PAINTED 'SWISS COFFEE'
KITCHEN WALL: TALL		
CABINETS:	UPG	SLAB WHITE OAK 'BOARDWALK'
ISLAND:	UPG	SLAB WHITE OAK 'BOARDWALK'
HARDWARE:	UPG	SEE ATTACHED
EXTRAS:		ADD COOKTOP CABINET WITH DRAWERS BELOW + DOUBLE APPLIANCE CABINET
		PLAIN WOOD HOOD - WHITE OAK 'BOARDWALK'
		SHAKER CROWN
		FRIDGE PANELS (supply only)
		OIL AND VINEGAR PULL OUT (LEFT OF COOKTOP)
		SPICE PULL OUT (RIGHT OF COOKTOP)
		RECYCLE CENTER - 4 BIN
		POTS AND PANS DRAWERS
		DISHWASHER PANEL (supply only)
		FLUSH KICK AT REAR OF ISLAND
		PANTRY INTERIOR ROLL OUT x3
		VALANCE - SHAKER RECESSED LIGHT VALANCE (electrical not included)
		note cooktop is induction, please leave cabinet above cook top the same size as other
		uppers
POWDER ROOM:	STD	SLAB MEL 'LARICE BIANCO'
HARDWARE:	STD	SEE ATTACHED
LAUNDRY	STD	SLAB MEL 'LARICE BIANCO'
HARDWARE:	STD	SEE ATTACHED
COUNTER:	STD	P-LAM 'WHITE'
PRINCIPAL ENSUITE:	STD	SLAB MEL 'LARICE BIANCO'
HARDWARE:	STD	SEE ATTACHED
SHARED ENSUITE	STD	SLAB MEL 'LARICE BIANCO'
HARDWARE:	STD	SEE ATTACHED
ENSUITE 4	STD	SLAB MEL 'LARICE BIANCO'
HARDWARE:	STD	SEE ATTACHED
BASEMENT BATH:	STD	SLAB MEL 'LARICE BIANCO'
HARDWARE:	STD	SEE ATTACHED

LOT#: 7-1	DATE: JULY 31 2025	
SIGNATURE:		i,
SIGNATURE:		

KITCHENS INC. **EURO CHOICE**

Guelph, On. NIL 1E2 Phone: 519-821-3670 2 Watson Rd. S.

Fax: 519-821-3613 PAGE 1 OF 5

ORDER#

CUSTOMER:

ROLLINGWOODS (ESTATES) INC. (GOLDPARK HOMES)

SHIPPING DIRECTIONS: PV4 - 7-1 132 SOUTHSEA CRESCENT, VAUGHAN

DATE ORDERED:

DATE REQUIRED:

BASE, UPPERS & HOOD

DESIGN: SLAB MDF STAIN: BM. OC-45 SWISS COFFEE

FRIDGE, PANTRY/OVEN & ISLAND
DESIGN: SLAB WHITE OAK
STAIN: BOARDWALK

HDWE: SEE ELEVATION

CTOP: 3" SLAB

-14" FROM BACK OF CROWN TO WALL-LIGHT VALANCE: SHAKER DRAWER TRACKS: QUADRO ON MELAMINE CROWN: 6"H SHAKER W/CLEAT (16"H TOTAL)

SOFT CLOSE DOORS

DRAWINGS ARE FOR PRESENTATION PURPOSES ONLY, MAY NOT BE EXACTLY AS THIS IS AN ARTIST'S RENDITION. THE


DRAWN DATE: JULY 14/25


DESIGNER: CLARA

SALES REP:TOM

-TO CEILING W/CROWN--NOTCH CROWN AROUND DROP-CABINET HEIGHT: 48" UPPERS-HANG @104" CEILING HEIGHT: 120" - 108" TO DROP@ SIDE

	-PANEL READY- (SUPPLY ONLY)	BUILT OUT FRIDGE
SINK - PANEL READY- SINK SUPPLY ONLY)	36" COOKTOP	PLAIN BOX HOOD
	MICRO/OVEN	BUILT-IN
		PANIRY

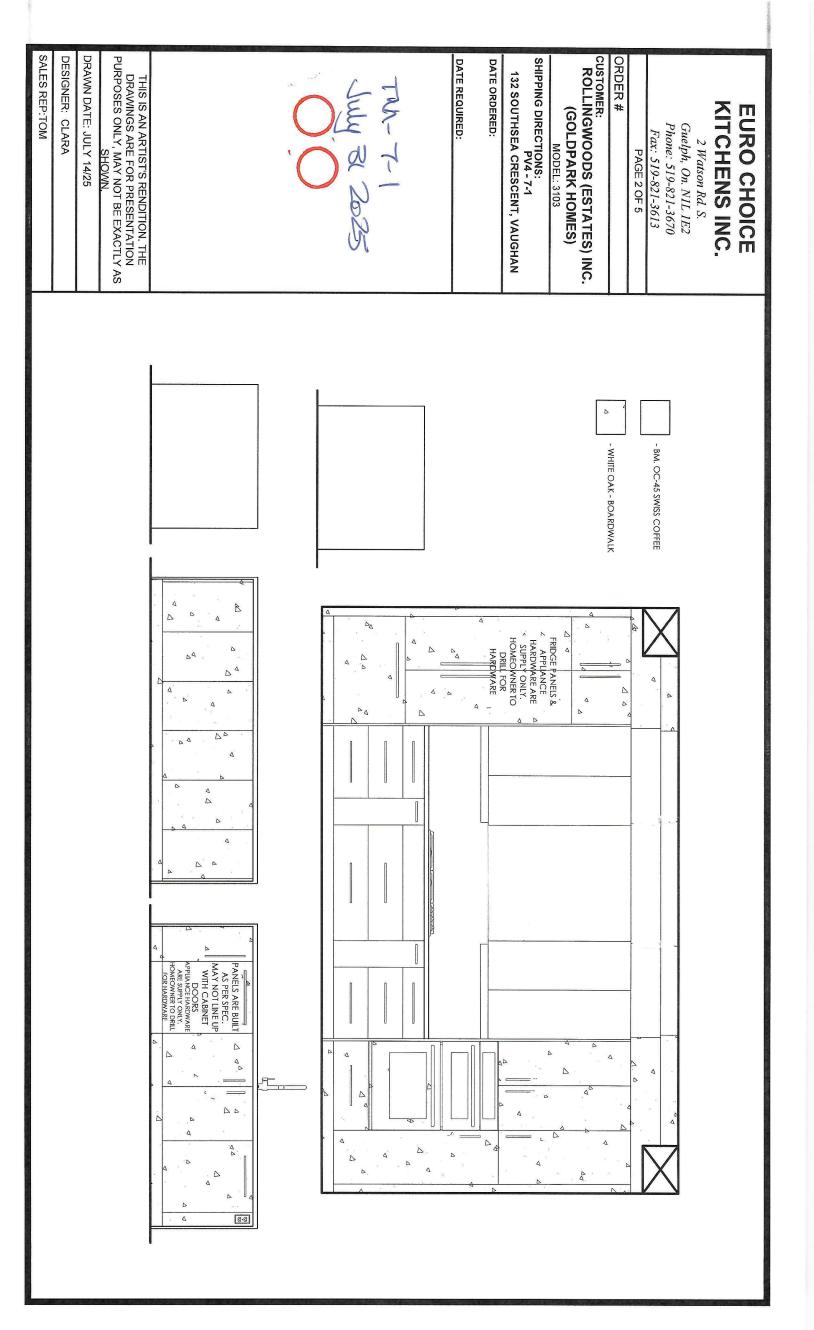

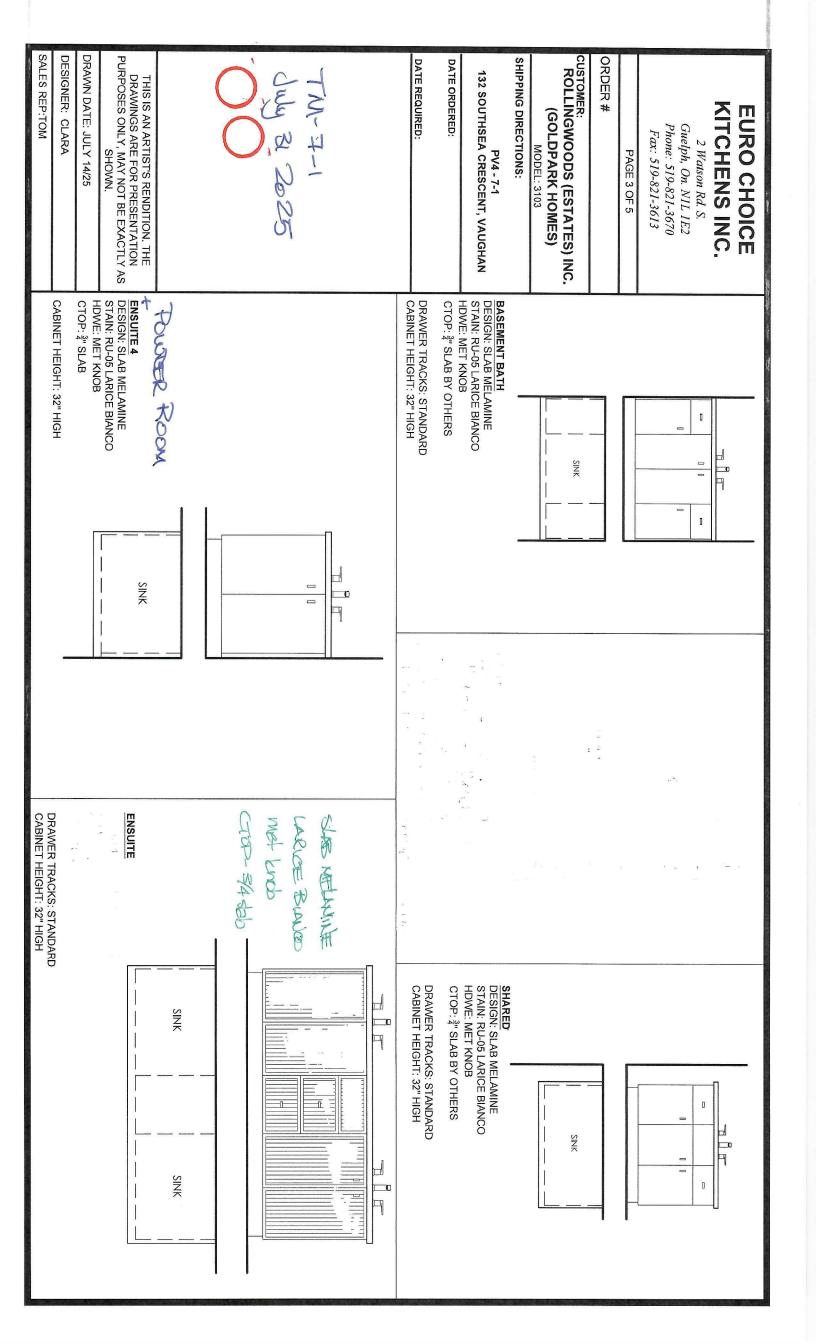

M THE MANORS

The Ashfon Manor

4 BEDROOMS | 4.5 BATHROOMS

ELEV. A 2825 SQ.FT.
INCLUDES 583 SQ.FT. OF FINISHED BASEMENT

ELEV. B 2813 sq.ft.
INCLUDES 583 SQ.FT. OF FINISHED BASEMENT


END 1 A 2866 sq.ft.
INCLUDES 587 SQ.FT. OF FINISHED BASEMENT

END 1 B 2855 sq.Ft.
INCLUDES 587 SQ.FT. OF FINISHED BASEMENT

END 2 A 2858 sq.ft.
INCLUDES 590 SQ.FT. OF FINISHED BASEMENT

END 2 B 2846 sq.ft.
INCLUDES 590 SQ.FT. OF FINISHED BASEMENT



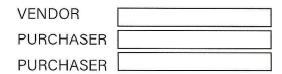

SCHEDULE 'F'

GOLD PARK WORTH MORE"

RENDERINGS ARE ARTIST'S CONCEPT. FIGURES, ILLUSTRATIONS, SIZES, FEATURES AND FINISHES ARE SUBJECT TO CHANGE WITHOUT NOTICE, AREAS AND DIMENSIONS ARE APPROXIMATE AND ACTUAL USABLE FLOOR SPACE MAY VARY FROM THE STATED AREA, LAYOUT MAY BE REVERSE OF THE UNIT PURCHASED, E. & O.E. 3103



The Ashton Manor

4 BEDROOMS | 4.5 BATHROOMS

ELEV. A 2825 SQ.FT.
INCLUDES 583 SQ.FT. OF FINISHED BASEMENT


ELEV. B 2813 sq.ft.
INCLUDES 583 SQ.FT. OF FINISHED BASEMENT


END 1 A 2866 sq.ft.
INCLUDES 587 SQ.FT. OF FINISHED BASEMENT

END 1 B 2855 sq.ft.
INCLUDES 587 SQ.FT. OF FINISHED BASEMENT

END 2 A 2858 sq.ft.

► END 2 B 2846 sq.ft.
INCLUDES 590 SQ.FT. OF FINISHED BASEMENT

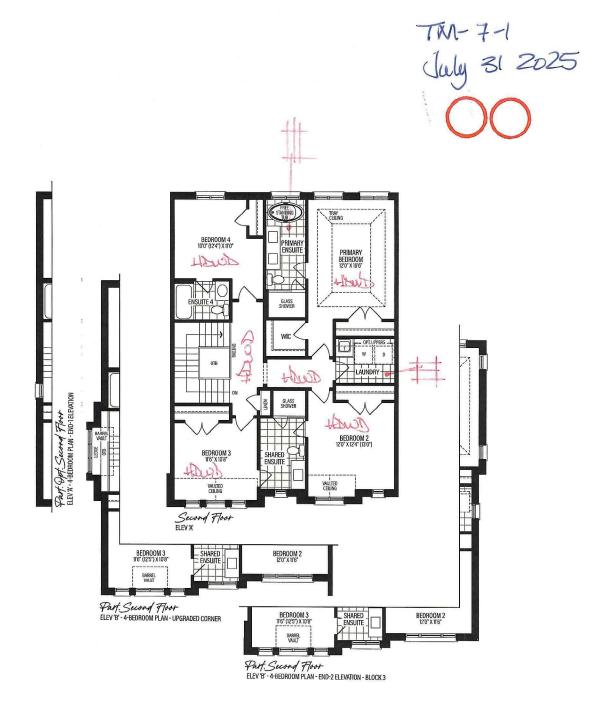

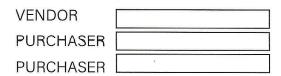





ELEV. A 2825 sq.ft.

ELEV. B 2813 sq.ft.
INCLUDES 583 SQ.FT. OF FINISHED BASEMENT

INCLUDES 583 SQ.FT. OF FINISHED BASEMENT

The Ashton Manor

4 BEDROOMS | 4.5 BATHROOMS


END 1 A 2866 sq.ft.
INCLUDES 587 SQ.FT. OF FINISHED BASEMENT

END 1 B 2855 sq.ft.
INCLUDES 587 SQ.FT. OF FINISHED BASEMENT


END 2 A 2858 sq.ft.
INCLUDES 590 SQ.FT. OF FINISHED BASEMENT

END 2 B 2846 sq.ft.
INCLUDES 590 SQ.FT. OF FINISHED BASEMENT

TM-7-1 July 31 2025

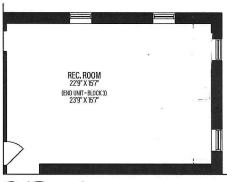

Part: Basement ELEV'A' & 'B' - END-2 ELEVATION

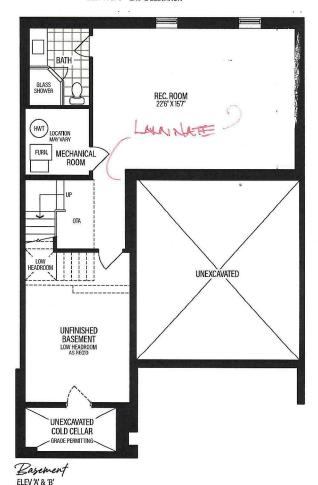

VENDOR

PURCHASER

PURCHASER

SCHEDULE 'F'

GOLDPARK WORTH MORE"

RENDERINGS ARE ARTIST'S CONCEPT, FIGURES, ILLUSTRATIONS, SIZES, FEATURES AND FINISHES ARE SUBJECT TO CHANGE WITHOUT NOTICE, AREAS AND DIMENSIONS ARE APPROXIMATE AND ACTUAL USABLE FLOOR SPACE MAY VARY FROM THE STATED AREA. LAYOUT MAY BE REVERSE OF THE UNIT PURCHASED. E. & O.E. 3103



COUNTER EDGE PROFILES THICKNESS V STANDARD - 2CM UPGRADE - 3CM **EDGE PROFILE - STANDARDS** STANDARD EASED THRU OUT except KITCHEN **EDGE PROFILE - UPGRADES** BULLNOSE EDGE MITER EDGE MICRO BEVEL (2CM ONLY) KNIFE EDGE OGEE EDGE SINGLE BEVEL QUIRK MITER EDGE Date:


Signature:

Signature



FRANKE

Maris Undermount Sink 31"

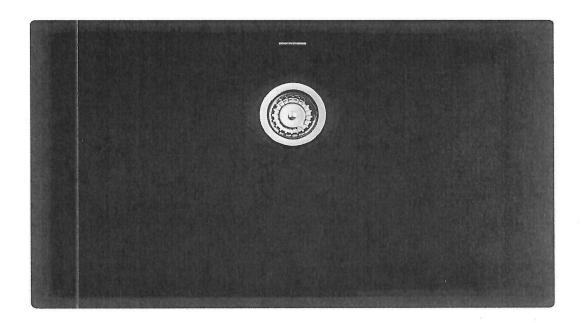

*Strain Basket Included	SLATE GREY STONE GREY CHAMPAGNE MATTE BLACK MOCHA ONYX OYSTER POLAR WHITE
DATE: July 31 2025	LOT: TM-7-1
LOCATION:	
SIGNATURE:	SIGNATURE:

MAG11029-ONY-S/MAG11029-OYS-S/MAG11029-PWT-S/MAG11029-SHG-S/MAG11029-SLG-S/MAG11029-CHA-S/MAG11029-MBK-S/MAG11029-MOC-

S

GOLDPARK



CABINETRY HARDWARE UPGRADES

Pull 160mm CC 9899-1MDB-P

Metro

	Brushed Nickel	
	Modern Brushed Gold	
	Matte Black	
Date: July 31 2025	Lot: TM-3-	
Location: KITCHEN -	spice pullouts + pan	try buen + signal front
Signature:	Signature:	

GOLDPARK

** Touch botch on island near.



GOLD PARK WORTH MORE

CABINETRY HARDWARE UPGRADES

Metro Appliance Pull

	a di kacampilia di palambilia di	
	Brushed Nickel	
	Modern Brushed Gold	
	Matte Black	
	Matte Black	a dan Ti gan adiyan sa
Date:	Lot:	
Chuly 31 2025	771-7-1	
Jim 5: 202		
Location: KITCHEN **supply only		
Signature:	Signature:	
	the state of the s	

9902-1MDB-P



GOLD PARK WORTH MORE'

CABINETRY HARDWARE UPGRADES

Pull 320mm CC

9902-1MDB-P

Metro

	Brushed Nickel Modern Brushed Gold	
Date: July 31 2025	Matte Black Lot: TM-3-1	
Location: KITCHEN	base calonet drawers	
Signature	Signature:	



STANDARD CABINETRY HARDWARE


TARKUO EXCEPT KITCH		7 -	
except Kutou	Satin Nickel	Matte Black	Brushed Nickel
Brushed Nickel	Brushed Nickel	Matte Black	
Brushed Nickel	Brushed Nickel	Matte Black	Brushed Nickel
			NONE □
Brushed Nickel	Brushed Nickel	Polished Chrome	NO HOLES
Date: July 31 Ze	25	Lot: 7M-7-1	
ocation:	L		
Signature:		Signature:	



UPGRADE SHOWER HARDWARE

MT6X6

Shower Door Handle

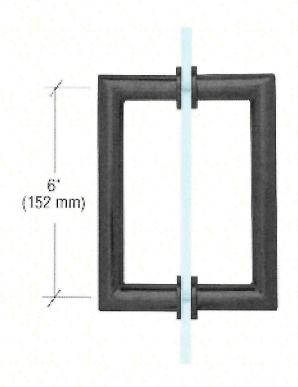

6 x 6" Back-to-Back 3/4" Diameter Tube Cut and Mitred Corners with Washers

a Salay peli belga Shekara Shekara Mayar M		
	Satin Brass Brushed Nickel Chrome Matte Black	+ Huges
Date: 31 2025	Lot: TM-7-1	
Location: PRINCIPAL ENGU	ute	
Signature:	Signature:	






UPGRADE SHOWER HARDWARE

MT6X6

Shower Door Handle

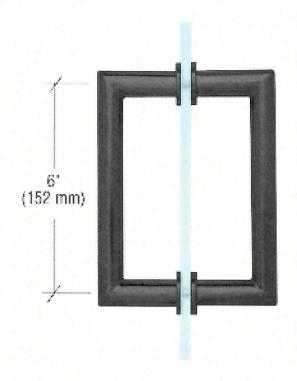

6 x 6" Back-to-Back 3/4" Diameter Tube Cut and Mitred Corners with Washers

	Satin Brass	
	Brushed Nickel	
	Chrome	V
	Matte Black	
Date: July 31 2025	Lot: TM - 7-1	
Location: SHARED FLOURE		
Signature:	Signature:	
V ,		






UPGRADE SHOWER HARDWARE

MT6X6

Shower Door Handle

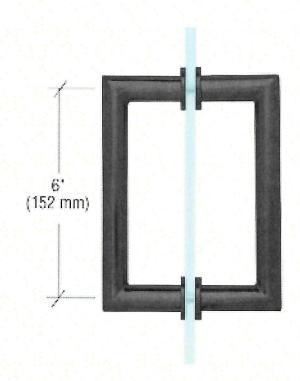

6 x 6" Back-to-Back 3/4" Diameter Tube Cut and Mitred Corners with Washers

	Satin Brass Brushed Nickel	
	Chrome	V
	Matte Black	
Date:	Lot:	
July 31 2025	TV1-7-1	
Location: Texamont Bah		
Signature:	Signature:	

