



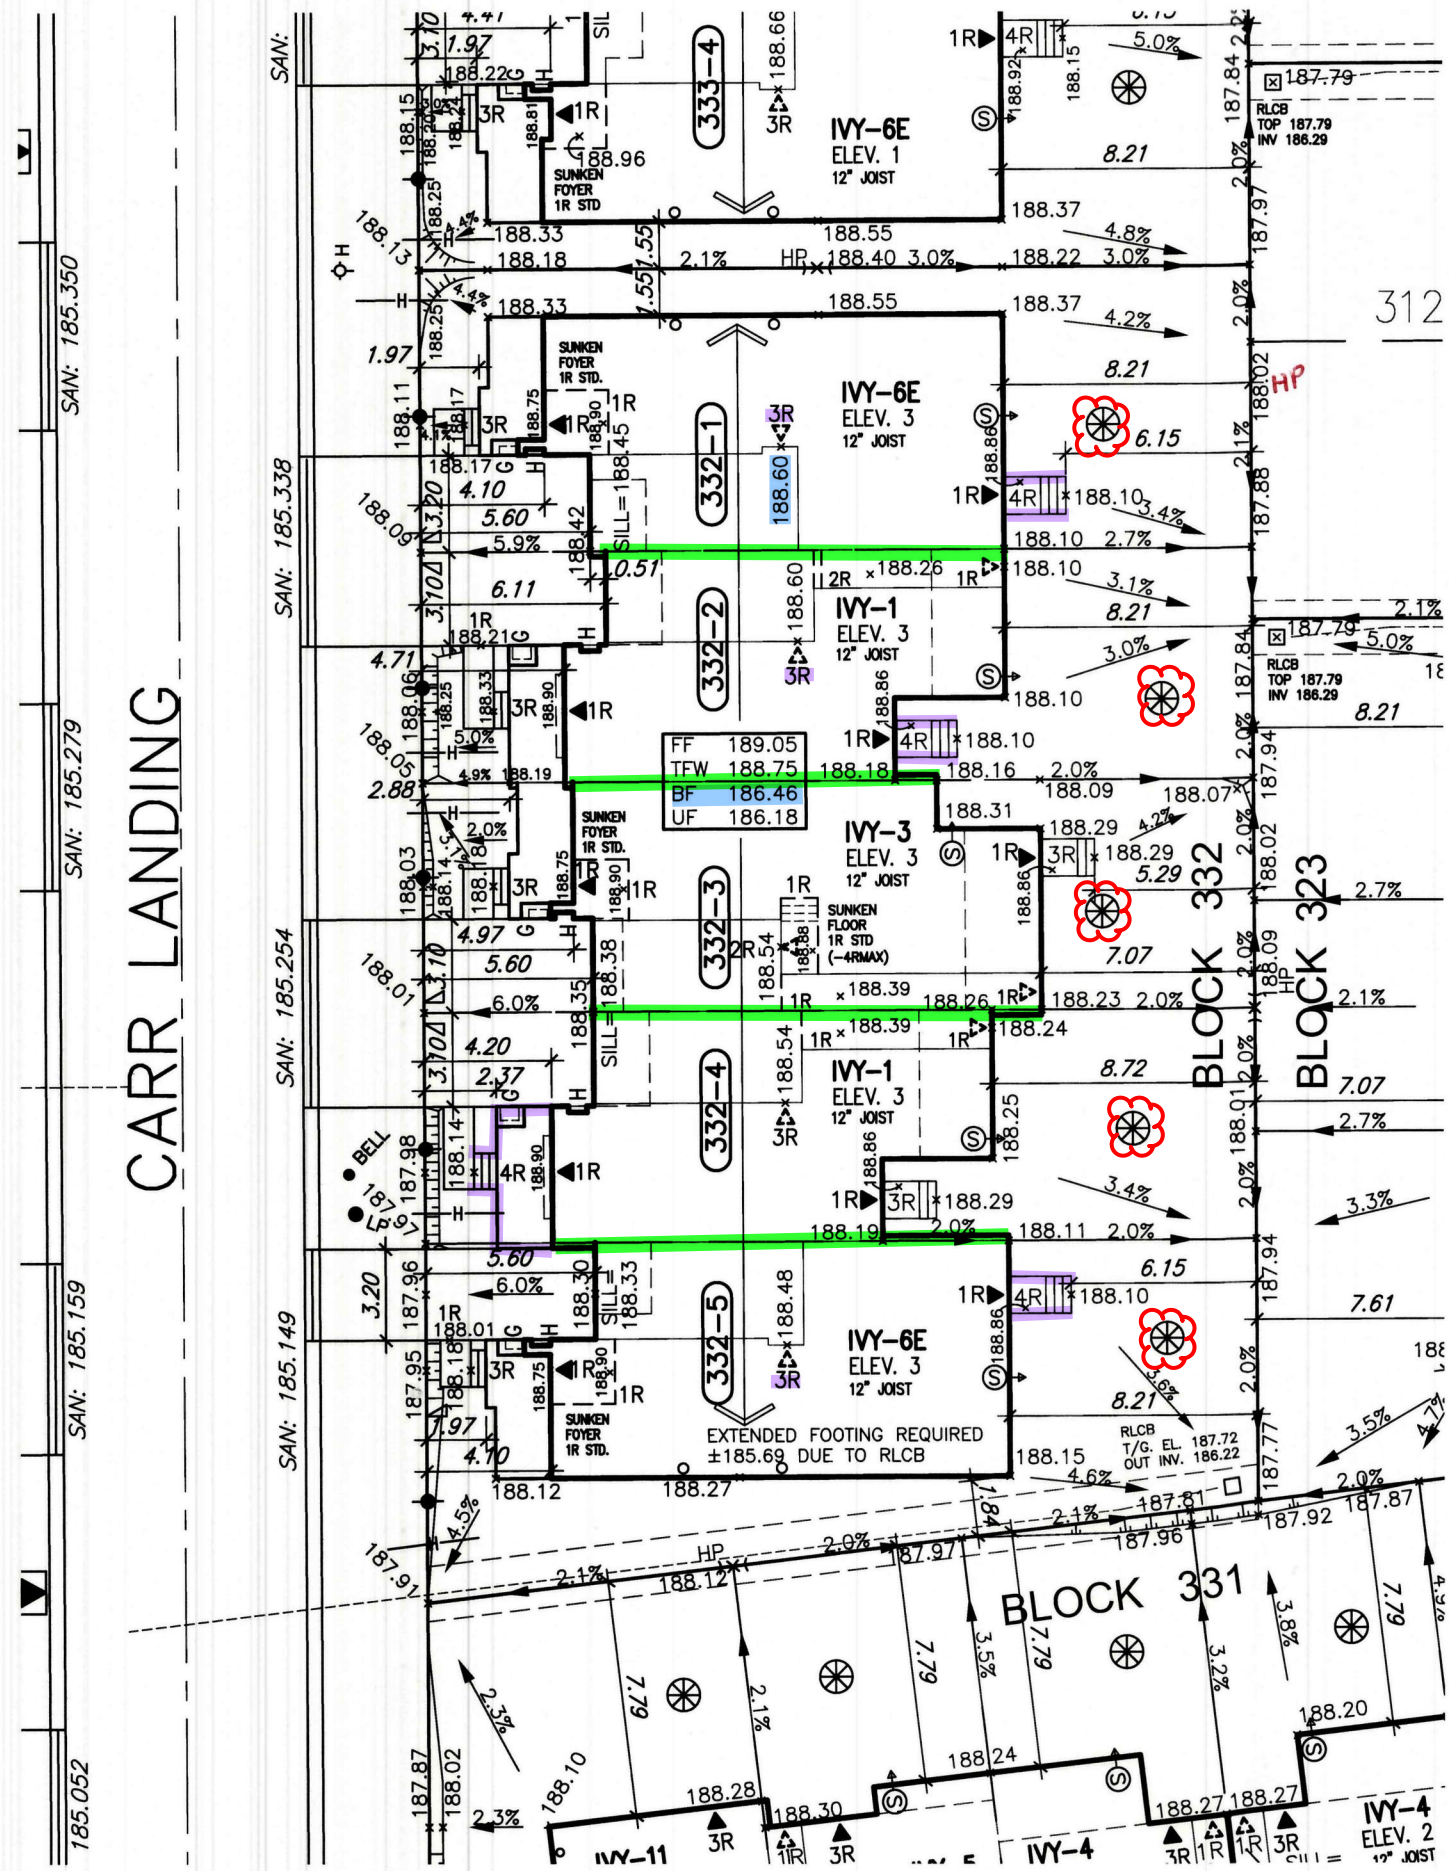

It is the builder's complete responsibility to ensure that all plans submitted for approval fully comply with the Architectural Guidelines and all applicable regulations and requirements including zoning provisions and any provisions in the subdivision agreement. The Control Architect is not responsible in any way for examining or approving site (lotting) plans or working drawings with respect to any zoning or building code or permit matter or that any house can be properly built or located on its lot.

This is to certify that these plans comply with the applicable Architectural Design Guidelines approved by the Town of MILTON.

ARCHITECTURAL REVIEW & APPROVAL
MAR 21 2017
John G. Williams Limited, Architect

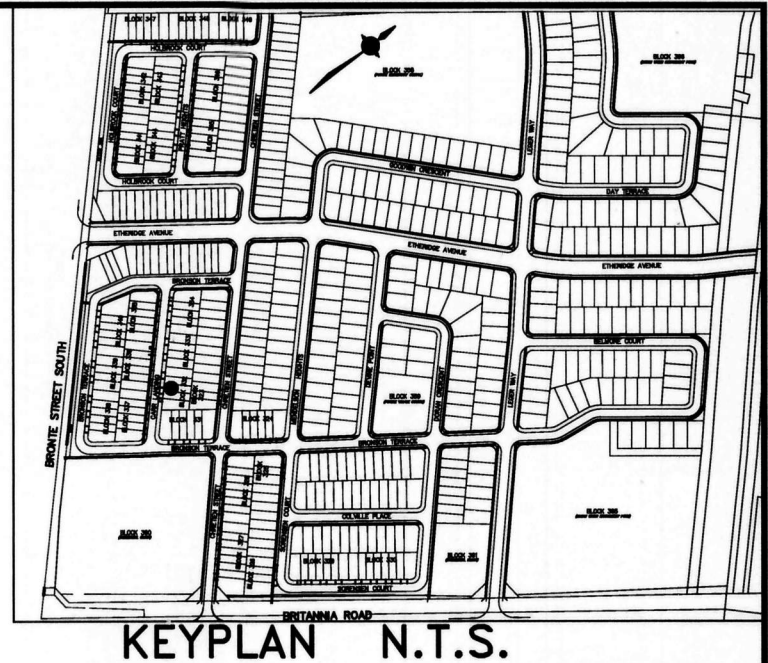

WE CERTIFY THAT THE PROPOSED GRADES AT THE LOT CORNERS ARE CORRECT AND THAT THE LOT GRADING OF THE SUBJECT LOT IS IN CONFORMITY TO THE APPROVED SUBDIVISION GRADING PLANS AND TOWN STANDARDS.

☐ REVIEWED
☒ REVIEWED AS NOTED
☐ REVISE AND RESUBMIT

The MUNICIPAL INFRASTRUCTURE Group Ltd.
DATE: APR 07 2017 By: B. GIBSON



TOWN OF MILTON
PLANNING AND DEVELOPMENT
RMD1*223 ZONE

ZONING: APPROVED
Matthew Seymour MAY 2, 2017
ZONING OFFICER DATE

LEGEND

- 45 Min FRR
- 45 Min FRR w/NC Cladding
- 1 Hr Party Wall
- 2 Hr Firewall (NC)
- Guard/Handrail as per 9.8.
- 2.14m Backfill height as per 9.15.

Siting to be read in conjunction with reviewed main model drawings

RECEIVED
TOWN OF MILTON
APR 12, 2017
17-5052 to 17-5056
BUILDING DIVISION

BLOCK 332 – ELEVATION 3										
	Model Type	Garage Dimension W x L (m)	Coverage (sq.m.)	Lot Area (sq.m.)	Coverage (%)	Uncover Driveway Area (m2)	Front Yard Area (m2)	Front Yard Landscape Area (m2)	Front Yard Landscape (%)	Lot Frontage (m)
332-1	IVY 6E	3.07x6.65	122.26	256.30	47.70	17.92	31.15	13.23	42.47	9.32
332-2	IVY 1	2.90x6.65	104.98	209.55	50.10	18.93	31.96	13.03	40.77	7.62
332-3	IVY 3	2.90x6.00	119.19	209.55	56.88	17.35	30.87	13.52	43.80	7.62
332-4	IVY 1	2.90x6.65	104.98	209.55	50.10	17.35	28.09	10.74	38.23	7.62
332-5	IVY 6E	3.07x6.65	122.26	282.26	43.31	16.90	36.45	19.55	53.64	11.16
TOTAL			573.67	1167.21	49.15	88.45	158.52	70.07	44.20	8.05

1. FOOTINGS ADJACENT TO UNDERGROUND SERVICES
FOOTINGS CONSTRUCTED NEXT TO A CATCHBASIN LEAD PIPE OR OTHER MUNICIPAL SERVICES SHALL BE INSTALLED BELOW THE LEAD PIPE EXCAVATION. FOOTINGS MUST BE CONSTRUCTED ON UNDISTURBED GROUND. SOIL CONSULTANT VERIFICATION MAY BE REQUIRED.

DRAWINGS ARE NOT TO BE SCALED.

NOTE: SUMP PUMP REQUIRED
SUMP PUMPS ARE REQUIRED FOR STORM SERVICE AS PER THE TOWN OF MILTON CRITERIA.
ALL OTHER SUMP PUMPS TO DISCHARGE TO SURFACE UNLESS OTHERWISE SHOWN.

NOTE:
DOWNSPOUTS TO BE LOCATED A MINIMUM OF 3.0M FROM THE SUMP PUMP OUTLET AND ONTO A CONCRETE SPLASH PAD.

Grading Notes:
It shall be the responsibility of the builder to have all grades and services verified and checked before construction by an approved grading engineer. These grades and the placement of storm and sanitary services off the street are to meet the requirements of the municipality having jurisdiction.

VA3 Design Inc. is to be notified promptly of any discrepancies at least 1 (one) week prior to excavation commences in order that the building can be re-sited. Failure to observe these conditions may require expensive remedial action that will not be the responsibility of or cost to VA3 Design Inc. Foundation wall shall be poured to a minimum of 6" above approved grades.

Finished grade lines as indicated on the house prototype are for reference only and do not necessarily depict finish grading conditions of any particular lot.

1. ISSUED FOR ENG. REVIEW. JAN. 05/17 GW

2. REVISED PER ENG. ISSUED FOR PERMIT. FEB. 22/17 GW

3.

4.

5.

6.

PROPOSED VALVE

L.P. LIGHT POLE

H. HYDRANT

TRANSFORMER

WATER SERVICE

DOUBLE STM./SAN. CONNECTION

SINGLE STM./SAN. CONNECTION

CATCH BASIN

CABLE TELEVISION PEDESTAL

BELL PEDESTAL

NO. OF RISERS

FINISHED FLOOR ELEVATION

UNDERSIDE FOOTING ELEVATION

FIN. BASEMENT FLOOR SLAB

TOP OF FOUNDATION WALL

UNDERSIDE FOOTING AT REAR

UNDERSIDE FOOTING AT FRONT

UNDERSIDE FOOTING AT SIDE

W.O.D. WALK OUT DECK

W.O.B. WALK OUT BASEMENT

REV. REVERSE PLAN

STREET SIGN

SUPER MAIL BOX

RETAINING WALL

1.5m BLACK VINYL CHAIN LINK FENCE

ACOUSTICAL FENCE (SEE LANDSCAPE PLAN)

WOOD SCREEN FENCE (SEE LANDSCAPE PLAN)

HYDRO SERVICE LATERAL

SHWLE DIRECTION

EMBANKMENT

PROMOTE 3/4" DIA. CLEAR STONE IN THIS AREA

THIS LOT CONTAINS ENGINEERED FILL

AIR CONDITIONER REQUIRED

RAIN WATER DOWNSPOUT LOCATION (DISCHARGE ONTO SPLASHPAD)

SIDE WINDOW LOCATION

EXTERIOR DOOR LOCATION

REDUCE SIDE YARD

north arrow

The undersigned has reviewed and taken responsibility for this design and has the qualifications and meets the requirements set out in the Ontario Building Code to be a Designer.

qualification information

Richard Vink 24488 BCN

name registration information

VA3 Design Inc. 42658

Builder to verify location of all hydronic, electric, light, telecommunications and other services. If additional dimensions are not indicated, builder is to relocate at his own expense.

Builder to verify service connection elevations prior to constructing foundations.

VA3 DESIGN

255 Consumers Rd Suite 120

Toronto, ON M2J 1R4

t 416.630.2255 f 416.630.4782

va3design.com

Greenpark

project name

LECCO RIDGE DEV. INC.

municipality

MILTON

date

NOV. 2016

checked by

scale

1:250

drawn by

LOT GRADING

16015-LRD-SP-BASE

file name

16015-LRD-SP-BASE

drawing no.

LG10

lot/block no.

332

registered plan no.

16015

project no.

16015

All drawings, specifications, related documents and design are the copyright property of VA3 DESIGN. Reproduction of this property in whole or in part is strictly prohibited without VA3 DESIGN's written permission.

BLOCK 325 - ELEVATION 2

LOT No.	Model Type	Garage Dimension W x L (m)	Coverage (sq.m.)	Lot Area (sq.m.)	Coverage (%)	Uncovered Driveway Area (m2)	Front Yard Area (m2)	Front Yard Landscape Area (m2)	Front Yard Landscape (%)	Lot Frontage (m)	Lot Depth (m)	Proposed Building Height (m)
325-1	IVY 7E	2.97x6.30	128.67	275.00	46.79	18.28	42.61	24.33	57.10	10.00	27.50	
325-2	IVY 5	2.97x6.02	118.54	209.55	56.57	17.35	33.83	16.48	48.71	7.62	27.50	
325-3	IVY 12	2.90x6.00	132.85	318.20	41.75	16.93	52.42	35.49	67.70	12.74	27.50	
TOTAL			380.06	802.75	47.34	52.56	128.86	76.30	59.21			8.46


It is the builder's complete responsibility to ensure that all plans submitted for approval fully comply with the Architectural Guidelines and all applicable regulations and requirements including zoning provisions and any provisions in the subdivision agreement. The Control Architect is not responsible in any way for examining or approving site (lotting) plans or working drawings with respect to any zoning or building code or permit matter or that any house can be properly built or located on its lot.

This is to certify that these plans comply with the applicable Architectural Design Guidelines approved by the Town of MILTON.

ARCHITECTURAL REVIEW & APPROVAL

MAR 21 2017

John G. Williams Limited, Architect

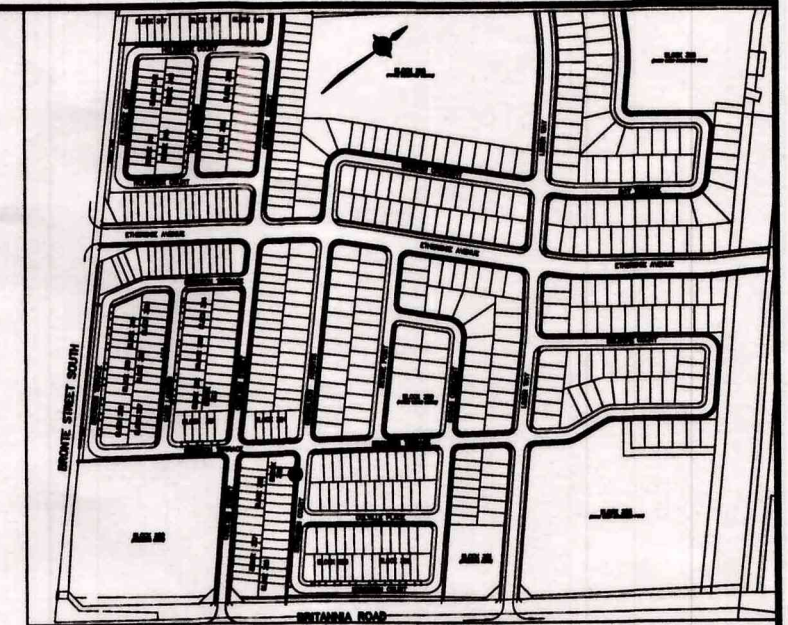

KEYPLAN N.T.S.


#17-5052 to #17-5056



LOT GRADING APPROVED

MAY 18 2017

Town of Milton - Development Engineering

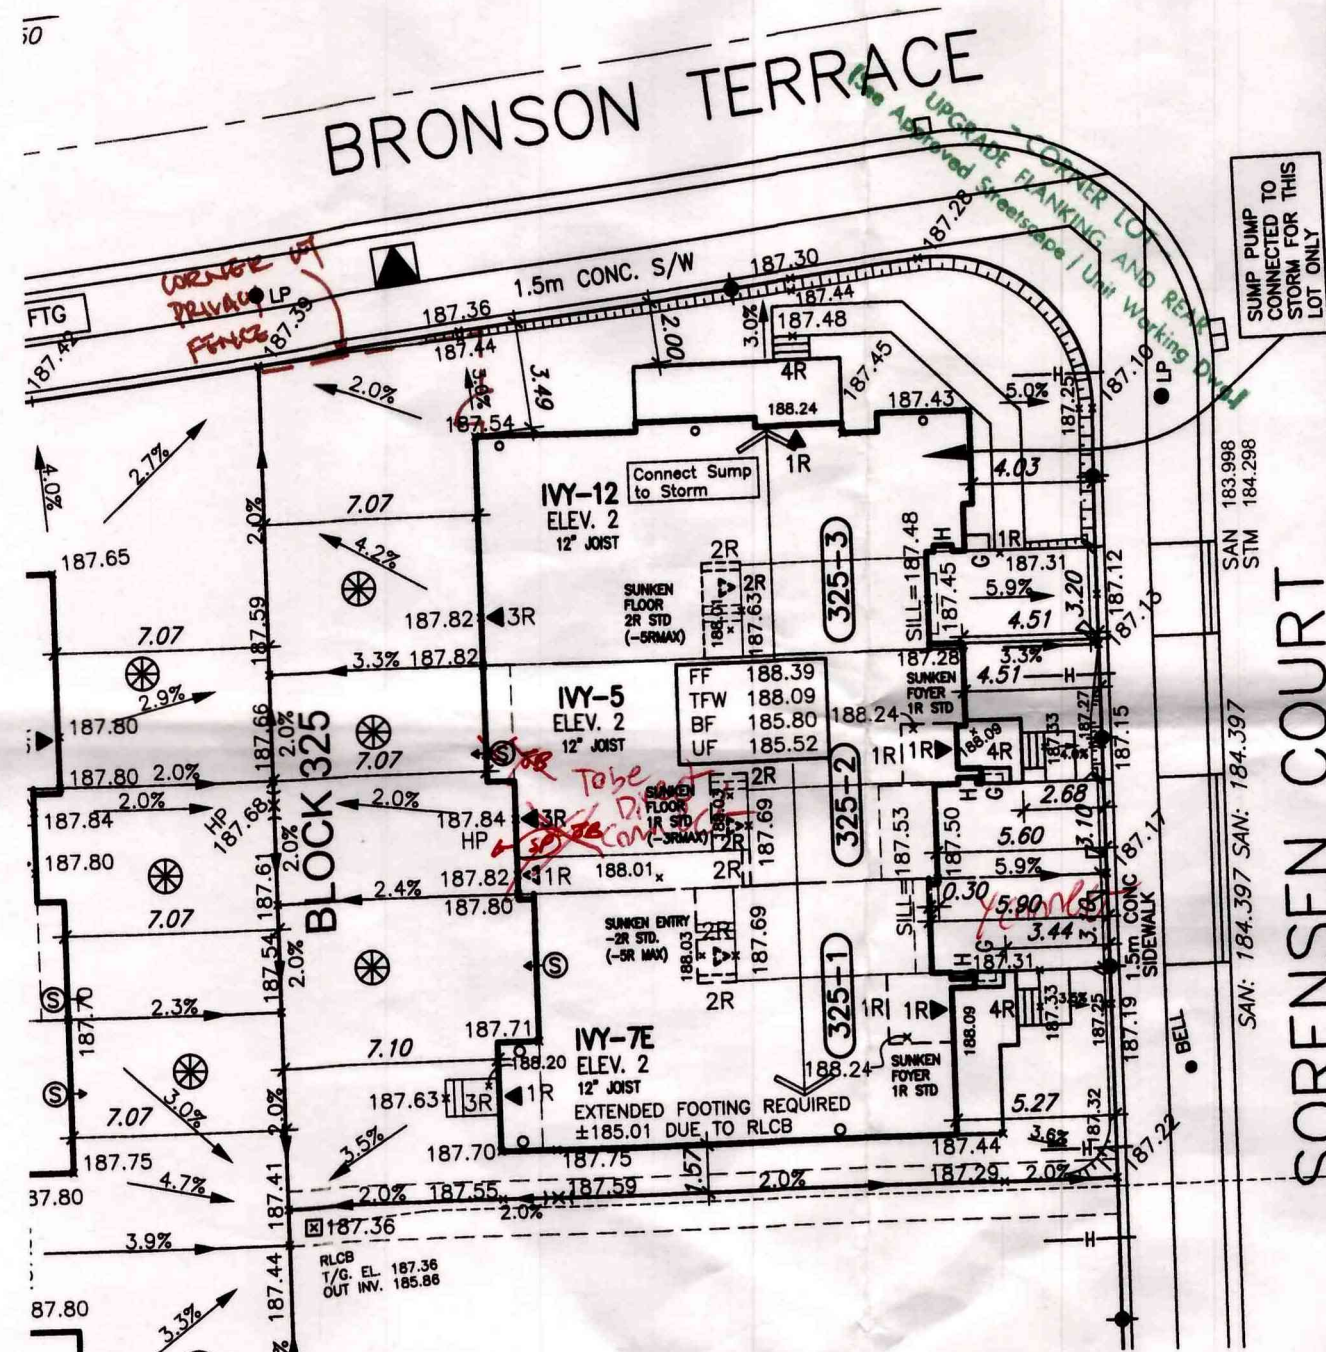

WE CERTIFY THAT THE PROPOSED GRADES AT THE LOT CORNERS ARE CORRECT AND THAT THE LOT GRADING OF THE SUBJECT LOT IS IN CONFORMITY TO THE APPROVED SUBDIVISION GRADING PLANS AND TOWN STANDARDS.

- ☐ REVIEWED
- ☒ REVIEWED AS NOTED
- ☐ REVISE AND RESUBMIT

The MUNICIPAL INFRASTRUCTURE Group Ltd.

DATE: APR 07 2017 By: B. GIBSON

NOTE: DOWNSPOUTS TO BE LOCATED A MINIMUM OF 3.0M FROM THE SUMP PUMP OUTLET AND ONTO A CONCRETE SPLASH PAD.

NOTE: SUMP PUMP REQUIRED S- SUMP PUMPS ARE REQUIRED FOR STORM SERVICE AS PER THE TOWN OF MILTON CRITERIA.

ALL OTHER SUMP PUMPS TO DISCHARGE TO SURFACE UNLESS OTHERWISE SHOWN.

1. FOOTINGS ADJACENT TO UNDERGROUND SERVICES FOOTINGS CONSTRUCTED NEXT TO A CATCHBASIN LEAD PIPE OR OTHER MUNICIPAL SERVICES SHALL BE INSTALLED BELOW THE LEAD PIPE EXCAVATION. FOOTINGS MUST BE CONSTRUCTED ON UNDISTURBED GROUND. SOIL CONSULTANT VERIFICATION MAY BE REQUIRED.

DRAWINGS ARE NOT TO BE SCALED.

Grading Notes:

It shall be the responsibility of the builder to have all grades and services verified and checked before construction by an approved grading engineer. These grades and the placement of storm and sanitary services off the street are to meet the requirements of the municipality having jurisdiction.

VA3 Design Inc. is to be notified promptly of any discrepancies at least 1 (one) week prior to excavation commences in order that the building can be re-sited. Failure to observe these conditions may require expensive remedial action that will not be the responsibility of or cost to VA3 Design Inc. Foundation wall shall be poured to a minimum of 6" above approved grades.

Finished grade lines as indicated on the house prototype are for reference only and do not necessarily depict finish grading conditions of any particular lot.

1 ISSUED FOR ENG. REVIEW. JAN. 05/17 GW		2 REVISED PER ENG. ISSUED FOR PERMIT. FEB. 22/17 GW		3		4		5		6							
PROPOSED VALE LP LIGHT POLE HYDRA TRANSFORMER WATER SERVICE DOUBLE STA./SAL. CONNECTION SINGLE STA./SAL. CONNECTION CATCH BASIN CABLE TELEVISION PEDestal BELL PEDestal			FF FINISHED FLOOR ELEVATION UF UNDERSIDE FOOTING ELEVATION BF FIN. BASEMENT FLOOR SLAB TPW TOP OF FOUNDATION WALL UPR UNDERSIDE FOOTING AT REAR UPF UNDERSIDE FOOTING AT FRONT UPS UNDERSIDE FOOTING AT SIDE W.O.D. WALK OUT DECK W.O.B. WALK OUT BEMENT REV REVERSE PLAN			STREET SIGN SUPER MAIL BOX RETAINING WALL 1.5m BLACK VINYL CHAIN LINK FENCE ACOUSTICAL FENCE (SEE LANDSCAPE PLAN) WOOD SCREEN FENCE (SEE LANDSCAPE PLAN) HYDRO SERVICE LATERAL SHADE DIRECTION EMBANKMENT			PROVIDE 3/4" DIA. CLEAR STONE IN THIS AREA THIS LOT CONTAINS ENGINEERED FILL AIR CONDITIONER REQUIRED RAIN WATER DOWNSPOUT LOCATION (DISCHARGE ONTO SPLASHPAD) SIDE WINDOW LOCATION EXTERIOR DOOR LOCATION REDUCE SIDE YARD			VA3 DESIGN 255 Consumers Rd Suite 120 Toronto ON M2J 1R4 t 416.630.2255 f 416.630.4782 va3design.com			Greenpark LECCO RIDGE DEV. INC. MILTON 16015 LOT GRADING 16015-LRD-SP-BASE LG3		