


It is the builder's complete responsibility to ensure that all plans submitted for approval fully comply with the Architectural Guidelines and all applicable regulations and requirements including zoning provisions and any provisions in the subdivision agreement. The Control Architect is not responsible in any way for examining or approving site (lotting) plans or working drawings with respect to any zoning or building code or permit matter or that any house can be properly built or located on its lot.

This is to certify that these plans comply with the applicable Architectural Design Guidelines approved by the Town of MILTON.

ARCHITECTURAL REVIEW & APPROVAL

MAR 21 2017

John G. Williams Limited, Architect

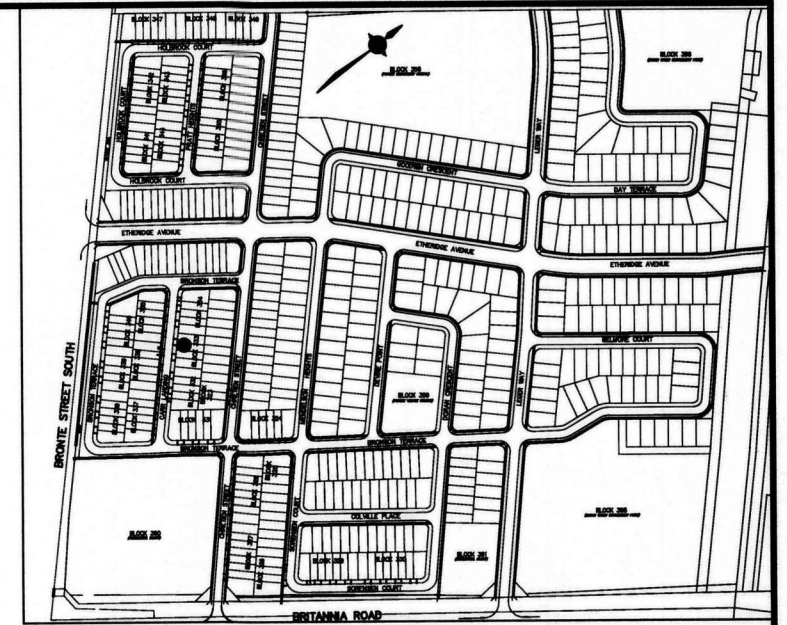

KEYPLAN N.T.S.

WE CERTIFY THAT THE PROPOSED GRADES AT THE LOT CORNERS ARE CORRECT AND THAT THE LOT GRADING OF THE SUBJECT LOT IS IN CONFORMITY TO THE APPROVED SUBDIVISION GRADING PLANS AND TOWN STANDARDS.

☒ REVIEWED


☐ REVIEWED AS NOTED

☐ REVISE AND RESUBMIT

The MUNICIPAL INFRASTRUCTURE Group Ltd.

DATE: APR 07 2017

By: B. GIBSON

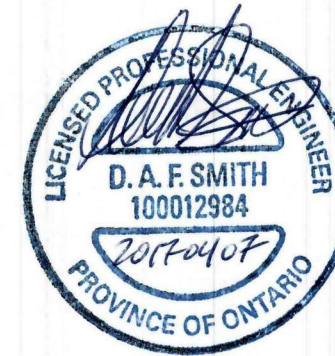

TOWN OF MILTON
PLANNING AND DEVELOPMENT
RMD1*223 ZONE
ZONING: APPROVED
Matthew Seymour MAY 2, 2017
ZONING OFFICER DATE

LEGEND
45 Min FRR
45 Min FRR w/NC Cladding
1 Hr Party Wall
2 Hr Firewall (NC)
Guard/Handrail as per 9.8.
Backfill height as per 9.15.
2.21 m

RECEIVED
TOWN OF MILTON
APR 12, 2017
17-5058 to 17-5061
BUILDING DIVISION

Siting to be read in conjunction with reviewed main model drawings

BACKFILL HEIGHT
Areas with backfill height exceeding 2.15 m are to have foundation wall thickened to 10" (refer to reviewed block plans)

BLOCK 333 - ELEVATION 1

LOT No.	Model Type	Garage Dimension W x L (m)	Coverage (sq.m.)	Lot Area (sq.m.)	Coverage (%)	Uncover Driveway Area (m2)	Front Yard Area (m2)	Front Yard Landscape Area (m2)	Front Yard Landscape (%)	Lot Frontage (m)	Lot Depth (m)	Proposed Building Height (m)
333-1	IVY 6E	3.07x6.65	122.26	256.30	47.70	17.92	31.15	13.23	42.47	9.32	27.50	
333-2	IVY 5	2.97x6.02	122.91	209.55	58.65	17.35	29.47	12.12	41.13	7.62	27.50	
333-3	IVY 4	2.97x6.02	115.94	209.55	55.33	17.35	33.75	16.40	48.59	7.62	27.50	
333-4	IVY 6E	3.07x6.65	122.26	256.30	47.70	17.92	31.15	13.23	42.47	9.32	27.50	
TOTAL			483.37	931.70	51.88	70.54	125.52	54.98	43.80			8.15

Grading Notes:

It shall be the responsibility of the builder to have all grades and services verified and checked before construction by an approved grading engineer. These grades and the placement of storm and sanitary services off the street are to meet the requirements of the municipality having jurisdiction.

VA3 Design Inc. is to be notified promptly of any discrepancies at least 1 (one) week prior to excavation commences in order that the building can be re-sited. Failure to observe these conditions may require expensive remedial action that will not be the responsibility of or cost to VA3 Design Inc. Foundation wall shall be poured to a minimum of 6" above approved grades.

Finished grade lines as indicated on the house prototype are for reference only and do not necessarily depict finish grading conditions of any particular lot.

1. FOOTINGS ADJACENT TO UNDERGROUND SERVICES
FOOTINGS CONSTRUCTED NEXT TO A CATCHBASIN LEAD PIPE OR OTHER MUNICIPAL SERVICES SHALL BE INSTALLED BELOW THE LEAD PIPE EXCAVATION. FOOTINGS MUST BE CONSTRUCTED ON UNDISTURBED GROUND. SOIL CONSULTANT VERIFICATION MAY BE REQUIRED.

DRAWINGS ARE NOT TO BE SCALED.

NOTE: SUMP PUMP REQUIRED
SUMP PUMPS ARE REQUIRED FOR STORM SERVICE AS PER THE TOWN OF MILTON CRITERIA.

ALL OTHER SUMP PUMPS TO DISCHARGE TO SURFACE UNLESS OTHERWISE SHOWN.

NOTE:
DOWNSPOUTS TO BE LOCATED A MINIMUM OF 3.0M FROM THE SUMP PUMP OUTLET AND ONTO A CONCRETE SPLASH PAD.


1 ISSUED FOR ENG. REVIEW. JAN. 05/17 GW		2 REVISED PER ENG. ISSUED FOR PERMIT. FEB. 22/17 GW		3		4		5		6	
LEGEND LP LIGHT POLE H HYDRAULIC TRANSFORMER WATER SERVICE DOUBLE STIM/SAN. CONNECTION SINGLE STIM/SAN. CONNECTION CATCH BASIN CABLE TELEVISION PEDESTAL BELL PEDESTAL J.R. NO. OF RISERS FF FINISHED FLOOR ELEVATION UF UNDERSIDE FOOTING ELEVATION BF FIN. BASEMENT FLOOR SLAB TFW TOP OF FOUNDATION WALL UFFR UNDERSIDE FOOTING AT REAR UFF UNDERSIDE FOOTING AT FRONT UFFS UNDERSIDE FOOTING AT SIDE W.O.D. WALK OUT DECK W.O.B. WALK OUT BASEMENT REV REVERSE PLAN STREET SIGN SUPER MAIL BOX RETAINING WALL 1.5m BLACK VINYL CHAIN LINK FENCE ACOUSTICAL FENCE (SEE LANDSCAPE PLAN) WOOD SCREEN FENCE (SEE LANDSCAPE PLAN) HYDRO SERVICE LATERAL SWALE DIRECTION EMBANKMENT PROVIDE 3/4" DIA. CLEAR STONE IN THIS AREA THIS LOT CONTAINS ENGINEERED FILL AIR CONDITIONER REQUIRED RAIN WATER DOWNSPOUT LOCATION (DISCHARGE ONTO SPLASHPAD) SIDE WINDOW LOCATION EXTERIOR DOOR LOCATION REDUCE SIDE YARD		LEGEND 45 Min FRR 45 Min FRR w/NC Cladding 1 Hr Party Wall 2 Hr Firewall (NC) Guard/Handrail as per 9.8. Backfill height as per 9.15. 2.21 m		BACKFILL HEIGHT Areas with backfill height exceeding 2.15 m are to have foundation wall thickened to 10" (refer to reviewed block plans)		LEGEND 45 Min FRR 45 Min FRR w/NC Cladding 1 Hr Party Wall 2 Hr Firewall (NC) Guard/Handrail as per 9.8. Backfill height as per 9.15. 2.21 m		RECEIVED TOWN OF MILTON APR 12, 2017 17-5058 to 17-5061 BUILDING DIVISION		LEGEND 45 Min FRR 45 Min FRR w/NC Cladding 1 Hr Party Wall 2 Hr Firewall (NC) Guard/Handrail as per 9.8. Backfill height as per 9.15. 2.21 m	
VA3 DESIGN 255 Consumers Rd Suite 120 Toronto ON M2J 1R4 t 416.630.2255 f 416.630.4782 va3design.com		Greenpark LECCO RIDGE DEV. INC. MILTON		LOT GRADING date NOV. 2016 drawn by GW checked by scale 1:250 The name 16015-LRD-SP-BASE drawing no. 16015		LG11					

BLOCK 324 - ELEVATION 3											
	Model Type	Garage Dimension W x L (m)	Coverage (sq.m.)	Lot Area (sq.m.)	Coverage (%)	Uncover Driveway Area (m2)	Front Yard Area (m2)	Front Yard Landscape Area (m2)	Front Yard Landscape (%)	Lot Frontage (m)	Proposed Building Height (m)
324-1	IVY 11	2.90x6.00	134.90	337.69	39.95	22.74	67.11	44.37	66.12	12.98	29.00
324-2	IVY 1	2.90x6.65	104.98	220.85	47.53	22.09	39.50	17.41	44.08	7.62	28.92
324-3	IVY 1	2.90x6.65	104.98	219.86	47.75	21.47	38.52	17.05	44.26	7.62	28.78
324-4	IVY 3	2.90x6.00	119.19	218.83	54.47	21.30	40.28	18.98	47.12	7.62	28.65
324-5	IVY 3	2.90x6.00	119.19	217.80	54.72	20.64	39.25	18.61	47.41	7.62	28.51
324-6	IVY 12	2.90x6.00	132.57	367.88	36.04	21.13	58.68	37.55	63.99	12.05	28.51
TOTAL			715.81	1582.91	45.22	129.37	283.34	153.97	54.34		8.18

It is the builder's complete responsibility to ensure that all plans submitted for approval fully comply with the Architectural Guidelines and all applicable regulations and requirements including zoning provisions and any provisions in the subdivision agreement. The Control Architect is not responsible in any way for examining or approving site (lotting) plans or working drawings with respect to any zoning or building code or permit matter or that any house can be properly built or located on its lot.

This is to certify that these plans comply with the applicable Architectural Design Guidelines approved by the Town of MILTON.

ARCHITECTURAL REVIEW & APPROVAL
MAR 21 2017
John G. Williams Limited, Architect

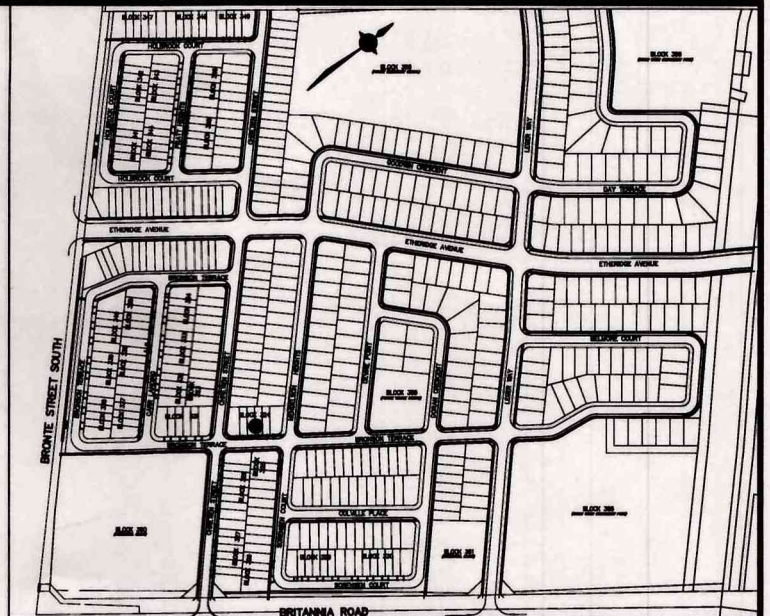

LOT GRADING APPROVED

APR 25 2017

Town of Milton - Development Engineering



WE CERTIFY THAT THE PROPOSED GRADES AT THE LOT CORNERS ARE CORRECT AND THAT THE LOT GRADING OF THE SUBJECT LOT IS IN CONFORMITY TO THE APPROVED SUBDIVISION GRADING PLANS AND TOWN STANDARDS.

☒ REVIEWED
☐ REVIEWED AS NOTED
☐ REVISE AND RESUBMIT

The MUNICIPAL INFRASTRUCTURE Group Ltd.
DATE: APR 07 2017 By: B. GIBSON

NOTE: DOWNSPOUTS TO BE LOCATED A MINIMUM OF 3.0M FROM THE SUMP PUMP OUTLET AND ONTO A CONCRETE SPLASH PAD.

NOTE: SUMP PUMP REQUIRED. SUMP PUMPS ARE REQUIRED FOR STORM SERVICE AS PER THE TOWN OF MILTON CRITERIA.

ALL OTHER SUMP PUMPS TO DISCHARGE TO SURFACE UNLESS OTHERWISE SHOWN.

1. FOOTINGS ADJACENT TO UNDERGROUND SERVICES FOOTINGS CONSTRUCTED NEXT TO A CATCHBASIN LEAD PIPE OR OTHER MUNICIPAL SERVICES SHALL BE INSTALLED BELOW THE LEAD PIPE EXCAVATION. FOOTINGS MUST BE CONSTRUCTED ON UNDISTURBED GROUND. SOIL CONSULTANT VERIFICATION MAY BE REQUIRED.

DRAWINGS ARE NOT TO BE SCALED.

1	ISSUED FOR ENG. REVIEW.	JAN. 05/17	GW	2	REVISED PER ENG. ISSUED FOR PERMIT.	FEB. 22/17	GW	3		4		5		6	
PROPOSED VALVE	JR	No. OF RISERS	FINISHED FLOOR ELEVATION	STREET SIGN	PROVIDE 3/4" DIA. CLEAR STONE IN THIS AREA										
LIGHT POLE	FF	FINISHED FLOOR ELEVATION	UNDERSIDE FOOTING ELEVATION	SUPER MAIL BOX	THIS LOT CONTAINS ENGINEERED FILL										
HYDRAWY	UF	FIN. BASEMENT FLOOR SLAB	TOP OF FOUNDATION WALL	RETAINING WALL	AIR CONDITIONER REQUIRED										
TRANSFORMER	BF	TOP OF FOUNDATION WALL	UNDERSIDE FOOTING AT REAR	1.5m BLACK VINYL CHAIN LINK FENCE	RAIN WATER DOWNSPOUT LOCATION (DISCHARGE ONTO SPLASHPAD)										
WATER SERVICE	UFR	UNDERSIDE FOOTING AT FRONT	UNDERSIDE FOOTING AT SIDE	ACOUSTICAL FENCE (SEE LANDSCAPE PLAN)	SIDE WINDOW LOCATION										
DOUBLE STM./SAN. CONNECTION	UPS	WALK OUT DECK		WOOD SCREEN FENCE (SEE LANDSCAPE PLAN)	EXTERIOR DOOR LOCATION										
SINGLE STM./SAN. CONNECTION	W.O.B.	WALK OUT BASEMENT		HYDRO SERVICE LATERAL	REDUCE SIDE YARD										
CATCH BASIN	REV	REVERSE PLAN		SHADE DIRECTION											
CABLE TELEVISION PEDESTAL				EMBARKMENT											
BELL PEDESTAL															



The undersigned has reviewed and taken responsibility for this design and has the qualifications and meets the requirements set out in the Ontario Building Code to be a Designer.

Qualification Information
Richard Vink 24488 BCN
name registration information
VA3 Design Inc. 42658

Builder to verify location of all hydro, street lights, transformers and other services. If unknown dimensions are not indicated, builder is to relocate at his own expense.
Builder to verify service connection directions prior to constructing foundations.

VA3 DESIGN
255 Consumers Rd Suite 120
Toronto ON M2J 1R4
t 416.630.2255 f 416.630.4782
va3design.com

project name
LECCO RIDGE DEV. INC.

date
NOV. 2016

drawn by
GW

checked by
-

scale
1:250

LOT GRADING
16015-LRD-SP-BASE

drawing no.
LG2

lot/block no.
324

registered plan no.
-

project no.
16015

city
MILTON

date
NOV. 2016

drawn by
GW

checked by
-

scale
1:250

LOT GRADING
16015-LRD-SP-BASE

drawing no.
LG2