

TOWN OF MILTON
PLANNING AND DEVELOPMENT
BUILDING PERMIT: 17-5181
BUILDING REVIEWED
SCOTT SHERRIFFS
APR 24, 2017
DATE

RECEIVED
TOWN OF MILTON
MAR 29, 2017
17-5181
BUILDING DIVISION

GENERAL NOTES/CONSTRUCTION DETAILS
Reviewed model drawings to be read in conjunction with reviewed general notes, construction details and specifications


TOWNHOUSE MODELS
Reviewed townhouse block drawings to be read in conjunction with reviewed townhouse model drawings and engineered truss system

= 2 HOUR FIREWALL
(NON-COMBUSTIBLE)


FIREWALL DETAILS
See standard details page 5
for standard firewall
construction details

= 1 HOUR PARTY WALL
(FIRE SEPARATION)

PARTY WALL DETAILS
See standard details page 4
for standard party wall
construction details

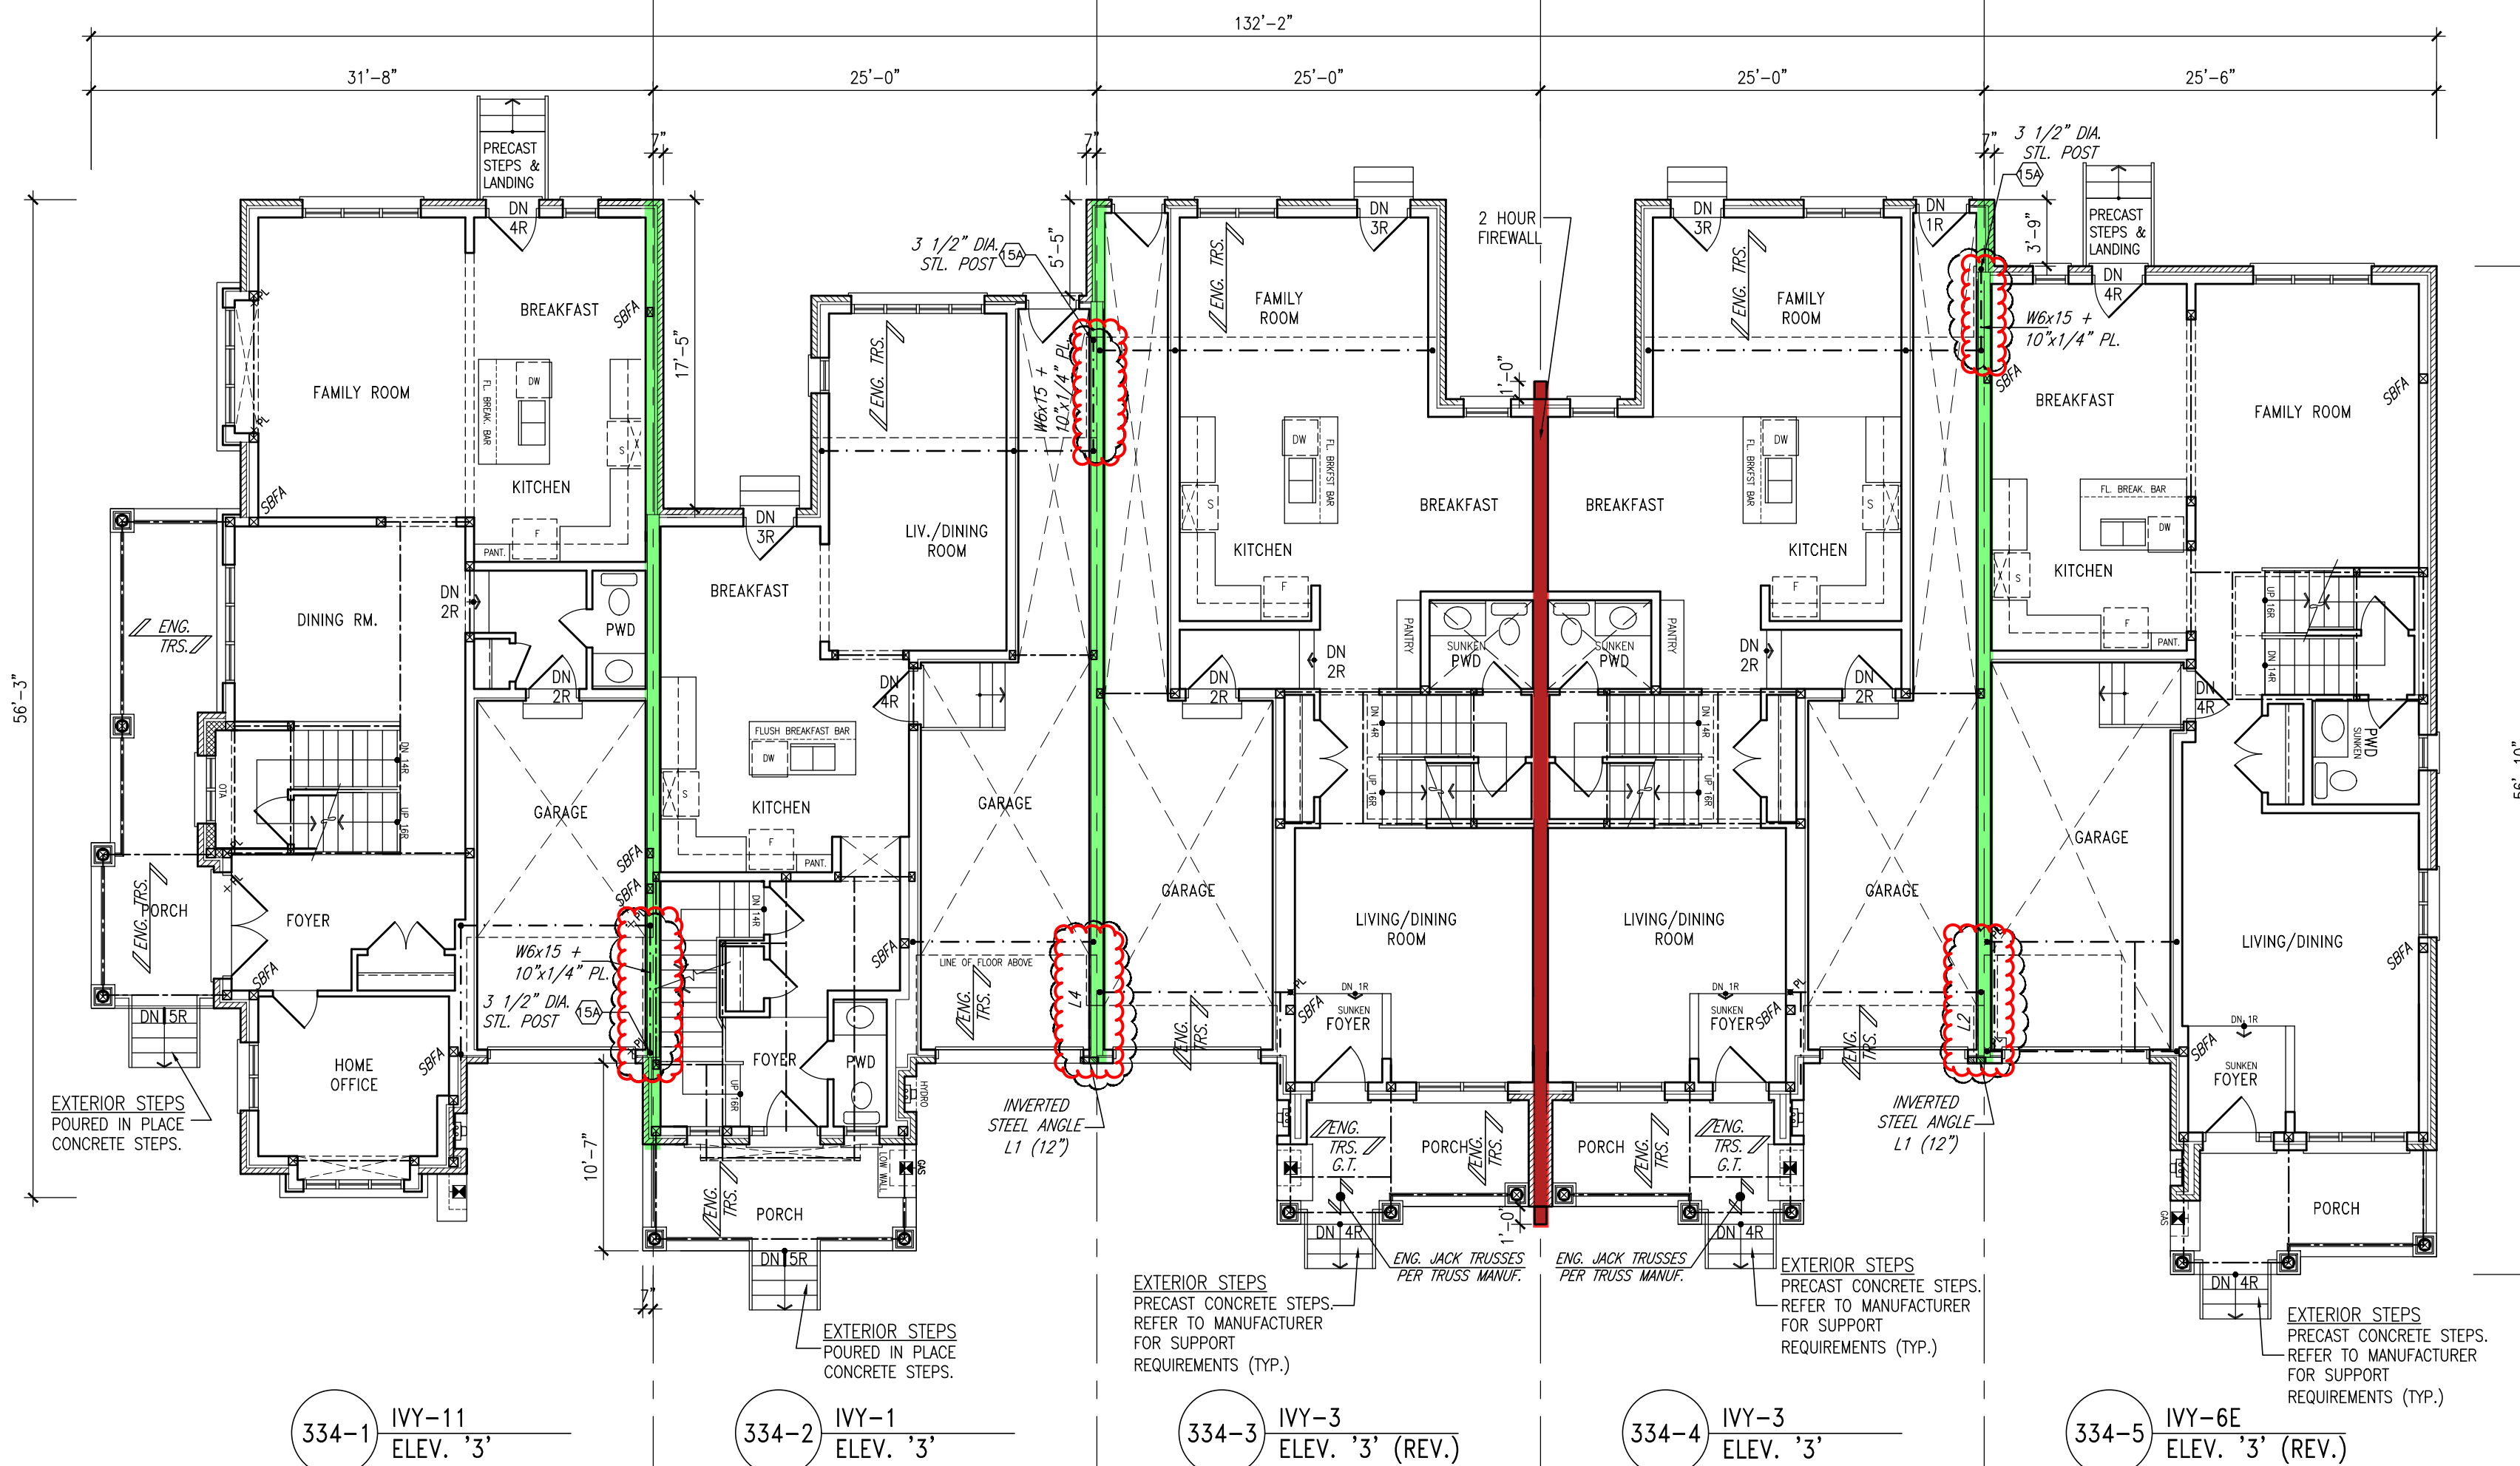


GROUND FLOOR PLAN

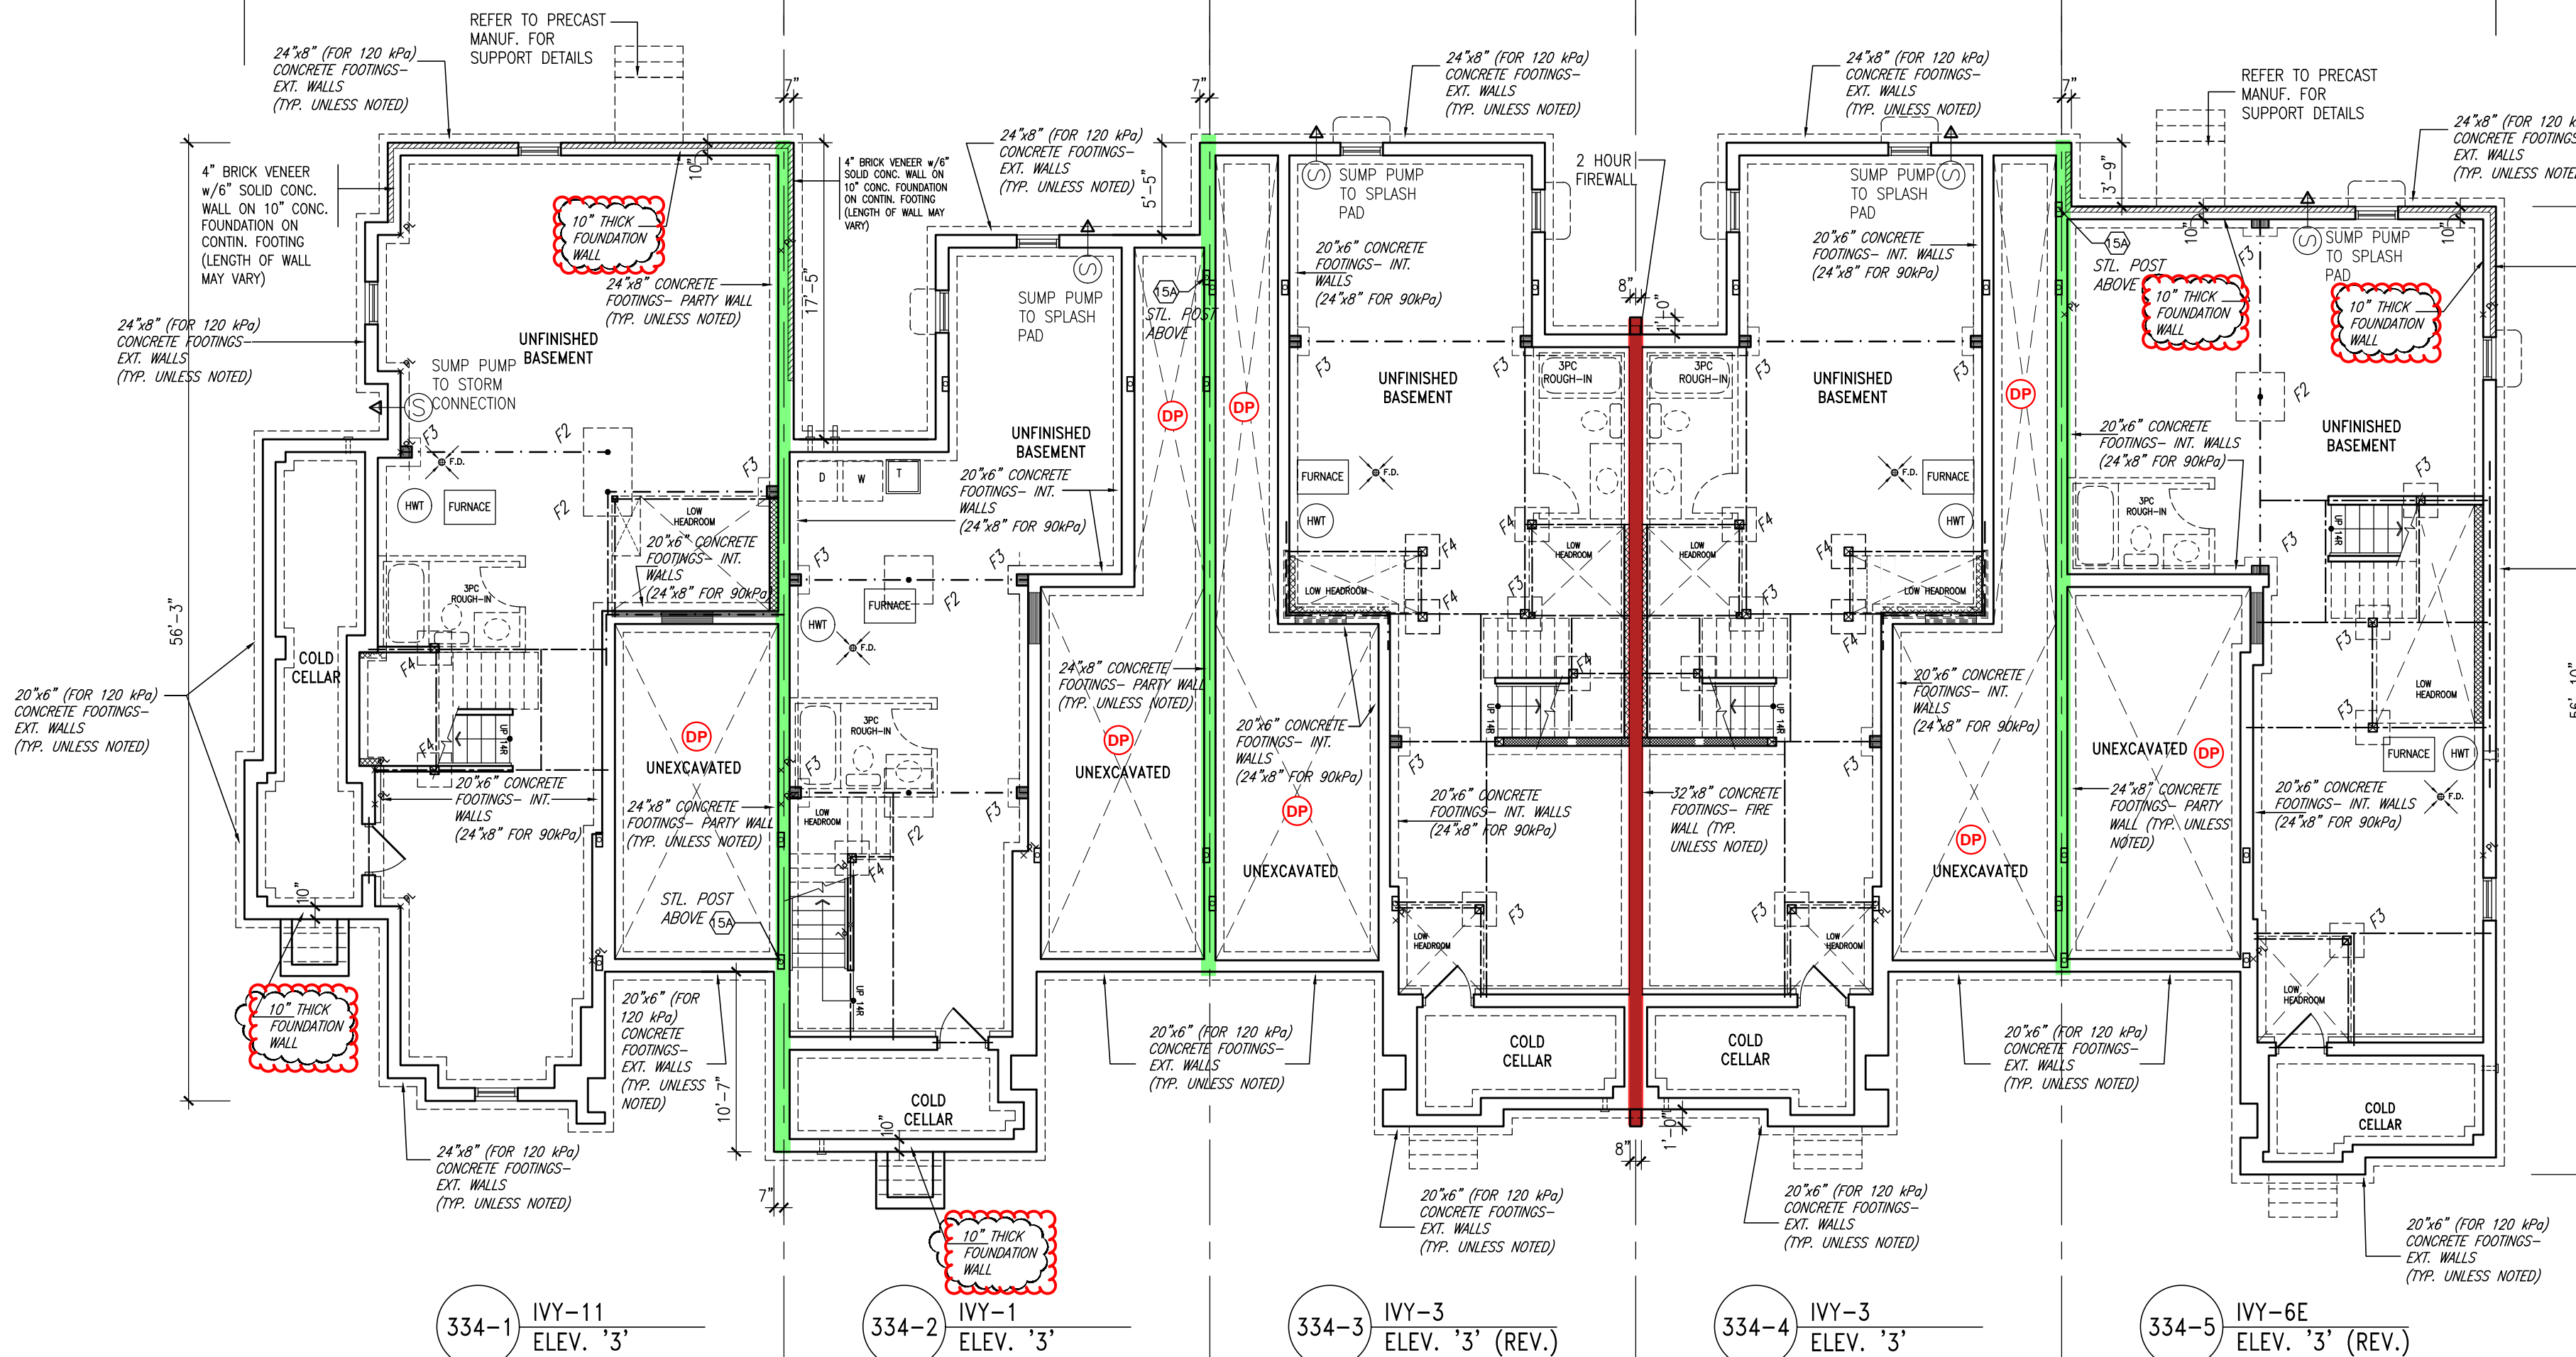


BASEMENT PLAN


NOTE:
REVISION CLOUD INDICATES
CONDITION THAT DIFFERS FROM
STANDARD UNIT

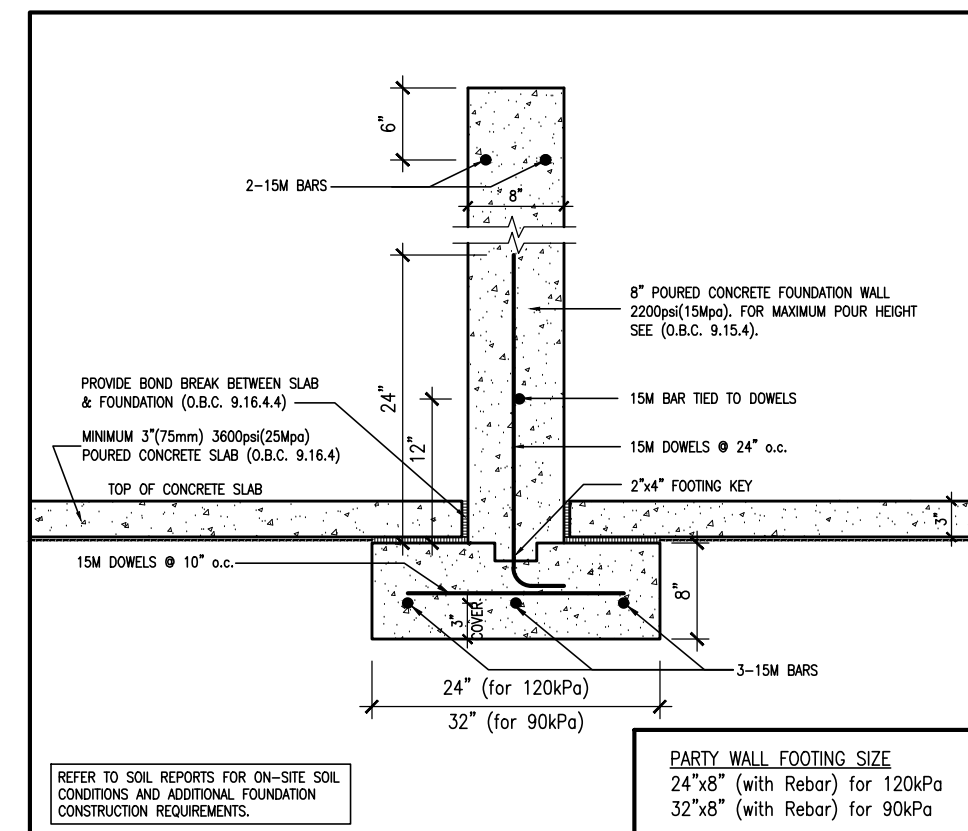

W2a TYPICAL PARTY WALL FOOTING

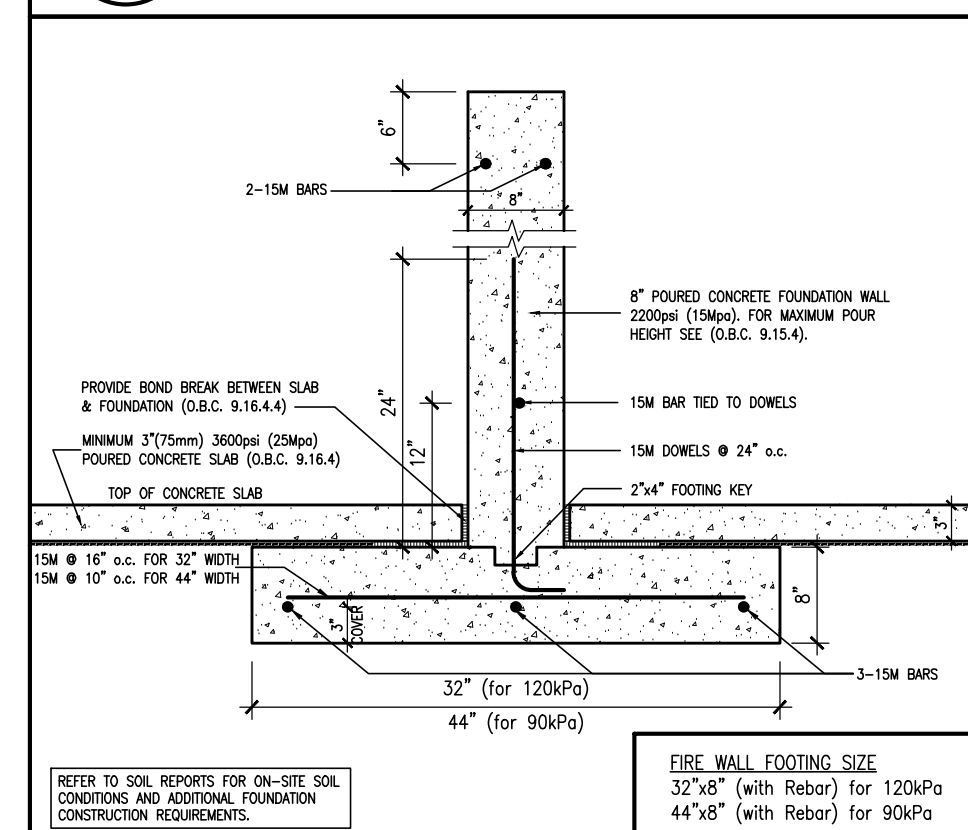

W2b TYPICAL FIRE WALL FOOTING

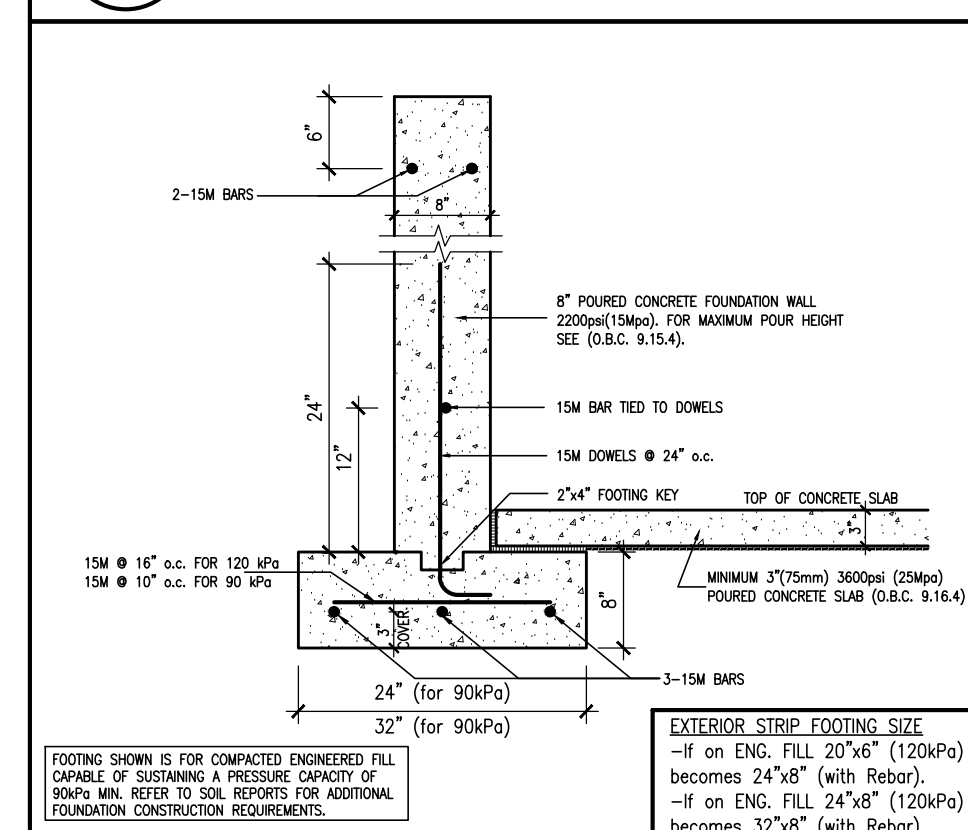

W2c EXTERIOR STRIP FOOTING

FOUNDATION DAMPROOFING
DRAINAGE AND WEeping TILE
TO BE INSTALLED ON FOUNDATION WALLS
SEPARATING BASEMENT SPACE FROM
UNEXCAVATED AREAS (UNDER PORCHES AND
ATTACHED GARAGE SLABS)

NOTE:
REFER TO GRADING PLAN
FOR NUMBER OF STEPS.



BLOCK 334
ELEVATION 3

BUILDING AREA
6493.40 S.F. (603.25 m²)

PAD FOOTINGS
120 KPa. NATIVE SOIL
F1 = 42"x42"x18" CONCRETE PAD
F2 = 36"x36"x18" CONCRETE PAD
F3 = 30"x30"x12" CONCRETE PAD
F4 = 24"x24"x12" CONCRETE PAD
F5 = 16"x16"x8" CONCRETE PAD
90 KPa. ENGINEERED FILL SOIL
F1 = 48"x48"x20" CONCRETE PAD
F2 = 40"x40"x16" CONCRETE PAD
F3 = 34"x34"x14" CONCRETE PAD
F4 = 28"x28"x12" CONCRETE PAD
F5 = 18"x18"x8" CONCRETE PAD
(REFER TO FLOOR PLAN FOR UNUSUAL SIZE PADS NOT ON CHART.)

STRIP FOOTINGS - FOR 2 STOREY TOWNHOUSES

FOOTINGS ON NATIVE SOIL (120 KPa.)
24"x8" CONCRETE STRIP FOOTINGS AS NOTED ON PLAN
24"x8" CONCRETE STRIP FOOTINGS BELOW EXTERIOR WALLS (UNLESS OTHERWISE NOTED).
24"x8" CONCRETE STRIP FOOTINGS (with REIN.) BELOW PARTY WALLS.
32"x8" CONCRETE STRIP FOOTINGS (with REIN.) BELOW FIRE WALLS.

FOOTINGS ON ENGINEERED FILL (90 KPa.)
24"x8" CONCRETE STRIP FOOTINGS WITH REINFORCEMENT, AS NOTED ON PLAN
32"x8" CONCRETE STRIP FOOTINGS BELOW EXTERIOR WALLS WITH REINFORCEMENT (UNLESS OTHERWISE NOTED).
32"x8" CONCRETE STRIP FOOTINGS WITH REINFORCEMENT BELOW PARTY WALLS.
44"x8" CONCRETE STRIP FOOTINGS WITH REINFORCEMENT BELOW FIRE WALLS. (REFER TO FOOTING DETAIL FOR REINFORCEMENT)

ASSUME 120KPa/17.4kgf/sq. SOIL BEARING CAPACITY FOR NATIVE SOIL OR 90KPa/13.0kgf/sq. FOR ENGINEERED FILL.
SOIL BEARING TO BE VERIFIED ON-SITE BY SOILS ENGINEER.

VENEER CUT
WHEN VENEER CUT IS GREATER
THAN 26", A 10" POURED
CONCRETE FOUNDATION WALL IS
REQUIRED.

REFER TO INDIVIDUAL UNITS
FOR THE FOLLOWING

- GROUND FLOOR ROOF STRUCTURE
- BASEMENT AND GROUND FLOOR LINTELS
- GROUND FLOOR AND SECOND FLOOR STRUCTURE
- DOUBLE VOLUME WALL LOCATION AND DETAILS
- CONCRETE SLABS

NOTE:
ROOF TRUSSES AND
SECOND FLOOR LINTELS
SHOWN ON BLOCK PLANS

SOFFIT VENTING
NO SOFFIT VENTING AT ROOF
OVERLAP OF DEMISING LINE/
PARTY WALL.

← SUMP PUMP LOCATION

It is the builder's complete responsibility to ensure that the plans submitted for approval fully comply with the Architectural Guidelines and all applicable regulations and requirements including zoning provisions and any provisions in the subdivision agreement. The Contractor is not responsible in any way for overlooking or overlooking any building codes or building code or permit matter or that any house on the property shall be located on the lot.

This is to certify that these plans comply with the applicable Architectural Design Guidelines approved by the Town of Milton.

ARCHITECTURAL REVIEW & APPROVAL
MAR 20 2017
John G. Williams, Licensed Architect


VA3 DESIGN
255 Consumers Rd
Suite 120
Toronto, ON M2J 1R4
T 416.630.2255
F 416.630.4182
va3design.com

Greenpark.


LECCO RIDGE DEV. INC.
TOWN OF MILTON

IVY SERIES
BLOCK 334

SEPTEMBER 2016
drawn by
checked by
16015-BLOCK-334

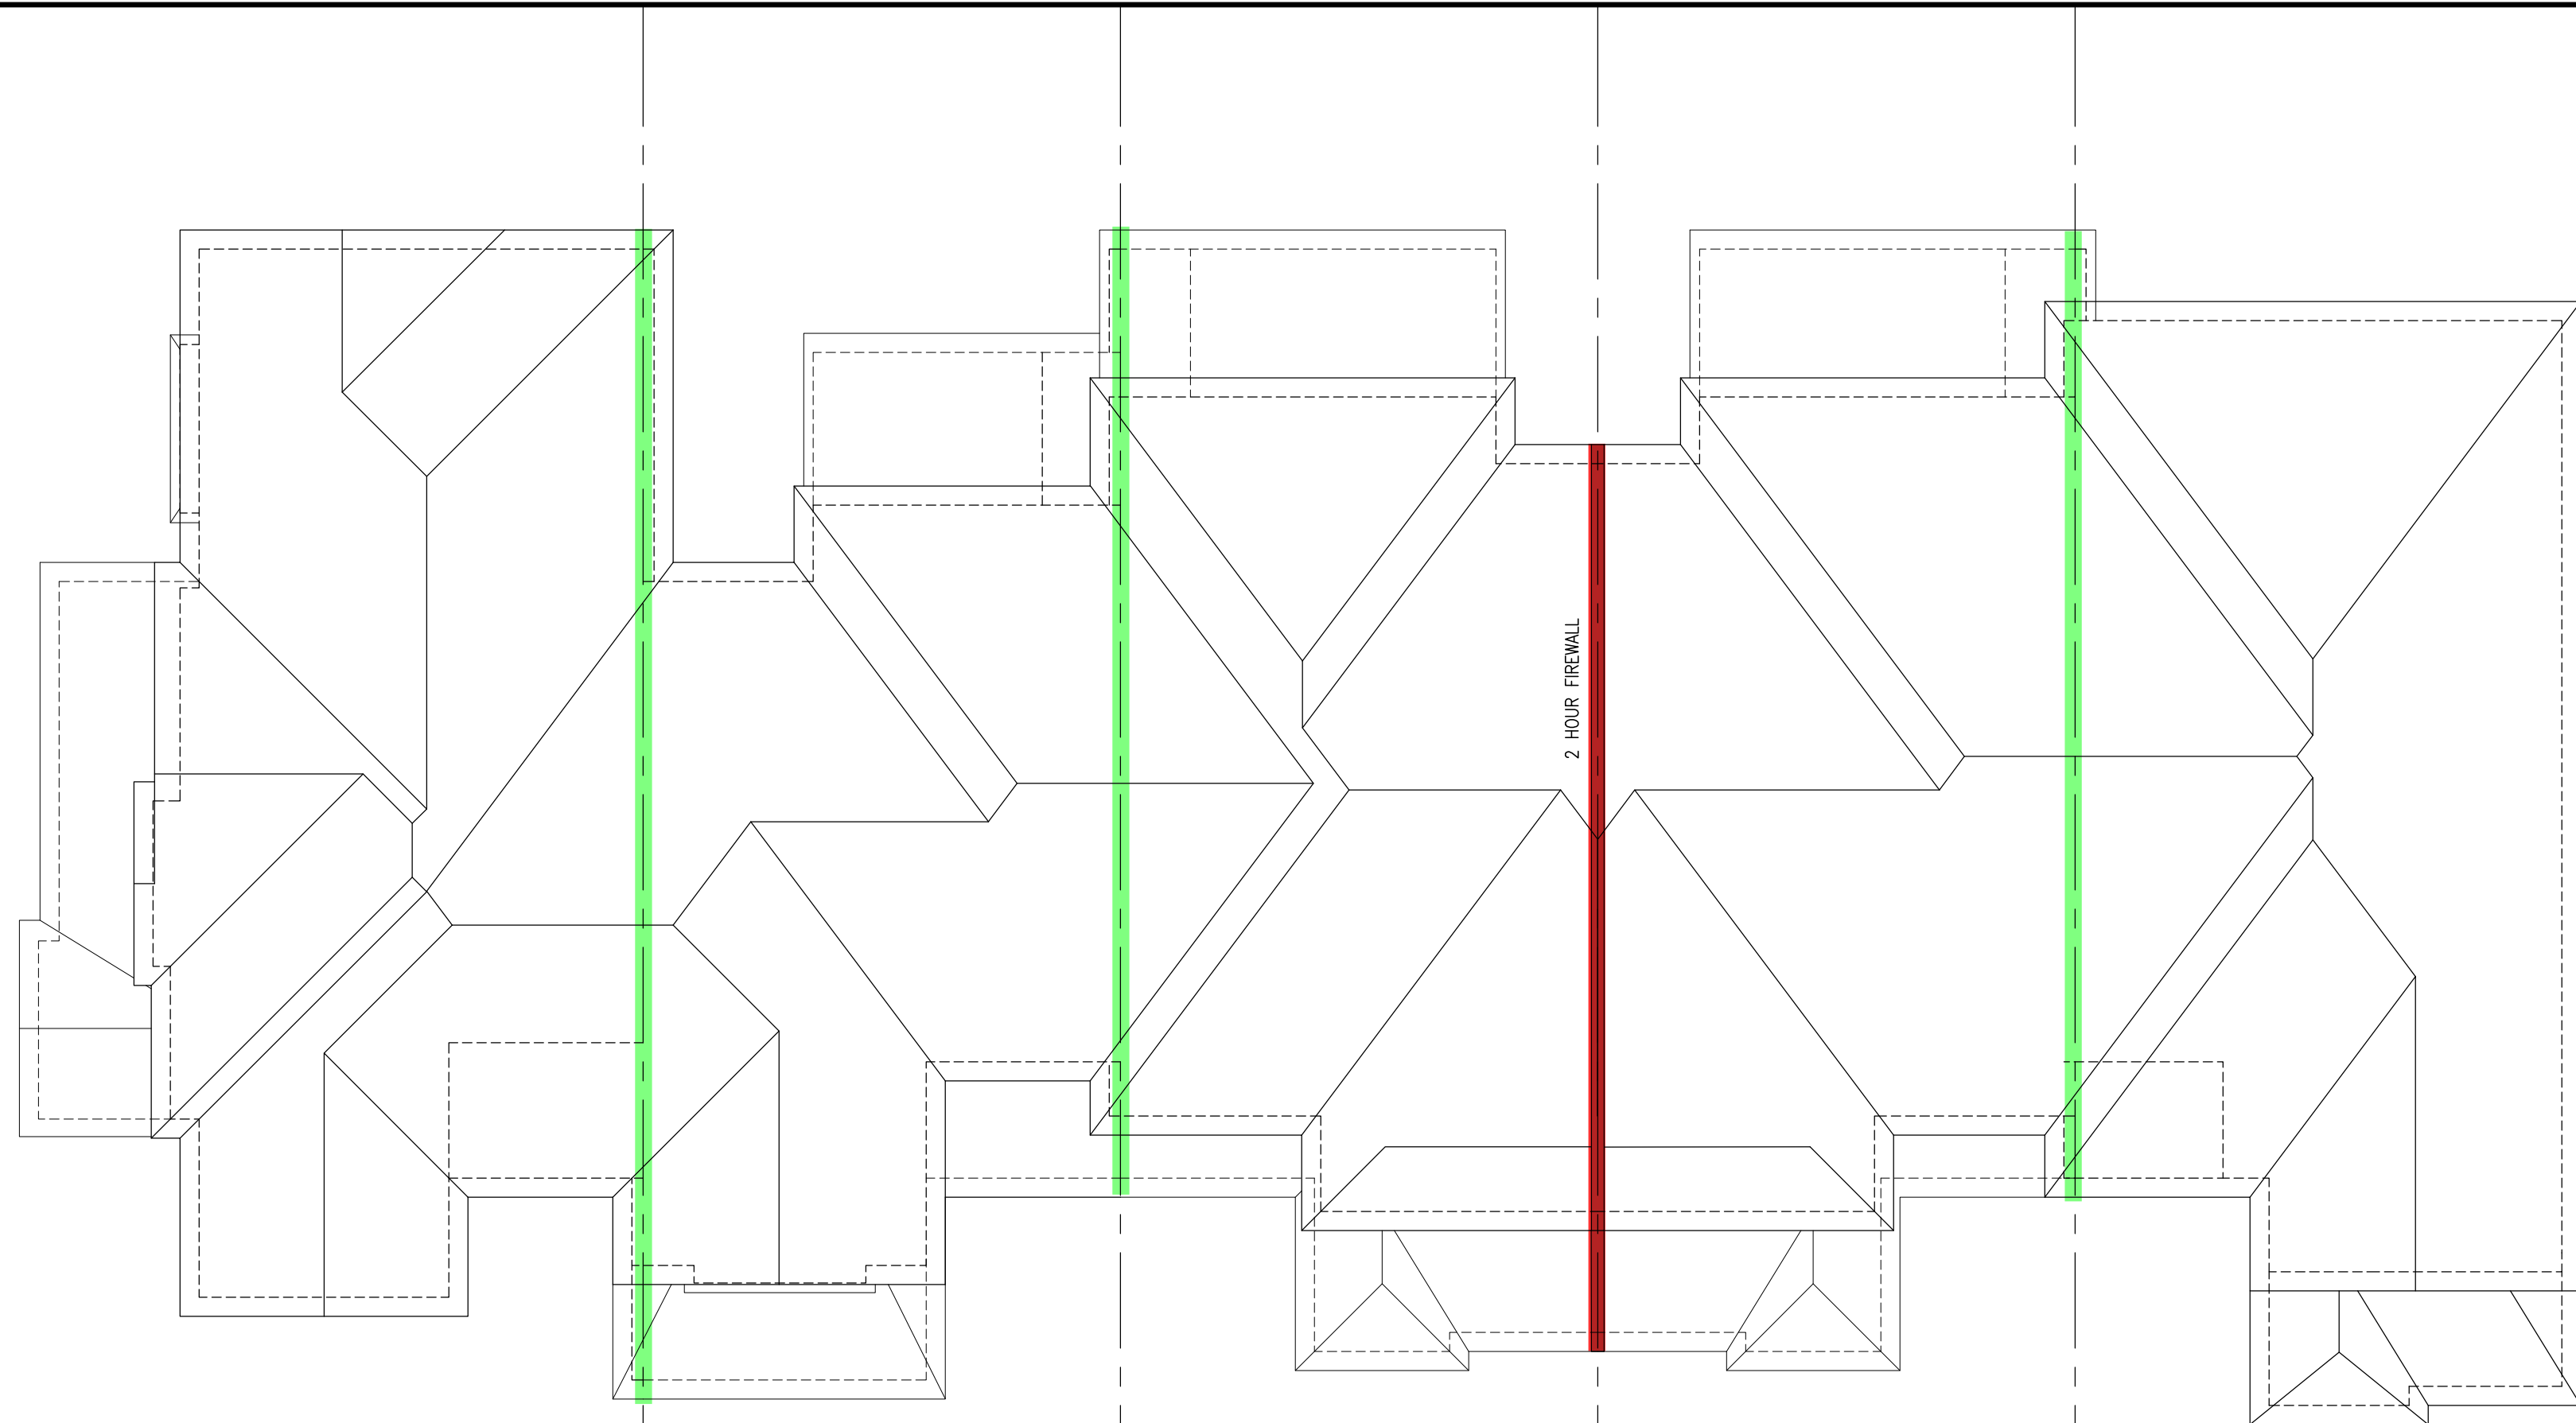

ROOF PLAN

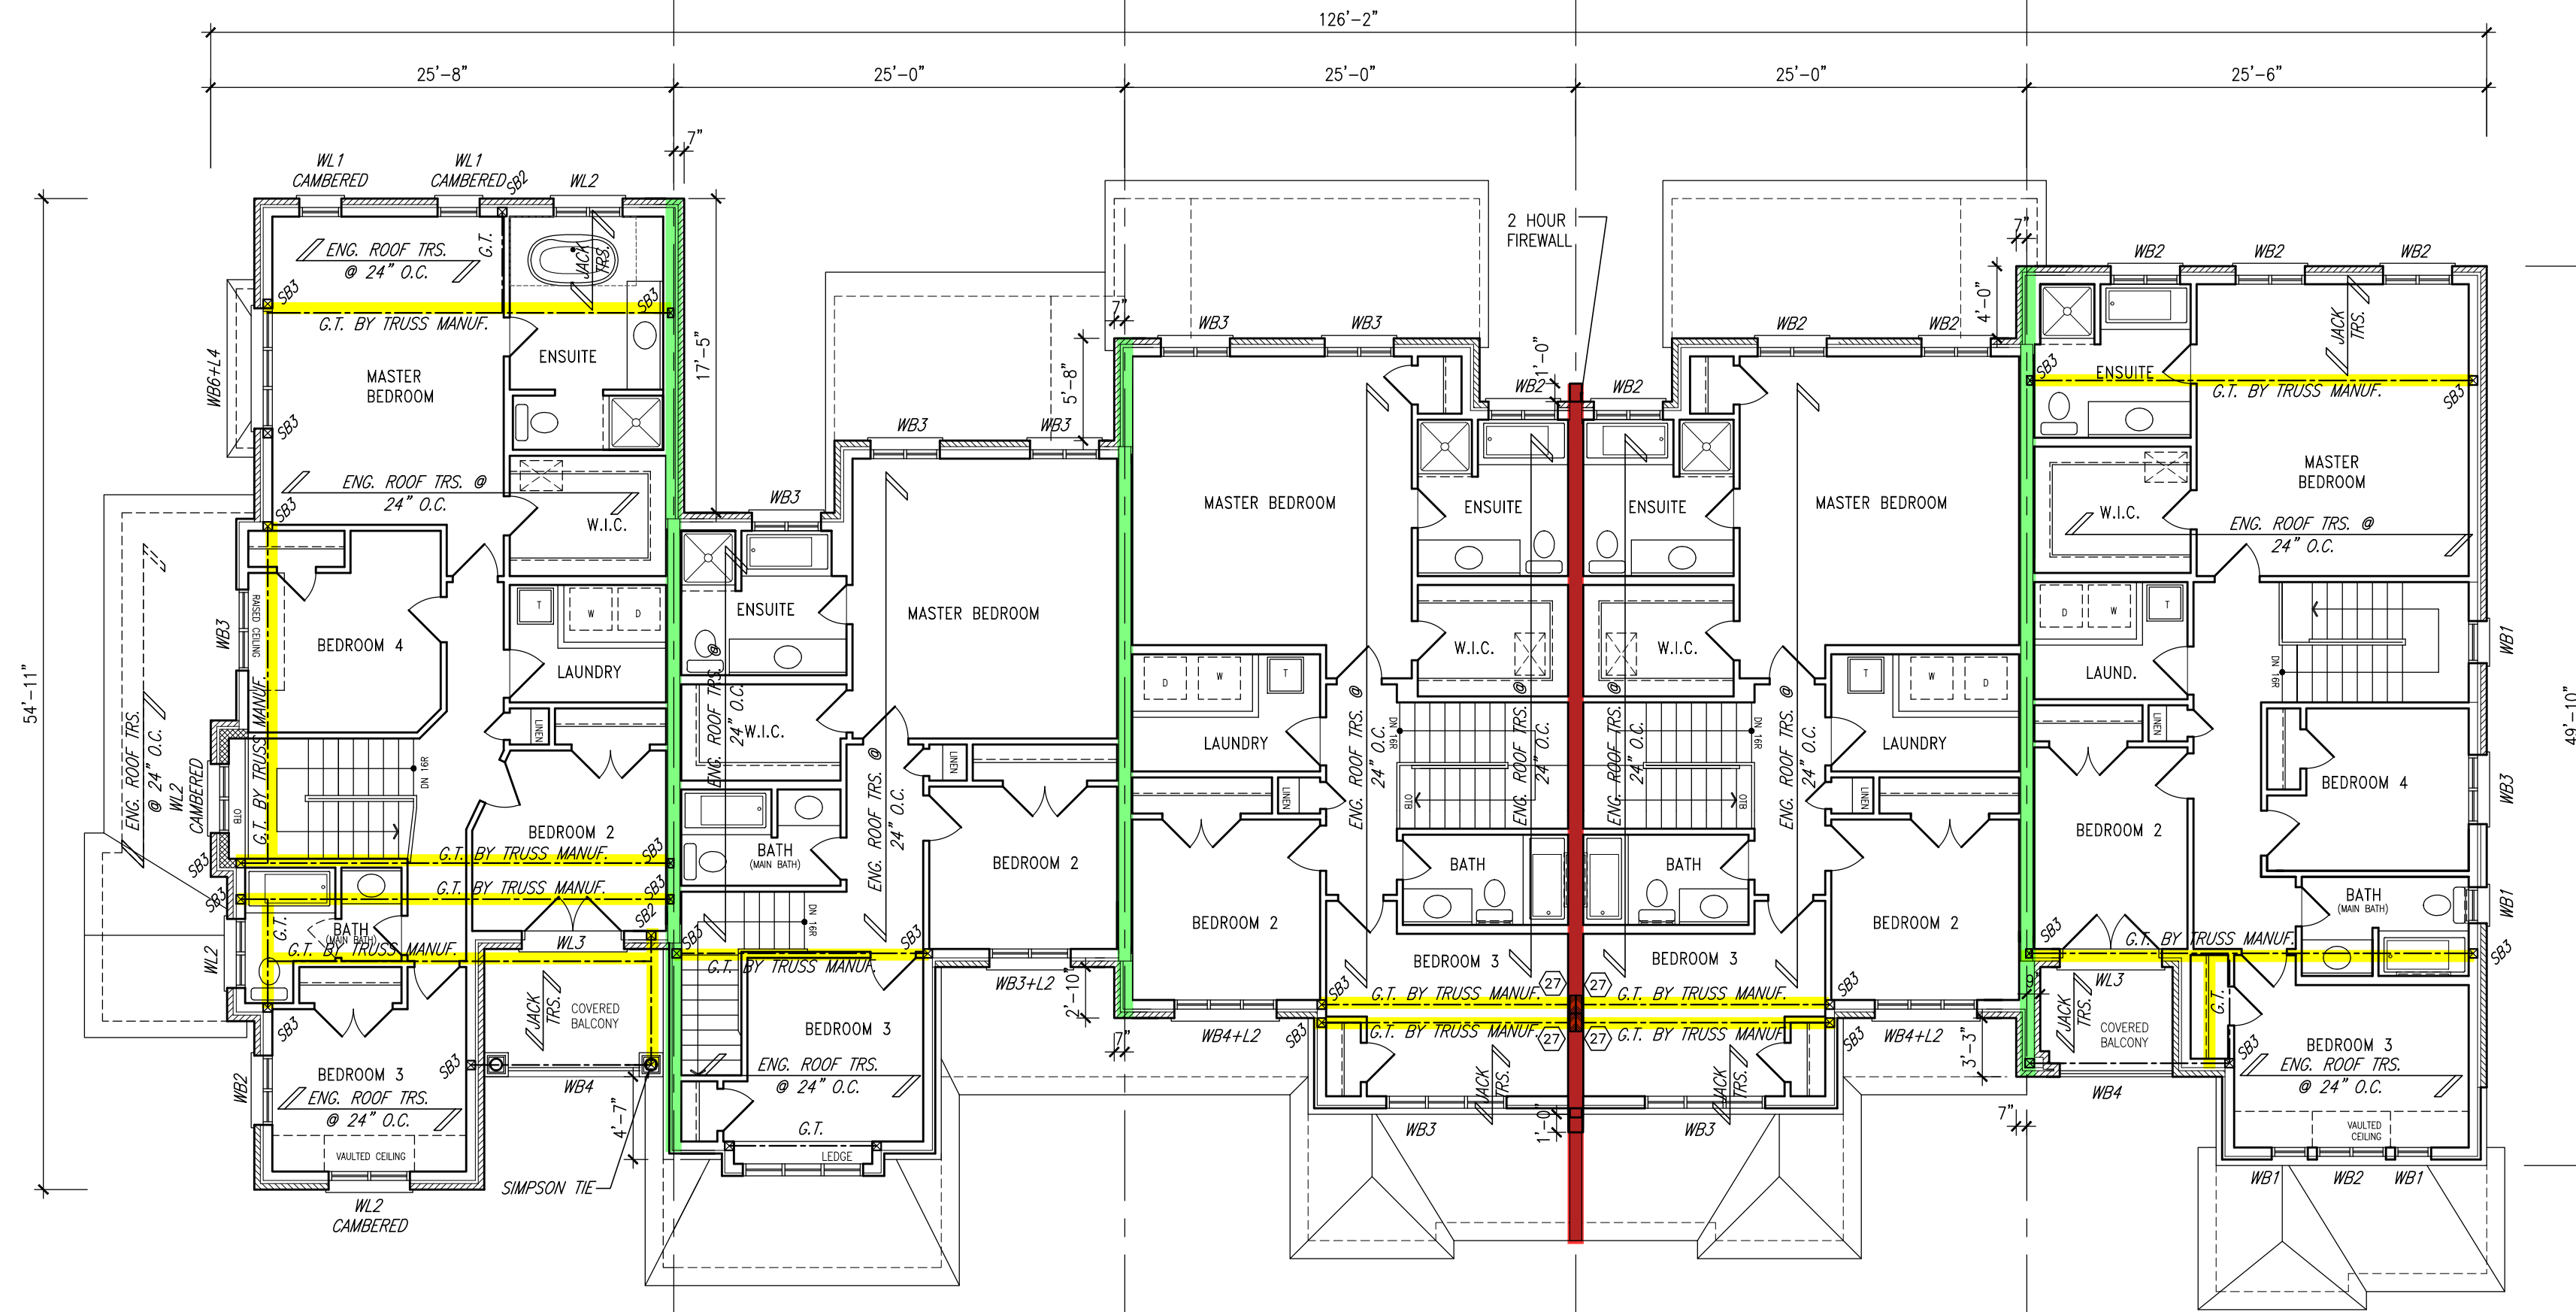

SECOND FLOOR PLAN

NOTE:
REVISION CLOUD INDICATES
CONDITION THAT DIFFERS FROM
STANDARD UNIT

TOWN OF MILTON
PLANNING AND DEVELOPMENT
BUILDING PERMIT-17-5181
SCOTT SHERIFFS APR 24, 2017
PLANS EXAMINER DATE
Neither the issuance of a permit nor carrying out of
inspections by the Town of Milton relieves the owner from
full responsibility for compliance with the provisions of
the Ontario Building Code Act and the Ontario Building
Code, both as amended, as well as other applicable
statutes and regulations of the Province of Ontario,
by-laws of the Region of Halton and Town of Milton.

RECEIVED
TOWN OF MILTON
MAR 29, 2017
17-5181
BUILDING DIVISION

TOWNHOUSE MODELS
Reviewed townhouse block drawings to be
read in conjunction with reviewed townhouse
model drawings and engineered truss system

GENERAL NOTES/CONSTRUCTION DETAILS
Reviewed model drawings to be read in
conjunction with reviewed general notes,
construction details and specifications

= 1 HOUR PARTY WALL
(FIRE SEPARATION)
PARTY WALL DETAILS
See standard details page 4
for standard party wall
construction details

= 2 HOUR FIREWALL
(NON-COMBUSTIBLE)
FIREWALL DETAILS
See standard details page 5
for standard firewall
construction details



**BLOCK 334
ELEVATION 3**

PAD FOOTINGS
120 KPa, NATIVE SOIL 90 KPa, ENGINEERED FILL SOIL
F1 = 42"x42"x18" CONCRETE PAD F1 = 48"x48"x20" CONCRETE PAD
F2 = 36"x36"x16" CONCRETE PAD F2 = 40"x40"x16" CONCRETE PAD
F3 = 30"x30"x12" CONCRETE PAD F3 = 34"x34"x14" CONCRETE PAD
F4 = 24"x24"x12" CONCRETE PAD F4 = 28"x28"x12" CONCRETE PAD
F5 = 16"x16"x8" CONCRETE PAD F5 = 18"x18"x8" CONCRETE PAD
(REFER TO FLOOR PLAN FOR UNUSUAL SIZE PADS NOT ON CHART.)

STRIP FOOTINGS - FOR 2 STOREY TOWNHOUSES

FOOTINGS ON NATIVE SOIL (120 KPa.)
20"x6" CONCRETE STRIP FOOTINGS AS NOTED ON PLAN
24"x6" CONCRETE STRIP FOOTINGS BELOW EXTERIOR WALLS (UNLESS
OTHERWISE NOTED).
24"x6" CONCRETE STRIP FOOTINGS (with REIN.) BELOW PARTY WALLS.
32"x6" CONCRETE STRIP FOOTINGS (with REIN.) BELOW FIRE WALLS.

FOOTINGS ON ENGINEERED FILL (90 KPa.)
24"x6" CONCRETE STRIP FOOTINGS WITH REINFORCEMENT, AS NOTED ON PLAN
32"x6" CONCRETE STRIP FOOTINGS BELOW EXTERIOR WALLS WITH
REINFORCEMENT (UNLESS OTHERWISE NOTED).
32"x6" CONCRETE STRIP FOOTINGS WITH REINFORCEMENT BELOW PARTY WALLS.
44"x6" CONCRETE STRIP FOOTINGS WITH REINFORCEMENT BELOW FIRE WALLS.
(REFER TO FOOTING DETAIL FOR REINFORCEMENT)

ASSUME 120KPa/17.4qsf SOIL BEARING CAPACITY FOR NATIVE SOIL
OR 90KPa/ 13.0qsf FOR ENGINEERED FILL
SOIL BEARING TO BE VERIFIED ON-SITE BY SOILS ENGINEER

VENEER CUT
WHEN VENEER CUT IS GREATER
THAN 26", A 10" POURED
CONCRETE FOUNDATION WALL IS
REQUIRED.

**REFER TO INDIVIDUAL UNITS
FOR THE FOLLOWING**

-GROUND FLOOR ROOF
STRUCTURE
-BASEMENT AND GROUND
FLOOR LINTELS
-GROUND FLOOR AND
SECOND FLOOR STRUCTURE
-DOUBLE VOLUME WALL
LOCATION AND DETAILS
-CONCRETE SLABS

NOTE:
ROOF TRUSSES AND
SECOND FLOOR LINTELS
SHOWN ON BLOCK PLANS

SOFFIT VENTING
NO SOFFIT VENTING AT ROOF
OVERLAP OF DEMISING LINE/
PARTY WALL.

It is the builder's complete responsibility to
ensure that all plans submitted for approval
fully comply with the Architectural Guidelines
and all applicable regulations and requirements
including zoning provisions and any provisions
in the subdivision agreement. The Contractor
Architect is not responsible in any way for
allowing or approving any building plans or
working drawings which do not conform to
building code or permit matter or that any
house can be properly built or located on its lot.

This is to certify that these plans comply
with the applicable Architectural Design
Guidelines approved by the Town of
MILTON.

ARCHITECTURAL REVIEW & APPROVAL
MAR 20 2017
John G. Williams Limited, Architect

10					
9					
8					
7					
6					
5	ISSUED FOR PERMIT	MAR 01/17	GM		
4	SUMP PUMP LOCATIONS ADDED	FEB 02/17	GM		
3	ISSUED FOR PRICING	JAN 17/17	GM		
2	REV. AS PER ENG. COMMENTS & TRUSS LAYOUTS	DEC 13/16	GM		
1	ISSUED FOR CLIENT REVIEW				
no	description	date	by		

Contractor must verify all dimensions on the job and report any discrepancy to the
Designer before proceeding with the work. All drawings and specifications are
instruments of service and the property of the architect which must be returned at
the completion of the work. Drawings are not to be scaled.

VAS DESIGN
255 Consumers Rd
Suite 120
Toronto ON M2J 1R4
t 416.630.2255
f 416.630.4182
vasdesign.com

All drawings, specifications, related
documents and design are the
copyright property of VAS DESIGN.
Reproduction of this property in
whole or in part is strictly
prohibited without VAS DESIGN's
written permission.

The contractor has reviewed and taken responsibility for the design
and for the specifications and made the requirements set out in the
contract. Building Code is to be followed.
signature
Richard Vink 24488
signature
VAS Design Inc. 42858

Greenpark.
PROJECT NAME
LECCO RIDGE DEV. INC.
PROJECT NO.
16015
TOWN OF MILTON
16015-BLOCK-334
IVY SERIES
**BLOCK 334
PLANS**
DATE
SEPTEMBER 2016
drawn by
BT
checked by
CW
scale
1/8" = 1'-0"
sheet no.
B2
total sheets
16015-BLOCK-334

NOTE:
REVISION CLOUD INDICATES
CONDITION THAT DIFFERS FROM
STANDARD UNIT

TOWNHOUSE MODELS
Reviewed townhouse block drawings to be
read in conjunction with reviewed townhouse
model drawings and engineered truss system

GENERAL NOTES/CONSTRUCTION DETAILS
Reviewed model drawings to be read in
conjunction with reviewed general notes,
construction details and specifications

**TOWN OF MILTON
PLANNING AND DEVELOPMENT
BUILDING REVIEWED
SCOTT SHERRIFFS**
APR 24, 2017
DATE
Whether the issuance of a permit or carrying out of
responsible by the Town of Milton relieves the owner from
all responsibility for compliance with the provisions of
the Ontario Building Code Act and the Ontario Building
Code, both as amended, as well as other applicable
laws and regulations of the Province of Ontario,
By-laws of the Region of Halton and Town of Milton

**RECEIVED
TOWN OF MILTON
MAR 29, 2017
17-5181
BUILDING DIVISION**



334-5 IVY-6E
ELEV. '3' (REV.)

RIGHT SIDE ELEVATION

334-5 IVY-6E
ELEV. '3' (REV.)

REAR ELEVATION

334-4 IVY-3
ELEV. '3'


334-3 IVY-3
ELEV. '3' (REV.)

334-2 IVY-1
ELEV. '3'

334-1 IVY-11
ELEV. '3'

1 HOUR PARTY WALL
(FIRE SEPARATION)
See standard details page 4
for standard party wall
construction details

2 HOUR FIREWALL
(NON-COMBUSTIBLE)
See standard details page 5
for standard firewall
construction details

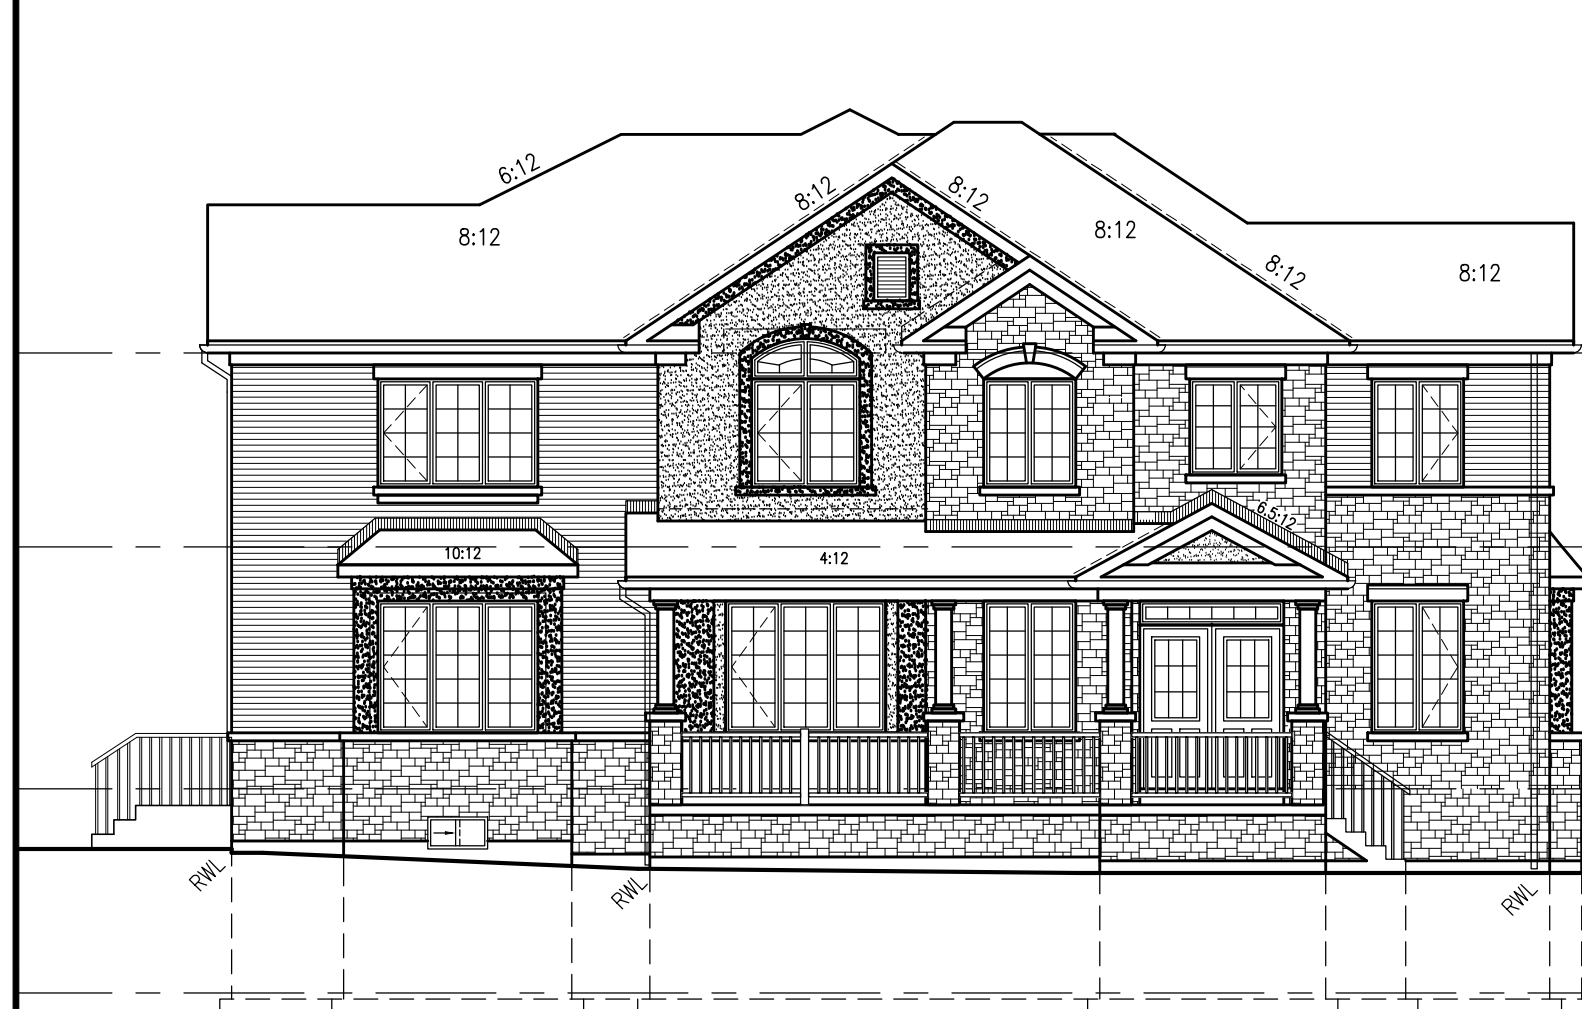

334-1 IVY-11
ELEV. '3'

LEFT SIDE ELEVATION



334-1 IVY-11
ELEV. '3'

FRONT ELEVATION

334-2 IVY-1
ELEV. '3'

334-3 IVY-3
ELEV. '3' (REV.)

334-4 IVY-3
ELEV. '3'

334-5 IVY-6E
ELEV. '3' (REV.)

GUARDS/MANDRAILS
Shall be provided on
porches as required
based on final lot grading

It is the builder's complete responsibility to
ensure that all plans submitted for approval
fully comply with the Architectural Guidelines
and all applicable regulations and requirements,
including zoning provisions and any provisions
in the subdivision agreement. The Contractor
Architect is not responsible in any way for
allowing or approving any building plans or
working drawings that are in any way in
violation of the Building Code or any other
building code or permit matter or that any
house on the property built or located on its lot.

This is to certify that these plans comply
with the applicable Architectural Design
Guidelines approved by the Town of
MILTON.

ARCHITECTURAL REVIEW & APPROVAL
MAR 20 2017
John G. Williams, Licensed Architect

no.	description	date	by
1	ISSUED FOR PERMIT	MAR 01/17	CM
2	SUMP PUMP LOCATIONS ADDED	FEB 02/17	CM
3	ISSUED FOR PERMIT	JAN 17/17	CM
4	REV. AS FOR ENG. COMMENTS & TRUSS LAYOUTS	DEC 13/16	CM
5	ISSUED FOR CLIENT REVIEW		

Contractor must verify all dimensions on the job and report any discrepancy to the
Designer before proceeding with the work. All drawings and specifications are
instruments of service and the property of the architect which must be returned at
the completion of the work. Drawings are not to be scaled.

VAS DESIGN
255 Consumers Rd
Suite 120
Toronto, ON M2J 1R4
t 416.630.2255
f 416.630.4782
vasdesign.com

All drawings, specifications, related
documents and design are the
copyright property of VAS DESIGN.
Reproduction of this property in
whole or in part is strictly
prohibited without VAS DESIGN's
written permission.

The architect has reviewed and taken responsibility for this design.
and for the qualifications and means the requirements are set in the
Ontario Building Code to be a "complete"
qualification to provide
Richard Vink
signature
24488
CM
42858

Greenpark.

PROJECT NAME
LECCO RIDGE DEV. INC.

PROJECT NO.
16015

TOWN OF MILTON

IVY SERIES

BLOCK 334

ELEVATIONS

SEPTEMBER 2016

1/8" = 1'-0"

16015-BLOCK-334

B3

BLOCK 334
ELEVATION 3