



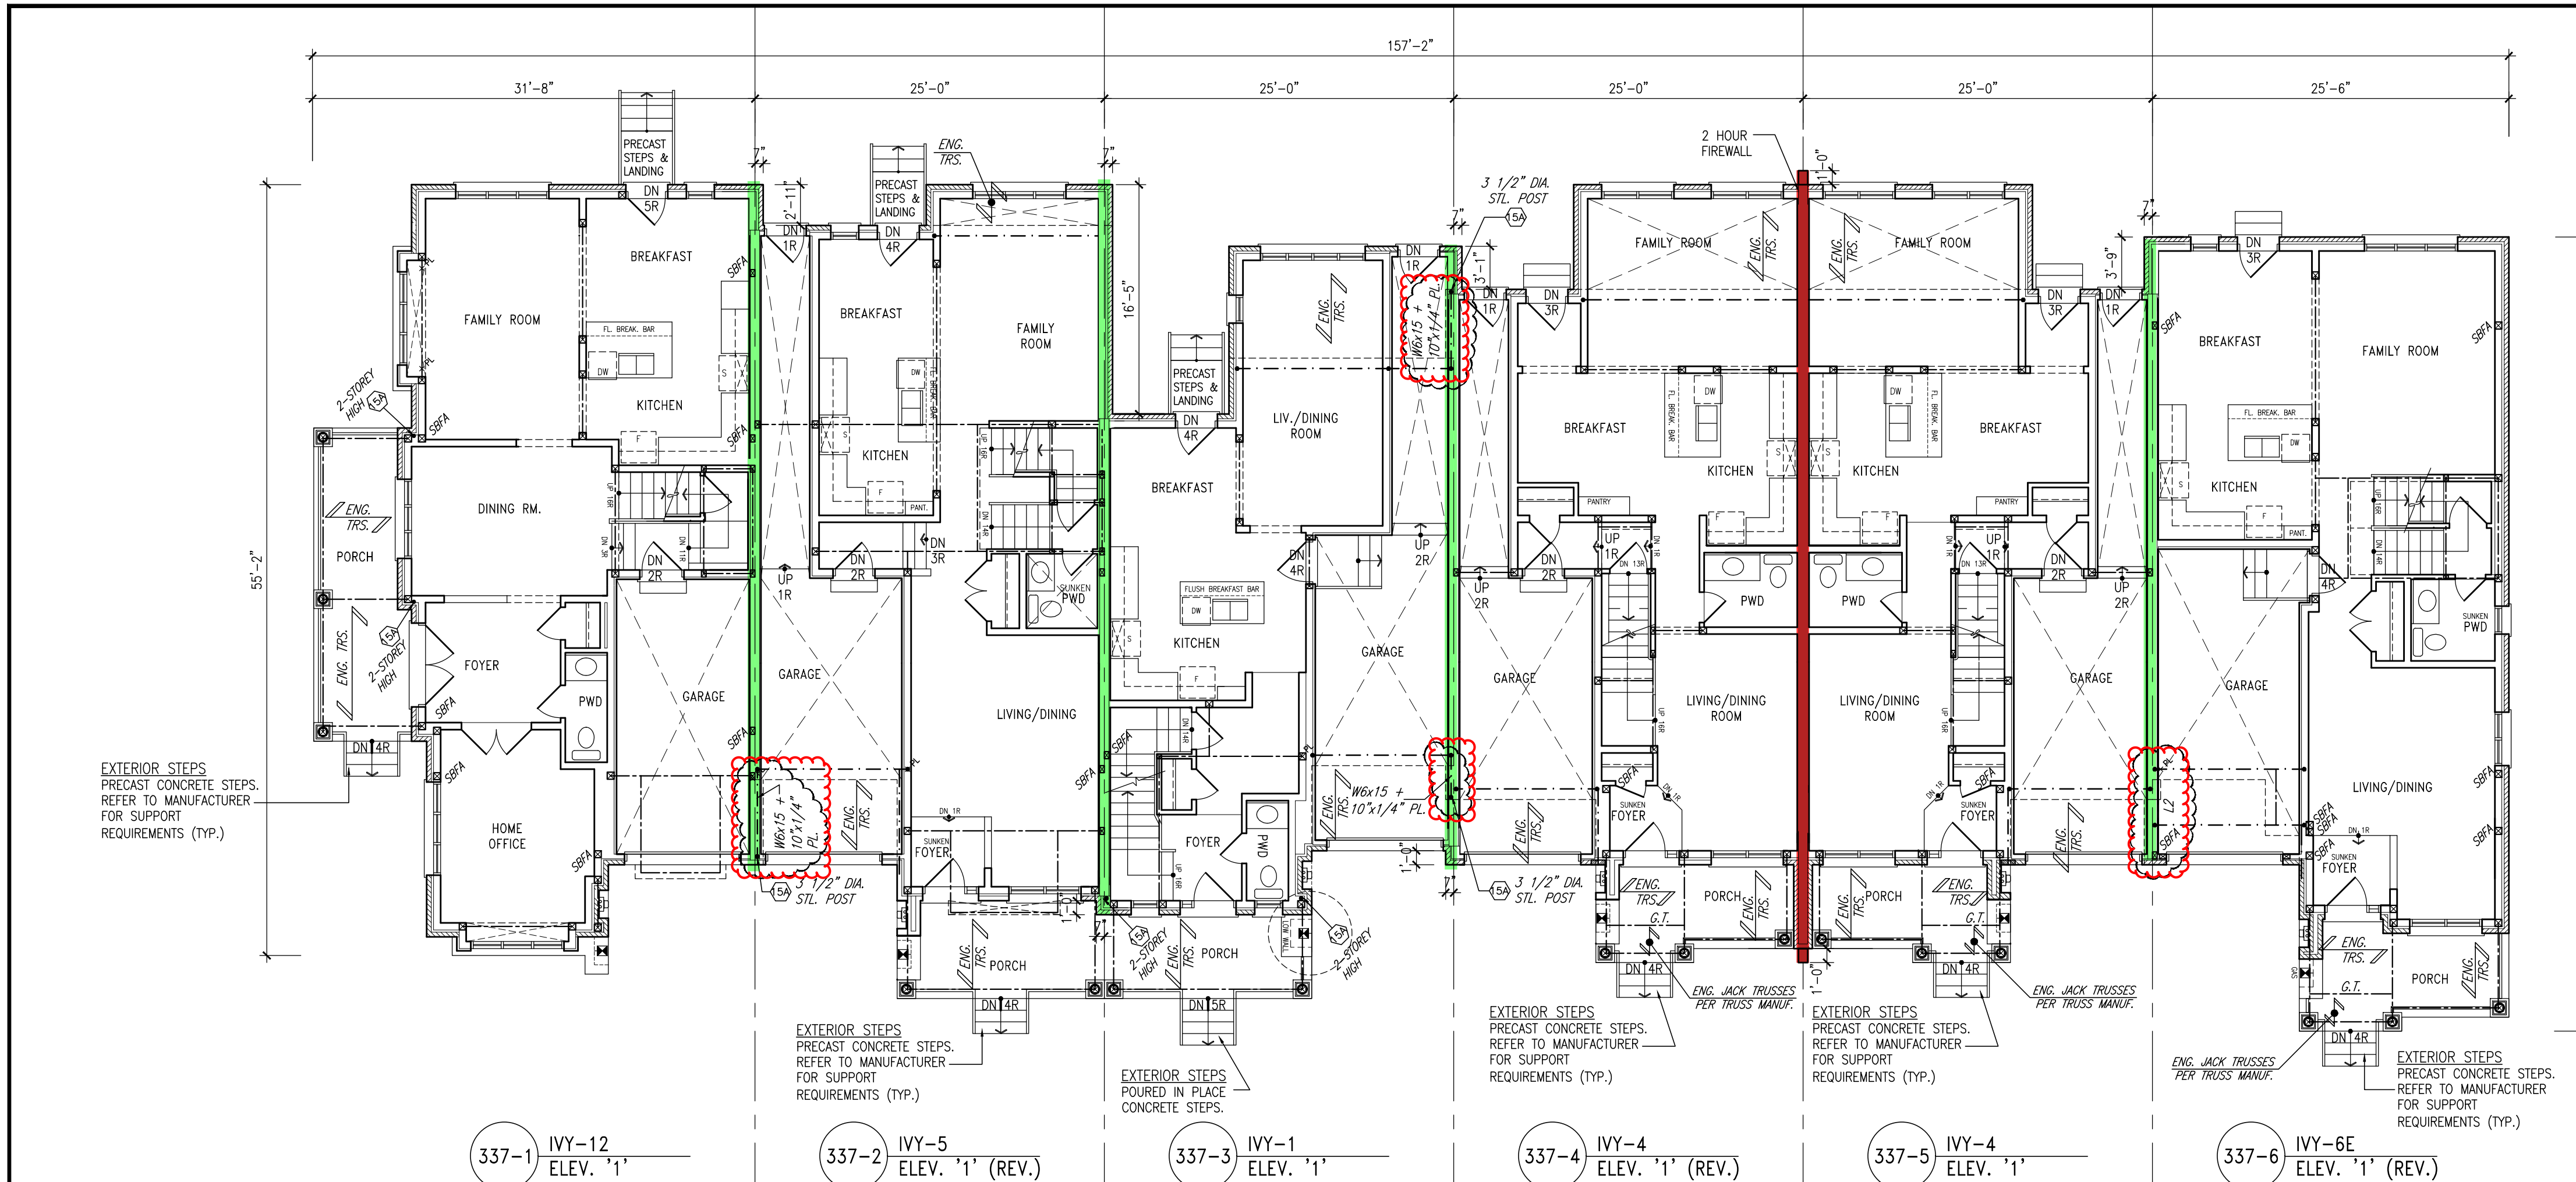


GROUND FLOOR PLAN

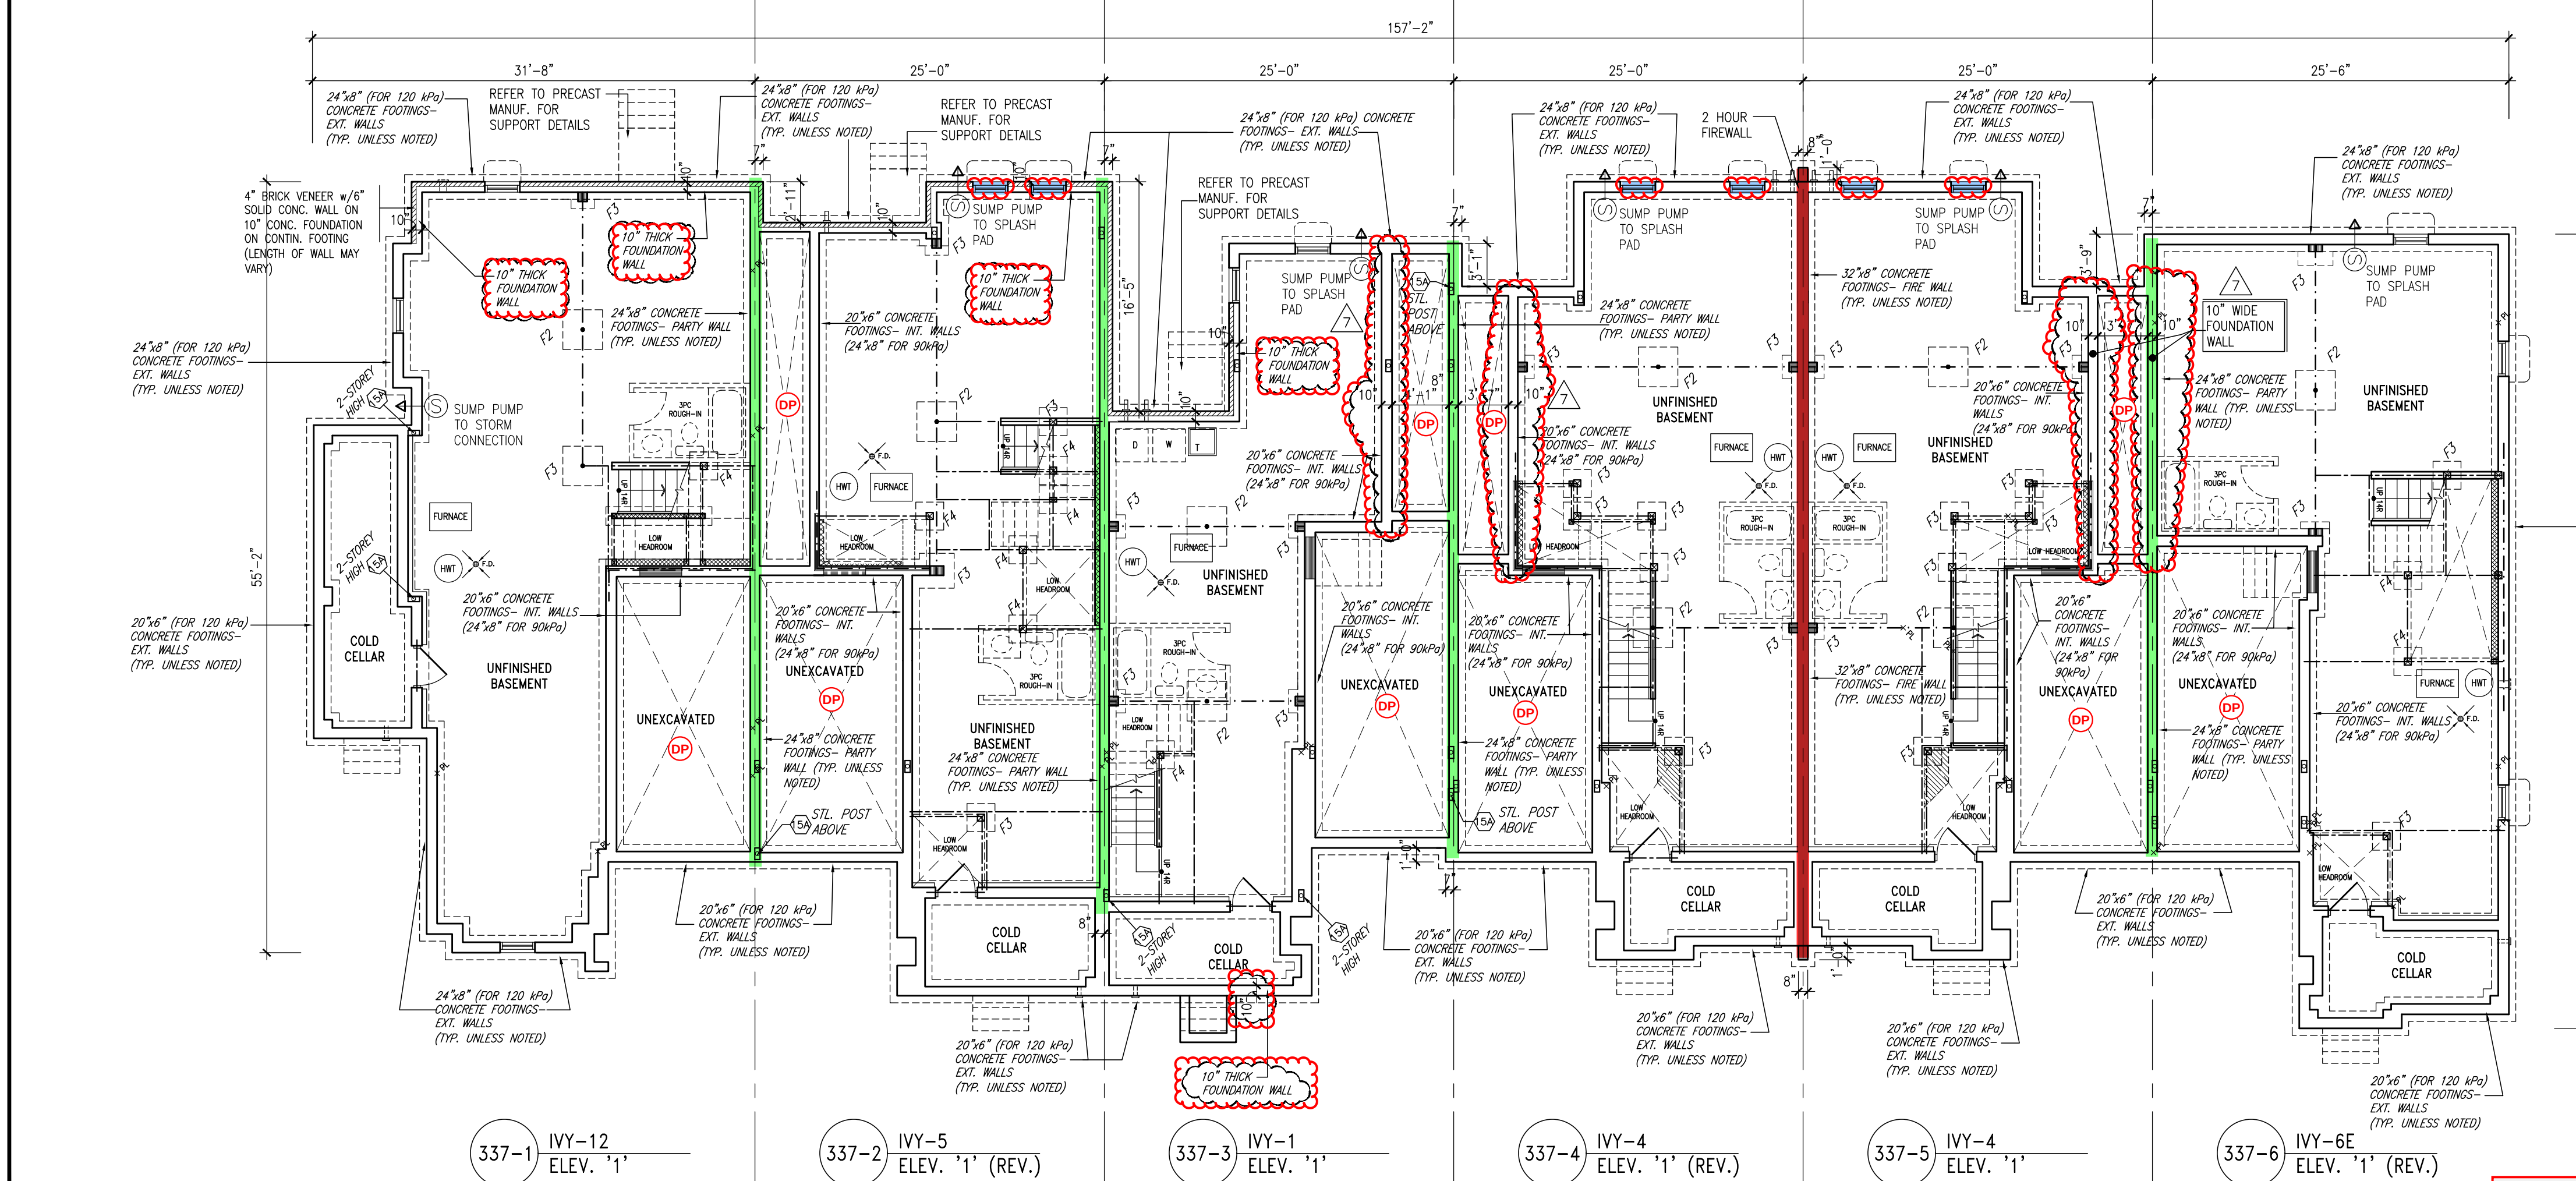


BASEMENT PLAN

NOTE:
REVISION CLOUD INDICATES
CONDITION THAT DIFFERS FROM
STANDARD UNIT

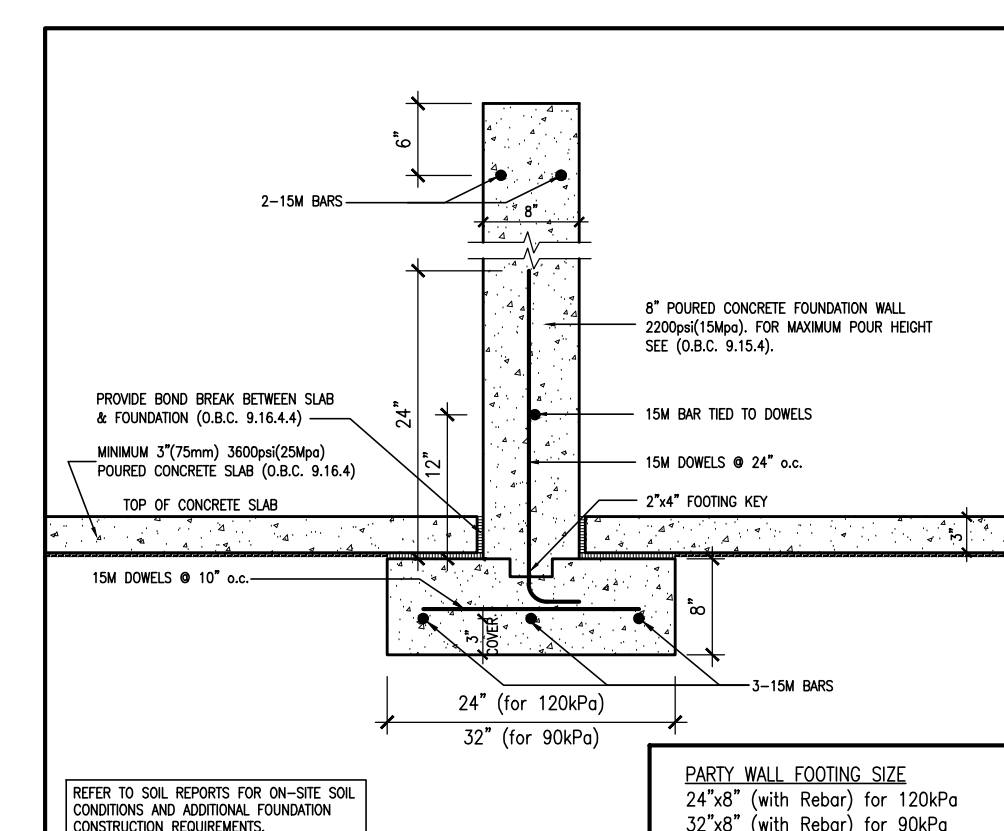


W2a TYPICAL PARTY WALL FOOTING

SCALE: Not to Scale

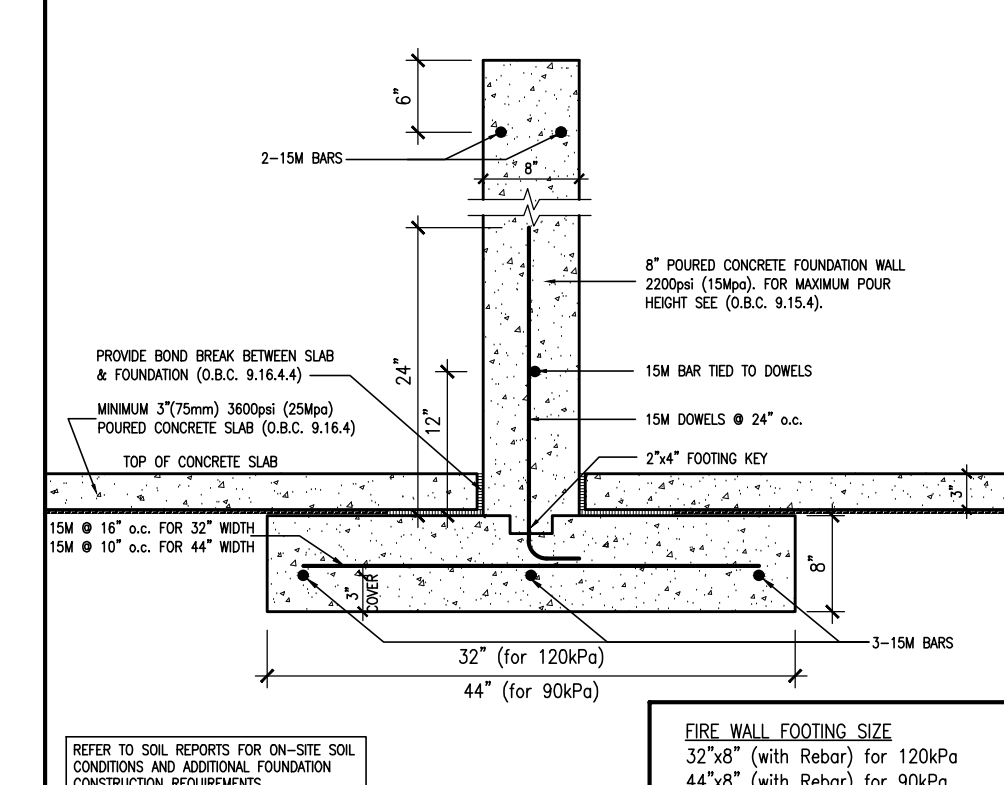

W2b TYPICAL FIRE WALL FOOTING

SCALE: Not to Scale

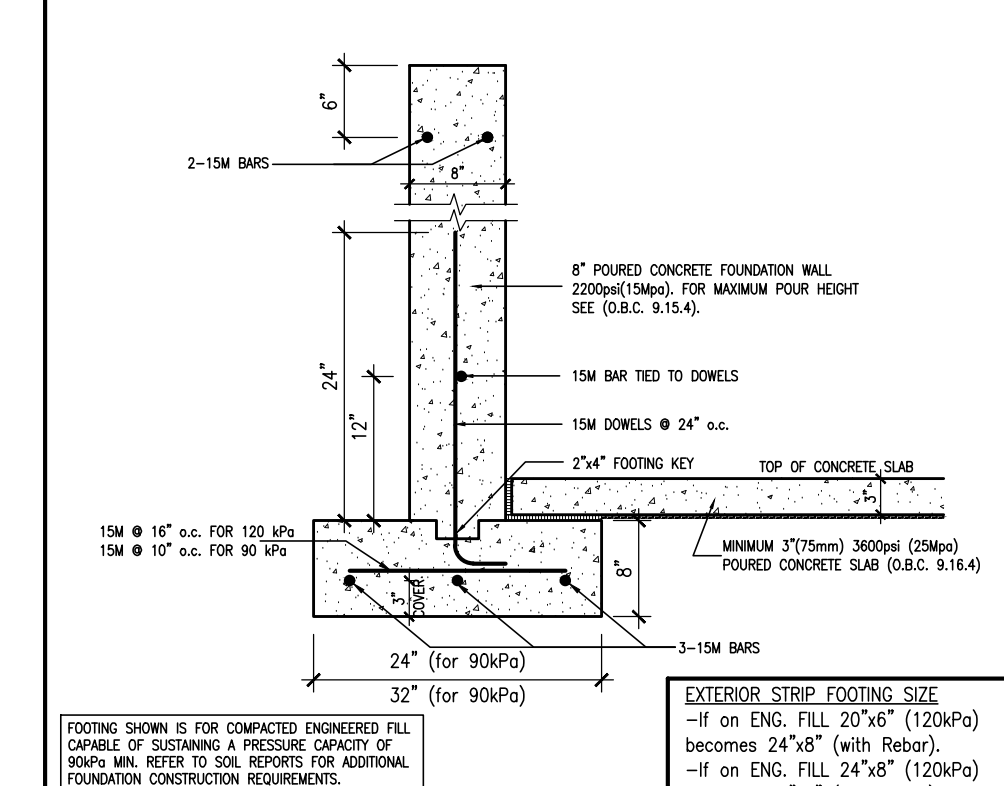

W2c EXTERIOR STRIP FOOTING

(On Engineered Fill) (90KPa. Minimum)

SCALE: Not to Scale

TOWNHOUSE MODELS
Reviewed townhouse block drawings to be read in conjunction with reviewed townhouse model drawings and engineered truss system

GENERAL NOTES/CONSTRUCTION DETAILS
General model drawings to be read in conjunction with reviewed general notes, construction details and specifications

NOTE:
REFER TO GRADING PLAN
FOR NUMBER OF STEPS.

RECEIVED
TOWN OF MILTON
BUILDING DIVISION
APR 24, 2017

RECEIVED
TOWN OF MILTON
BUILDING DIVISION
APR 24, 2017

BUILDING AREA
7725.01 S.F. (717.67 m²)

PAD FOOTINGS
120 KPa. NATIVE SOIL
F1 = 42"x42"x18" CONCRETE PAD
F2 = 36"x36"x18" CONCRETE PAD
F3 = 30"x30"x12" CONCRETE PAD
F4 = 24"x24"x12" CONCRETE PAD
F5 = 16"x16"x8" CONCRETE PAD
90 KPa. ENGINEERED FILL SOIL
F1 = 48"x48"x20" CONCRETE PAD
F2 = 40"x40"x16" CONCRETE PAD
F3 = 34"x34"x14" CONCRETE PAD
F4 = 28"x28"x12" CONCRETE PAD
F5 = 18"x18"x8" CONCRETE PAD
(REFER TO FLOOR PLAN FOR UNUSUAL SIZE PADS NOT ON CHART.)

STRIP FOOTINGS - FOR 2 STOREY TOWNHOUSES

FOOTINGS ON NATIVE SOIL (120 KPa.)
24"x8" CONCRETE STRIP FOOTINGS AS NOTED ON PLAN
24"x8" CONCRETE STRIP FOOTINGS BELOW EXTERIOR WALLS (UNLESS OTHERWISE NOTED).
24"x8" CONCRETE STRIP FOOTINGS (WITH REINFC.) BELOW PARTY WALLS.
32"x8" CONCRETE STRIP FOOTINGS (WITH REINFC.) BELOW FIRE WALLS.

FOOTINGS ON ENGINEERED FILL (90 KPa.)
24"x8" CONCRETE STRIP FOOTINGS-WITH REINFORCEMENT, AS NOTED ON PLAN
32"x8" CONCRETE STRIP FOOTINGS BELOW EXTERIOR WALLS-WITH REINFORCEMENT (UNLESS OTHERWISE NOTED).
32"x8" CONCRETE STRIP FOOTINGS-WITH REINFORCEMENT BELOW PARTY WALLS.
44"x8" CONCRETE STRIP FOOTINGS - WITH REINFORCEMENT BELOW FIRE WALLS. (REFER TO FOOTING DETAIL FOR REINFORCEMENT)

ASSUME 120KPa/17.4kg soil BEARING CAPACITY FOR NATIVE SOIL OR 90KPa/13.0kg FOR ENGINEERED FILL. SOIL BEARING TO BE VERIFIED ON-SITE BY SOILS ENGINEER.

VENEER CUT
WHEN VENEER CUT IS GREATER THAN 26", A 10" POURED CONCRETE FOUNDATION WALL IS REQUIRED.

REFER TO INDIVIDUAL UNITS FOR THE FOLLOWING

-GROUND FLOOR ROOF STRUCTURE

-BASEMENT AND GROUND FLOOR LINTELS

-GROUND FLOOR AND SECOND FLOOR STRUCTURE

-DOUBLE VOLUME WALL LOCATION AND DETAILS

-CONCRETE SLABS

NOTE:
ROOF TRUSSES AND SECOND FLOOR LINTELS SHOWN ON BLOCK PLANS

SOFFIT VENTING
NO SOFFIT VENTING AT ROOF OVERLAP OF DEMISING LINE/ PARTY WALL.

← SUMP PUMP LOCATION

It is the builder's complete responsibility to ensure that all plans submitted for approval fully comply with the Architectural Guidelines and all applicable regulations and requirements including zoning provisions and any provisions of the Planning and Building Act. The Council Architect is not responsible in any way for reviewing or approving any drawings, plans or building codes or permit number or that any plans or drawings are not in compliance with the Architectural Guidelines and the Town of Milton.

ARCHITECTURAL REVIEW & APPROVAL
MAR 20, 2017
John G. Williams, Architect

255 Consumers Rd
Suite 120
Toronto, ON M2J 1R4
416.630.2255
416.630.4152
vo3design.com

VA3 DESIGN

LECCO RIDGE DEV. INC.

TOWN OF MILTON

IVY SERIES

BLOCK 337


BLOCK 337 PLANS

SEPTEMBER 2016


1/8" = 1'-0"

16015-BLOCK-337

B1

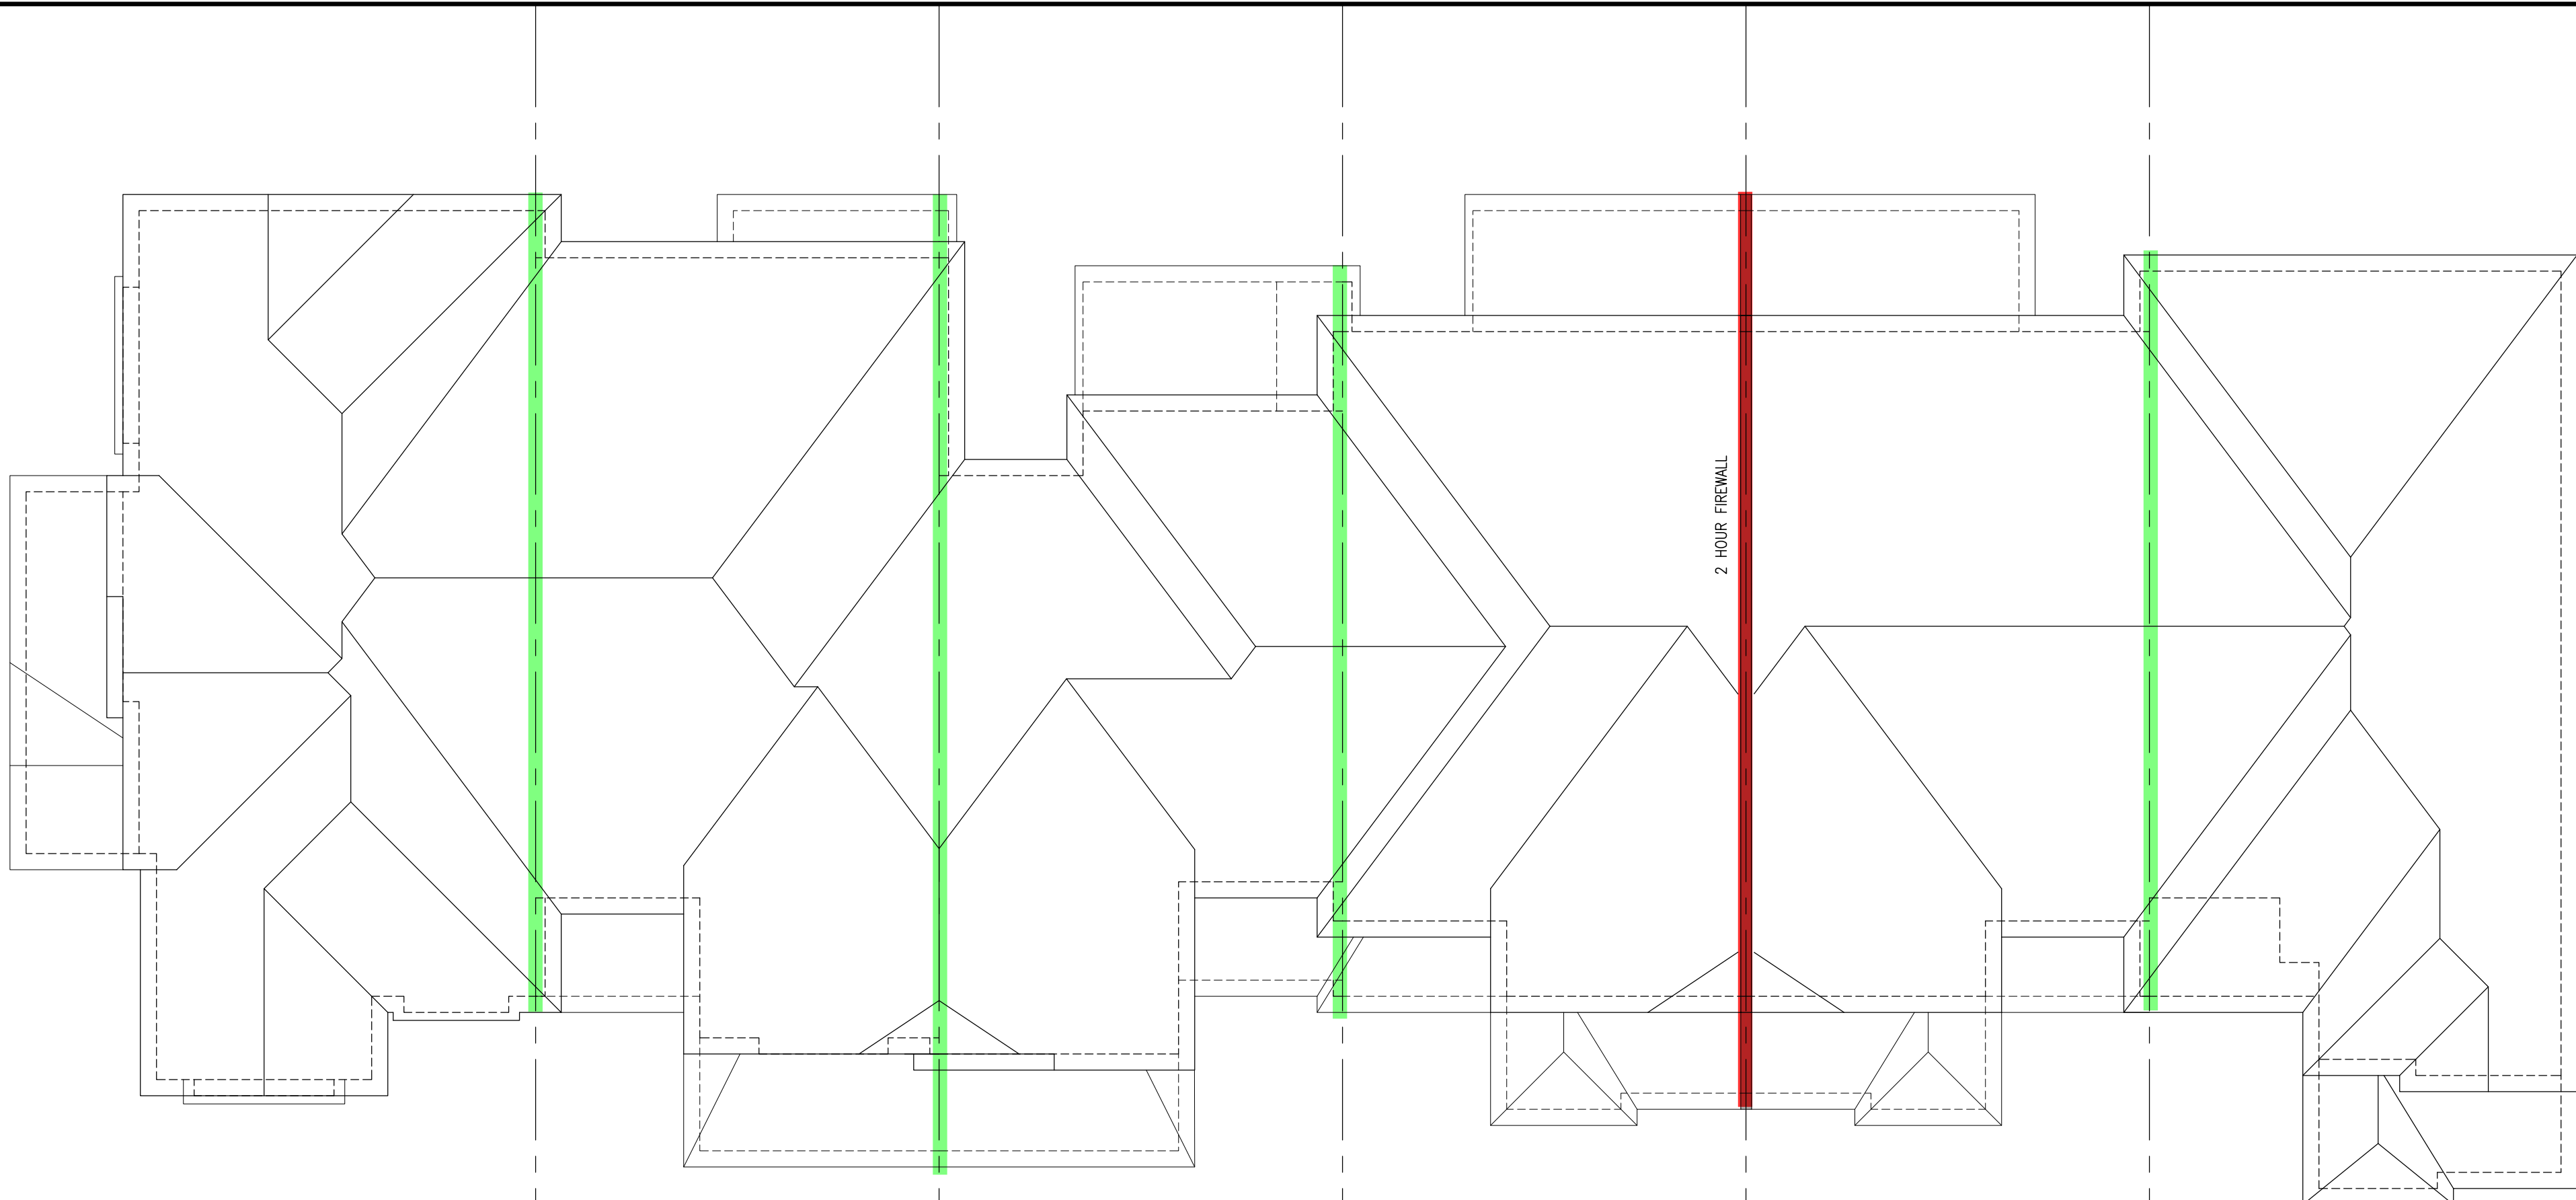

ROOF PLAN

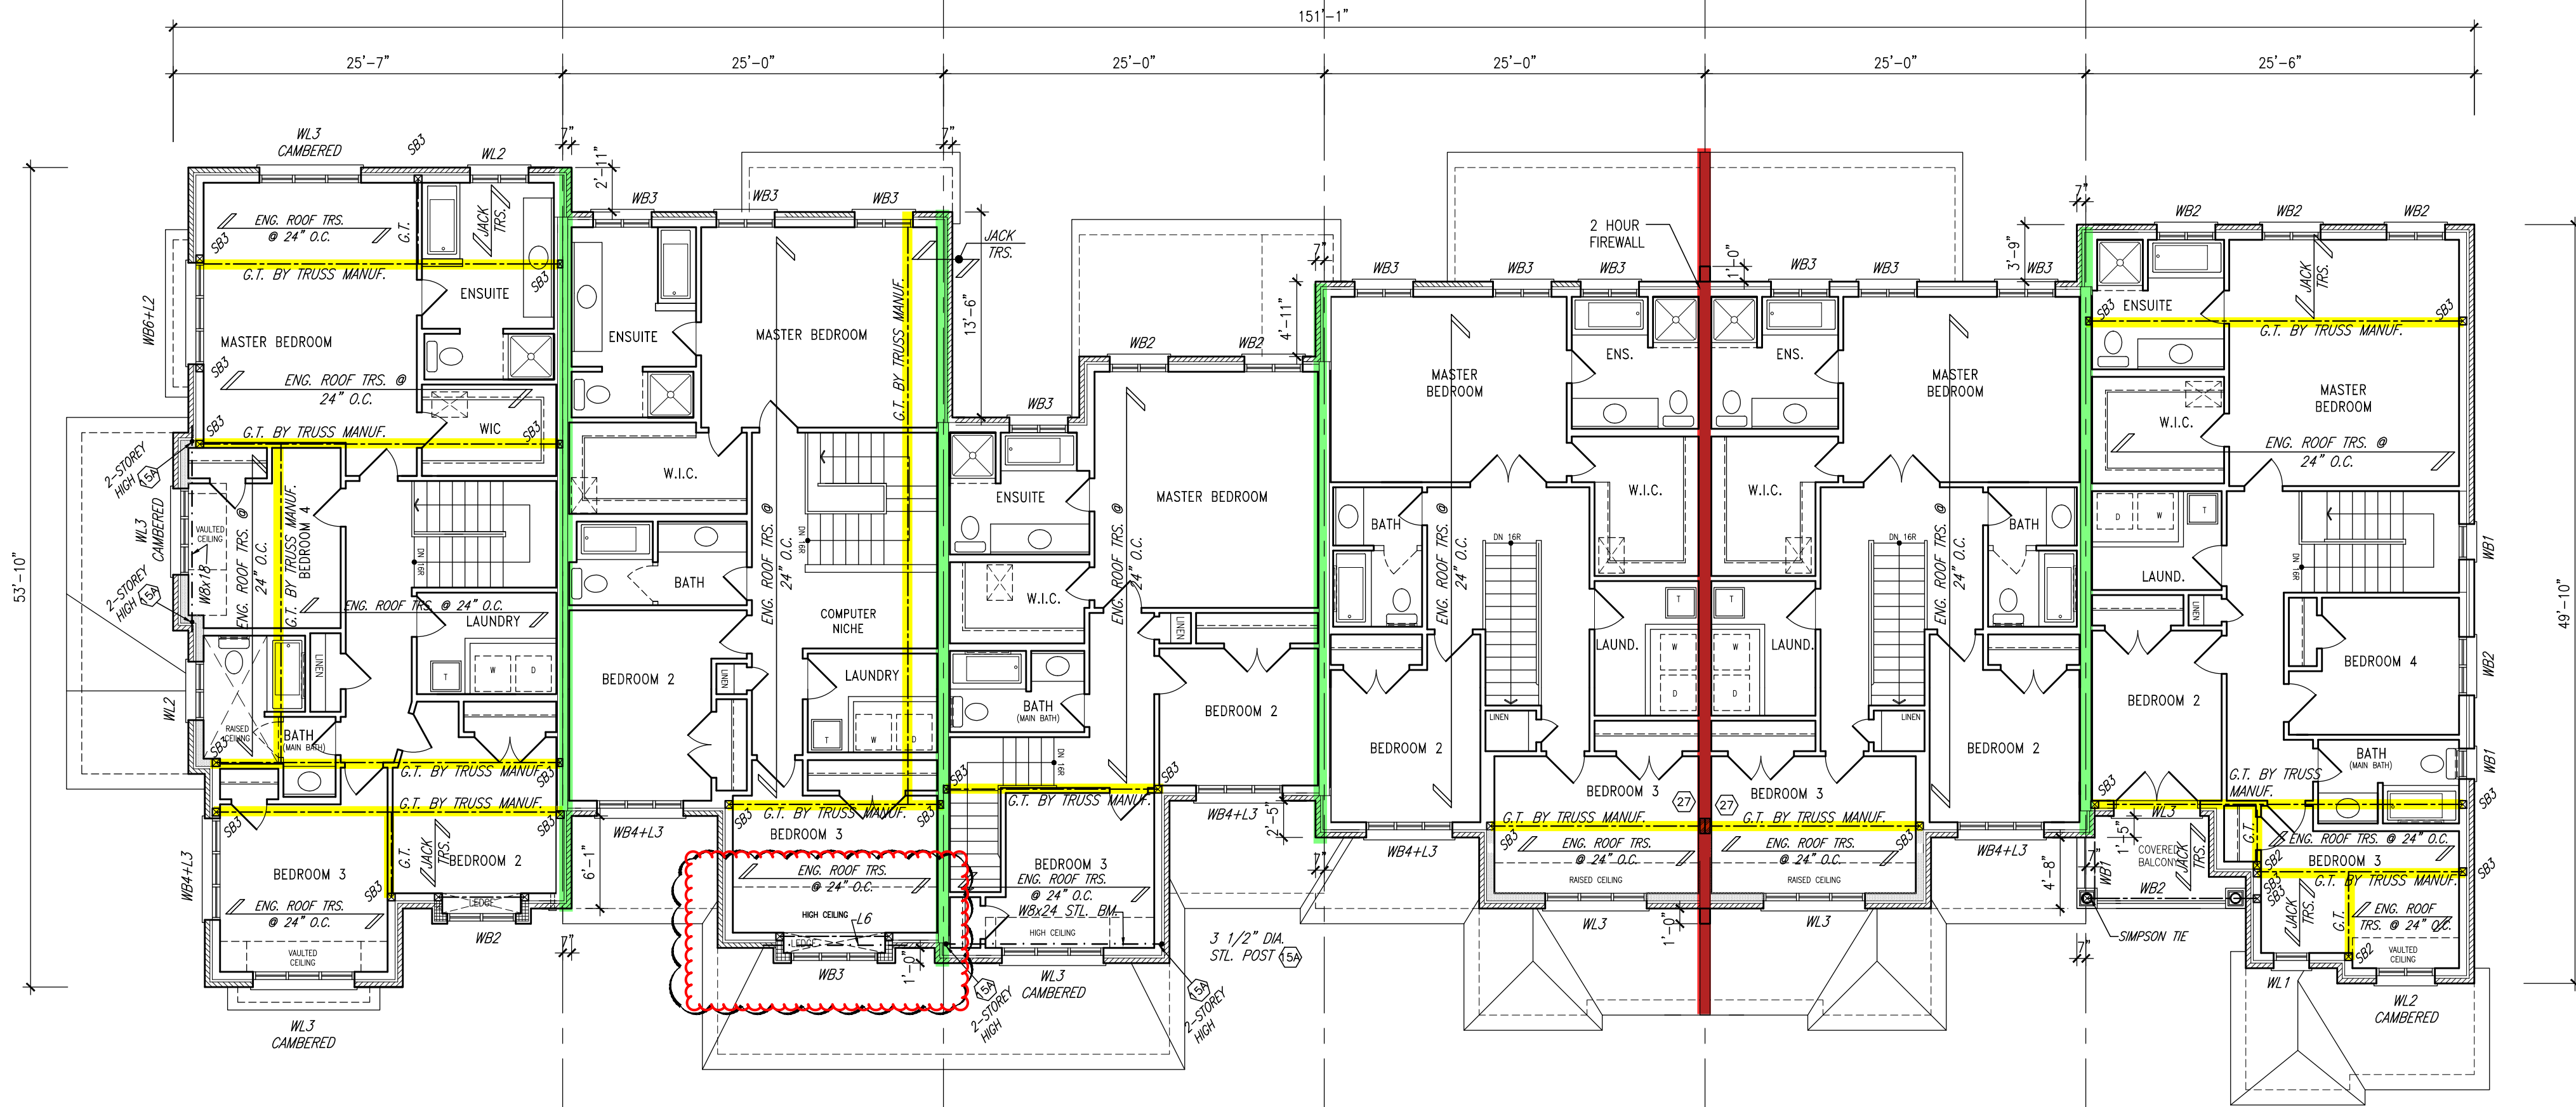

SECOND FLOOR PLAN

NOTE:
REVISION CLOUD INDICATES
CONDITION THAT DIFFERS FROM
STANDARD UNIT

TOWN OF MILTON
PLANNING AND DEVELOPMENT
BUILDING PERMIT: 17-5224
DATE: APR 24, 2017
BUILDING DIVISION

GENERAL NOTES/CONSTRUCTION DETAILS
Reviewed model drawings to be read in conjunction with reviewed general notes, construction details and specifications

TOWNHOUSE MODELS
Reviewed townhouse block drawings to be read in conjunction with reviewed townhouse model drawings and engineered truss system

= 2 HOUR FIREWALL
(NON-COMBUSTIBLE)

FIREWALL DETAILS
See standard details page 5
for standard firewall
construction details

= 1 HOUR PARTY WALL
(FIRE SEPARATION)

PARTY WALL DETAILS
See standard details page 4
for standard party wall
construction details



**BLOCK 337
ELEVATION 1**

PAD FOOTINGS
120 KPa, NATIVE SOIL
F1 = 42"x42"x18" CONCRETE PAD
F2 = 36"x36"x18" CONCRETE PAD
F3 = 30"x30"x12" CONCRETE PAD
F4 = 24"x24"x12" CONCRETE PAD
F5 = 16"x16"x8" CONCRETE PAD
90 KPa, ENGINEERED FILL SOIL
F1 = 48"x48"x20" CONCRETE PAD
F2 = 40"x40"x16" CONCRETE PAD
F3 = 34"x34"x14" CONCRETE PAD
F4 = 28"x28"x12" CONCRETE PAD
F5 = 18"x18"x8" CONCRETE PAD
(REFER TO FLOOR PLAN FOR UNUSUAL SIZE PADS NOT ON CHART.)

STRIP FOOTINGS - FOR 2 STOREY TOWNHOUSES

FOOTINGS ON NATIVE SOIL (120 KPa.)
20"x6" CONCRETE STRIP FOOTINGS AS NOTED ON PLAN
24"x8" CONCRETE STRIP FOOTINGS BELOW EXTERIOR WALLS (UNLESS OTHERWISE NOTED).
24"x8" CONCRETE STRIP FOOTINGS (WITH REIN.) BELOW PARTY WALLS.
32"x8" CONCRETE STRIP FOOTINGS (WITH REIN.) BELOW FIRE WALLS.

FOOTINGS ON ENGINEERED FILL (90 KPa.)
24"x8" CONCRETE STRIP FOOTINGS WITH REINFORCEMENT, AS NOTED ON PLAN
32"x8" CONCRETE STRIP FOOTINGS BELOW EXTERIOR WALLS WITH REINFORCEMENT (UNLESS OTHERWISE NOTED).
32"x8" CONCRETE STRIP FOOTINGS WITH REINFORCEMENT BELOW PARTY WALLS.
44"x8" CONCRETE STRIP FOOTINGS WITH REINFORCEMENT BELOW FIRE WALLS.
(REFER TO FOOTING DETAIL FOR REINFORCEMENT)

ASSUME 120KPa/17.4psi SOIL BEARING CAPACITY FOR NATIVE SOIL
OR 90KPa/ 13.0psi FOR ENGINEERED FILL
SOIL BEARING TO BE VERIFIED ON-SITE BY SOILS ENGINEER

VENEER CUT
WHEN VENEER CUT IS GREATER
THAN 26", A 10" POURED
CONCRETE FOUNDATION WALL IS
REQUIRED.

**REFER TO INDIVIDUAL UNITS
FOR THE FOLLOWING**

- GROUND FLOOR ROOF STRUCTURE
- BASEMENT AND GROUND FLOOR LINTELS
- GROUND FLOOR AND SECOND FLOOR STRUCTURE
- DOUBLE VOLUME WALL LOCATION AND DETAILS
- CONCRETE SLABS

NOTE:
ROOF TRUSSES AND
SECOND FLOOR LINTELS
SHOWN ON BLOCK PLANS

SOFFIT VENTING
NO SOFFIT VENTING AT ROOF
OVERLAP OF DEMISING LINE/
PARTY WALL.

It is the builder's complete responsibility to ensure that all plans submitted for approval fully comply with the Architectural Guidelines and all applicable regulations and requirements including zoning provisions and any provisions in the subdivision agreement. The Council Architect is not responsible in any way for omissions or approvals and is not liable for building code or permit matter or that any house can be properly built or located on its lot.

This is to certify that these plans comply with the applicable Architectural Design Guidelines approved by the Town of Milton.

ARCHITECTURAL REVIEW & APPROVAL
MAR 20 2017
John G. Williams (Council, Architect)

no.	description	date	by
1	ISSUED FOR PERMIT	MAR 01/17	GM
2	SUMP PUMP LOCATIONS ADDED	FEB 02/17	GM
3	ISSUED FOR PRICING	JAN 17/17	GM
4	REV. AS PER ENG. COMMENTS & TRUSS LAYOUTS	DEC 13/16	GM
5	ISSUED FOR CLIENT REVIEW		

Contractor must verify all dimensions on the job and report any discrepancy to the Designer before proceeding with the work. All drawings and specifications are instruments of service and the property of the architect which must be returned at the completion of the work. Drawings are not to be scaled.

V3 DESIGN
255 Consumers Rd
Suite 120
Toronto ON M2J 1R4
t 416.630.2255
f 416.630.4182
v3design.com

All drawings, specifications, related documents and design are the copyright property of V3 DESIGN. Reproduction in this property in whole or in part is strictly prohibited without V3 DESIGN's written permission.

The architect has reviewed and taken responsibility for the design and for the specifications and notes the requirements are set in the design. Building Code is not a design. Reproduction in this property in whole or in part is strictly prohibited without V3 DESIGN's written permission.

Richard Vink 24488
signature
V3 Design Inc. 42858

Greenpark.

PROJECT NAME: **LECCO RIDGE DEV. INC.**
PROJECT NO: 16015

TOWN OF MILTON
16015
BLOCK 337

IVY SERIES
BLOCK 337 PLANS
SEPTEMBER 2016
1/8" = 1'-0"

drawn by: **BT**
checked by: **GM**
16015-BLOCK-337
B2

