

1883 SF.

STRIP FOOTINGS – FOR SINGLES & SEMIS UP TO 2 STOREYS

8" OR 10" FOUNDATION WALLS WITH 2"x8" / 2"x10" FLOOR JOISTS
20"x6" CONCRETE STRIP FOOTINGS BELOW FOUNDATION WALLS.
24"x8" CONCRETE STRIP FOOTINGS BELOW PARTY WALLS.
FOUNDATION WALLS WITH ENGINEERED JOISTS OVER 16' SPANS
24"x8" CONCRETE STRIP FOOTINGS BELOW FOUNDATION WALLS.

FOOTINGS ON ENGINEERED FILL

24"x8" CONCRETE STRIP FOOTINGS WITH REINFORCING.
BELOW EXTERIOR WALLS.
30"x8" CONCRETE STRIP FOOTINGS WITH REINFORCING.
BELOW PARTY WALLS.
(REFER TO ENGINEER FILL FOOTING DETAIL)

ASSUME THE LARGER FOOTING SIZE WHEN TWO CONDITIONS APPLY

ASSUMED 120 KPa (18 p.s.i.) SOIL BEARING CAPACITY FOR SINGLES OR 90 KPa FOR ENGINEERED FILL, TO BE VERIFIED ON SITE.

PAD FOOTINGS

120 KPa. NATIVE SOIL

F1 = 42"x42"x18" CONCRETE PAD
F2 = 36"x36"x16" CONCRETE PAD
F3 = 30"x30"x12" CONCRETE PAD
F4 = 24"x24"x12" CONCRETE PAD
F5 = 16"x16"x8" CONCRETE PAD

90 KPa. ENGINEERED FILL SOIL

F1 = 48"x48"x20" CONCRETE PAD
F2 = 40"x40"x16" CONCRETE PAD
F3 = 34"x34"x14" CONCRETE PAD
F4 = 28"x28"x12" CONCRETE PAD
F5 = 18"x18"x8" CONCRETE PAD

(REFER TO FLOOR PLAN FOR UNUSUAL SIZE PADS NOT ON CHART.)

VENEER CUT

WHEN VENEER CUT IS GREATER THAN 26", A 10" POURED CONCRETE FOUNDATION WALL IS REQUIRED.

EXPOSED CONCRETE (FLATWORK)

ALL GARAGE SLABS, PORCH SLABS, STAIRS (EXPOSED CONC. FLAT WORK) TO BE 32 MPa. WITH 5-8% AIR ENTRAINMENT.

BRICK VENEER LINTELS (WL)

WL1 = 3-1/2" x 3-1/2" x 1/4"L (90x90x6.0L) + 2-2"x8" SPR. No.2
WL2 = 4" x 3-1/2" x 5/16"L (100x90x8.0L) + 2-2"x8" SPR. No.2
WL3 = 5" x 3-1/2" x 5/16"L (125x90x8.0L) + 2-2"x10" SPR. No.2
WL4 = 6" x 3-1/2" x 3/8"L (150x90x10.0L) + 2-2"x12" SPR. No.2
WL5 = 6" x 4" x 3/8"L (150x100x10.0L) + 2-2"x12" SPR. No.2
WL6 = 5" x 3-1/2" x 5/16"L (125x90x8.0L) + 2-2"x12" SPR. No.2
WL7 = 5" x 3-1/2" x 5/16"L (125x90x8.0L) + 3-2"x12" SPR. No.2
WL8 = 5" x 3-1/2" x 5/16"L (125x90x8.0L) + 3-2"x10" SPR. No.2
WL9 = 6" x 4" x 3/8"L (150x100x10.0L) + 3-2"x10" SPR. No.2

WOOD LINTELS AND BEAMS (WB)

WB1 = 2-2"x8" (2-38x184) SPR. No.2
WB2 = 3-2"x8" (3-38x184) SPR. No.2
WB3 = 2-2"x10" (2-38x235) SPR. No.2
WB4 = 3-2"x10" (3-38x235) SPR. No.2
WB5 = 2-2"x12" (2-38x286) SPR. No.2
WB6 = 3-2"x12" (3-38x286) SPR. No.2
WB7 = 5-2"x12" (5-38x286) SPR. No.2
WB11 = 4-2"x10" (4-38x235) SPR. No.2
WB12 = 4-2"x12" (4-38x286) SPR. No.2

LAMINATED VENEER LUMBER (LVL) BEAMS

LVL1A = 1-1 3/4"x7 1/4" (1-45x184)
LVL1 = 2-1 3/4"x7 1/4" (2-45x184)
LVL2 = 3-1 3/4"x7 1/4" (3-45x184)
LVL3 = 4-1 3/4"x7 1/4" (4-45x184)
LVL4A = 1-1 3/4"x9 1/2" (1-45x240)
LVL4 = 2-1 3/4"x9 1/2" (2-45x240)
LVL5 = 3-1 3/4"x9 1/2" (3-45x240)
LVL5A = 4-1 3/4"x9 1/2" (4-45x240)
LVL6A = 1-1 3/4"x11 7/8" (1-45x300)
LVL6 = 2-1 3/4"x11 7/8" (2-45x300)
LVL7 = 3-1 3/4"x11 7/8" (3-45x300)
LVL8 = 2-1 3/4"x14" (2-45x356)
LVL9 = 3-1 3/4"x14" (3-45x356)

LOOSE STEEL LINTELS (L)

L1 = 3-1/2" x 3-1/2" x 1/4"L (90x90x6.0L)
L2 = 4" x 3-1/2" x 5/16"L (100x90x8.0L)
L3 = 5" x 3-1/2" x 5/16"L (125x90x8.0L)
L4 = 6" x 3-1/2" x 3/8"L (150x90x10.0L)
L5 = 6" x 4" x 3/8"L (150x100x10.0L)
L6 = 7" x 4" x 3/8"L (180x100x10.0L)

CERAMIC TILE FOR CONVENTIONAL LUMBER (OBC 9.30.6)

SPACE ALL CONVENTIONAL FLOOR JOISTS @ 12" O.C. BELOW ALL CERAMIC TILE AREAS.
PROVIDE 1 ROW BRIDGING FOR SPANS OF 5'0"-7'0", 2 ROWS FOR SPANS GREATER THAN 7'0".

NOTE: ROOF FRAMING

REFER TO ROOF TRUSS SHOP DRAWINGS FOR ALL ROOF FRAMING INFORMATION UNLESS OTHERWISE NOTED.


PLANS NOT DRAWN TO ACTUAL GRADE. REFER TO FINAL APPROVED GRADING PLAN.

NOTE: ENGINEERED FLOOR FRAMING

REFER TO ENGINEERED FLOOR FLAYOUTS FOR ALL ENGINEERED FLOOR FRAMING INFORMATION AND DETAILS. UNLESS OTHERWISE NOTED.

TWO STOREY HEIGHT WALL DETAIL


2-2"x6" STUD WALL NAILED TOGETHER AND SPACED @ 12" o.c. FULL HEIGHT, c/w SOLID BLOCKING @ 4'-0" o.c. VERTICAL AND 7/16" EXT. PLYWOOD SHEATHING.

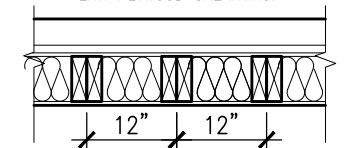

NOTE: MAXIMUM HEIGHT OF WALL FOR THIS DETAIL IS 18'-0" AND MAX. SUPPORTED LENGTH OF TRUSS IS 40'-0".

TWO STOREY HEIGHT WALL DETAIL


2-1 1/2"x 5 1/2" TIMBERSTRAND (LSL) 1.5E STUD WALL GLUED & NAILED TOGETHER AND SPACED MAX. @ 10" o.c. FULL HEIGHT, c/w SOLID BLOCKING @ 8'-0" o.c. VERTICAL AND 7/16" EXT. OSB SHEATHING.

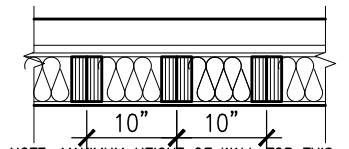

NOTE: MAXIMUM HEIGHT OF WALL FOR THIS DETAIL IS 20'-2" AND MAX. SUPPORTED LENGTH OF TRUSS IS 40'-0".

TWO STOREY HEIGHT WALL DETAIL

2-1 1/2"x 5 1/2" TIMBERSTRAND (LSL) 1.5E STUD WALL GLUED & NAILED TOGETHER AND SPACED MAX. @ 9" o.c. FULL HEIGHT, c/w SOLID BLOCKING @ 8'-0" o.c. VERTICAL AND 7/16" EXT. OSB SHEATHING.

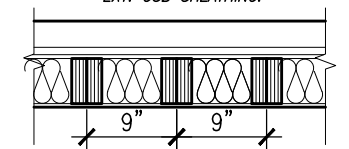

NOTE: MAXIMUM HEIGHT OF WALL FOR THIS DETAIL IS 21'-5" AND MAX. SUPPORTED LENGTH OF TRUSS IS 40'-0".

DOOR SCHEDULE

NOS.	WIDTH	HEIGHT 8'-9' CEILING	HEIGHT 10' OR MORE CEILING	TYPE
1	2'-10"	6'-8"	8'-0"	INSULATED ENTRANCE DOOR
1a	2'-8"	6'-8"	8'-0"	INSULATED FRONT DOORS
2	2'-8"	6'-8"	8'-0"	WOOD & GLASS DOOR
3	2'-8"	6'-8"	8'-0"	EXTERIOR SLAB DOOR
4	2'-8"	6'-8"	8'-0"	INTERIOR SLAB DOOR
5	2'-6"	6'-8"	8'-0"	INTERIOR SLAB DOOR
6	2'-2"	6'-8"	8'-0"	INTERIOR SLAB DOOR
7	1'-6"	6'-8"	8'-0"	INTERIOR SLAB DOOR

GENERAL NOTES/CONSTRUCTION DETAILS

Reviewed model drawings to be read in conjunction with reviewed general notes, constructions details and specifications

TOWNHOUSE MODELS

Reviewed townhouse model drawings to be read in conjunction with reviewed lot specific block drawings and engineered truss system

TOWN OF MILTON PLANNING AND DEVELOPMENT IVY 3 MODEL

BUILDING: REVIEWED
SCOTT SHERRIFFS APR 18, 2017

PLANS EXAMINER DATE
Neither the issuance of a permit nor carrying out of inspections by the Town of Milton relieves the owner from full responsibility for compliance with the provisions of the Ontario Building Code Act and the Ontario Building Code, both as amended, as well as other applicable statutes and regulations of the Province of Ontario, By-laws of the Region of Halton and Town of Milton

RECEIVED
TOWN OF MILTON
MAR 29, 2017
IVY 3
BUILDING DIVISION

It is the builder's complete responsibility to ensure that all plans submitted for approval fully comply with the Architectural Guidelines and all applicable regulations and requirements including zoning provisions and any provisions in the subdivision agreement. The Control Architect is not responsible in any way for examining or approving site (lotting) plans or working drawings with respect to any zoning or building code or permit matter or that any house can be properly built or located on its lot.

This is to certify that these plans comply with the applicable Architectural Design Guidelines approved by the Town of MILTON.

UNINSULATED OPENINGS (PER OBC. SB-12.3.1.1.(7))			
IVY 3 AND ELEVATION 1	ENERGY EFFICIENCY – ENERGY STAR		
ELEVATION	WALL AREA S.F.	OPENING S.F.	PERCENTAGE
FRONT	452.83 S.F.	83.92 S.F.	18.53 %
LEFT SIDE	936.15 S.F.	3.33 S.F.	0.36 %
RIGHT SIDE	936.15 S.F.	0.0 S.F.	0.00 %
REAR	452.83 S.F.	113.91 S.F.	25.16 %
TOTAL SQ. FT.	2777.96 S.F.	201.16 S.F.	7.24 %
TOTAL SQ. M.	258.08 S.M.	18.69 S.M.	7.24 %

UNINSULATED OPENINGS (PER OBC. SB-12.3.1.1.(7))			
IVY 3 AND ELEVATION 2	ENERGY EFFICIENCY – ENERGY STAR		
ELEVATION	WALL AREA S.F.	OPENING S.F.	PERCENTAGE
FRONT	482.50 S.F.	96.34 S.F.	19.97 %
LEFT SIDE	936.15 S.F.	3.33 S.F.	0.36 %
RIGHT SIDE	936.15 S.F.	0.0 S.F.	0.00 %
REAR	452.83 S.F.	113.91 S.F.	25.16 %
TOTAL SQ. FT.	2807.63 S.F.	213.58 S.F.	7.61 %
TOTAL SQ. M.	260.84 S.M.	19.84 S.M.	7.61 %

UNINSULATED OPENINGS (PER OBC. SB-12.3.1.1.(7))			
IVY 3 AND ELEVATION 3	ENERGY EFFICIENCY – ENERGY STAR		
ELEVATION	WALL AREA S.F.	OPENING S.F.	PERCENTAGE
FRONT	452.83 S.F.	88.42 S.F.	19.53 %
LEFT SIDE	936.15 S.F.	3.33 S.F.	0.36 %
RIGHT SIDE	936.15 S.F.	0.0 S.F.	0.00 %
REAR	452.83 S.F.	113.91 S.F.	25.16 %
TOTAL SQ. FT.	2777.96 S.F.	205.66 S.F.	7.40 %
TOTAL SQ. M.	258.08 S.M.	19.11 S.M.	7.40 %

AREA CALCULATIONS ELEV '1'

GROUND FLOOR AREA 872 SF
SECOND FLOOR AREA 1008 SF

TOTAL FLOOR AREA 1880 SF
(174.66 m2)

FIRST FLOOR OPEN AREA 0 SF
SECOND FLOOR OPEN AREA 3 SF
ADD TOTAL OPEN AREAS +3 SF
ADD FINISHED BSMT AREA +0 SF

GROSS FLOOR AREA 1883 SF
(174.93 m2)

GROUND FLOOR COVERAGE 872 SF
GARAGE COVERAGE/AREA 315 SF
PORCH COVERAGE/AREA 96 SF

COVERAGE W/ PORCH 1283 SF
(119.19 m2)

COVERAGE W/O PORCH 1187 SF
(110.28 m2)

AREA CALCULATIONS ELEV '2'

GROUND FLOOR AREA 872 SF
SECOND FLOOR AREA 999 SF

TOTAL FLOOR AREA 1871 SF
(173.82 m2)

FIRST FLOOR OPEN AREA 0 SF
SECOND FLOOR OPEN AREA 3 SF
ADD TOTAL OPEN AREAS +3 SF
ADD FINISHED BSMT AREA +0 SF

GROSS FLOOR AREA 1874 SF
(174.10 m2)

GROUND FLOOR COVERAGE 872 SF
GARAGE COVERAGE/AREA 315 SF
PORCH COVERAGE/AREA 104 SF

COVERAGE W/ PORCH 1291 SF
(119.93 m2)

COVERAGE W/O PORCH 1187 SF
(110.28 m2)

AREA CALCULATIONS ELEV '3'

GROUND FLOOR AREA 872 SF
SECOND FLOOR AREA 999 SF

TOTAL FLOOR AREA 1871 SF
(173.82 m2)

FIRST FLOOR OPEN AREA 0 SF
SECOND FLOOR OPEN AREA 3 SF
ADD TOTAL OPEN AREAS +3 SF
ADD FINISHED BSMT AREA +0 SF

GROSS FLOOR AREA 1874 SF
(174.10 m2)

GROUND FLOOR COVERAGE 872 SF
GARAGE COVERAGE/AREA 315 SF
PORCH COVERAGE/AREA 96 SF

COVERAGE W/ PORCH 1283 SF
(119.19 m2)

COVERAGE W/O PORCH 1187 SF
(110.28 m2)



STRUDET INC.
FOR STRUCTURE ONLY



ENERGY STAR- V 12.7

IVY 3
ENERGY STAR/ PANEL


18				9	REVISED PER BLDG. DEPT. COMMENTS.	APR. 10/17	GW
17				8	ISSUED FOR PERMIT.	MAR. 01/17	GW
16				7	ISSUED FOR PRICING.	DEC. 21/16	GW
15				6	CLOSET ADDED TO MASTER BEDROOM.	OCT. 27/16	GW
14				5	REVISED. ADD SUNKEN FOYER COND.	OCT 03/16	WT
13				4	2nd FL. WINDOW PANELS. STAIR SHIFT 4".	SEP 06/16	GW
12				3	REPLACE PATIO DR w/ WINDOW	AUG 26/16	GW
11				2	REVISED PLANS & ELEVATIONS.	AUG 22/16	GW
10				1	ISSUED FOR CLIENT REVIEW.	AUG. 08/16	GW
no. description		date	by	no. description		date	by

The undersigned has reviewed and takes responsibility for this design and has the qualifications and meets the requirements set out in the Ontario Building Code to be a Designer.
qualification information
Richard Vink 24488
signature
name registration information
VA3 Design Inc. 42658
Contractor must verify all dimensions on the job and report any discrepancy to the Designer before proceeding with the work. All drawings and specifications are instruments of service and the property of the Designer which must be returned at the completion of the work. Drawings are not to be scaled.

VA3 DESIGN
255 Consumers Rd Suite 120
Toronto ON M2J 1R4
t 416.630.2255 f 416.630.4782
va3design.com

		IVY 3	
project name	LECCO RIDGE DEV. INC.	municipality	TOWN OF MILTON
date	JULY 2016	checked by	scale
drawn by	AF	3/16" = 1'-0"	16015-IVY-3
GENERAL NOTES & CHARTS		drawing no.	
GREG - H:\ARCHIVE\WORKING\2016\16015.GRE\UNITS\IVY\IVY 3\16015-IVY-3.dwg - Mon - Apr 10 2017 - 4:12 PM		A0	

= 1 HOUR PARTY WALL
(FIRE SEPARATION)
PARTY WALL DETAILS
See standard details page 4
for standard party wall
construction details

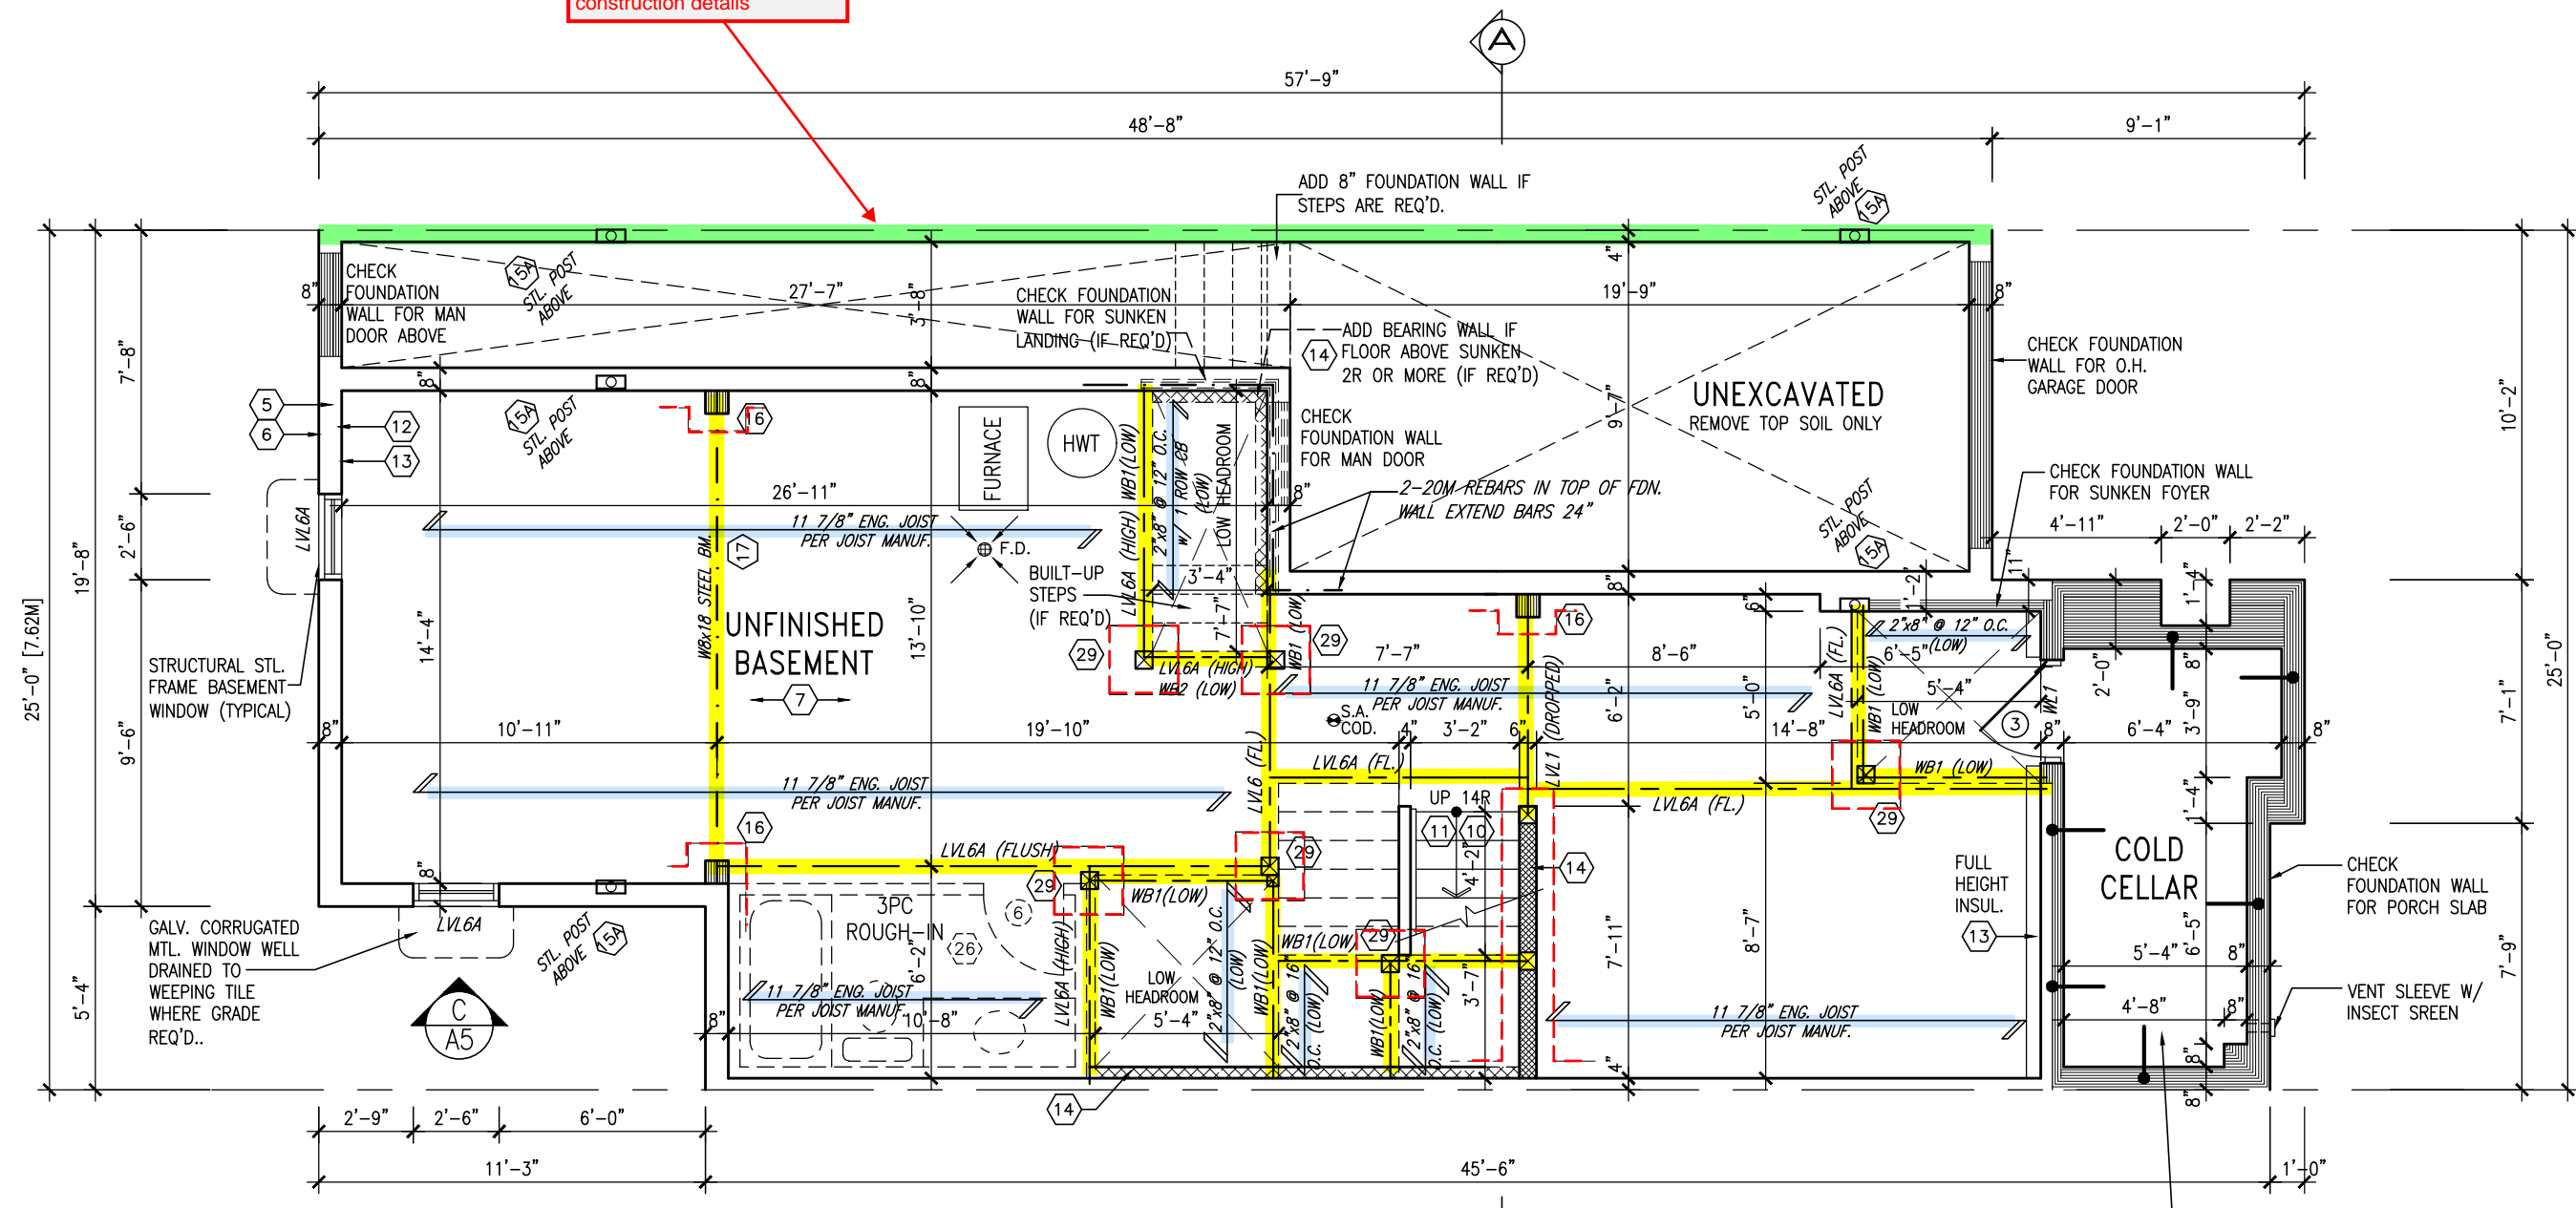

BASEMENT PLAN - ELEV. 1

ENGINEERED FLOOR FRAMING INFO
REFER TO ENGINEERED FLOOR LAYOUTS FOR
ALL FLOOR FRAMING INFORMATION AND DETAILS.
UNLESS OTHERWISE NOTED.

ENGINEERED FLOOR SYSTEM
Reviewed model drawings to be
read in conjunction with reviewed
engineered floor system layout

COLD STORAGE SLAB
5" REINFORCED CONCRETE SLAB
WITH 10M BARS @ 7 7/8" O.C.
EACH WAY WITH MIN. 1 1/4" CONC. COVER AND 10M BENT (24"x24") DOWELS SPACED NOT MORE THAN 23 5/8" O.C.

It is the builder's complete responsibility to ensure that all plans submitted for approval fully comply with the Architectural Guidelines and all applicable regulations and requirements including zoning provisions and any provisions in the subdivision agreement. The Control Architect is not responsible in any way for examining or approving site (lotting) plans or working drawings with respect to any zoning or building code or permit matter or that any house can be properly built or located on its lot.

This is to certify that these plans comply with the applicable Architectural Design Guidelines approved by the Town of Milton.

ARCHITECTURAL REVIEW & APPROVAL
MAR 20 2017
John G. Williams Limited, Architect



RECEIVED
TOWN OF MILTON
MAR 29, 2017
IVY 3
BUILDING DIVISION


**TOWN OF MILTON
PLANNING AND DEVELOPMENT
IVY 3 MODEL**
**BUILDING: REVIEWED
SCOTT SHERRIFFS APR 18, 2017**
PLANS EXAMINER DATE
Neither the issuance of a permit nor carrying out of inspections by the Town of Milton relieves the owner from full responsibility for compliance with the provisions of the Ontario Building Code Act and the Ontario Building Code, both as amended, as well as other applicable statutes and regulations of the Province of Ontario, By-laws of the Region of Halton and Town of Milton

18				9	REVISED PER BLDG. DEPT. COMMENTS.	APR. 10/17	GW	
17				8	ISSUED FOR PERMIT.	MAR. 01/17	GW	
16				7	ISSUED FOR PRICING.	DEC. 21/16	GW	
15				6	CLOSET ADDED TO MASTER BEDROOM.	OCT. 27/16	GW	
14				5	REVISED. ADD SUNKEN FOYER COND.	OCT 03/16	WT	
13				4	2nd FL. WINDOW PANELS. STAIR SHIFT 4".	SEP 06/16	GW	
12				3	REPLACE PATIO DR w/ WINDOW	AUG 26/16	GW	
11				2	REVISED PLANS & ELEVATIONS.	AUG 22/16	GW	
10				1	ISSUED FOR CLIENT REVIEW.	AUG. 08/16	GW	
no.	description		date	by	no.	description	date	by

The undersigned has reviewed and takes responsibility for this design and has the qualifications and meets the requirements set out in the Ontario Building Code to be a Designer.
qualification information
Richard Vink 24488
signature
name
registration information
VA3 Design Inc. 42658
Contractor must verify all dimensions on the job and report any discrepancy to the Designer before proceeding with the work. All drawings and specifications are instruments of service and the property of the Designer which must be returned at the completion of the work. Drawings are not to be scaled.

VA3 DESIGN
255 Consumers Rd Suite 120
Toronto ON M2J 1R4
t 416.630.2255 f 416.630.4782
va3design.com

Greenpark.		IVY 3	
LECCO RIDGE DEV. INC.		TOWN OF MILTON	
project name		project no. 16015	
date 2016-07		drawing no. A1	
drawn by AF		checked by 3/16" = 1'-0"	
scale		file name 16015-IVY-3	
GREG - H:\ARCHIVE\WORKING\2016\16015.GRE\UNITS\IVY\IVY 3\16015-IVY-3.dwg - Mon - Apr 10 2017 - 4:12 PM			

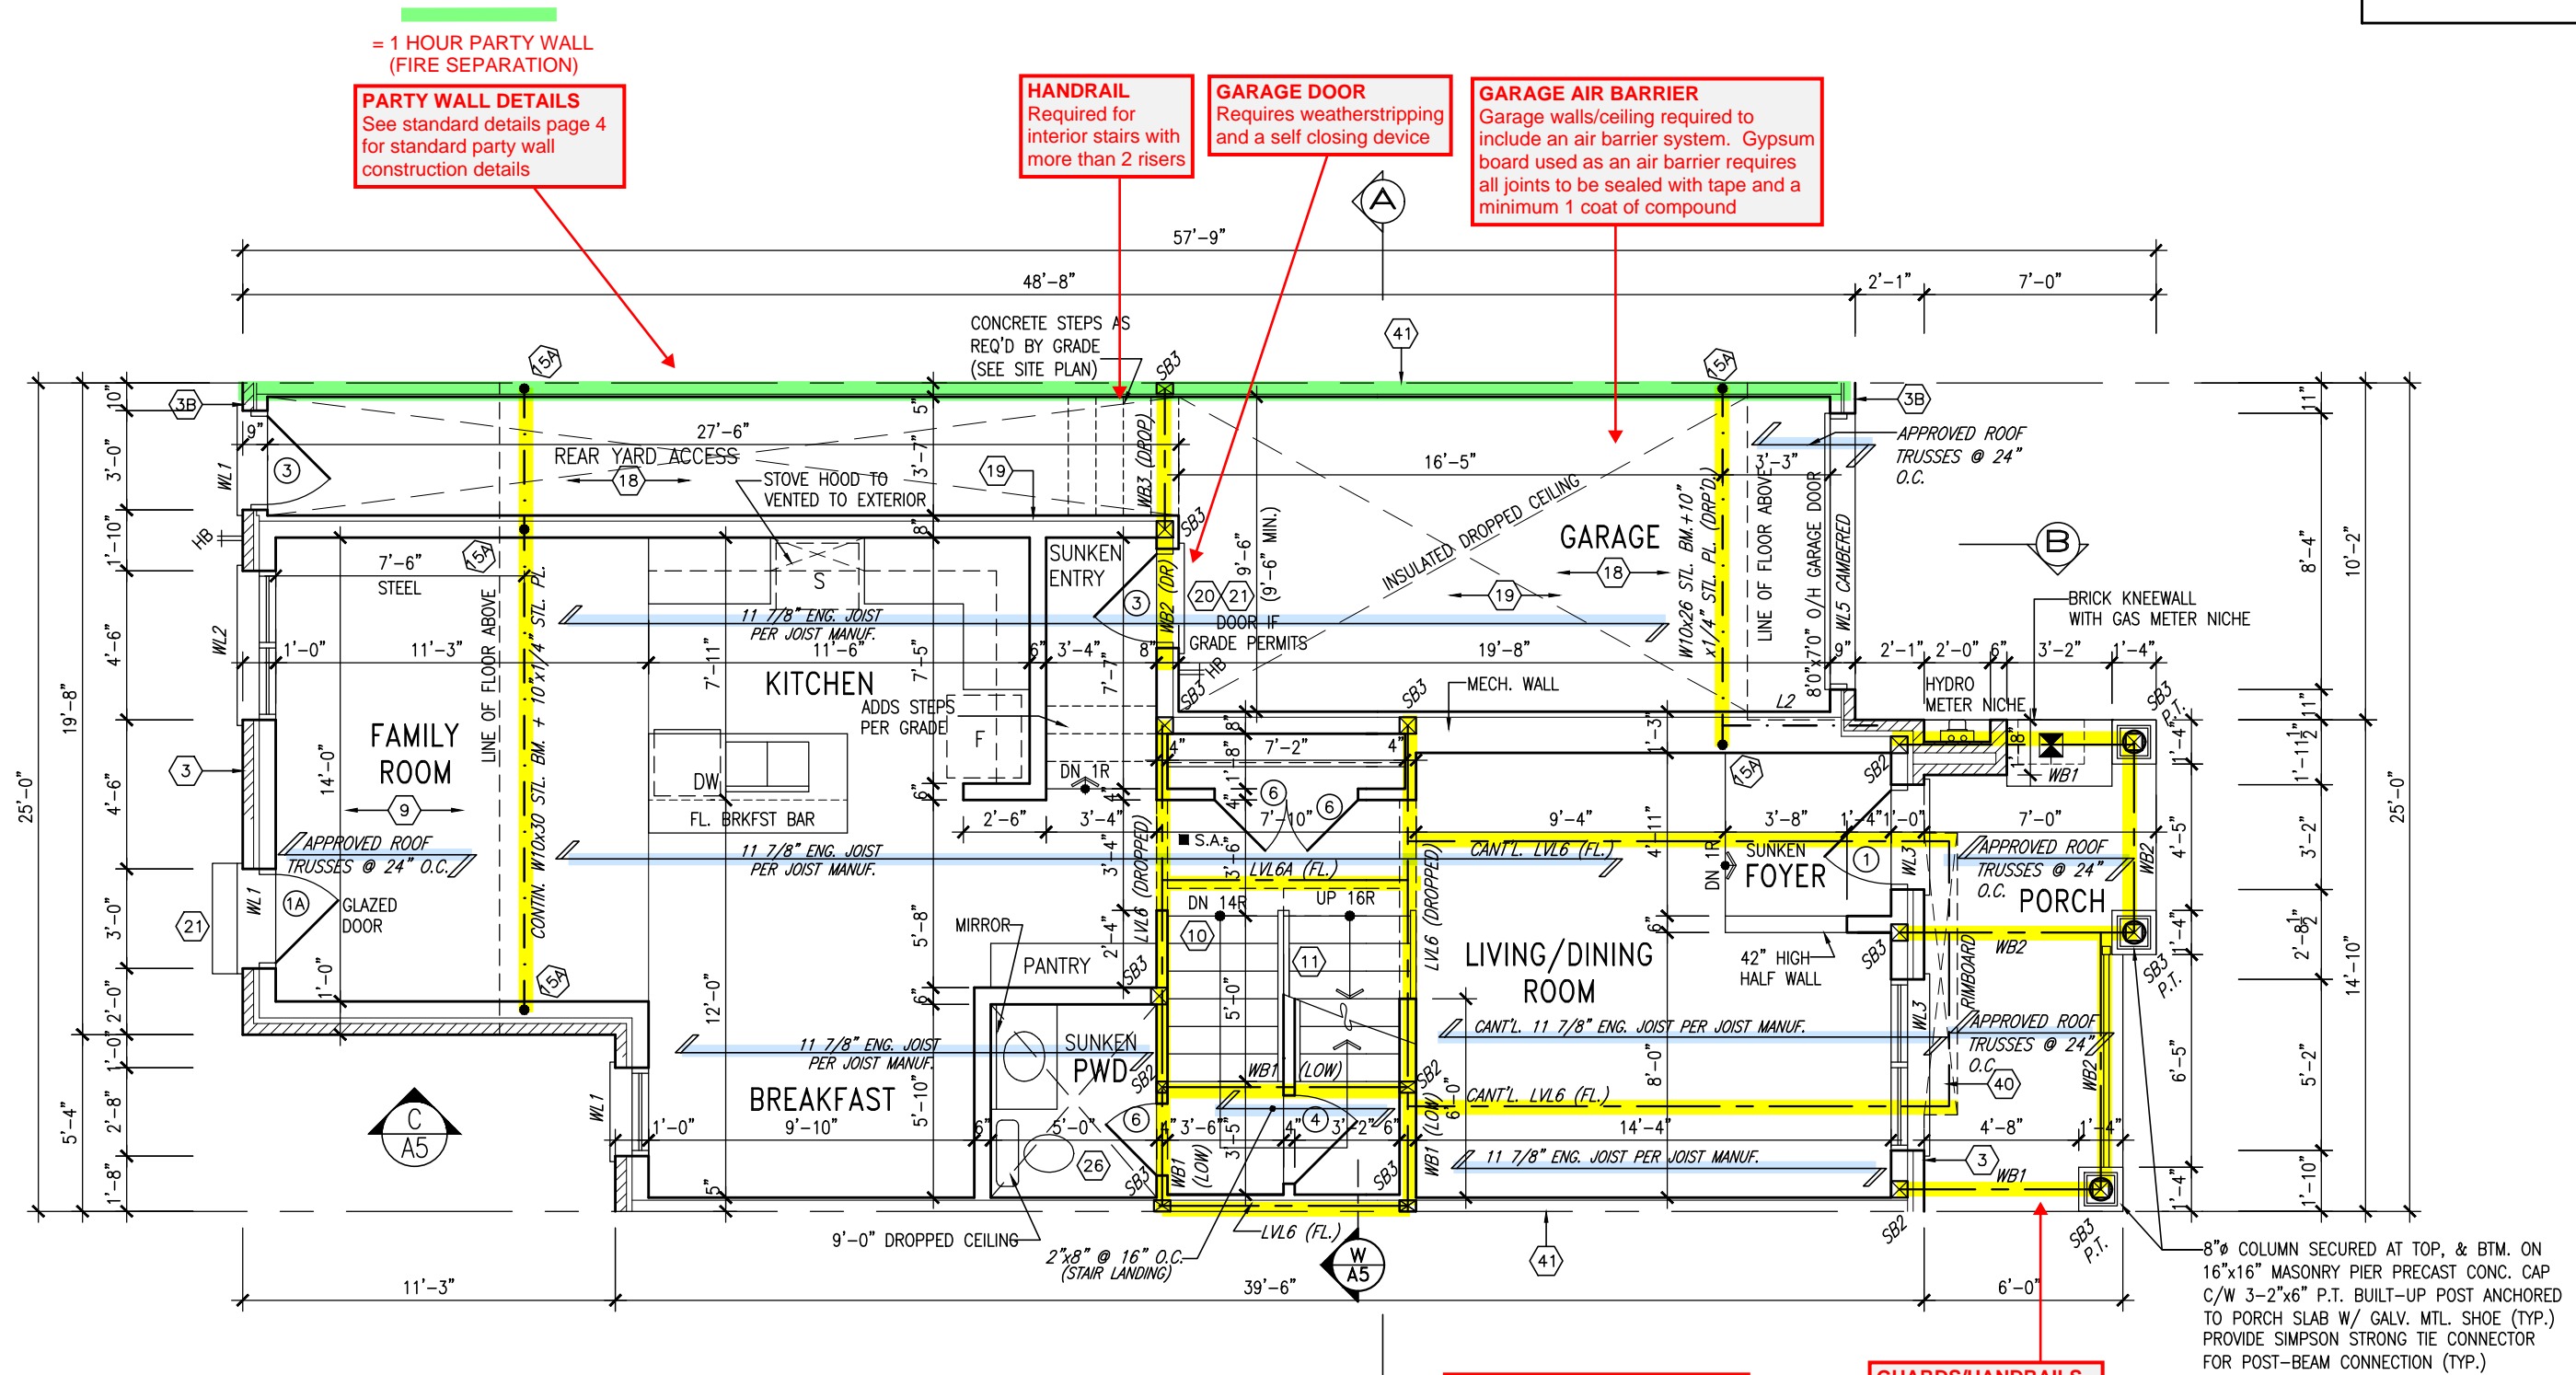

GROUND FLOOR PLAN - ELEV. 1

ENGINEERED FLOOR SYSTEM
Reviewed model drawings to be read in conjunction with reviewed engineered floor system layout

GUARDS/HANDRAILS
Shall be provided on porches as required based on final lot grading

It is the builder's complete responsibility to ensure that all plans submitted for approval fully comply with the Architectural Guidelines and all applicable regulations and requirements including zoning provisions and any provisions in the subdivision agreement. The Control Architect is not responsible in any way for examining or approving site (lotting) plans or working drawings with respect to any zoning or building code or permit matter or that any house can be properly built or located on its lot.

This is to certify that these plans comply with the applicable Architectural Design Guidelines approved by the Town of MILTON.

ARCHITECTURAL REVIEW & APPROVAL
MAR 20 2017
John G. Williams Limited, Architect

TOWN OF MILTON
PLANNING AND DEVELOPMENT
IVY 3 MODEL

BUILDING: REVIEWED
SCOTT SHERRIFFS APR 18, 2017
PLANS EXAMINER DATE

Neither the issuance of a permit nor carrying out of inspections by the Town of Milton relieves the owner from full responsibility for compliance with the provisions of the Ontario Building Code Act and the Ontario Building Code, both as amended, as well as other applicable statutes and regulations of the Province of Ontario, By-laws of the Region of Halton and Town of Milton

RECEIVED
TOWN OF MILTON
MAR 29, 2017
IVY 3
BUILDING DIVISION

ALL GARAGE SLABS, PORCH SLABS, STAIRS (EXPOSED CONC. FLAT WORK) TO BE 32 MPa WITH 5-8% AIR ENTRAINMENT.

NOTE: ROOF FRAMING
ROOF TRUSS INFORMATION REFER TO ROOF TRUSS SHOP DRAWINGS FOR ALL ROOF FRAMING INFORMATION UNLESS OTHERWISE NOTED.

ENGINEERED FLOOR FRAMING INFO
REFER TO ENGINEERED FLOOR LAYOUTS FOR ALL FLOOR FRAMING INFORMATION AND DETAILS. UNLESS OTHERWISE NOTED.



18				9	REVISED PER BLDG. DEPT. COMMENTS.	APR. 10/17	GW
17				8	ISSUED FOR PERMIT.	MAR. 01/17	GW
16				7	ISSUED FOR PRICING.	DEC. 21/16	GW
15				6	CLOSET ADDED TO MASTER BEDROOM.	OCT. 27/16	GW
14				5	REVISED. ADD SUNKEN FOYER COND.	OCT 03/16	WT
13				4	2nd FL. WINDOW PANELS. STAIR SHIFT 4".	SEP 06/16	GW
12				3	REPLACE PATIO DR w/ WINDOW	AUG 26/16	GW
11				2	REVISED PLANS & ELEVATIONS.	AUG 22/16	GW
10				1	ISSUED FOR CLIENT REVIEW.	AUG. 08/16	GW
no.	description	date	by	no.	description	date	by

The undersigned has reviewed and takes responsibility for this design and has the qualifications and meets the requirements set out in the Ontario Building Code to be a Designer.

qualification information
Richard Vink 24488
signature BCIN
name registration information
VA3 Design Inc. 42658

Contractor must verify all dimensions on the job and report any discrepancy to the Designer before proceeding with the work. All drawings and specifications are instruments of service and the property of the Designer which must be returned at the completion of the work. Drawings are not to be scaled.

VA3 DESIGN
255 Consumers Rd Suite 120
Toronto ON M2J 1R4
t 416.630.2255 f 416.630.4782
va3design.com

project name
LECCO RIDGE DEV. INC.

date
2016-07

drawn by
AF

checked by
3/16" = 1'-0"

scale
16015-IVY-3

file name
16015-IVY-3

project no.
16015


municipality
TOWN OF MILTON

GROUND FLOOR PLAN - ELEV. 1

drawing no.
A2

IVY 3
ENERGY STAR/ PANEL

1883 SF.

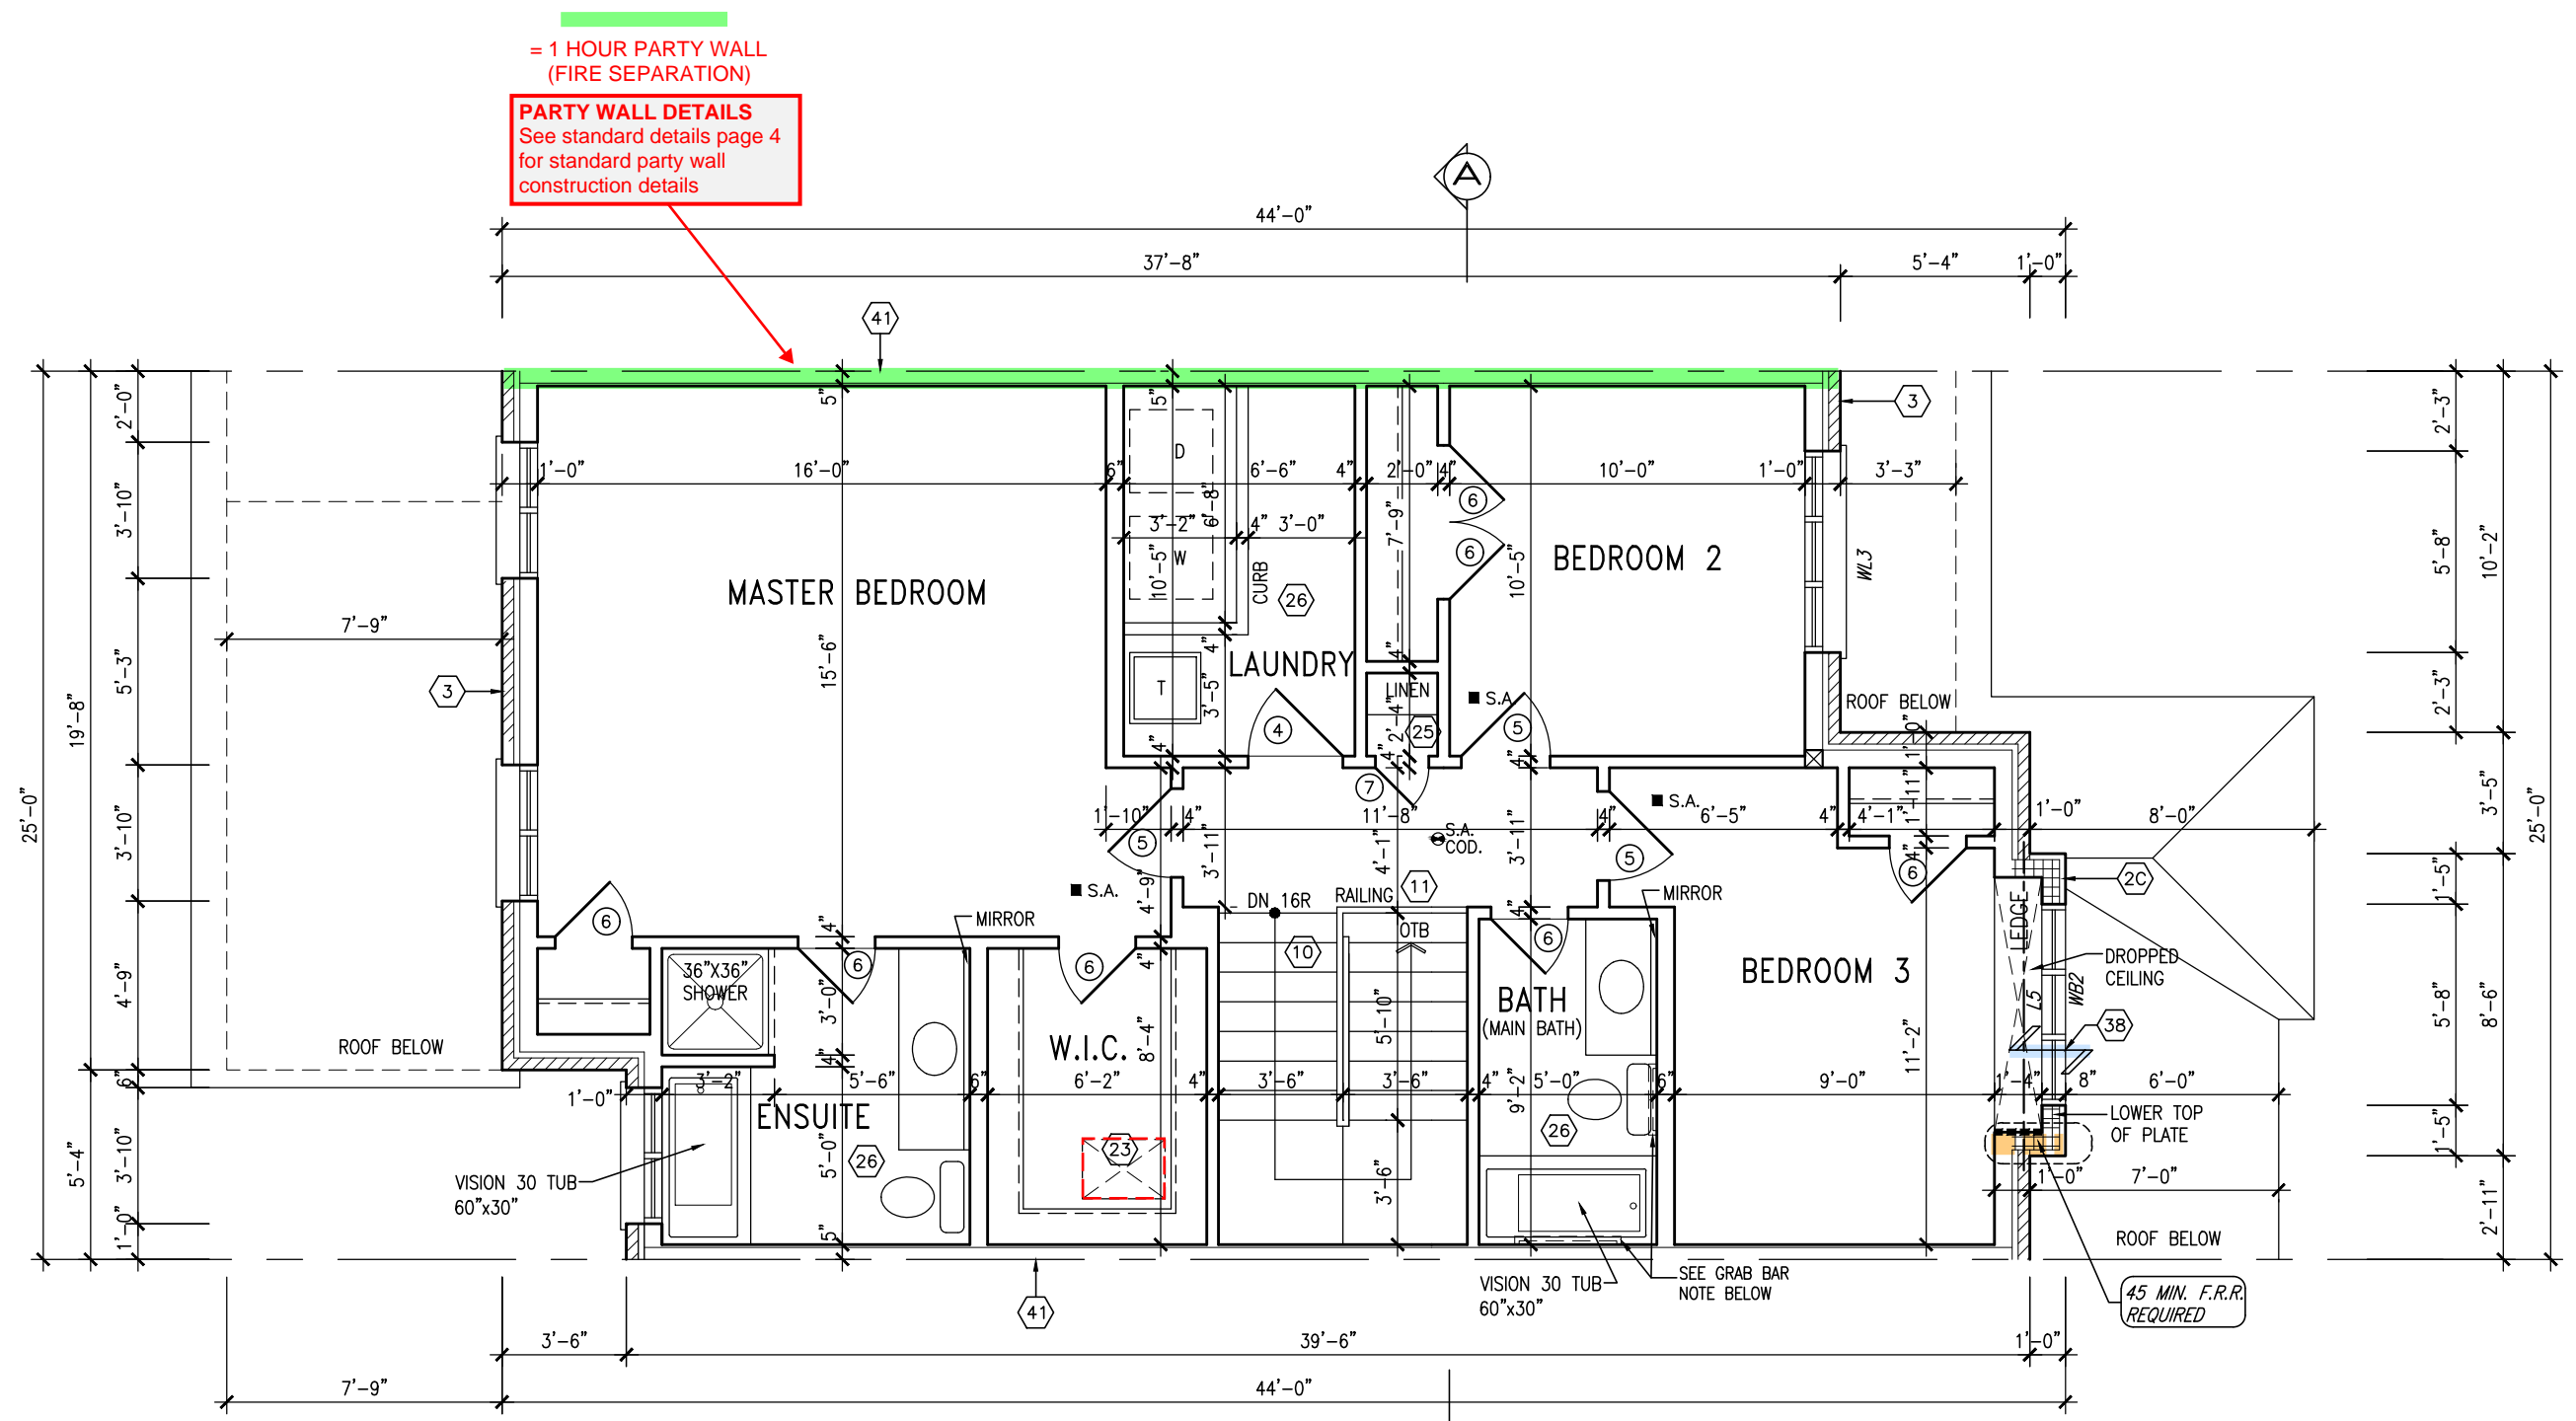

SECOND FLOOR PLAN - ELEV. 1

TOWNHOUSE MODELS
Reviewed townhouse model drawings to be read in conjunction with reviewed lot specific block drawings and engineered truss system

BATHROOM BLOCKING
See standard details page 8 for required main bathroom grab bar reinforcing

HEADER/RIM JOIST LEVEL
(FOR WALLS LESS THAN 1.2M (3'-11") FROM THE LOT LINE)
45 MINUTE FIRE RATING @ HEADER
PROVIDE 15.9mm (5/8") TYPE 'X' GYPSUM BOARD BETWEEN FLOOR JOIST AT THE HEADER OR CONTINUOUSLY ALONG THE RIM JOIST WHEN FLOOR JOISTS ARE PARALLEL TO RIM JOIST TO MAINTAIN 45 MINUTE FIRE RATING.

45 MINUTE FIRE RATED WALL
(FOR WALLS LESS THAN 1.2M (3'-11") FROM THE LOT LINE/PARTY WALL)
45 MINUTE FIRE RATED WALL
PROVIDE A CONTINUOUS LAYER OF 12.7mm (1/2") TYPE 'X' GYPSUM BOARD (INTERIOR SIDE) INSTALLED SO THAT ALL EDGES ARE SUPPORTED, TAPED AND FILLED. SPACE BETWEEN WOOD STUDS TO BE FILLED WITH INSULATION CONFORMING TO CAN/ULC-S702, "MINERAL FIBRE THERMAL INSULATION for BUILDINGS" WITH A MASS OF NOT LESS THAN 1.22 Kg/SQ.M. AND MUST FILL AT LEAST 90% OF THE CAVITY THICKNESS. THE (REFER TO SECTION SB-2 OF OBC 2012-SUPPLEMENTARY STANDARDS)
PROVIDE 1/2" EXTERIOR GRADE GYPSUM BOARD SHEATHING BEHIND SIDING (REFER TO OBC. DIV. B-9.10.14.5.(2) OR 9.10.15.5.(3))

It is the builder's complete responsibility to ensure that all plans submitted for approval fully comply with the Architectural Guidelines and all applicable regulations and requirements including zoning provisions and any provisions in the subdivision agreement. The Control Architect is not responsible in any way for examining or approving site (lotting) plans or working drawings with respect to any zoning or building code or permit matter or that any house can be properly built or located on its lot.

This is to certify that these plans comply with the applicable Architectural Design Guidelines approved by the Town of Milton.

ARCHITECTURAL REVIEW & APPROVAL
MAR 20 2017
John G. Williams, Architect

NOTE:
REFER TO BLOCK WORKING DRAWINGS FOR SECOND FLOOR STRUCTURAL INFORMATION.

STUD WALL REINFORCEMENT FOR FUTURE GRAB BARS IN MAIN BATHROOM
REINFORCEMENT OF STUD WALLS SHALL BE INSTALLED ADJACENT TO WATER CLOSETS AND SHOWER OR BATHTUB IN MAIN BATHROOM. REFER TO OBC. 9.5.2.3, 3.8.3.8.(1)(d) & 3.8.3.13.(1)(f).

TOWN OF MILTON
PLANNING AND DEVELOPMENT
IVY 3 MODEL

BUILDING: REVIEWED
SCOTT SHERRIFFS
PLANS EXAMINER
APR 18, 2017
DATE

Neither the issuance of a permit nor carrying out of inspections by the Town of Milton relieves the owner from full responsibility for compliance with the provisions of the Ontario Building Code Act and the Ontario Building Code, both as amended, as well as other applicable statutes and regulations of the Province of Ontario, By-laws of the Region of Halton and Town of Milton

RECEIVED
TOWN OF MILTON
MAR 29, 2017
IVY 3
BUILDING DIVISION

18		9	REVISED PER BLDG. DEPT. COMMENTS.	APR. 10/17	GW
17		8	ISSUED FOR PERMIT.	MAR. 01/17	GW
16		7	ISSUED FOR PRICING.	DEC. 21/16	GW
15		6	CLOSET ADDED TO MASTER BEDROOM.	OCT. 27/16	GW
14		5	REVISED. ADD SUNKEN FOYER COND.	OCT 03/16	WT
13		4	2nd FL. WINDOW PANELS. STAIR SHIFT 4".	SEP 06/16	GW
12		3	REPLACE PATIO DR w/ WINDOW	AUG 26/16	GW
11		2	REVISED PLANS & ELEVATIONS.	AUG 22/16	GW
10		1	ISSUED FOR CLIENT REVIEW.	AUG. 08/16	GW
no.	description	date	by	no.	description

The undersigned has reviewed and takes responsibility for this design and has the qualifications and meets the requirements set out in the Ontario Building Code to be a Designer.

qualification information
Richard Vink 24488
signature
VA3 Design Inc. 42658
name
registration information

Contractor must verify all dimensions on the job and report any discrepancy to the Designer before proceeding with the work. All drawings and specifications are instruments of service and the property of the Designer which must be returned at the completion of the work. Drawings are not to be scaled.

VA3 DESIGN
255 Consumers Rd Suite 120
Toronto ON M2J 1R4
t 416.630.2255 f 416.630.4782
va3design.com


Greenpark.

project name
LECCO RIDGE DEV. INC.
municipality
TOWN OF MILTON

date
2016-07
drawn by
AF
checked by
3/16" = 1'-0"
scale
16015-IVY-3
file name
16015-IVY-3

project no.
16015
drawing no.
A3

IVY 3
ENERGY STAR/ PANEL

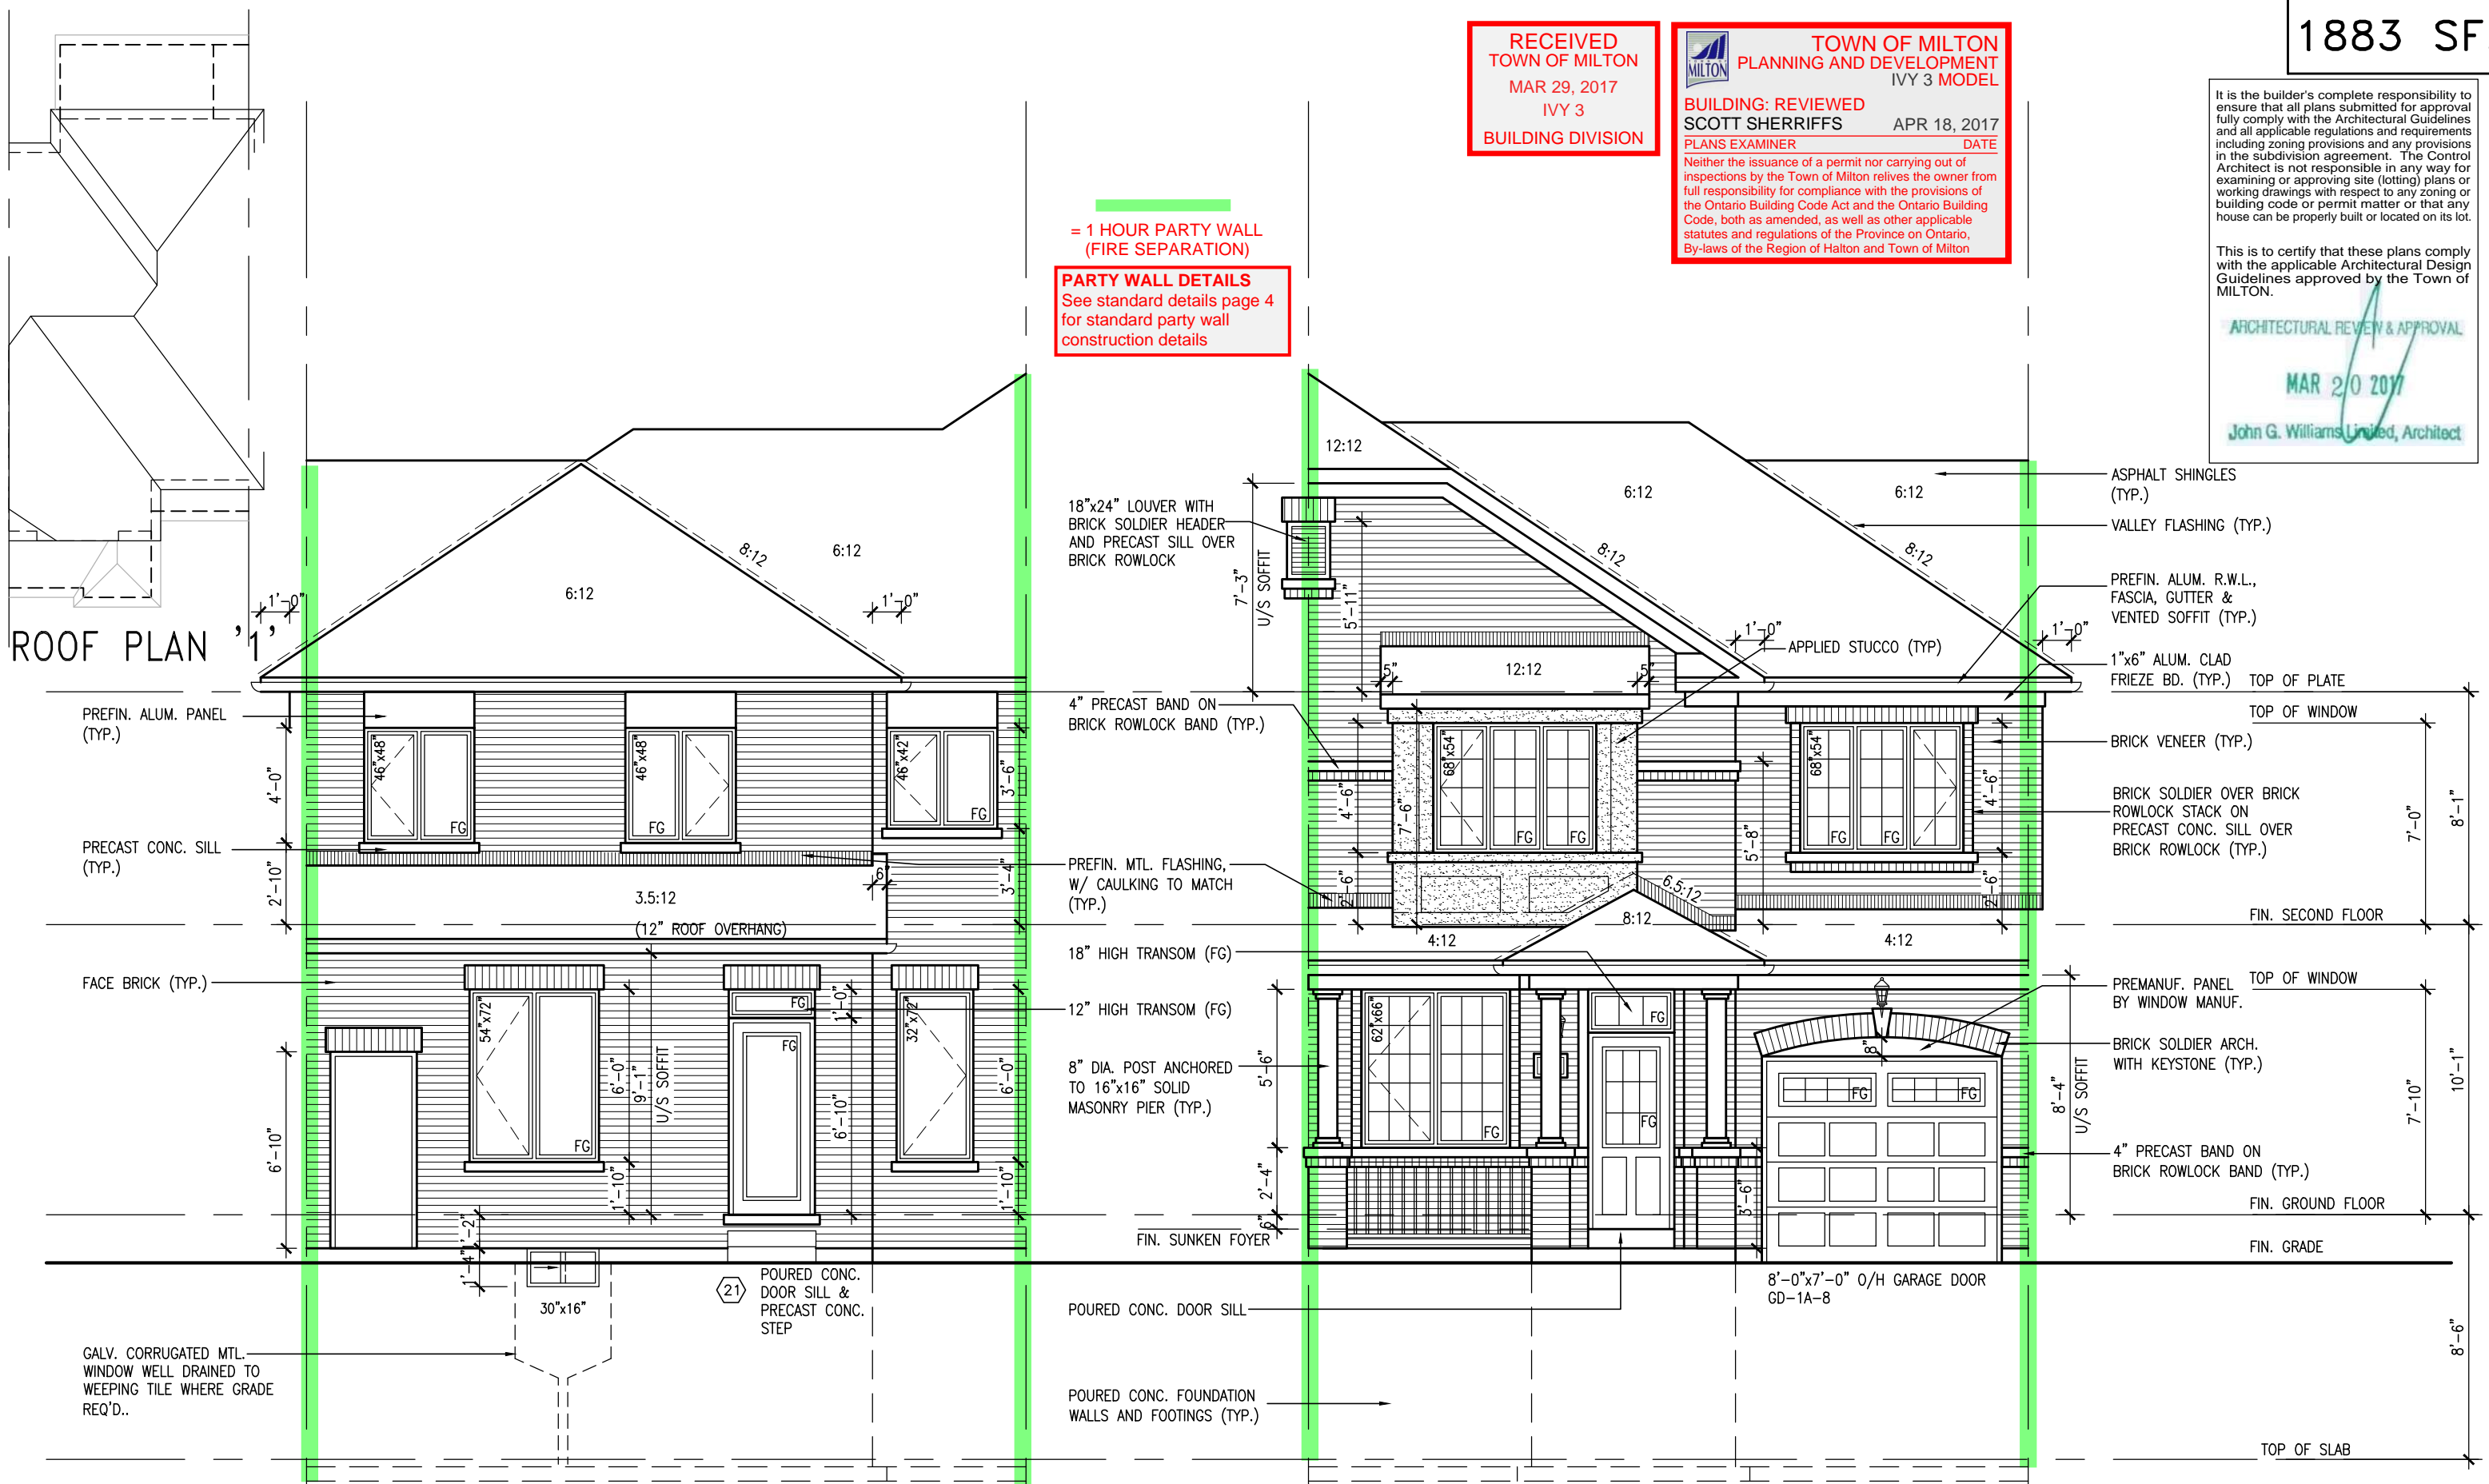

ROOF PLAN

REAR ELEVATION
ELEV. 1

FRONT ELEVATION
ELEV. 1

RECEIVED
TOWN OF MILTON
MAR 29, 2017
IVY 3
BUILDING DIVISION

TOWN OF MILTON
PLANNING AND DEVELOPMENT
IVY 3 MODEL
BUILDING: REVIEWED
SCOTT SHERRIFFS
PLANS EXAMINER
APR 18, 2017
DATE
Neither the issuance of a permit nor carrying out of
inspections by the Town of Milton relieves the owner from
full responsibility for compliance with the provisions of
the Ontario Building Code Act and the Ontario Building
Code, both as amended, as well as other applicable
statutes and regulations of the Province of Ontario,
By-laws of the Region of Halton and Town of Milton

1883 SF.

It is the builder's complete responsibility to
ensure that all plans submitted for approval
fully comply with the Architectural Guidelines
and all applicable regulations and requirements
including zoning provisions and any provisions
in the subdivision agreement. The Control
Architect is not responsible in any way for
examining or approving site (lotting) plans or
working drawings with respect to any zoning or
building code or permit matter or that any
house can be properly built or located on its lot.

This is to certify that these plans comply
with the applicable Architectural Design
Guidelines approved by the Town of
MILTON.

ARCHITECTURAL REVIEW & APPROVAL
MAR 20 2017
John G. Williams Limited, Architect

GUARDS/HANDRAILS
Shall be provided on
porches as required
based on final lot grading


ELEVATIONS NOT DRAWN TO ACTUAL GRADE.
REFER TO FINAL GRADING PLAN.
3'-6" HIGH RAILING IF PORCH SLAB
IS MORE THAN 5'-11" ABOVE FINISHED
GRADE AND 3'-0" HIGH RAILING
WHEN PORCH SLAB IS LESS THAN
5'-11" ABOVE FINISHED GRADE

18				9	REVISED PER BLDG. DEPT. COMMENTS.	APR. 10/17	GW	
17				8	ISSUED FOR PERMIT.	MAR. 01/17	GW	
16				7	ISSUED FOR PRICING.	DEC. 21/16	GW	
15				6	CLOSET ADDED TO MASTER BEDROOM.	OCT. 27/16	GW	
14				5	REVISED. ADD SUNKEN FOYER COND.	OCT 03/16	WT	
13				4	2nd FL. WINDOW PANELS. STAIR SHIFT 4".	SEP 06/16	GW	
12				3	REPLACE PATIO DR w/ WINDOW	AUG 26/16	GW	
11				2	REVISED PLANS & ELEVATIONS.	AUG 22/16	GW	
10				1	ISSUED FOR CLIENT REVIEW.	AUG. 08/16	GW	
no.	description		date	by	no.	description	date	by

The undersigned has reviewed and takes responsibility for this design
and has the qualifications and meets the requirements set out in the
Ontario Building Code to be a Designer.
qualification information
Richard Vink 24488
signature BCIN
VA3 Design Inc. 42658
Contractor must verify all dimensions on the job and report any
discrepancy to the Designer before proceeding with the work. All
drawings and specifications are instruments of service and the property
of the Designer which must be returned at the completion of the work.
Drawings are not to be scaled.

VA3
DESIGN
255 Consumers Rd Suite 120
Toronto ON M2J 1R4
t 416.630.2255 f 416.630.4782
va3design.com

Greenpark.
project name
LECCO RIDGE DEV. INC.
municipality
TOWN OF MILTON
project no.
16015
drawing no.
A4
date
2016-07
drawn by
AF
checked by
3/16" = 1'-0"
scale
16015-IVY-3
file name
16015-IVY-3
GREG - H:\ARCHIVE\WORKING\2016\16015.GRE\UNITS\IVY\IVY 3\16015-IVY-3.dwg - Mon - Apr 10 2017 - 4:12 PM

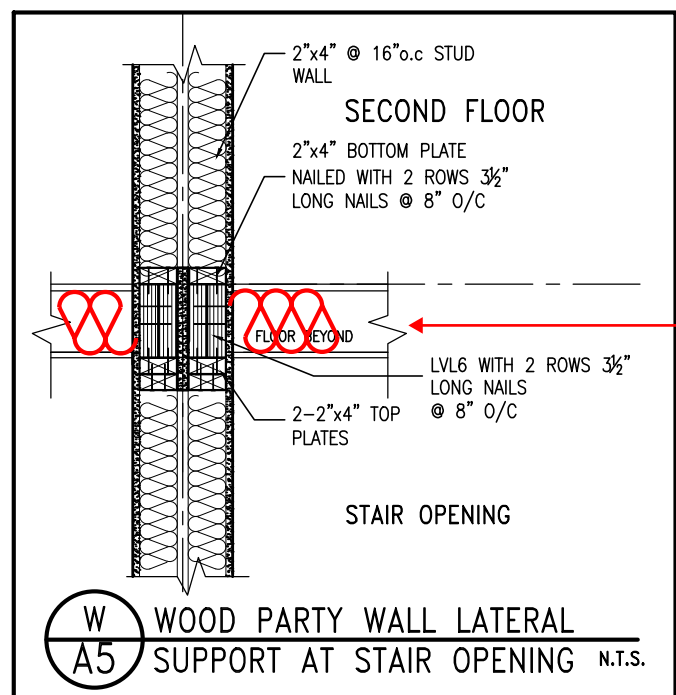

PARTY WALL SOUND RATING
Provide insulation in all joist spaces at main floors and landings to maintain required min 50 STC rating. See standard details page 4 for standard party wall construction details


RECEIVED
TOWN OF MILTON
MAR 29, 2017
IVY 3
BUILDING DIVISION

TOWN OF MILTON
PLANNING AND DEVELOPMENT
IVY 3 MODEL
BUILDING: REVIEWED
SCOTT SHERRIFFS APR 18, 2017
PLANS EXAMINER DATE
Neither the issuance of a permit nor carrying out of inspections by the Town of Milton relieves the owner from full responsibility for compliance with the provisions of the Ontario Building Code Act and the Ontario Building Code, both as amended, as well as other applicable statutes and regulations of the Province of Ontario, By-laws of the Region of Halton and Town of Milton.

1883 SF.


It is the builder's complete responsibility to ensure that all plans submitted for approval fully comply with the Architectural Guidelines and all applicable regulations and requirements including zoning provisions and any provisions in the subdivision agreement. The Control Architect is not responsible in any way for examining or approving site (lotting) plans or working drawings with respect to any zoning or building code or permit matter or that any house can be properly built or located on its lot.

This is to certify that these plans comply with the applicable Architectural Design Guidelines approved by the Town of MILTON.

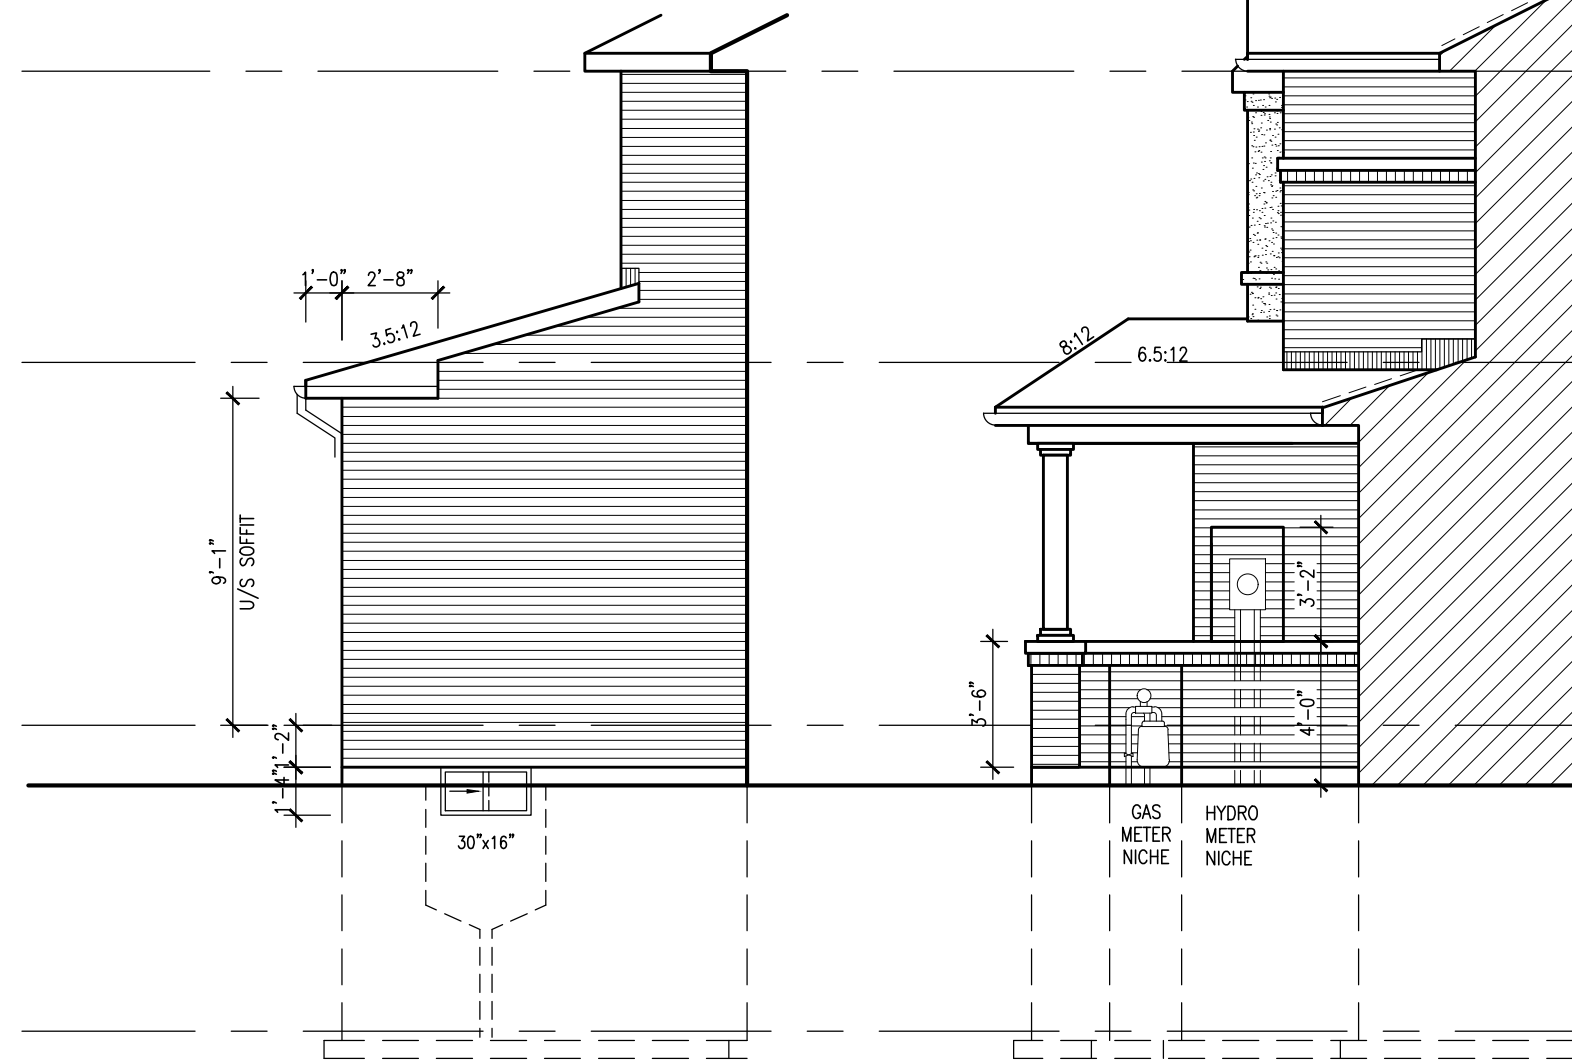

C SIDE ELEV.
ALLOWABLE GLAZED OPENINGS
WALL AREA =152.73 SQ. FT.
LIMITING DISTANCE 1.5 M (10%)
GLAZING ALLOWED =15.27 SQ. FT.
GLAZING PROVIDED =2.44 SQ. FT. (GLASS AREA ONLY)

SECTION B

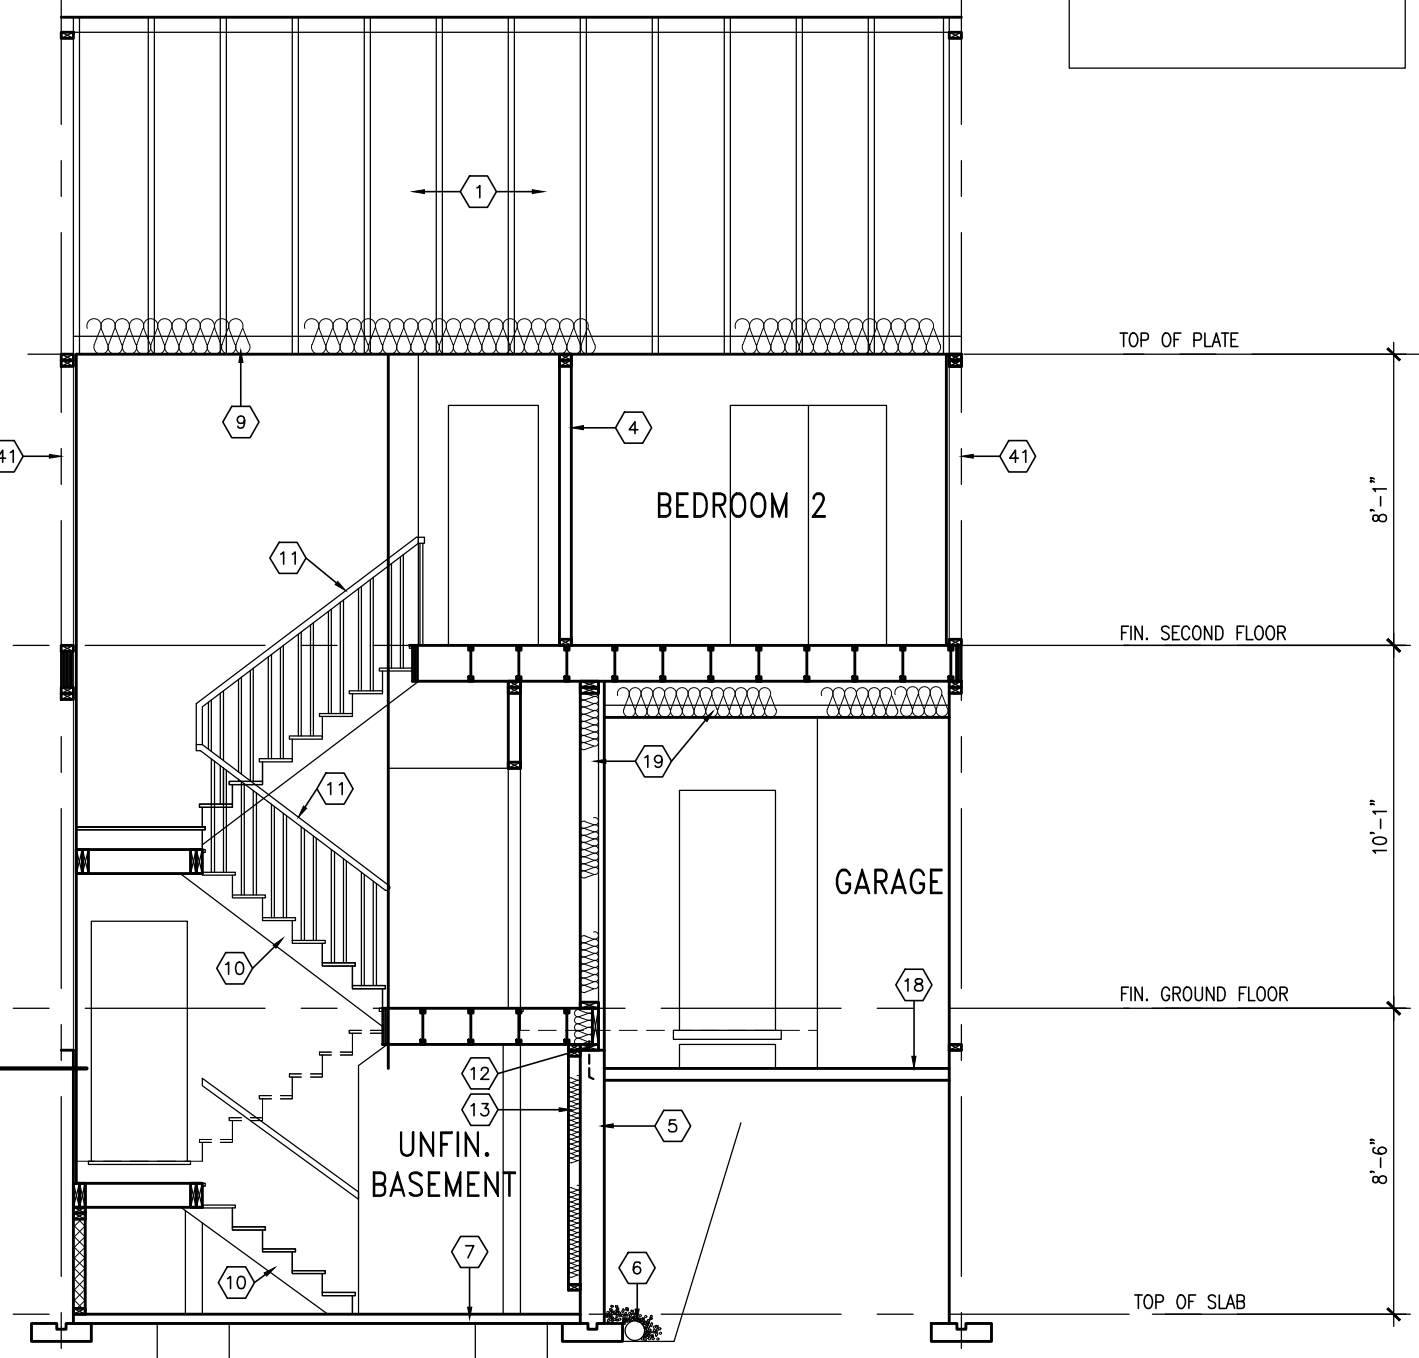

SECTION A-A ELEV. 1



18			9	REVISED PER BLDG. DEPT. COMMENTS.	APR. 10/17	GW
17			8	ISSUED FOR PERMIT.	MAR. 01/17	GW
16			7	ISSUED FOR PRICING.	DEC. 21/16	GW
15			6	CLOSET ADDED TO MASTER BEDROOM.	OCT. 27/16	GW
14			5	REVISED. ADD SUNKEN FOYER COND.	OCT. 03/16	WT
13			4	2nd FL. WINDOW PANELS. STAIR SHIFT 4".	SEP 06/16	GW
12			3	REPLACE PATIO DR w/ WINDOW	AUG 26/16	GW
11			2	REVISED PLANS & ELEVATIONS.	AUG 22/16	GW
10			1	ISSUED FOR CLIENT REVIEW.	AUG. 08/16	GW
no. description	date	by	no. description	date	by	

The undersigned has reviewed and takes responsibility for this design and has the qualifications and meets the requirements set out in the Ontario Building Code to be a Designer.
qualification information
Richard Vink 24488
signature BCIN
name registration information
VA3 Design Inc. 42658
Contractor must verify all dimensions on the job and report any discrepancy to the Designer before proceeding with the work. All drawings and specifications are instruments of service and the property of the Designer which must be returned at the completion of the work. Drawings are not to be scaled.

VA3 DESIGN
255 Consumers Rd Suite 120
Toronto ON M2J 1R4
t 416.630.2255 f 416.630.4782
va3design.com

Greenpark.
project name
LECCO RIDGE DEV. INC. municipality
TOWN OF MILTON
date
2016-07
drawn by
AF
checked by
3/16" = 1'-0"
scale
file name
16015-IVY-3
drawing no.
A5
SECTION A-A ELEV. 1
project no.
16015
IVY 3
ENERGY STAR/ PANEL

It is the builder's complete responsibility to ensure that all plans submitted for approval fully comply with the Architectural Guidelines and all applicable regulations and requirements including zoning provisions and any provisions in the subdivision agreement. The Control Architect is not responsible in any way for examining or approving site (lotting) plans or working drawings with respect to any zoning or building code or permit matter or that any house can be properly built or located on its lot.

This is to certify that these plans comply with the applicable Architectural Design Guidelines approved by the Town of MILTON.

MAR 2/0 2017

John G. Williams Limited, Architect

= 1 HOUR PARTY WALL
(FIRE SEPARATION)

PARTY WALL DETAILS
See standard details page 4
for standard party wall
construction details

PART. GROUND FLOOR PLAN
W.O.D CONDITION (8R OR MORE)

DECK DETAILS
See standard details pages
and 5-2 for additional deck
construction details

UPGRADE WINDOW WITH
MIN. 4'-6" FIN. FIRST -
FLOOR TO GRADE
CONDITION.

REFER TO PRECAST —
MANUF. FOR
SUPPORT DETAILS

PART. BASEMENT PLAN W.O.D
CONDITION (7R MAX.)

VENEER CUT
WHEN VENEER CUT IS GREATER
THAN 26", A 10" POURED
CONCRETE FOUNDATION WALL IS
REQUIRED.

PART. GROUND FLOOR PLAN
W.O.D CONDITION (7R MAX.)

RECEIVED
TOWN OF MILTON
MAR 29, 2017
IVY 3
BUILDING DIVISION



TOWN OF MILTON
PLANNING AND DEVELOPMENT
IVY 3 MODEL

BUILDING: REVIEWED

SCOTT SHERRIFFS


APR 18, 2017

PLANS EXAMINER

DATE

IVY 3
ENERGY STAR/ PANEL

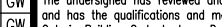

18					9 REVISED PER BLDG. DEPT. COMMENTS.	APR. 10/17 GW	The undersigned has reviewed and takes responsibility for this design and has the qualifications and meets the requirements set out in the Ontario Building Code to be a Designer. qualification information 	2448-
17					8 ISSUED FOR PERMIT.	MAR. 01/17 GW		BC
16					7 ISSUED FOR PRICING.	DEC. 21/16 GW		
15					6 CLOSET ADDED TO MASTER BEDROOM.	OCT. 27/16 GW	Richard Vink name registration information VA3 Design Inc.	4265
14					5 REVISED. ADD SUNKEN FOYER COND.	OCT 03/16 WT		
13					4 2nd FL. WINDOW PANELS. STAIR SHIFT 4".	SEP 06/16 GW		
12					3 REPLACE PATIO DR w/ WINDOW	AUG 26/16 GW		
11					2 REVISED PLANS & ELEVATIONS.	AUG 22/16 GW		
10					1 ISSUED FOR CLIENT REVIEW.	AUG. 08/16 GW	Contractor must verify all dimensions on the job and report any discrepancy to the Designer before proceeding with the work. All drawings and specifications are instruments of service and the property of the Designer which must be returned at the completion of the work. Items are not to be scaled.	
no.	description		date	bv	no.	description	date	bv



VA3
DESIGN

255 Consumers Rd Suite 120
Toronto ON M2J 1R4
t 416.630.2255 f 416.630.4782
va3design.com



project name LECCO RIDGE DEV. INC.	municipality TOWN OF MILTON	project no. 16015
date 2016-07		drawing no. A6
PART. PLANS - DECK CONDITION		
drawn by AF	checked by -	
scale 3/16" = 1'-0"		file name 16015-IVY-3
GREF - H:\ARCHIVE\WORKING\2016\16015 GREF\UNITS\IVY\IVY_3\16015-IVY-3.dwg - Mon - Apr 10 2017 - 4:13 PM		

All drawings specifications, related documents and design are the copyright property of VA3 DESIGN. Reproduction of this property in whole or in part is strictly prohibited without VA3 DESIGN's written permission.

RECEIVED
TOWN OF MILTON
MAR 29, 2017
IVY 3
BUILDING DIVISION

TOWN OF MILTON
PLANNING AND DEVELOPMENT
IVY 3 MODEL
BUILDING: REVIEWED
SCOTT SHERRIFFS
APR 18, 2017
PLANS EXAMINER
DATE
Neither the issuance of a permit nor carrying out of
inspections by the Town of Milton relieves the owner from
full responsibility for compliance with the provisions of
the Ontario Building Code Act and the Ontario Building
Code, both as amended, as well as other applicable
statutes and regulations of the Province of Ontario,
By-laws of the Region of Halton and Town of Milton


1883 SF.

It is the builder's complete responsibility to
ensure that all plans submitted for approval
fully comply with the Architectural Guidelines
and all applicable regulations and requirements
including zoning provisions and any provisions
in the subdivision agreement. The Control
Architect is not responsible in any way for
examining or approving site (lotting) plans or
working drawings with respect to any zoning or
building code or permit matter or that any
house can be properly built or located on its lot.

This is to certify that these plans comply
with the applicable Architectural Design
Guidelines approved by the Town of
MILTON.


ARCHITECTURAL REVIEW & APPROVAL
MAR 20 2017
John G. Williams Limited, Architect

= 1 HOUR PARTY WALL
(FIRE SEPARATION)
PARTY WALL DETAILS
See standard details page 4
for standard party wall
construction details

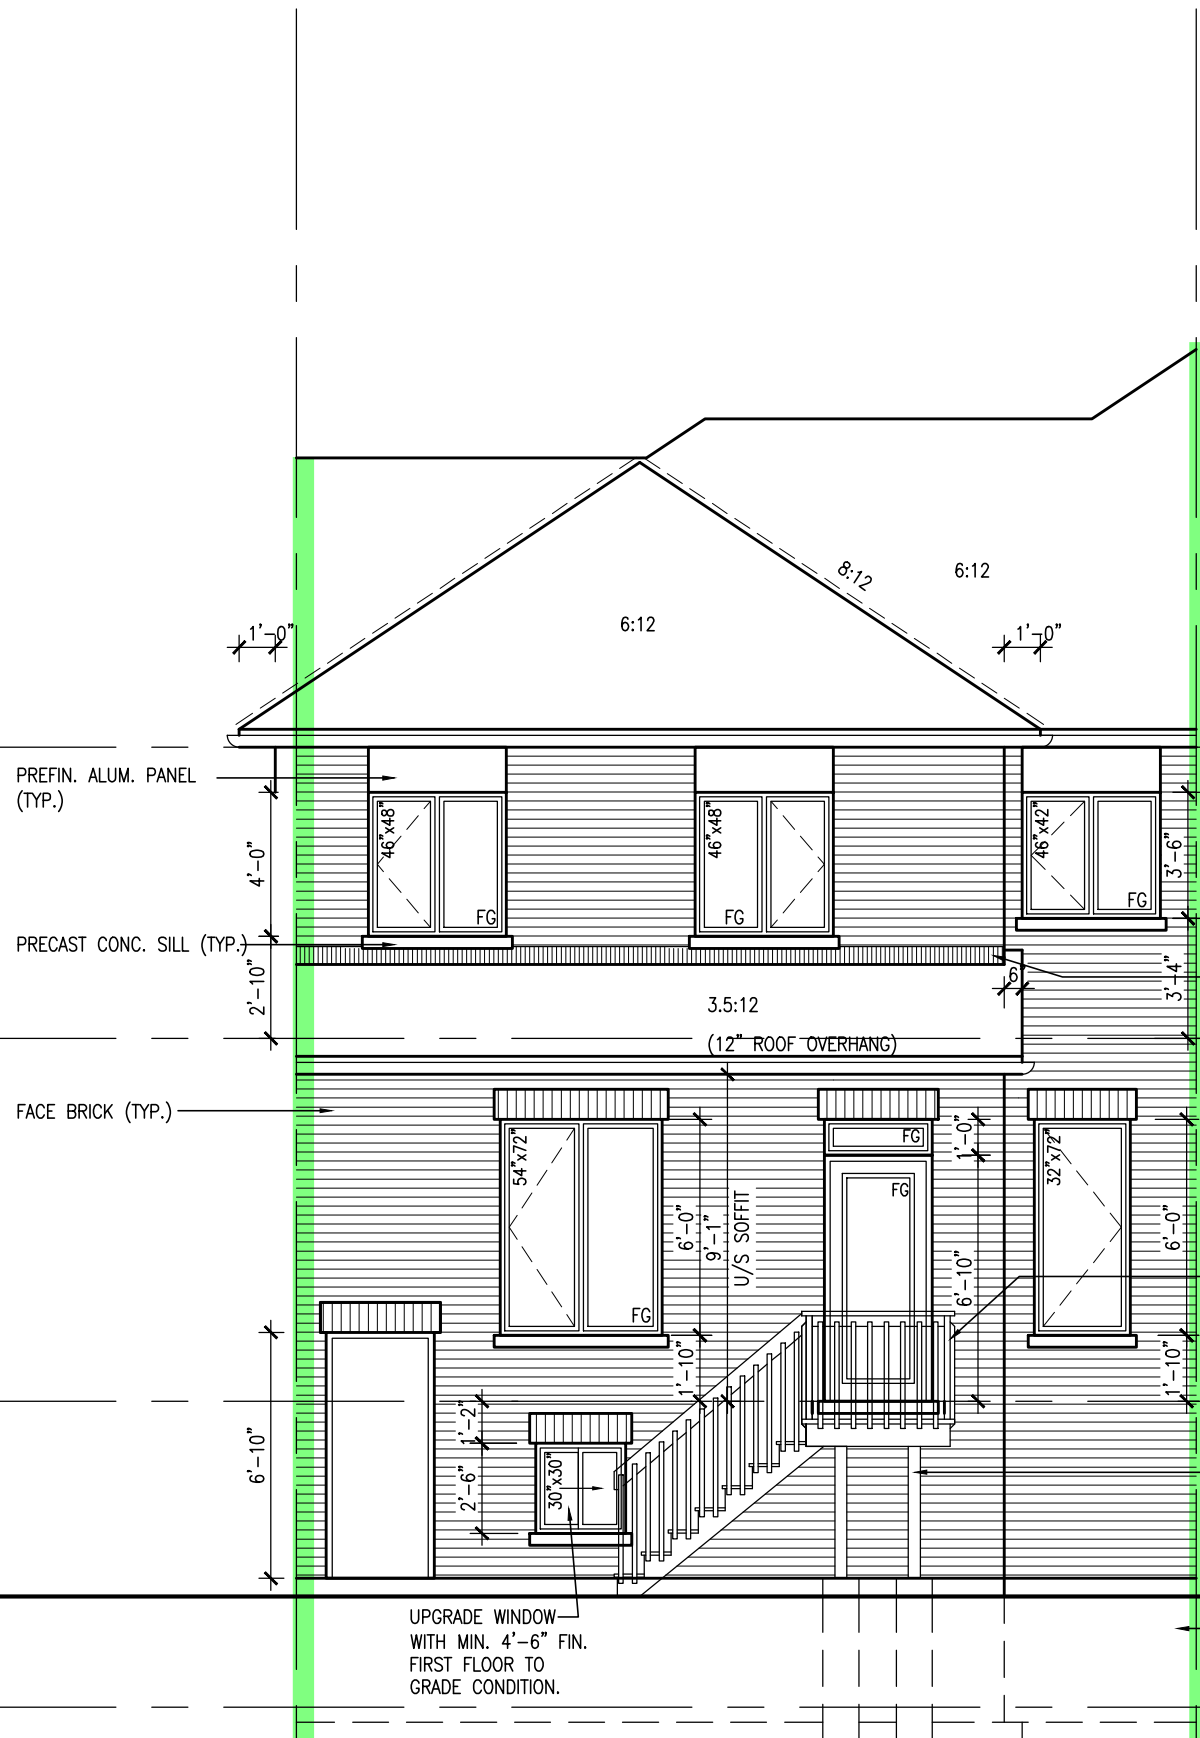

REAR ELEVATION ELEV. 1
DECK CONDITION (8R OR MORE)

DECK DETAILS
See standard details pages 5
and 5-2 for additional deck
construction details

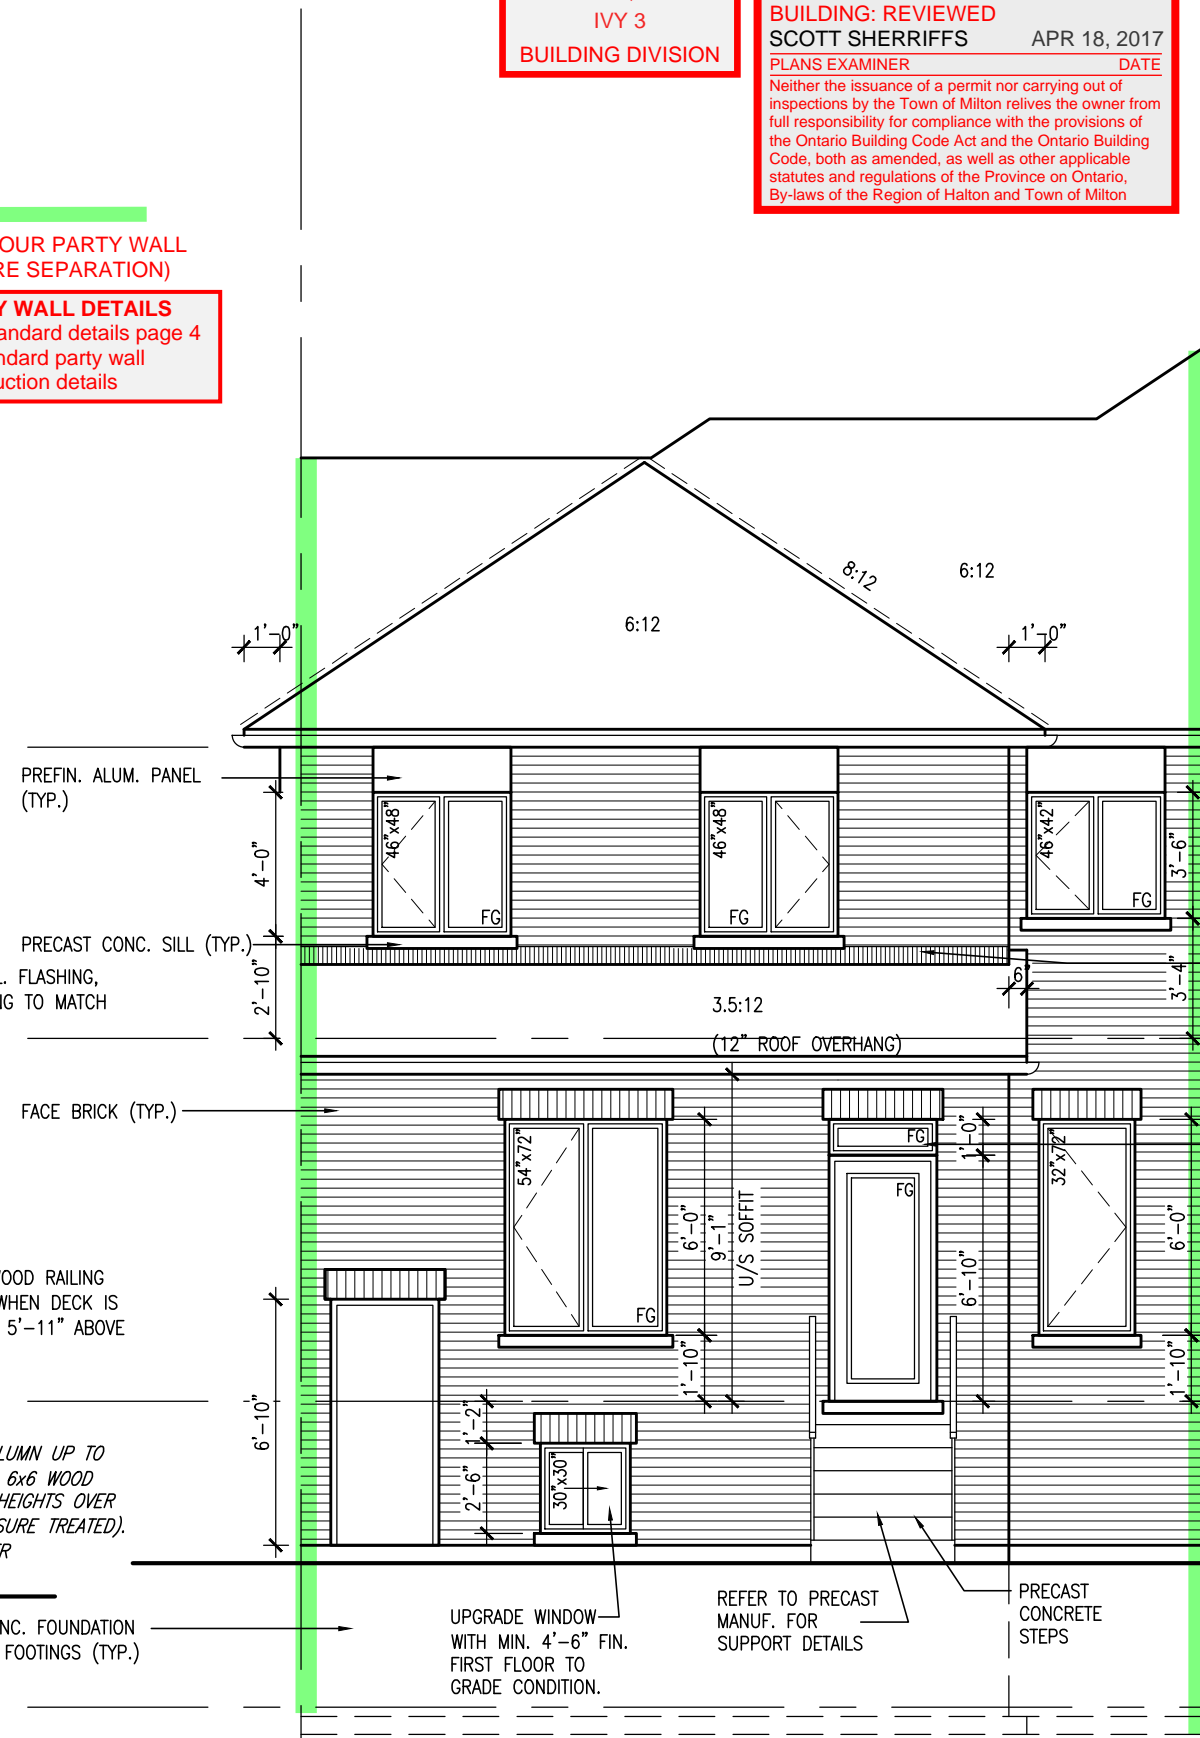

REAR ELEVATION ELEV. 1
DECK CONDITION (7R MAX.)

PRECAST STAIR/LANDING
Refer to master specifications
for anchorage details for
Parson's precast stair/landing

IVY 3
ENERGY STAR/ PANEL

18				9	REVISED PER BLDG. DEPT. COMMENTS.	APR. 10/17	GW
17				8	ISSUED FOR PERMIT.	MAR. 01/17	GW
16				7	ISSUED FOR PRICING.	DEC. 21/16	GW
15				6	CLOSET ADDED TO MASTER BEDROOM.	OCT. 27/16	GW
14				5	REVISED. ADD SUNKEN FOYER COND.	OCT 03/16	WT
13				4	2nd FL. WINDOW PANELS. STAIR SHIFT 4".	SEP 06/16	GW
12				3	REPLACE PATIO DR w/ WINDOW	AUG 26/16	GW
11				2	REVISED PLANS & ELEVATIONS.	AUG 22/16	GW
10				1	ISSUED FOR CLIENT REVIEW.	AUG. 08/16	GW
no.	description	date	by	no.	description	date	by


The undersigned has reviewed and takes responsibility for this design
and has the qualifications and meets the requirements set out in the
Ontario Building Code to be a Designer.
qualification information
Richard Vink 24488
name signature BCIN
registration information
VA3 Design Inc. 42658
Contractor must verify all dimensions on the job and report any
discrepancy to the Designer before proceeding with the work. All
drawings and specifications are instruments of service and the property
of the Designer which must be returned at the completion of the work.
Drawings are not to be scaled.

VA3
DESIGN
255 Consumers Rd Suite 120
Toronto ON M2J 1R4
t 416.630.2255 f 416.630.4782
va3design.com

Greenpark.
project name
LECCO RIDGE DEV. INC.
municipality
TOWN OF MILTON
date
2016-07
drawn by
AF
checked by
scale
3/16" = 1'-0"
file name
16015-IVY-3
drawing no.
A7

IVY 3
-
project no.
16015
drawing no.
A7

1871 SF.

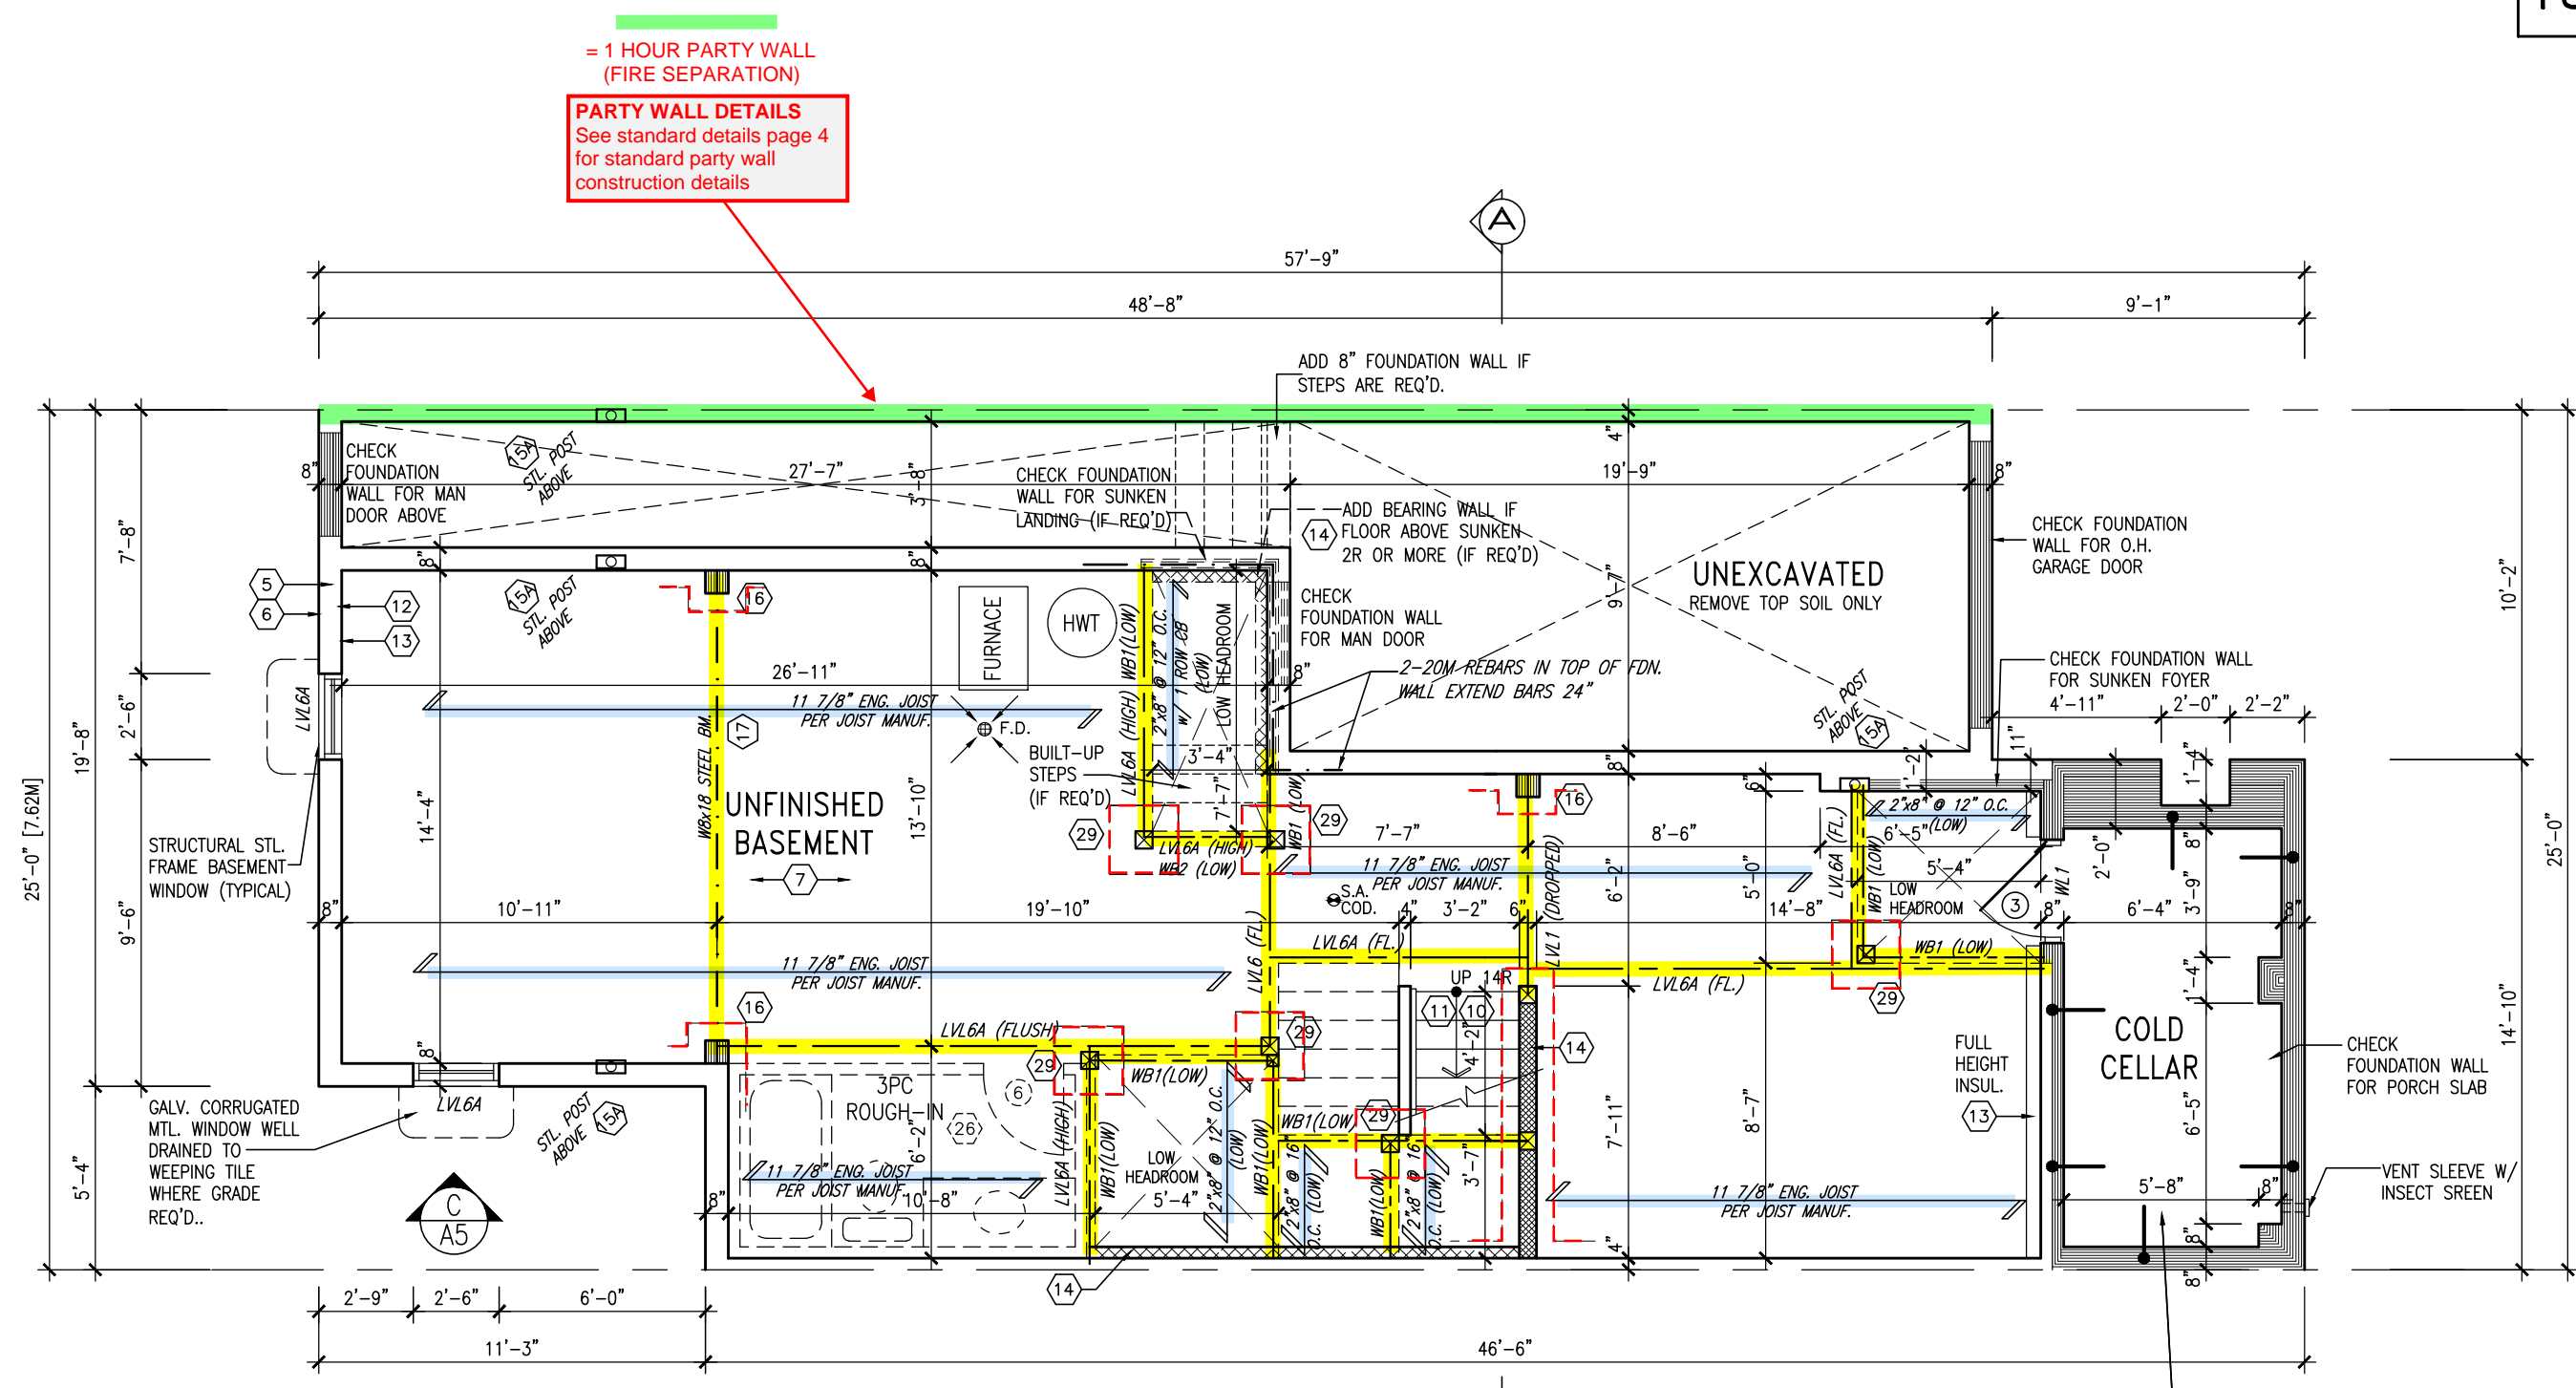

BASEMENT PLAN - ELEV. 2

ENGINEERED FLOOR FRAMING INFO
REFER TO ENGINEERED FLOOR LAYOUTS FOR
ALL FLOOR FRAMING INFORMATION AND DETAILS.
UNLESS OTHERWISE NOTED.

ENGINEERED FLOOR SYSTEM
Reviewed model drawings to be
read in conjunction with reviewed
engineered floor system layout

COLD STORAGE SLAB
5" REINFORCED CONCRETE SLAB
WITH 10M BARS @ 7 7/8" O.C.
EACH WAY WITH MIN. 1 1/4"
CONC. COVER AND 10M BENT
(24"x24") DOWELS SPACED NOT
MORE THAN 23 5/8" O.C.

It is the builder's complete responsibility to
ensure that all plans submitted for approval
fully comply with the Architectural Guidelines
and all applicable regulations and requirements
including zoning provisions and any provisions
in the subdivision agreement. The Control
Architect is not responsible in any way for
examining or approving site (lotting) plans or
working drawings with respect to any zoning or
building code or permit matter or that any
house can be properly built or located on its lot.

This is to certify that these plans comply
with the applicable Architectural Design
Guidelines approved by the Town of
MILTON.

ARCHITECTURAL REVIEW & APPROVAL
MAR 20 2017
John G. Williams Limited, Architect



TOWN OF MILTON
PLANNING AND DEVELOPMENT
IVY 3 MODEL
BUILDING: REVIEWED
SCOTT SHERRIFFS APR 18, 2017
PLANS EXAMINER DATE
Neither the issuance of a permit nor carrying out of
inspections by the Town of Milton relieves the owner from
full responsibility for compliance with the provisions of
the Ontario Building Code Act and the Ontario Building
Code, both as amended, as well as other applicable
statutes and regulations of the Province of Ontario,
By-laws of the Region of Halton and Town of Milton


RECEIVED
TOWN OF MILTON
MAR 29, 2017
IVY 3
BUILDING DIVISION

no.	description	date	by	no.	description	date	by
18				9	REVISED PER BLDG. DEPT. COMMENTS.	APR. 10/17	GW
17				8	ISSUED FOR PERMIT.	MAR. 01/17	GW
16				7	ISSUED FOR PRICING.	DEC. 21/16	GW
15				6	CLOSET ADDED TO MASTER BEDROOM.	OCT. 27/16	GW
14				5	REVISED. ADD SUNKEN FOYER COND.	OCT. 03/16	WT
13				4	2nd FL. WINDOW PANELS. STAIR SHIFT 4".	SEP 06/16	GW
12				3	REPLACE PATIO DR w/ WINDOW	AUG 26/16	GW
11				2	REVISED PLANS & ELEVATIONS.	AUG 22/16	GW
10				1	ISSUED FOR CLIENT REVIEW.	AUG. 08/16	GW

The undersigned has reviewed and takes responsibility for this design
and has the qualifications and meets the requirements set out in the
Ontario Building Code to be a Designer.
qualification information
Richard Vink 24488
signature
name
registration information
VA3 Design Inc. 42658
Contractor must verify all dimensions on the job and report any
discrepancy to the Designer before proceeding with the work. All
drawings and specifications are instruments of service and the property
of the Designer which must be returned at the completion of the work.
Drawings are not to be scaled.

VA3
DESIGN
255 Consumers Rd Suite 120
Toronto ON M2J 1R4
t 416.630.2255 f 416.630.4782
va3design.com

		IVY 3	
project name LECCO RIDGE DEV. INC.		project no. 16015	
municipality TOWN OF MILTON		drawing no. A1a	
date 2016-07	checked by AF	scale 3/16" = 1'-0"	file name 16015-IVY-3
BASEMENT PLAN - ELEV. 2			
GREG - H:\ARCHIVE\WORKING\2016\16015\GRE\UNITS\IVY\IVY 3\16015-IVY-3.dwg - Mon - Apr 10 2017 - 4:13 PM			

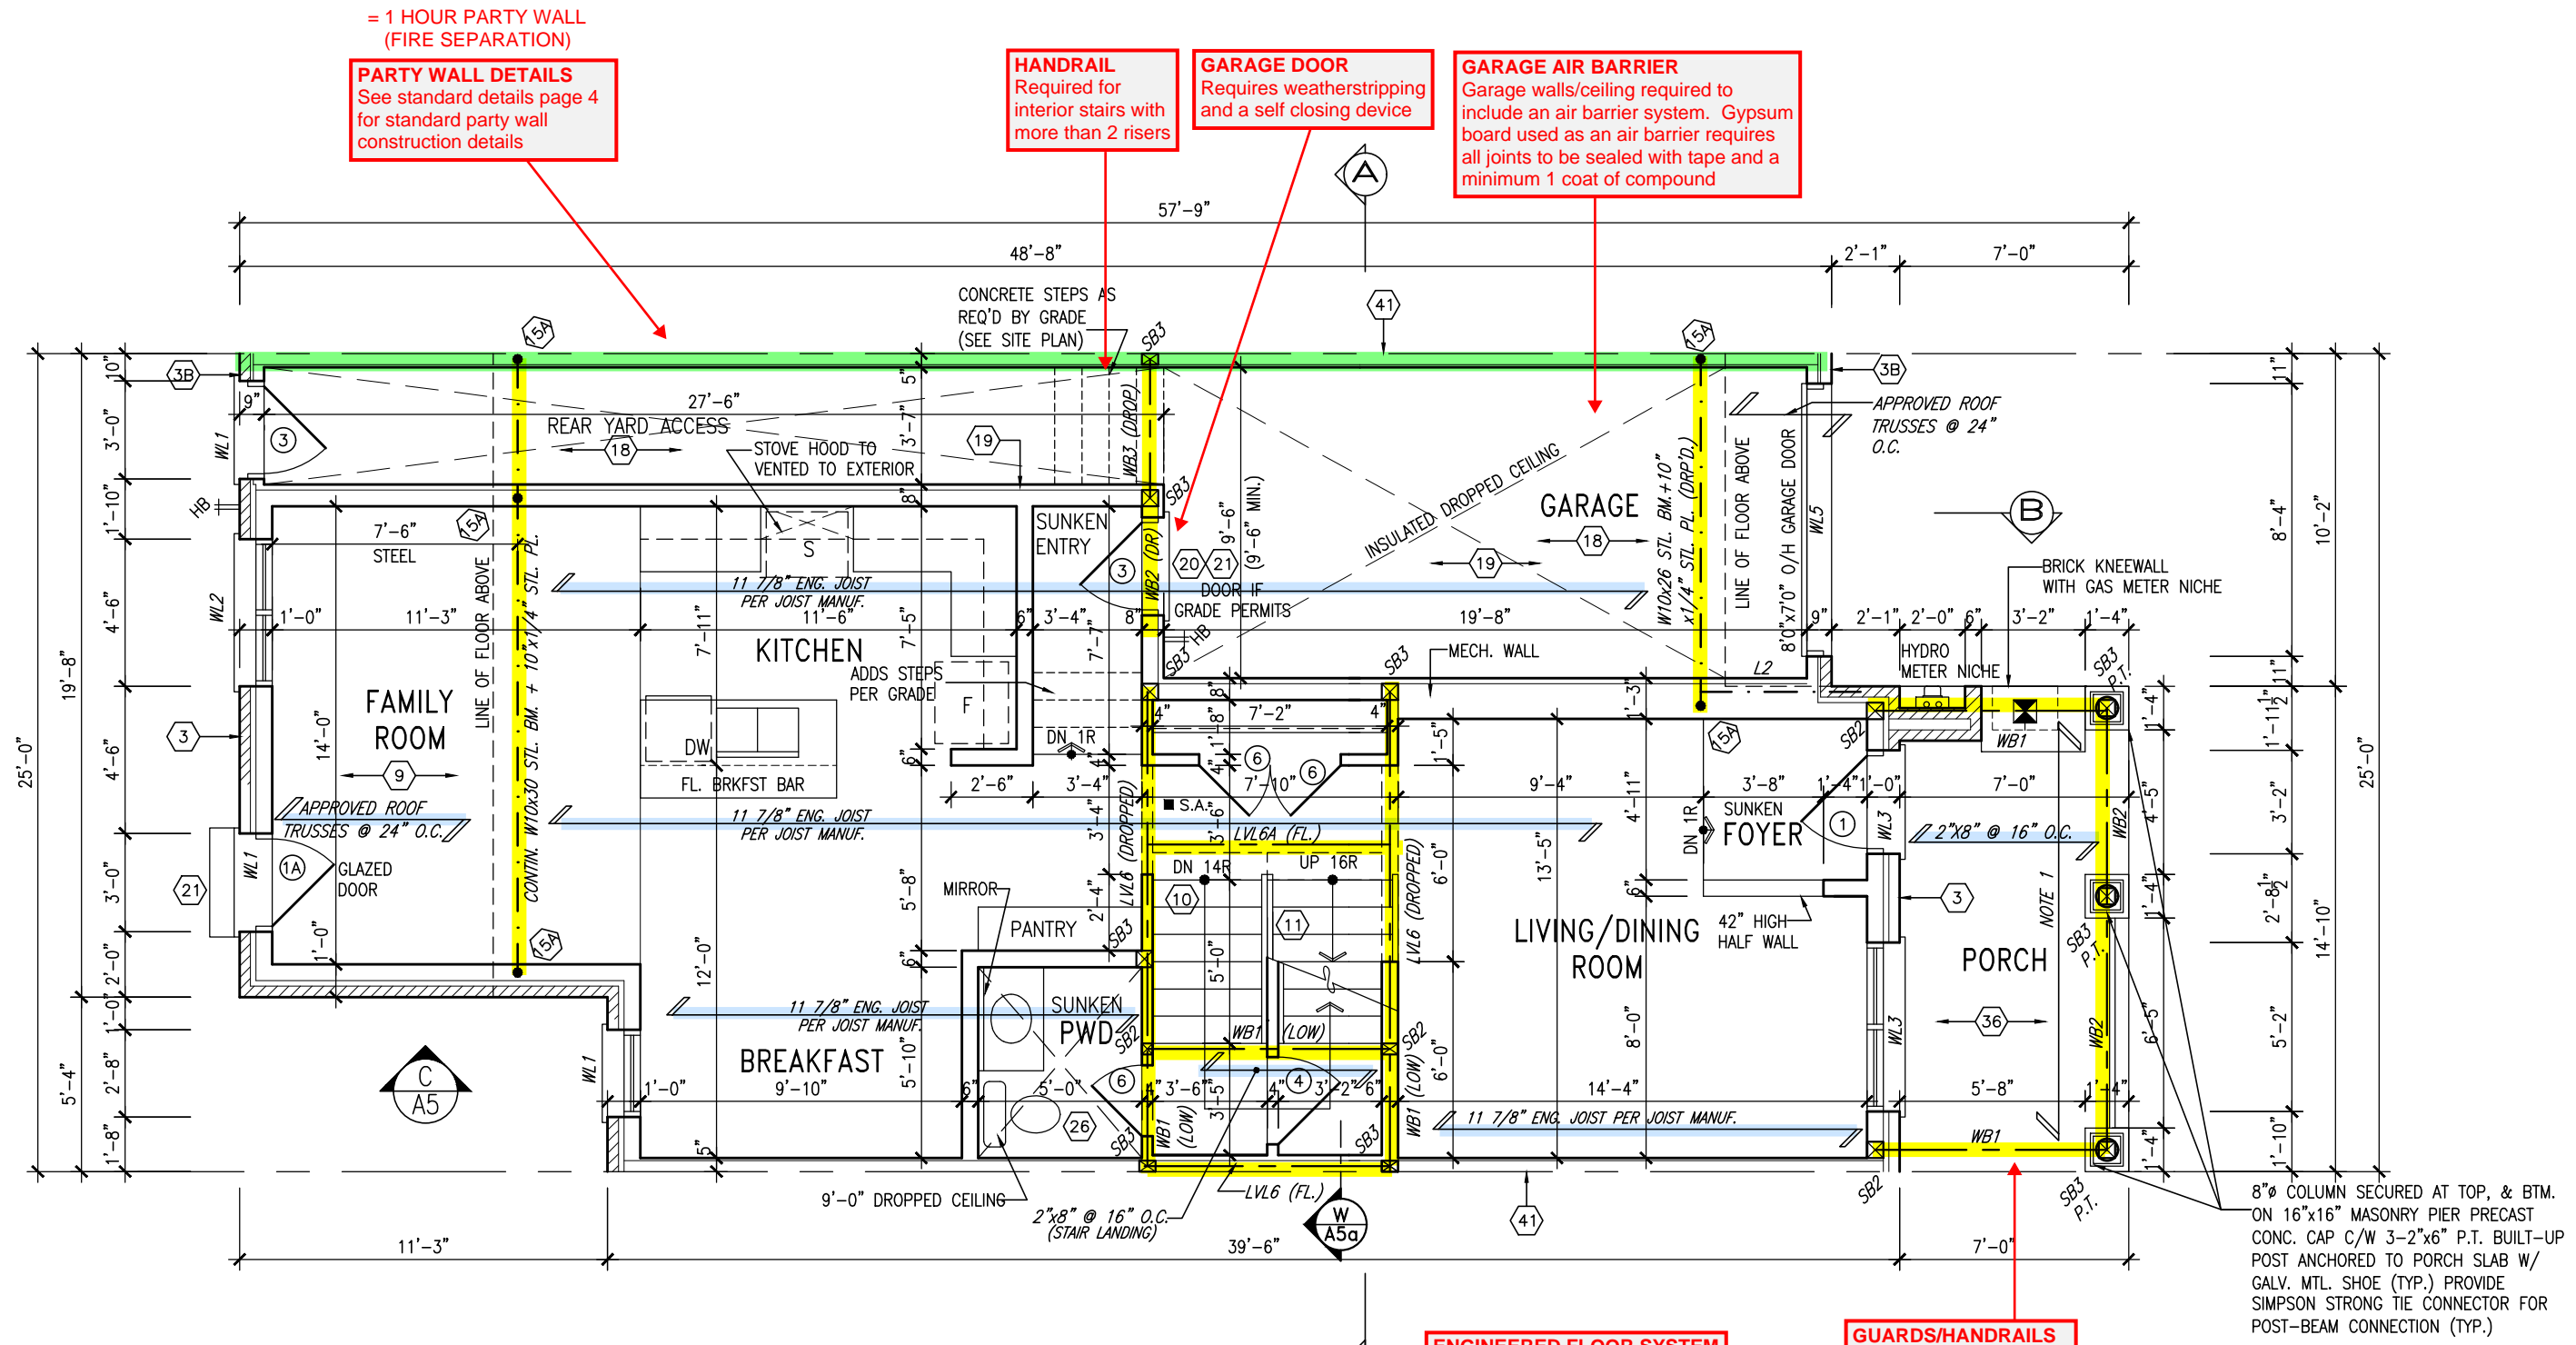

GROUND FLOOR PLAN - ELEV. 2

ALL GARAGE SLABS, PORCH SLABS, STAIRS (EXPOSED CONC. FLAT WORK) TO BE 32 MPa WITH 5-8% AIR ENTRAINMENT.

NOTE: ROOF FRAMING
ROOF TRUSS INFORMATION REFER TO ROOF TRUSS SHOP DRAWINGS FOR ALL ROOF FRAMING INFORMATION UNLESS OTHERWISE NOTED.

ENGINEERED FLOOR FRAMING INFO
REFER TO ENGINEERED FLOOR LAYOUTS FOR ALL FLOOR FRAMING INFORMATION AND DETAILS. UNLESS OTHERWISE NOTED.

RECEIVED
TOWN OF MILTON
MAR 29, 2017
IVY 3
BUILDING DIVISION

TOWN OF MILTON
PLANNING AND DEVELOPMENT
IVY 3 MODEL
BUILDING: REVIEWED
SCOTT SHERRIFFS APR 18, 2017
PLANS EXAMINER DATE
Neither the issuance of a permit nor carrying out of inspections by the Town of Milton relieves the owner from full responsibility for compliance with the provisions of the Ontario Building Code Act and the Ontario Building Code, both as amended, as well as other applicable statutes and regulations of the Province of Ontario, By-laws of the Region of Halton and Town of Milton

NOTE 1:
FLAT ROOF FRAMING (TYP.)
2"x8" @ 12" O.C. P.T. CLG. JST.
w/ 2"x4" @ 12" O.C. P.T.
DIAGONALLY CUT CROSS PURLINS
w/ 5/8" EXTERIOR GRADE
SHEATHING + SINGLE PLY ROOF
MEMBRANE (SLOPE TO DRAIN)

It is the builder's complete responsibility to ensure that all plans submitted for approval fully comply with the Architectural Guidelines and all applicable regulations and requirements including zoning provisions and any provisions in the subdivision agreement. The Control Architect is not responsible in any way for examining or approving site (lotting) plans or working drawings with respect to any zoning or building code or permit matter or that any house can be properly built or located on its lot.

This is to certify that these plans comply with the applicable Architectural Design Guidelines approved by the Town of MILTON.

ARCHITECTURAL REVIEW & APPROVAL
MAR 20 2017
John G. Williams, Limited, Architect

IVY 3
ENERGY STAR/ PANEL




18			9	REVISED PER BLDG. DEPT. COMMENTS.	APR. 10/17	GW
17			8	ISSUED FOR PERMIT.	MAR. 01/17	GW
16			7	ISSUED FOR PRICING.	DEC. 21/16	GW
15			6	CLOSET ADDED TO MASTER BEDROOM.	OCT. 27/16	GW
14			5	REVISED. ADD SUNKEN FOYER COND.	OCT 03/16	WT
13			4	2nd FL. WINDOW PANELS. STAIR SHIFT 4".	SEP 06/16	GW
12			3	REPLACE PATIO DR w/ WINDOW	AUG 26/16	GW
11			2	REVISED PLANS & ELEVATIONS.	AUG 22/16	GW
10			1	ISSUED FOR CLIENT REVIEW.	AUG. 08/16	GW
no. description	date	by	no. description	date	by	

The undersigned has reviewed and takes responsibility for this design and has the qualifications and meets the requirements set out in the Ontario Building Code to be a Designer.
qualification information
Richard Vink 24488
signature BCIN
name registration information
VA3 Design Inc. 42658
Contractor must verify all dimensions on the job and report any discrepancy to the Designer before proceeding with the work. All drawings and specifications are instruments of service and the property of the Designer which must be returned at the completion of the work. Drawings are not to be scaled.

VA3 DESIGN
255 Consumers Rd Suite 120
Toronto ON M2J 1R4
t 416.630.2255 f 416.630.4782
va3design.com

Greenpark.		IVY 3	
LECCO RIDGE DEV. INC.		TOWN OF MILTON	
project name	LECCO RIDGE DEV. INC.	project no.	16015
date	2016-07	drawing no.	A2a
drawn by	AF	checked by	3/16" = 1'-0"
scale	3/16" = 1'-0"	file name	16015-IVY-3
GREG - H:\ARCHIVE\WORKING\2016\16015.GRE\UNITS\IVY\IVY 3\16015-IVY-3.dwg - Mon - Apr 10 2017 - 4:13 PM			

1871 SF.

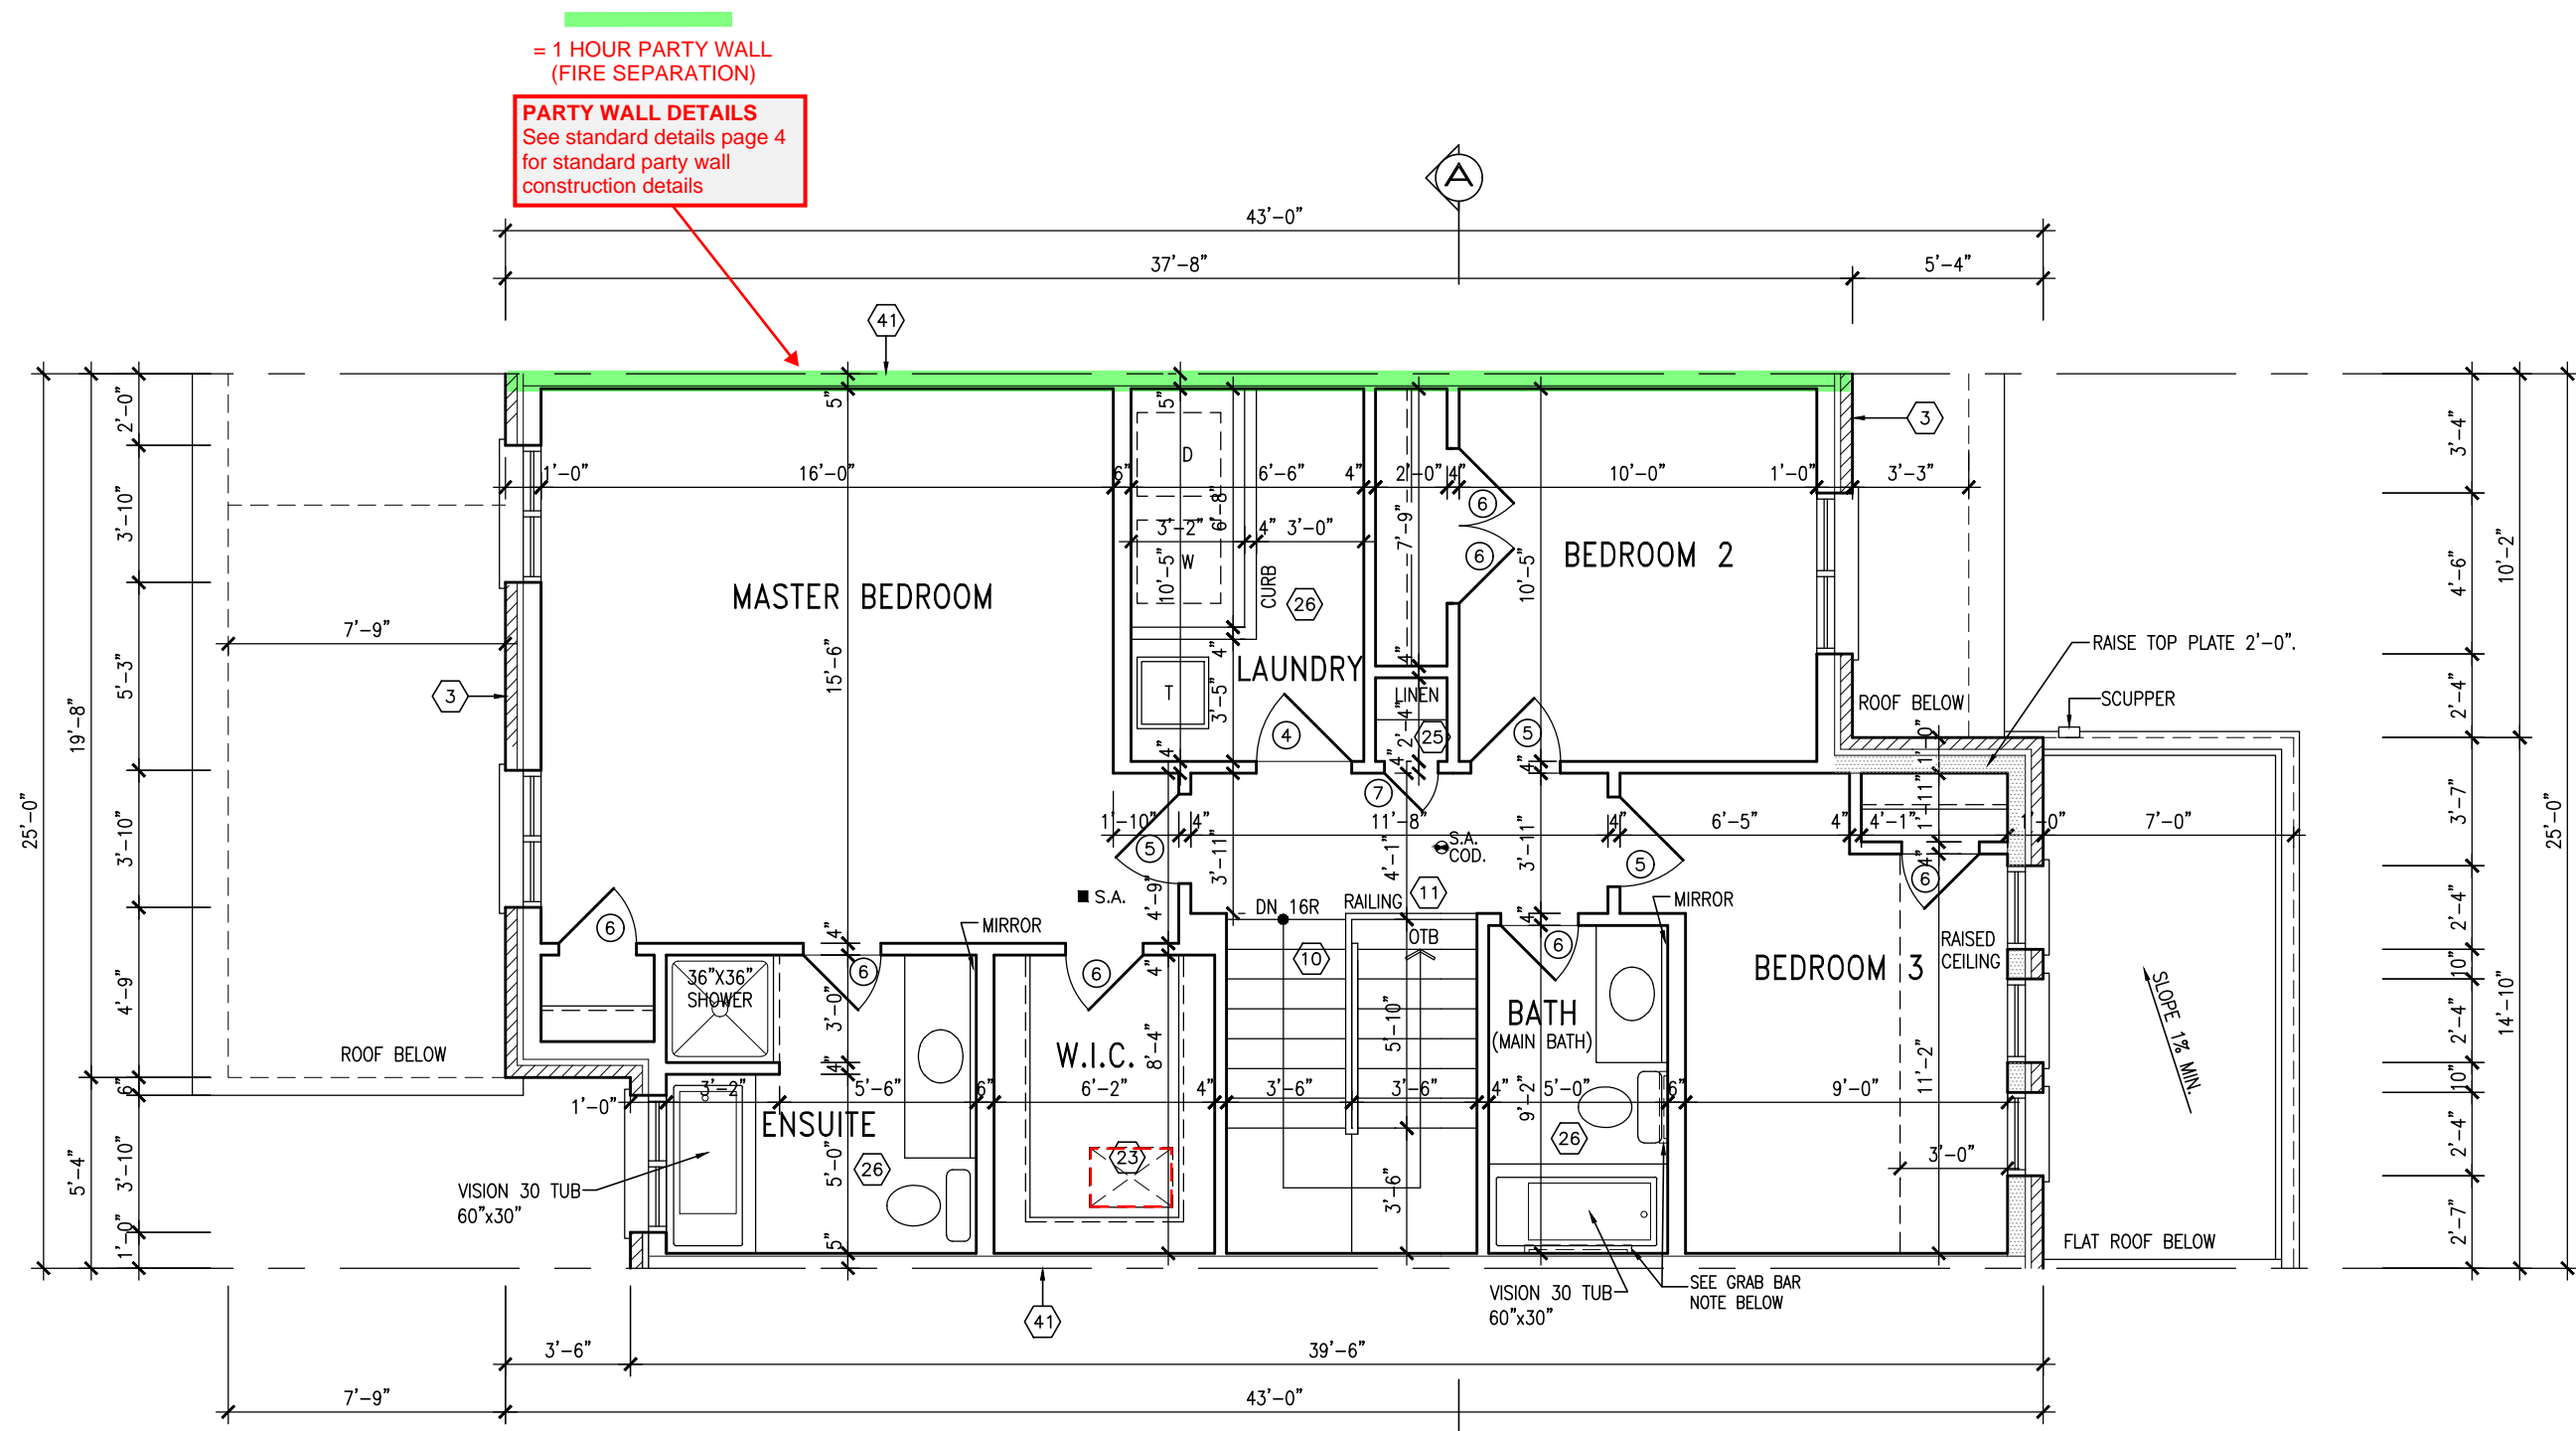

SECOND FLOOR PLAN - ELEV. 2

TOWNHOUSE MODELS
Reviewed townhouse model drawings to be read in conjunction with reviewed lot specific block drawings and engineered truss system

BATHROOM BLOCKING
See standard details page 8 for required main bathroom grab bar reinforcing

It is the builder's complete responsibility to ensure that all plans submitted for approval fully comply with the Architectural Guidelines and all applicable regulations and requirements including zoning provisions and any provisions in the subdivision agreement. The Control Architect is not responsible in any way for examining or approving site (lotting) plans or working drawings with respect to any zoning or building code or permit matter or that any house can be properly built or located on its lot.

This is to certify that these plans comply with the applicable Architectural Design Guidelines approved by the Town of MILTON.

ARCHITECTURAL REVIEW & APPROVAL
MAR 20 2017
John G. Williams Limited, Architect

NOTE:
REFER TO BLOCK WORKING DRAWINGS FOR SECOND FLOOR STRUCTURAL INFORMATION.

STUD WALL REINFORCEMENT FOR FUTURE GRAB BARS IN MAIN BATHROOM
REINFORCEMENT OF STUD WALLS SHALL BE INSTALLED ADJACENT TO WATER CLOSETS AND SHOWER OR BATHTUB IN MAIN BATHROOM. REFER TO OBC. 9.5.2.3, 3.8.3.8.(1)(d) & 3.8.3.13.(1)(f).

TOWN OF MILTON
PLANNING AND DEVELOPMENT
IVY 3 MODEL

BUILDING: REVIEWED
SCOTT SHERRIFFS APR 18, 2017
PLANS EXAMINER DATE

Neither the issuance of a permit nor carrying out of inspections by the Town of Milton relieves the owner from full responsibility for compliance with the provisions of the Ontario Building Code Act and the Ontario Building Code, both as amended, as well as other applicable statutes and regulations of the Province of Ontario, By-laws of the Region of Halton and Town of Milton

RECEIVED
TOWN OF MILTON
MAR 29, 2017
IVY 3
BUILDING DIVISION

18		9	REVISED PER BLDG. DEPT. COMMENTS.	APR. 10/17	GW
17		8	ISSUED FOR PERMIT.	MAR. 01/17	GW
16		7	ISSUED FOR PRICING.	DEC. 21/16	GW
15		6	CLOSET ADDED TO MASTER BEDROOM.	OCT. 27/16	GW
14		5	REVISED. ADD SUNKEN FOYER COND.	OCT 03/16	WT
13		4	2nd FL. WINDOW PANELS. STAIR SHIFT 4".	SEP 06/16	GW
12		3	REPLACE PATIO DR w/ WINDOW	AUG 26/16	GW
11		2	REVISED PLANS & ELEVATIONS.	AUG 22/16	GW
10		1	ISSUED FOR CLIENT REVIEW.	AUG. 08/16	GW
no.	description	date	by	no.	description

The undersigned has reviewed and takes responsibility for this design and has the qualifications and meets the requirements set out in the Ontario Building Code to be a Designer.

qualification information
Richard Vink 24488
signature BCIN
VA3 Design Inc. 42658

Contractor must verify all dimensions on the job and report any discrepancy to the Designer before proceeding with the work. All drawings and specifications are instruments of service and the property of the Designer which must be returned at the completion of the work. Drawings are not to be scaled.

VA3 DESIGN
255 Consumers Rd Suite 120
Toronto ON M2J 1R4
t 416.630.2255 f 416.630.4782
va3design.com

Greenpark.

project name **LECCO RIDGE DEV. INC.** municipality **TOWN OF MILTON** project no. **16015**

date **2016-07** drawn by **AF** checked by **3/16" = 1'-0"** scale **16015-IVY-3** file name **16015-IVY-3**

SECOND FLOOR PLAN - ELEV. 2 drawing no. **A3a**

GREG - H:\ARCHIVE\WORKING\2016\16015.GRE\UNITS\IVY\IVY 3\16015-IVY-3.dwg - Mon - Apr 10 2017 - 4:13 PM

IVY 3
ENERGY STAR/ PANEL

RECEIVED
TOWN OF MILTON
MAR 29, 2017
IVY 3
BUILDING DIVISION

TOWN OF MILTON
PLANNING AND DEVELOPMENT
IVY 3 MODEL
BUILDING: REVIEWED
SCOTT SHERRIFFS APR 18, 2017
PLANS EXAMINER DATE
Neither the issuance of a permit nor carrying out of
inspections by the Town of Milton relieves the owner from
full responsibility for compliance with the provisions of
the Ontario Building Code Act and the Ontario Building
Code, both as amended, as well as other applicable
statutes and regulations of the Province of Ontario,
By-laws of the Region of Halton and Town of Milton

1871 SF.


It is the builder's complete responsibility to
ensure that all plans submitted for approval
fully comply with the Architectural Guidelines
and all applicable regulations and requirements
including zoning provisions and any provisions
in the subdivision agreement. The Control
Architect is not responsible in any way for
examining or approving site (lotting) plans or
working drawings with respect to any zoning or
building code or permit matter or that any
house can be properly built or located on its lot.

This is to certify that these plans comply
with the applicable Architectural Design
Guidelines approved by the Town of
MILTON.


ARCHITECTURAL REVIEW & APPROVAL
MAR 20 2017
John G. Williams Limited, Architect

= 1 HOUR PARTY WALL
(FIRE SEPARATION)
PARTY WALL DETAILS
See standard details page 4
for standard party wall
construction details

ROOF PLAN

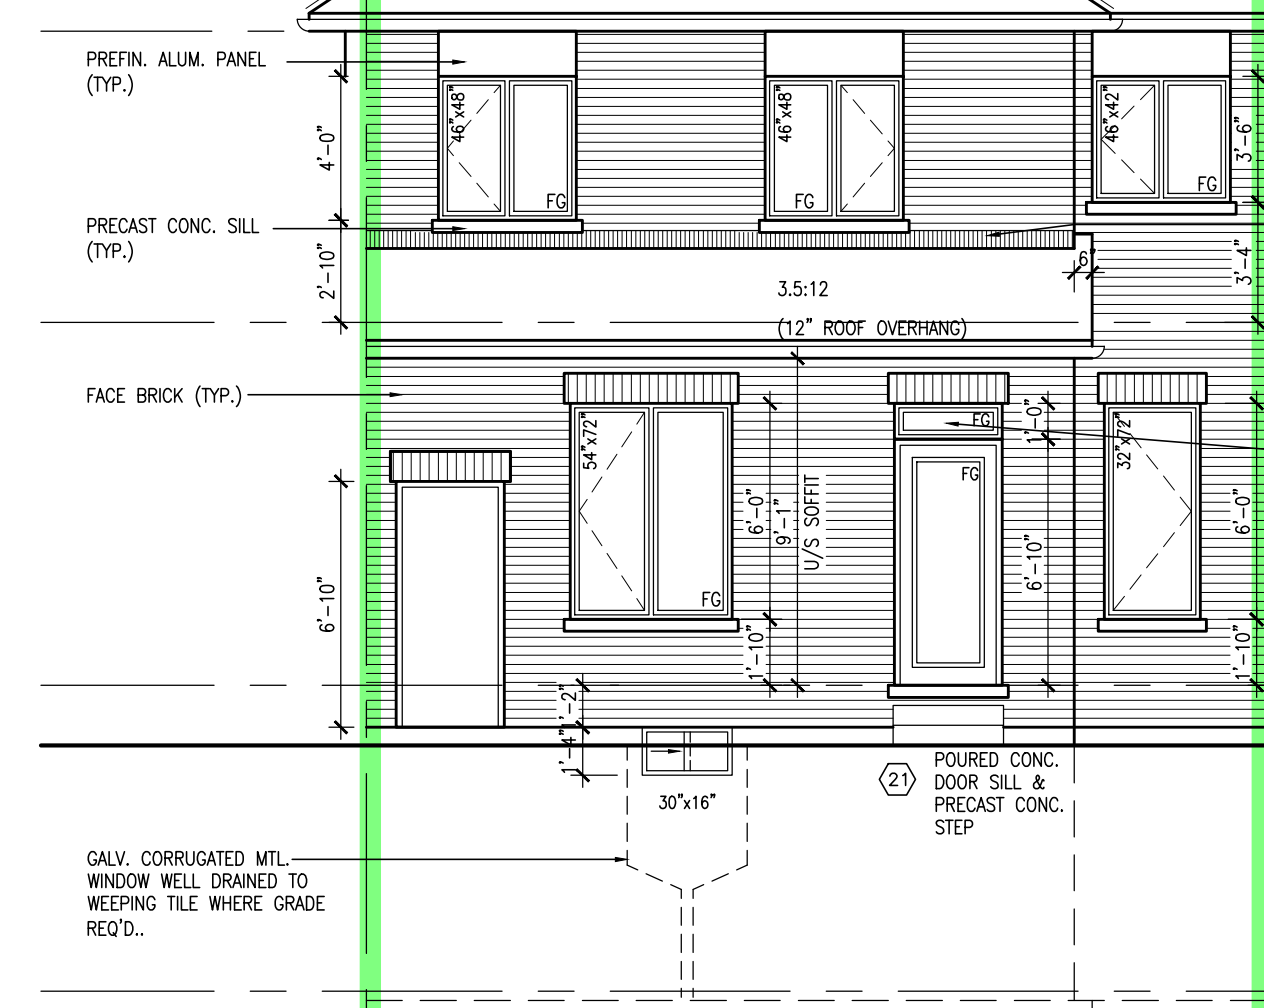

REAR ELEVATION
ELEV. 2

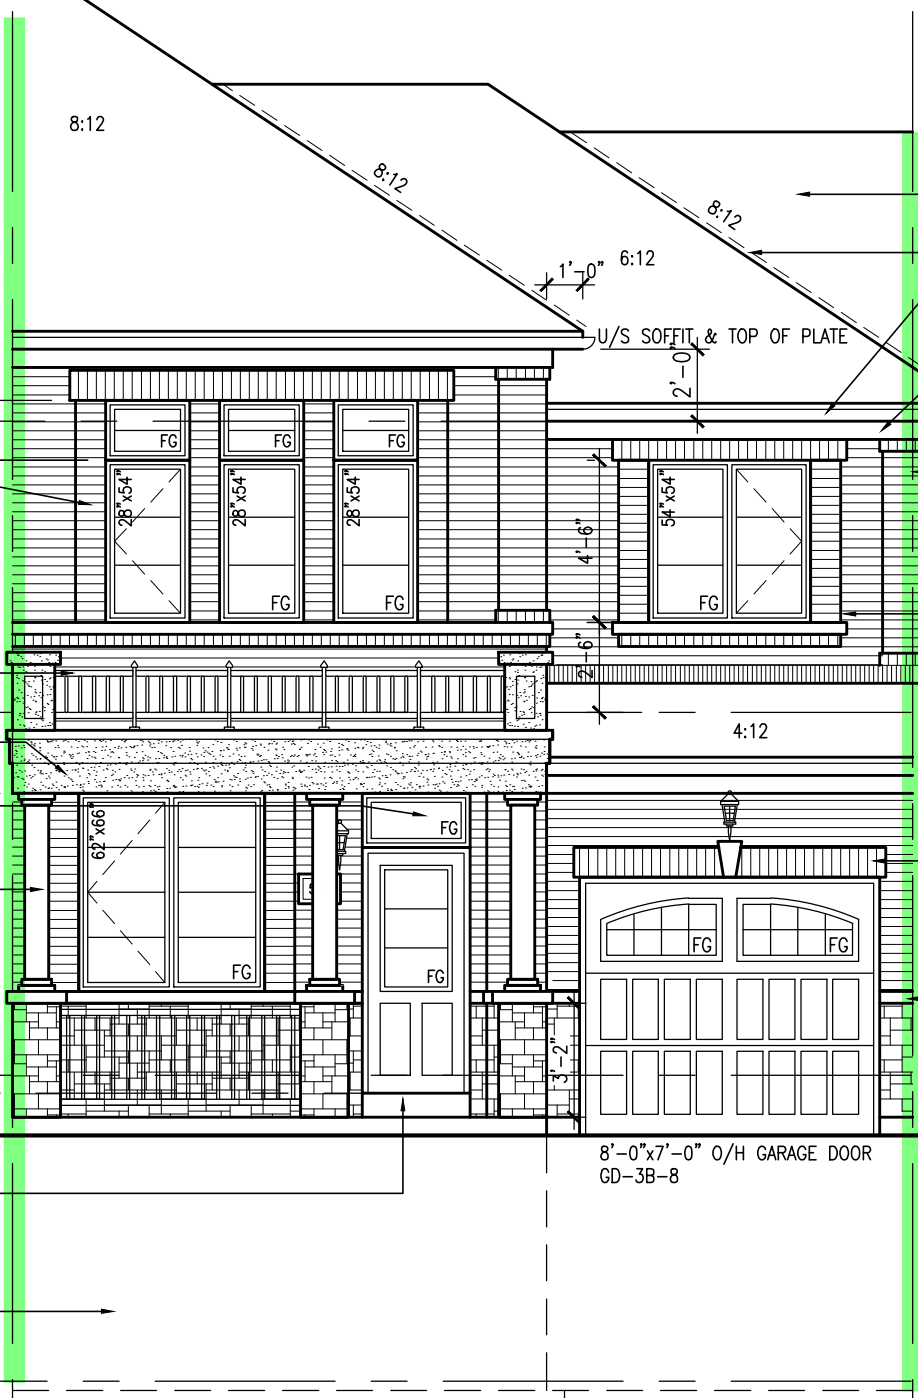

FRONT ELEVATION
ELEV. 2

GUARDS/HANDRAILS
Shall be provided on
porches as required
based on final lot grading

ELEVATIONS NOT DRAWN TO ACTUAL GRADE.
REFER TO FINAL GRADING PLAN.
3'-6" HIGH RAILING IF PORCH SLAB
IS MORE THAN 5'-11" ABOVE FINISHED
GRADE AND 3'-0" HIGH RAILING
WHEN PORCH SLAB IS LESS THAN
5'-11" ABOVE FINISHED GRADE

18				9	REVISED PER BLDG. DEPT. COMMENTS.	APR. 10/17	GW
17				8	ISSUED FOR PERMIT.	MAR. 01/17	GW
16				7	ISSUED FOR PRICING.	DEC. 21/16	GW
15				6	CLOSET ADDED TO MASTER BEDROOM.	OCT. 27/16	GW
14				5	REVISED. ADD SUNKEN FOYER COND.	OCT. 03/16	WT
13				4	2nd FL. WINDOW PANELS. STAIR SHIFT 4".	SEP. 06/16	GW
12				3	REPLACE PATIO DR w/ WINDOW	AUG. 26/16	GW
11				2	REVISED PLANS & ELEVATIONS.	AUG. 22/16	GW
10				1	ISSUED FOR CLIENT REVIEW.	AUG. 08/16	GW
no.	description	date	by	no.	description	date	by

The undersigned has reviewed and takes responsibility for this design
and has the qualifications and meets the requirements set out in the
Ontario Building Code to be a Designer.
qualification information
Richard Vink 24488
signature BCIN
name registration information
VA3 Design Inc. 42658
Contractor must verify all dimensions on the job and report any
discrepancy to the Designer before proceeding with the work. All
drawings and specifications are instruments of service and the property
of the Designer which must be returned at the completion of the work.
Drawings are not to be scaled.

VA3
DESIGN
255 Consumers Rd Suite 120
Toronto ON M2J 1R4
t 416.630.2255 f 416.630.4782
va3design.com

Greenpark.
project name
LECCO RIDGE DEV. INC. municipality
TOWN OF MILTON
date
2016-07
drawn by
AF
checked by
scale
3/16" = 1'-0"
file name
16015-IVY-3
drawing no.
A4a

IVY 3
ENERGY STAR/ PANEL


1883 SF.

RECEIVED
TOWN OF MILTON
MAR 29, 2017
IVY 3
BUILDING DIVISION


TOWN OF MILTON
PLANNING AND DEVELOPMENT
IVY 3 MODEL
BUILDING: REVIEWED
SCOTT SHERRIFFS
PLANS EXAMINER
DATE
APR 18, 2017
Neither the issuance of a permit nor carrying out of inspections by the Town of Milton relieves the owner from full responsibility for compliance with the provisions of the Ontario Building Code Act and the Ontario Building Code, both as amended, as well as other applicable statutes and regulations of the Province of Ontario, By-laws of the Region of Halton and Town of Milton

It is the builder's complete responsibility to ensure that all plans submitted for approval fully comply with the Architectural Guidelines and all applicable regulations and requirements including zoning provisions and any provisions in the subdivision agreement. The Control Architect is not responsible in any way for examining or approving site (lotting) plans or working drawings with respect to any zoning or building code or permit matter or that any house can be properly built or located on its lot.


This is to certify that these plans comply with the applicable Architectural Design Guidelines approved by the Town of MILTON.

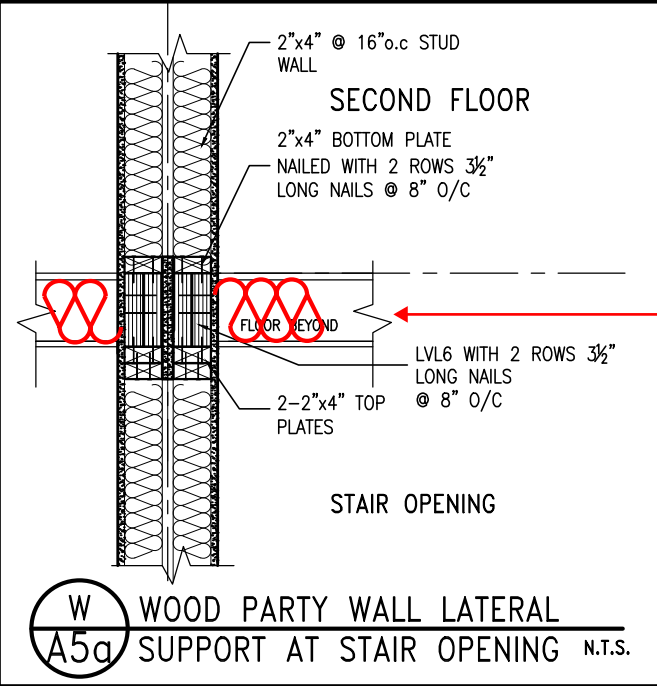

PARTY WALL SOUND RATING
Provide insulation in all joist spaces at main floors and landings to maintain required min 50 STC rating. See standard details page 4 for standard party wall construction details

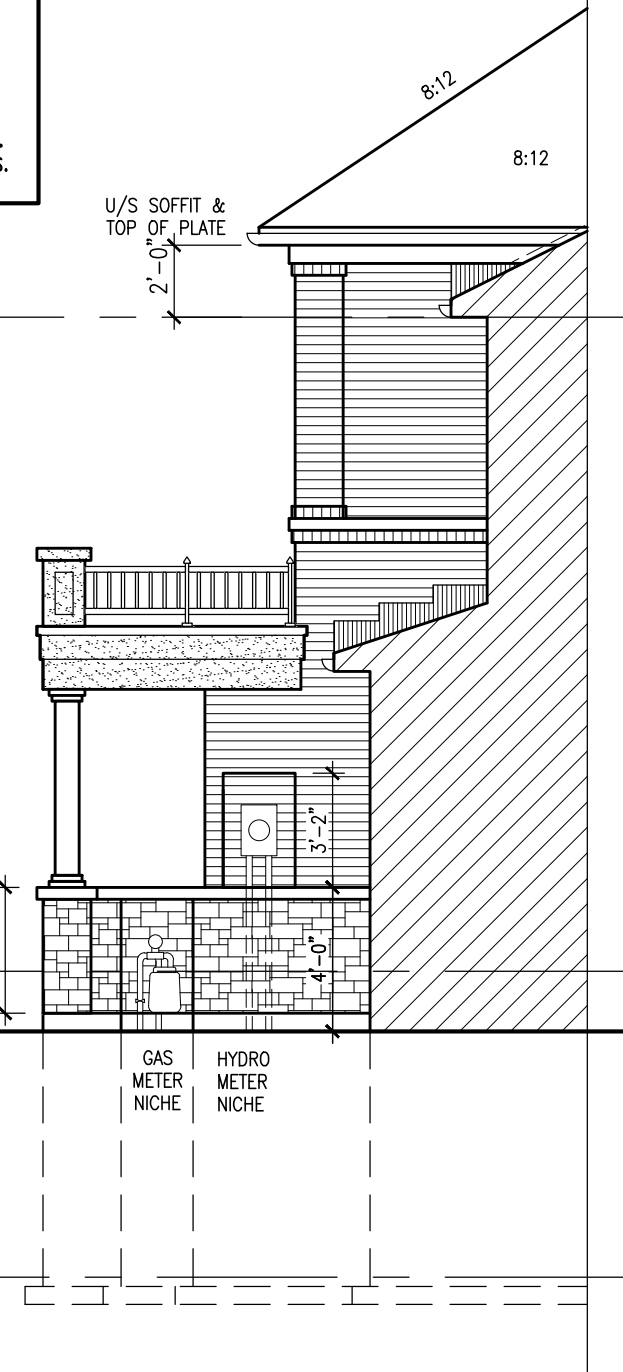

SECTION B

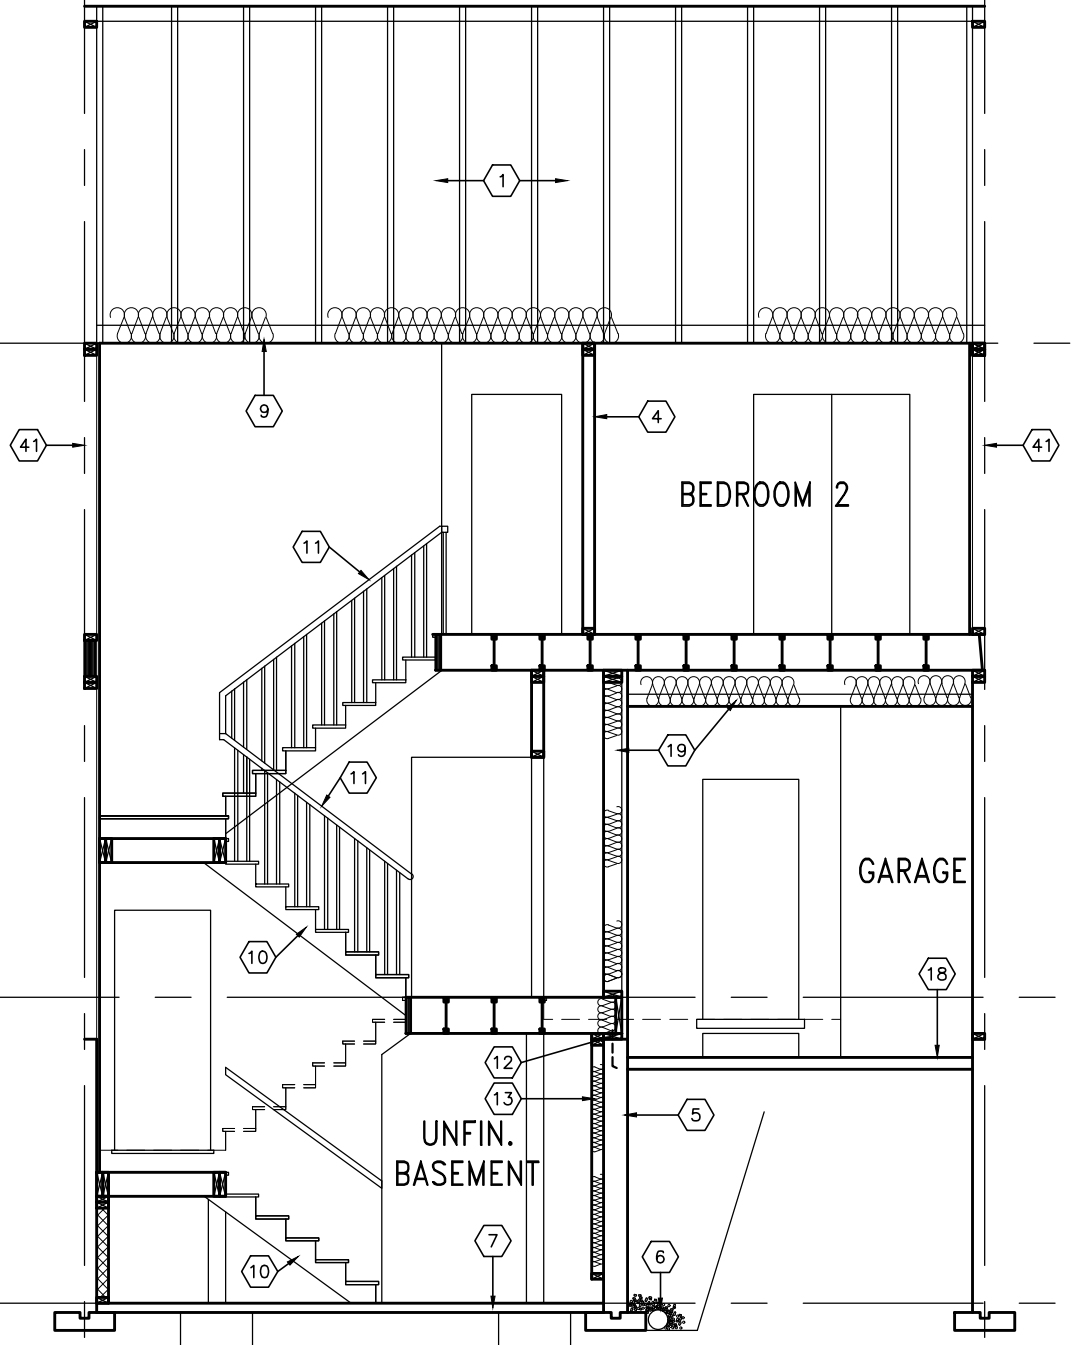

SECTION A-A ELEV. 2



18		9	REVISED PER BLDG. DEPT. COMMENTS.	APR. 10/17	GW
17		8	ISSUED FOR PERMIT.	MAR. 01/17	GW
16		7	ISSUED FOR PRICING.	DEC. 21/16	GW
15		6	CLOSET ADDED TO MASTER BEDROOM.	OCT. 27/16	GW
14		5	REVISED. ADD SUNKEN FOYER COND.	OCT 03/16	WT
13		4	2nd FL. WINDOW PANELS. STAIR SHIFT 4".	SEP 06/16	GW
12		3	REPLACE PATIO DR w/ WINDOW	AUG 26/16	GW
11		2	REVISED PLANS & ELEVATIONS.	AUG 22/16	GW
10		1	ISSUED FOR CLIENT REVIEW.	AUG. 08/16	GW
no. description	date	by	no. description	date	by

The undersigned has reviewed and takes responsibility for this design and has the qualifications and meets the requirements set out in the Ontario Building Code to be a Designer.
qualification information
Richard Vink
signature
24488
BCIN
VA3 Design Inc.
42658
Contractor must verify all dimensions on the job and report any discrepancy to the Designer before proceeding with the work. All drawings and specifications are instruments of service and the property of the Designer which must be returned at the completion of the work. Drawings are not to be scaled.

VA3 DESIGN
255 Consumers Rd Suite 120
Toronto ON M2J 1R4
t 416.630.2255 f 416.630.4782
va3design.com

Greenpark.
project name
LECCO RIDGE DEV. INC.
municipality
TOWN OF MILTON
project no.
16015
drawing no.
A5a
SECTION A-A ELEV. 2
date
2016-07
drawn by
AF
checked by
scale
3/16" = 1'-0"
file name
16015-IVY-3
16015-IVY-3
GREG - H:\ARCHIVE\WORKING\2016\16015.GRE\UNITS\IVY\IVY 3\16015-IVY-3.dwg - Mon - Apr 10 2017 - 4:13 PM

RECEIVED
TOWN OF MILTON
MAR 29, 2017
IVY 3
BUILDING DIVISION

TOWN OF MILTON
PLANNING AND DEVELOPMENT
IVY 3 MODEL
BUILDING: REVIEWED
SCOTT SHERRIFFS
PLANS EXAMINER
DATE
APR 18, 2017
Neither the issuance of a permit nor carrying out of inspections by the Town of Milton relieves the owner from full responsibility for compliance with the provisions of the Ontario Building Code Act and the Ontario Building Code, both as amended, as well as other applicable statutes and regulations of the Province of Ontario, By-laws of the Region of Halton and Town of Milton

1883 SF.

It is the builder's complete responsibility to ensure that all plans submitted for approval fully comply with the Architectural Guidelines and all applicable regulations and requirements including zoning provisions and any provisions in the subdivision agreement. The Control Architect is not responsible in any way for examining or approving site (lotting) plans or working drawings with respect to any zoning or building code or permit matter or that any house can be properly built or located on its lot.

This is to certify that these plans comply with the applicable Architectural Design Guidelines approved by the Town of MILTON.

ARCHITECTURAL REVIEW & APPROVAL
MAR 20 2017
John G. Williams Limited, Architect


= 1 HOUR PARTY WALL
(FIRE SEPARATION)
PARTY WALL DETAILS
See standard details page 4
for standard party wall
construction details



REAR ELEVATION ELEV. 2
DECK CONDITION (8R OR MORE)

DECK DETAILS
See standard details pages 5
and 5-2 for additional deck
construction details

PREFIN. ALUM. PANEL (TYP.)
4'-0"
PRECAST CONC. SILL (TYP.)
2'-10"
3.5:12
(12" ROOF OVERHANG)
FACE BRICK (TYP.)
6'-10"
36" HIGH WOOD RAILING
(42" HIGH WHEN DECK IS
MORE THAN 5'-11" ABOVE
GRADE)
4x4 WOOD COLUMN UP TO
4'-0" HEIGHT, 6x6 WOOD
COLUMN FOR HEIGHTS OVER
4'-0" (PRESSURE TREATED).
12" CONC. PIER
POURED CONC. FOUNDATION
WALLS AND FOOTINGS (TYP.)

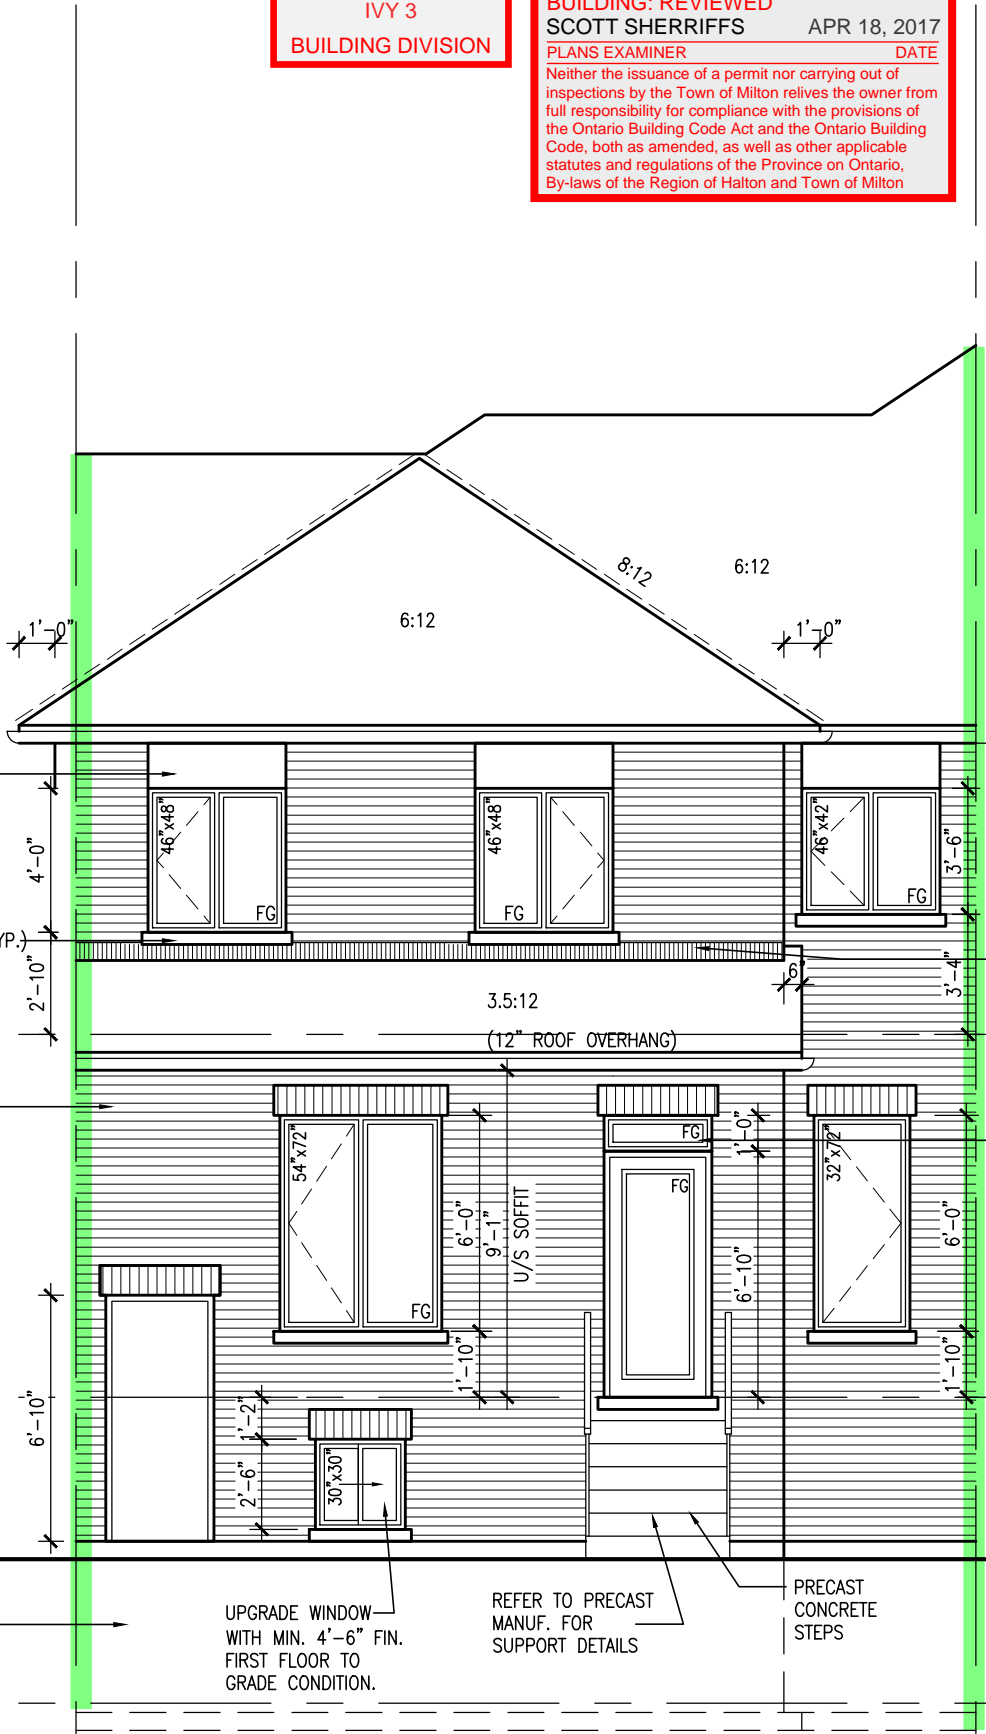

REAR ELEVATION ELEV. 2
DECK CONDITION (7R MAX.)

PRECAST STAIR/LANDING
Refer to master specifications
for anchorage details for
Parson's precast stair/landing

TOP OF PLATE
TOP OF WINDOW
7'-0"
8'-1"
PREFIN. MTL. FLASHING,
W/ CAULKING TO MATCH
(TYP.)
FIN. SECOND FLOOR
TOP OF WINDOW
12" HIGH TRANSOM (FG)
7'-10"
10'-1"
FIN. GROUND FLOOR
4'-6" MIN.
FOR UPGRADE WINDOWS
FIN. GRADE
8'-6"
TOP OF SLAB


IVY 3
ENERGY STAR/ PANEL

18				9	REVISED PER BLDG. DEPT. COMMENTS.	APR. 10/17	GW	
17				8	ISSUED FOR PERMIT.	MAR. 01/17	GW	
16				7	ISSUED FOR PRICING.	DEC. 21/16	GW	
15				6	CLOSET ADDED TO MASTER BEDROOM.	OCT. 27/16	GW	
14				5	REVISED. ADD SUNKEN FOYER COND.	OCT 03/16	WT	
13				4	2nd FL. WINDOW PANELS. STAIR SHIFT 4".	SEP 06/16	GW	
12				3	REPLACE PATIO DR w/ WINDOW	AUG 26/16	GW	
11				2	REVISED PLANS & ELEVATIONS.	AUG 22/16	GW	
10				1	ISSUED FOR CLIENT REVIEW.	AUG. 08/16	GW	
no.	description		date	by	no.	description	date	by

The undersigned has reviewed and takes responsibility for this design and has the qualifications and meets the requirements set out in the Ontario Building Code to be a Designer.
signature
Richard Vink
name
registration information
VA3 Design Inc.
24488
BCIN
42658
Contractor must verify all dimensions on the job and report any discrepancy to the Designer before proceeding with the work. All drawings and specifications are instruments of service and the property of the Designer which must be returned at the completion of the work. Drawings are not to be scaled.

VA3
DESIGN
255 Consumers Rd Suite 120
Toronto ON M2J 1R4
t 416.630.2255 f 416.630.4782
va3design.com

		IVY 3	
project name LECCO RIDGE DEV. INC.		municipality TOWN OF MILTON	project no. 16015
date 2016-07	drawn by AF	checked by 3/16" = 1'-0"	scale 16015-IVY-3
REAR ELEVATION ELEV. 2 - DECK CONDITION		drawing no. A7a	
GREG - H:\ARCHIVE\WORKING\2016\16015\GRE\UNITS\IVY\IVY 3\16015-IVY-3.dwg - Mon - Apr 10 2017 - 4:13 PM			

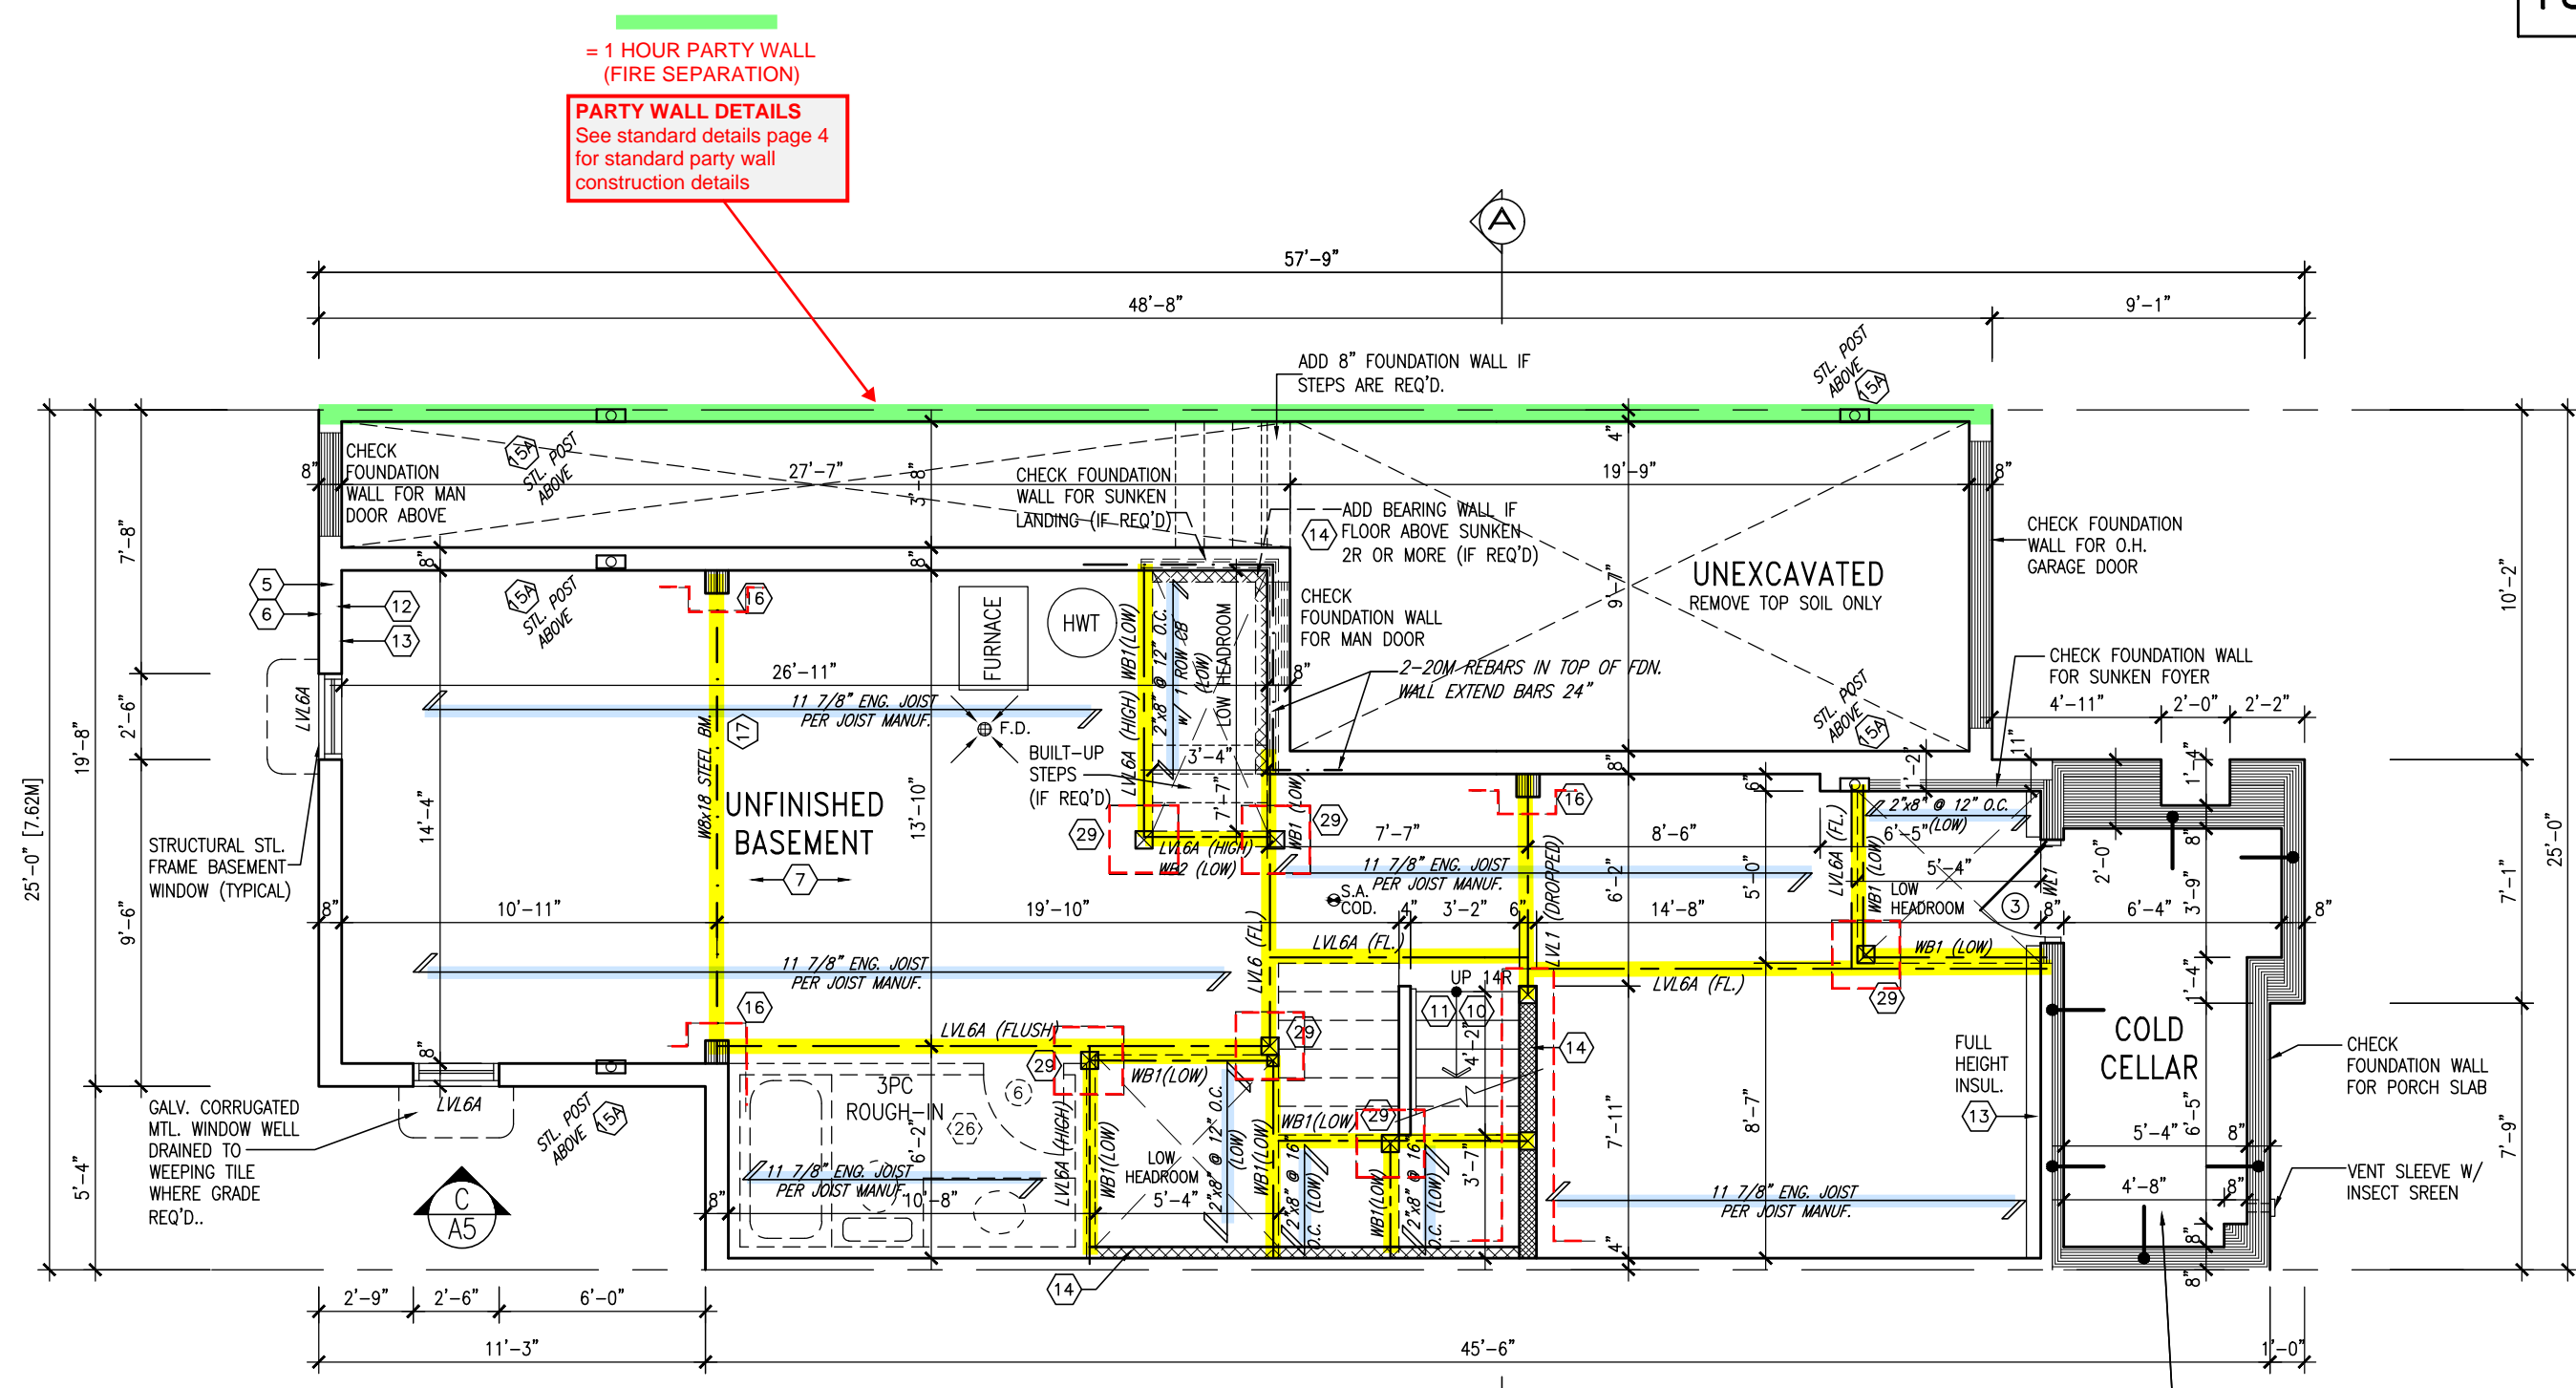

BASEMENT PLAN - ELEV. 3

ENGINEERED FLOOR FRAMING INFO
REFER TO ENGINEERED FLOOR LAYOUTS FOR
ALL FLOOR FRAMING INFORMATION AND DETAILS.
UNLESS OTHERWISE NOTED.

ENGINEERED FLOOR SYSTEM
Reviewed model drawings to be
read in conjunction with reviewed
engineered floor system layout

COLD STORAGE SLAB
5" REINFORCED CONCRETE SLAB
WITH 10M BARS @ 7 7/8" O.C.
EACH WAY WITH MIN. 1 1/4"
CONC. COVER AND 10M BENT
(24"x24") DOWELS SPACED NOT
MORE THAN 23 5/8" O.C.

It is the builder's complete responsibility to
ensure that all plans submitted for approval
fully comply with the Architectural Guidelines
and all applicable regulations and requirements
including zoning provisions and any provisions
in the subdivision agreement. The Control
Architect is not responsible in any way for
examining or approving site (lotting) plans or
working drawings with respect to any zoning or
building code or permit matter or that any
house can be properly built or located on its lot.

This is to certify that these plans comply
with the applicable Architectural Design
Guidelines approved by the Town of
MILTON.

ARCHITECTURAL REVIEW & APPROVAL
MAR 20 2017
John G. Williams, Architect



TOWN OF MILTON
PLANNING AND DEVELOPMENT
IVY 3 MODEL
BUILDING: REVIEWED
SCOTT SHERRIFFS APR 18, 2017
PLANS EXAMINER DATE
Neither the issuance of a permit nor carrying out of
inspections by the Town of Milton relieves the owner from
full responsibility for compliance with the provisions of
the Ontario Building Code Act and the Ontario Building
Code, both as amended, as well as other applicable
statutes and regulations of the Province of Ontario,
By-laws of the Region of Halton and Town of Milton


RECEIVED
TOWN OF MILTON
MAR 29, 2017
IVY 3
BUILDING DIVISION

18				9	REVISED PER BLDG. DEPT. COMMENTS.	APR. 10/17	GW
17				8	ISSUED FOR PERMIT.	MAR. 01/17	GW
16				7	ISSUED FOR PRICING.	DEC. 21/16	GW
15				6	CLOSET ADDED TO MASTER BEDROOM.	OCT. 27/16	GW
14				5	REVISED. ADD SUNKEN FOYER COND.	OCT. 03/16	WT
13				4	2nd FL. WINDOW PANELS. STAIR SHIFT 4".	SEP 06/16	GW
12				3	REPLACE PATIO DR w/ WINDOW	AUG 26/16	GW
11				2	REVISED PLANS & ELEVATIONS.	AUG 22/16	GW
10				1	ISSUED FOR CLIENT REVIEW.	AUG. 08/16	GW
no.	description	date	by	no.	description	date	by

The undersigned has reviewed and takes responsibility for this design
and has the qualifications and meets the requirements set out in the
Ontario Building Code to be a Designer.
qualification information
Richard Vink 24488
signature
name
registration information
VA3 Design Inc. 42658
Contractor must verify all dimensions on the job and report any
discrepancy to the Designer before proceeding with the work. All
drawings and specifications are instruments of service and the property
of the Designer which must be returned at the completion of the work.
Drawings are not to be scaled.

VA3
DESIGN
255 Consumers Rd Suite 120
Toronto ON M2J 1R4
t 416.630.2255 f 416.630.4782
va3design.com

		IVY 3	
project name LECCO RIDGE DEV. INC.		municipality TOWN OF MILTON	project no. 16015
date 2016-07	drawn by AF	checked by 3/16" = 1'-0"	scale 16015-IVY-3
drawing no. A1b		drawing no. A1b	

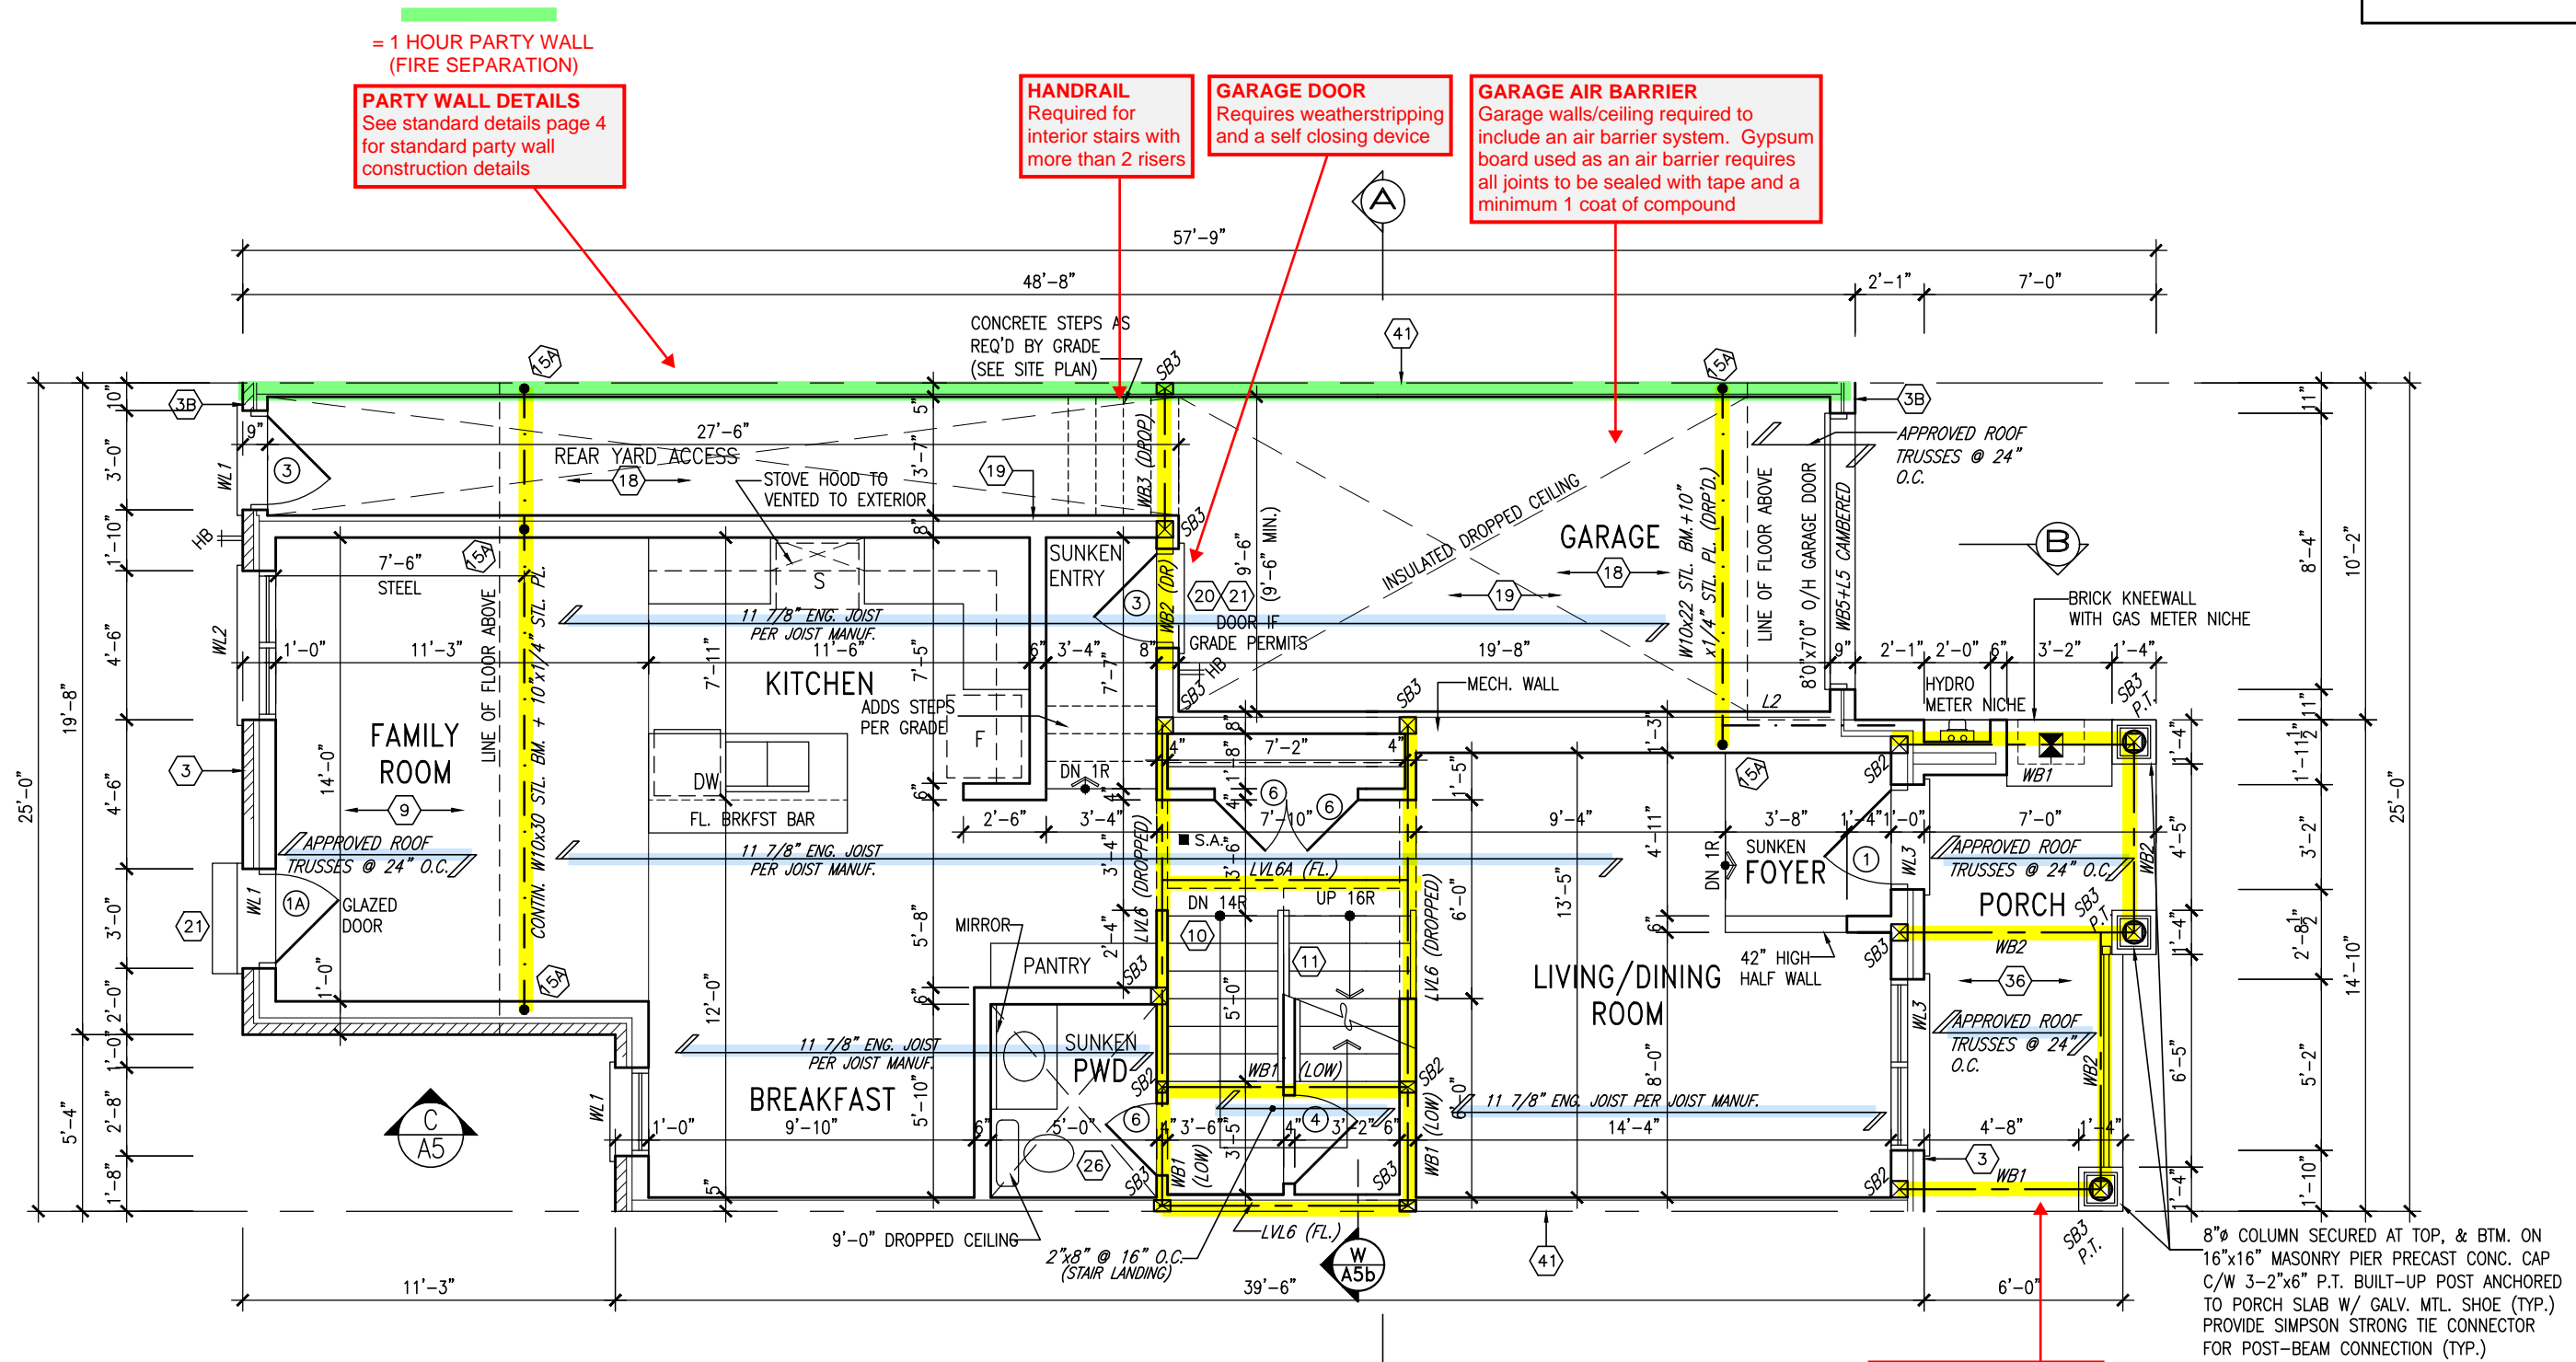

GROUND FLOOR PLAN - ELEV. 3

ALL GARAGE SLABS, PORCH SLABS, STAIRS (EXPOSED CONC. FLAT WORK) TO BE 32 MPa WITH 5-8% AIR ENTRAINMENT.

NOTE: ROOF FRAMING
ROOF TRUSS INFORMATION REFER TO ROOF TRUSS SHOP DRAWINGS FOR ALL ROOF FRAMING INFORMATION UNLESS OTHERWISE NOTED.

ENGINEERED FLOOR FRAMING INFO
REFER TO ENGINEERED FLOOR LAYOUTS FOR ALL FLOOR FRAMING INFORMATION AND DETAILS. UNLESS OTHERWISE NOTED.



TOWN OF MILTON
PLANNING AND DEVELOPMENT
IVY 3 MODEL

BUILDING: REVIEWED
SCOTT SHERRIFFS APR 18, 2017
PLANS EXAMINER DATE

Neither the issuance of a permit nor carrying out of inspections by the Town of Milton relieves the owner from full responsibility for compliance with the provisions of the Ontario Building Code Act and the Ontario Building Code, both as amended, as well as other applicable statutes and regulations of the Province of Ontario, By-laws of the Region of Halton and Town of Milton.

RECEIVED
TOWN OF MILTON
MAR 29, 2017
IVY 3
BUILDING DIVISION

It is the builder's complete responsibility to ensure that all plans submitted for approval fully comply with the Architectural Guidelines and all applicable regulations and requirements including zoning provisions and any provisions in the subdivision agreement. The Control Architect is not responsible in any way for examining or approving site (lotting) plans or working drawings with respect to any zoning or building code or permit matter or that any house can be properly built or located on its lot.

This is to certify that these plans comply with the applicable Architectural Design Guidelines approved by the Town of Milton.

ARCHITECTURAL REVIEW & APPROVAL
MAR 20 2017
John G. Williams, Architect



18				9	REVISED PER BLDG. DEPT. COMMENTS.	APR. 10/17	GW
17				8	ISSUED FOR PERMIT.	MAR. 01/17	GW
16				7	ISSUED FOR PRICING.	DEC. 21/16	GW
15				6	CLOSET ADDED TO MASTER BEDROOM.	OCT. 27/16	GW
14				5	REVISED. ADD SUNKEN FOYER COND.	OCT 03/16	WT
13				4	2nd FL. WINDOW PANELS. STAIR SHIFT 4".	SEP 06/16	GW
12				3	REPLACE PATIO DR w/ WINDOW	AUG 26/16	GW
11				2	REVISED PLANS & ELEVATIONS.	AUG 22/16	GW
10				1	ISSUED FOR CLIENT REVIEW.	AUG. 08/16	GW
no. description		date	by	no. description		date	by


The undersigned has reviewed and takes responsibility for this design and has the qualifications and meets the requirements set out in the Ontario Building Code to be a Designer.

qualification information
Richard Vink 24488
signature BCIN

name
registration information
VA3 Design Inc. 42658

Contractor must verify all dimensions on the job and report any discrepancy to the Designer before proceeding with the work. All drawings and specifications are instruments of service and the property of the Designer which must be returned at the completion of the work. Drawings are not to be scaled.

VA3 DESIGN
255 Consumers Rd Suite 120
Toronto ON M2J 1R4
t 416.630.2255 f 416.630.4782
va3design.com



Greenpark.

project name
LECCO RIDGE DEV. INC.

date
2016-07

drawn by
AF

checked by
3/16" = 1'-0"

scale
3/16" = 1'-0"

file name
16015-IVY-3

drawing no.
A2b

municipality
TOWN OF MILTON


project no.
16015

GROUND FLOOR PLAN - ELEV. 3

IVY 3

ENERGY STAR/ PANEL

1871 SF.

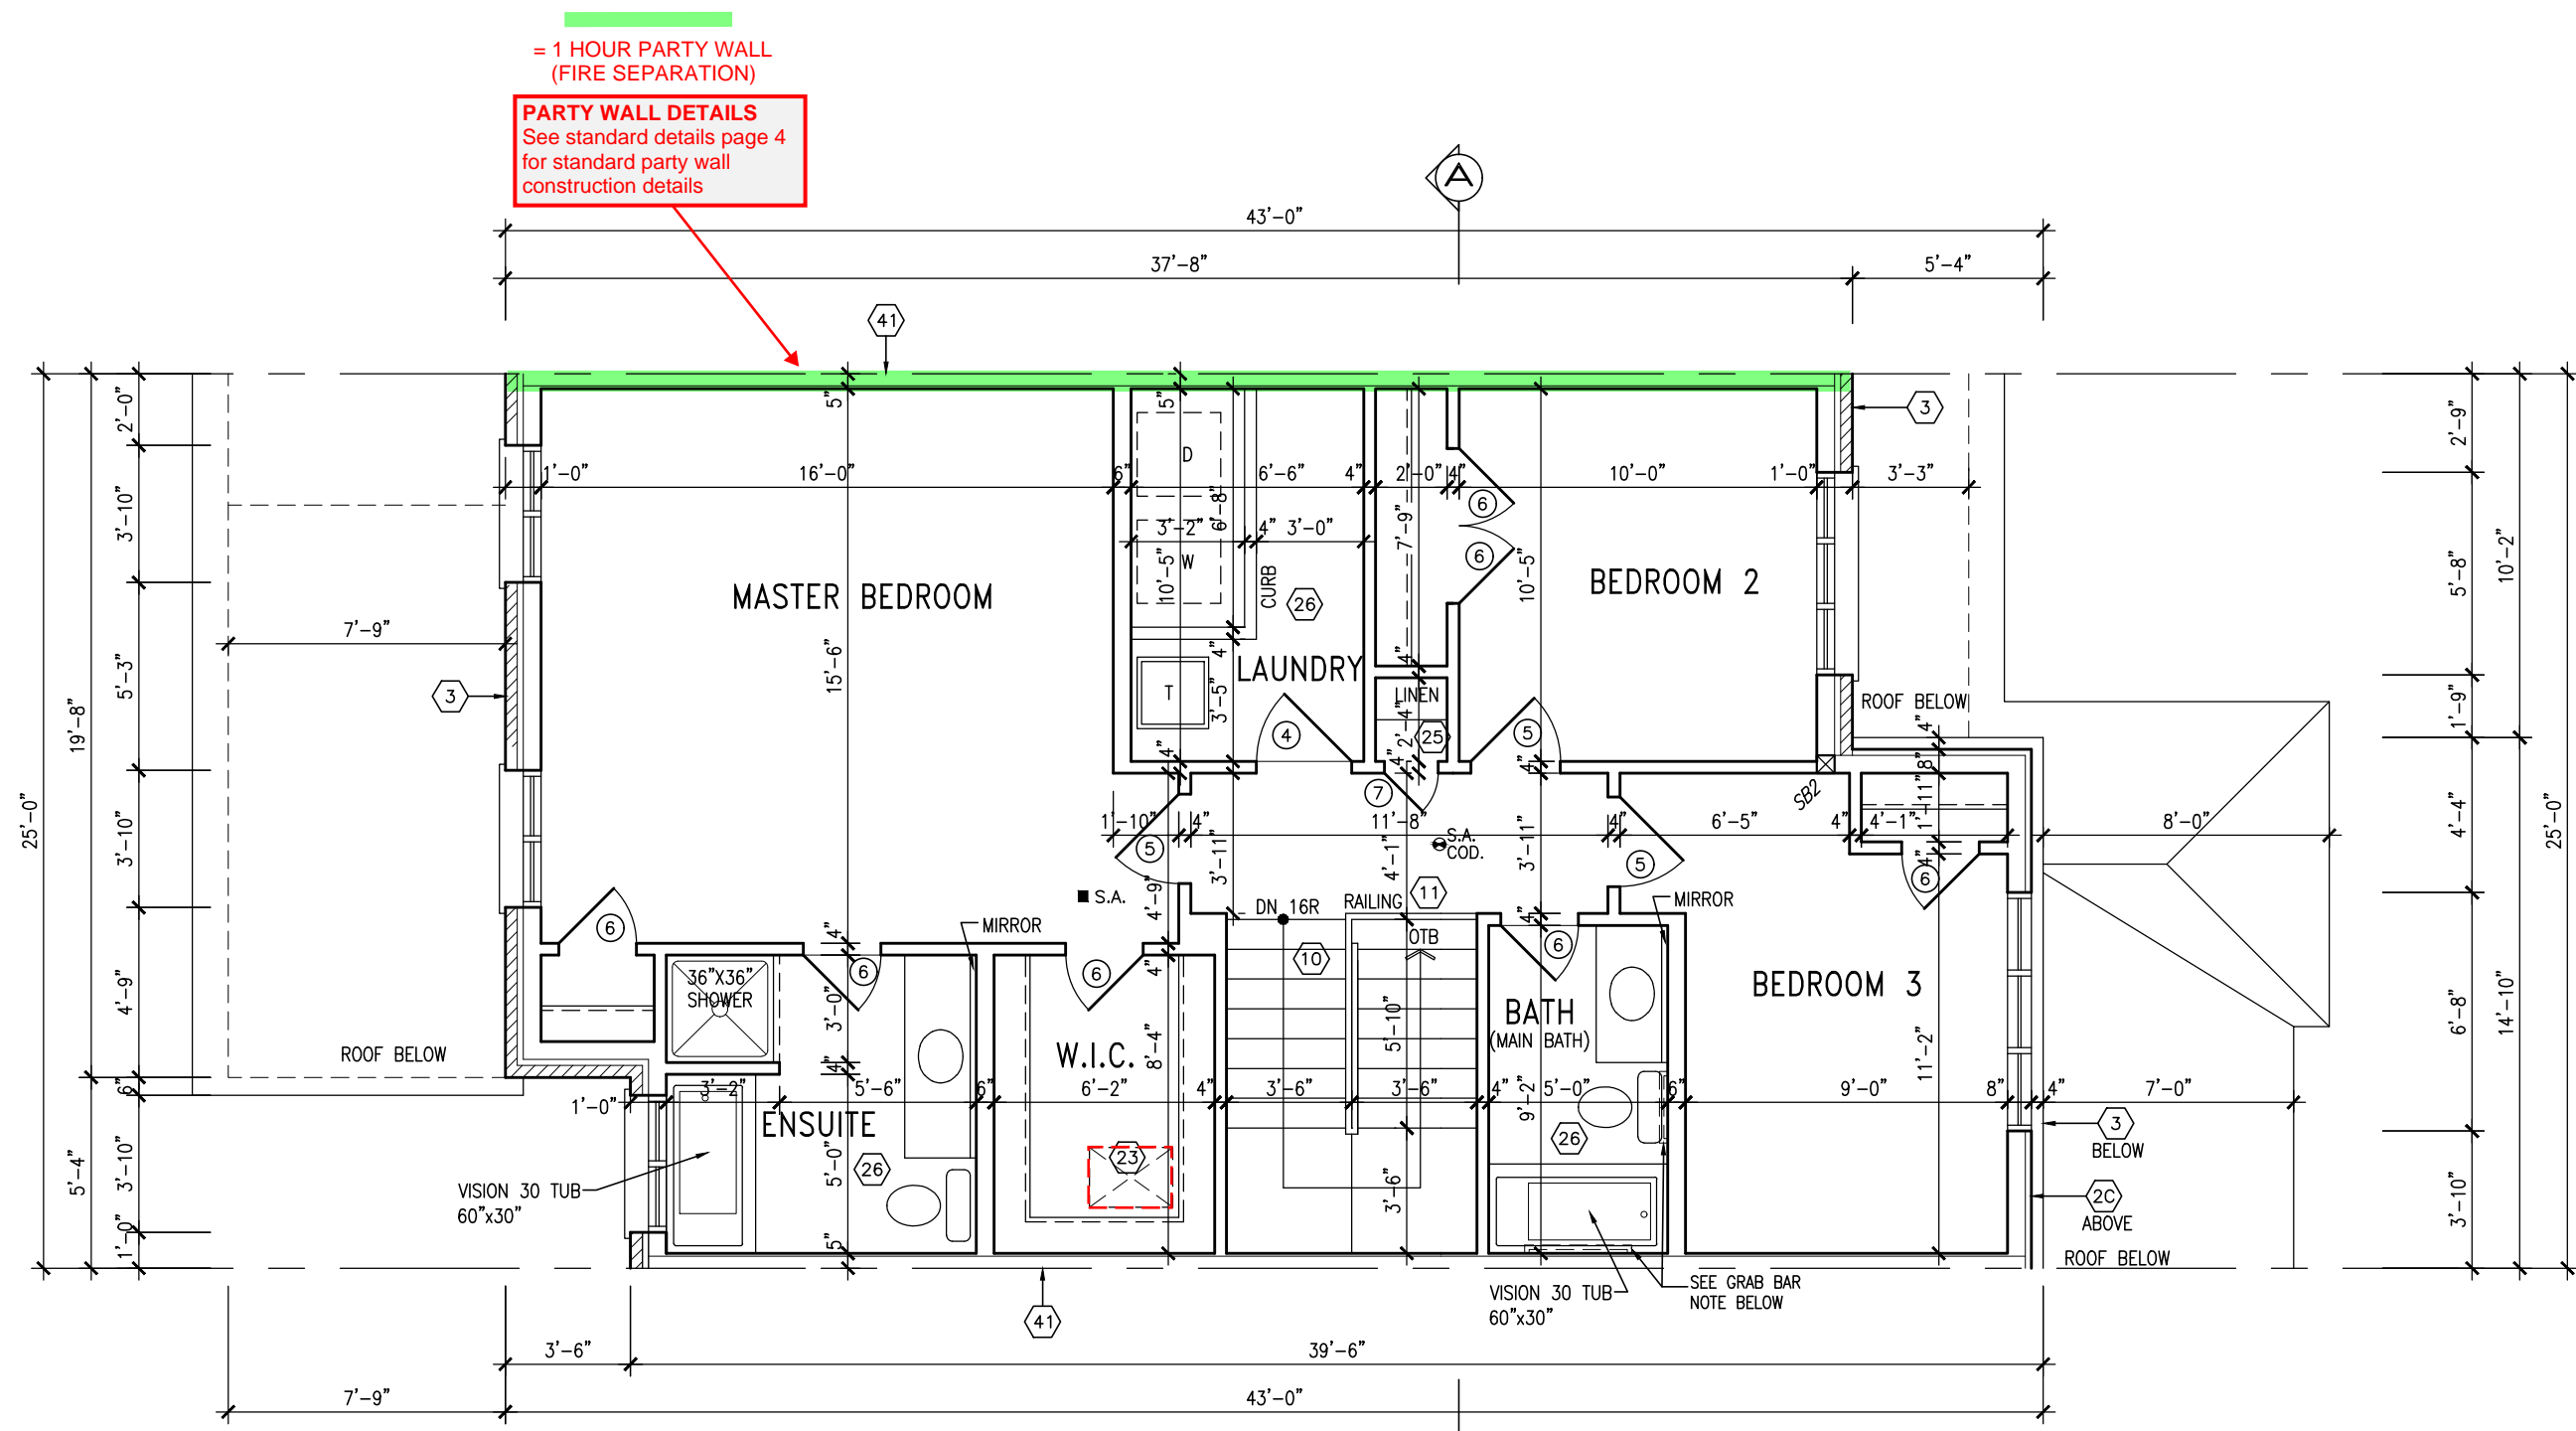

SECOND FLOOR PLAN – ELEV. 3

TOWNHOUSE MODELS
Reviewed townhouse model drawings to be read in conjunction with reviewed lot specific block drawings and engineered truss system

BATHROOM BLOCKING
See standard details page 8 for required main bathroom grab bar reinforcing

It is the builder's complete responsibility to ensure that all plans submitted for approval fully comply with the Architectural Guidelines and all applicable regulations and requirements including zoning provisions and any provisions in the subdivision agreement. The Control Architect is not responsible in any way for examining or approving site (lotting) plans or working drawings with respect to any zoning or building code or permit matter or that any house can be properly built or located on its lot.

This is to certify that these plans comply with the applicable Architectural Design Guidelines approved by the Town of Milton.

ARCHITECTURAL REVIEW & APPROVAL
MAR 20 2017
John G. Williams Limited, Architect

NOTE:
REFER TO BLOCK WORKING DRAWINGS FOR SECOND FLOOR STRUCTURAL INFORMATION.

STUD WALL REINFORCEMENT FOR FUTURE GRAB BARS IN MAIN BATHROOM
REINFORCEMENT OF STUD WALLS SHALL BE INSTALLED ADJACENT TO WATER CLOSETS AND SHOWER OR BATHTUB IN MAIN BATHROOM. REFER TO OBC. 9.5.2.3, 3.8.3.8.(1)(d) & 3.8.3.13.(1)(f).

TOWN OF MILTON
PLANNING AND DEVELOPMENT
IVY 3 MODEL

BUILDING: REVIEWED
SCOTT SHERRIFFS

DATE
APR 18, 2017

Neither the issuance of a permit nor carrying out of inspections by the Town of Milton relieves the owner from full responsibility for compliance with the provisions of the Ontario Building Code Act and the Ontario Building Code, both as amended, as well as other applicable statutes and regulations of the Province of Ontario, By-laws of the Region of Halton and Town of Milton

RECEIVED
TOWN OF MILTON
MAR 29, 2017
IVY 3
BUILDING DIVISION

18				9	REVISED PER BLDG. DEPT. COMMENTS.	APR. 10/17	GW	
17				8	ISSUED FOR PERMIT.	MAR. 01/17	GW	
16				7	ISSUED FOR PRICING.	DEC. 21/16	GW	
15				6	CLOSET ADDED TO MASTER BEDROOM.	OCT. 27/16	GW	
14				5	REVISED. ADD SUNKEN FOYER COND.	OCT 03/16	WT	
13				4	2nd FL. WINDOW PANELS. STAIR SHIFT 4".	SEP 06/16	GW	
12				3	REPLACE PATIO DR w/ WINDOW	AUG 26/16	GW	
11				2	REVISED PLANS & ELEVATIONS.	AUG 22/16	GW	
10				1	ISSUED FOR CLIENT REVIEW.	AUG. 08/16	GW	
no.	description		date	by	no.	description	date	by

The undersigned has reviewed and takes responsibility for this design and has the qualifications and meets the requirements set out in the Ontario Building Code to be a Designer.

qualification information
Richard Vink 24488
signature BCIN
VA3 Design Inc. 42658

Contractor must verify all dimensions on the job and report any discrepancy to the Designer before proceeding with the work. All drawings and specifications are instruments of service and the property of the Designer which must be returned at the completion of the work. Drawings are not to be scaled.

255 Consumers Rd Suite 120
Toronto ON M2J 1R4
t 416.630.2255 f 416.630.4782
va3design.com

project name
LECCO RIDGE DEV. INC.

municipality
TOWN OF MILTON

date
2016-07

drawn by
AF

checked by
3/16" = 1'-0"

scale
16015-IVY-3

project no.
16015

drawing no.
A3b

IVY 3

ENERGY STAR/ PANEL

IVY 3

SECOND FLOOR PLAN – ELEV. 3

RECEIVED
TOWN OF MILTON
MAR 29, 2017
IVY 3
BUILDING DIVISION

It is the builder's complete responsibility to ensure that all plans submitted for approval fully comply with the Architectural Guidelines and all applicable regulations and requirements including zoning provisions and any provisions in the subdivision agreement. The Control Architect is not responsible in any way for examining or approving site (lotting) plans or working drawings with respect to any zoning or building code or permit matter or that any house can be properly built or located on its lot.

This is to certify that these plans comply with the applicable Architectural Design Guidelines approved by the Town of MILTON.

ARCHITECTURAL REVIEW & APPROVAL
MAR 20 2017
John G. Williams Limited, Architect

REAR ELEVATION
ELEV. 3

= 1 HOUR PARTY WALL
(FIRE SEPARATION)

PARTY WALL DETAILS
See standard details page 4
for standard party wall
construction details

1"x6" STUCCO CLAD
FRIEZE BD. (TYP.) _____

18"x24" LOUVER WITH _____
4" STUCCO SURROUND ON
4" STUCCO SILL

6" PROFILED STUCCO —
SURROUND (TYP.)

STUCCO VENEER (TYP.)

—PREFIN. MTL. FLASHING, —
W/ CAULKING TO MATCH
(TYP.)

18" HIGH TRANSOM (EC)

12" HIGH TRANSOM (EC)

STONE VENEER (TYP.)

STONE VENEER (TYP.)—

8" DIA. POST ANCHORED

TO 16"x16" SOLID
MASONRY PIER (TYP.)

MASONRY FIER (TIF.)

FIN. CLINIKEN 5

FIN. SUNKEN F

POURED CONC. DOOR SILL

POURED CONC FOUNDAT


WALLS AND FOOTINGS (T

FRONT ELEVATION
ELEV. 3

GUARDS/HANDRAILS
Shall be provided on
porches as required
based on final lot grading

IVY 3
ENERGY STAR/ PANEL

ELEVATIONS NOT DRAWN TO ACTUAL GRADE. REFER TO FINAL GRADING PLAN.
3'-6" HIGH RAILING IF PORCH SLAB IS MORE THAN 5'-11" ABOVE FINISHED GRADE AND 3'-0" HIGH RAILING WHEN PORCH SLAB IS LESS THAN 5'-11" ABOVE FINISHED GRADE

18					9	REVISED PER BLDG. DEPT. COMMENTS.	APR. 10/17	GW	The undersigned has reviewed and takes responsibility for this design and has the qualifications and meets the requirements set out in the Ontario Building Code to be a Designer. qualification information  name signature VA3 Design Inc.	2448- BC 4265
17					8	ISSUED FOR PERMIT.	MAR. 01/17	GW		
16					7	ISSUED FOR PRICING.	DEC. 21/16	GW		
15					6	CLOSET ADDED TO MASTER BEDROOM.	OCT. 27/16	GW		
14					5	REVISED. ADD SUNKEN FOYER COND.	OCT 03/16	WT		
13					4	2nd FL. WINDOW PANELS. STAIR SHIFT 4".	SEP 06/16	GW		
12					3	REPLACE PATIO DR w/ WINDOW	AUG 26/16	GW		
11					2	REVISED PLANS & ELEVATIONS.	AUG 22/16	GW		
10					1	ISSUED FOR CLIENT REVIEW.	AUG. 08/16	GW	Contractor must verify all dimensions on the job and report any discrepancy to the Designer before proceeding with the work. All drawings and specifications are instruments of service and the property of the Designer which must be returned at the completion of the work. Items are not to be scaled.	
no.	description		date	hw	no.	description	date	hw		

VA3
DESIGN
255 Consumers Rd Suite 120
Toronto ON M2J 1R4
t 416.630.2255 f 416.630.478
va3design.com



project name	LECCO RIDGE DEV. INC.	municipality	TOWN OF MILTON	project no.	16015
date	FRONT & REAR ELEVATION				drawing no.
2016-07					
drawn by	checked by	scale	file name		
AF	-	3/16" = 1'-0"	16015-IVY-3		
<small> GREG - H:\ARCHIVE\WORKING\2016\16015\GREG\UNITS\IVY\IVY_3\16015-IVY-3.dwg - Mon - Apr 10 2017 - 4:13 PM drawing no. A4b </small>					

All drawings specifications, related documents and design are the copyright property of VA3 DESIGN. Reproduction of this property in whole or in part is strictly prohibited without VA3 DESIGN's written permission.


1883 SF.

RECEIVED
TOWN OF MILTON
MAR 29, 2017
IVY 3
BUILDING DIVISION


TOWN OF MILTON
PLANNING AND DEVELOPMENT
IVY 3 MODEL
BUILDING: REVIEWED
SCOTT SHERRIFFS
PLANS EXAMINER
APR 18, 2017
DATE
Neither the issuance of a permit nor carrying out of
inspections by the Town of Milton relieves the owner from
full responsibility for compliance with the provisions of
the Ontario Building Code Act and the Ontario Building
Code, both as amended, as well as other applicable
statutes and regulations of the Province of Ontario,
By-laws of the Region of Halton and Town of Milton

It is the builder's complete responsibility to
ensure that all plans submitted for approval
fully comply with the Architectural Guidelines
and all applicable regulations and requirements
including zoning provisions and any provisions
in the subdivision agreement. The Control
Architect is not responsible in any way for
examining or approving site (lotting) plans or
working drawings with respect to any zoning or
building code or permit matter or that any
house can be properly built or located on its lot.


This is to certify that these plans comply
with the applicable Architectural Design
Guidelines approved by the Town of
MILTON.

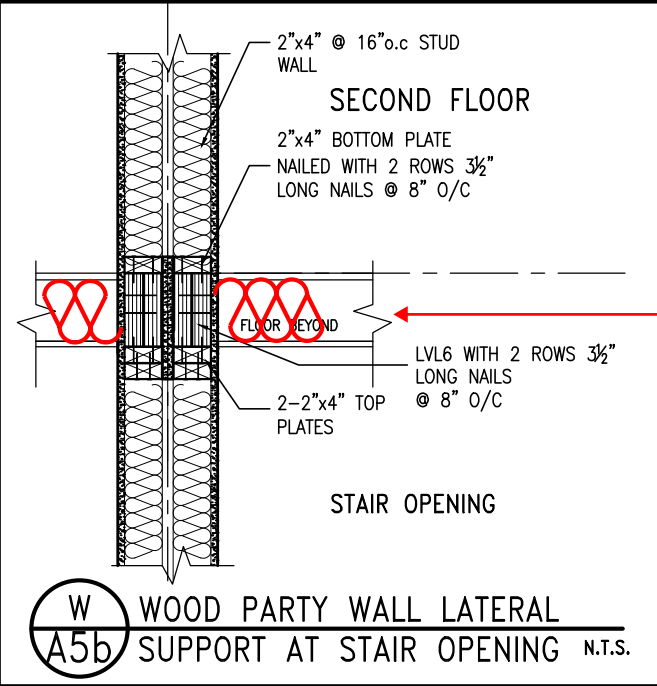

PARTY WALL SOUND RATING
Provide insulation in all joist spaces at
main floors and landings to maintain
required min 50 STC rating. See
standard details page 4 for standard
party wall construction details

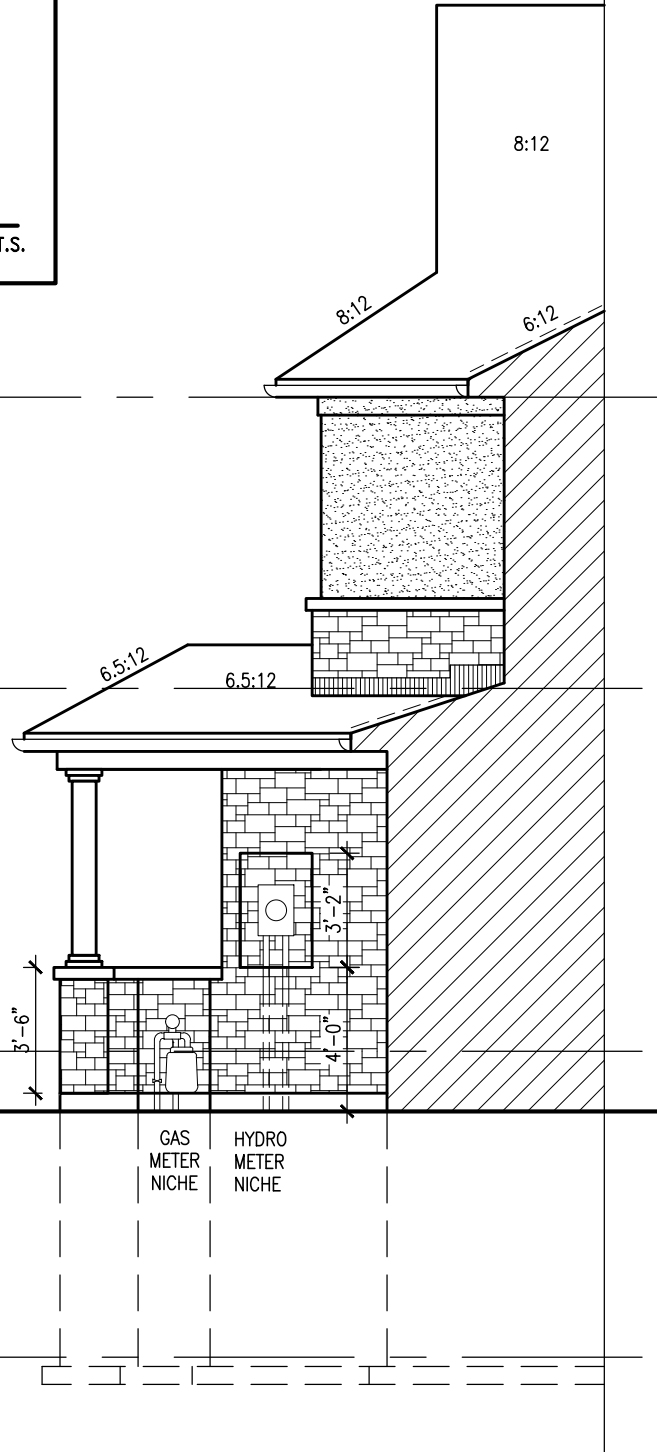

SECTION B

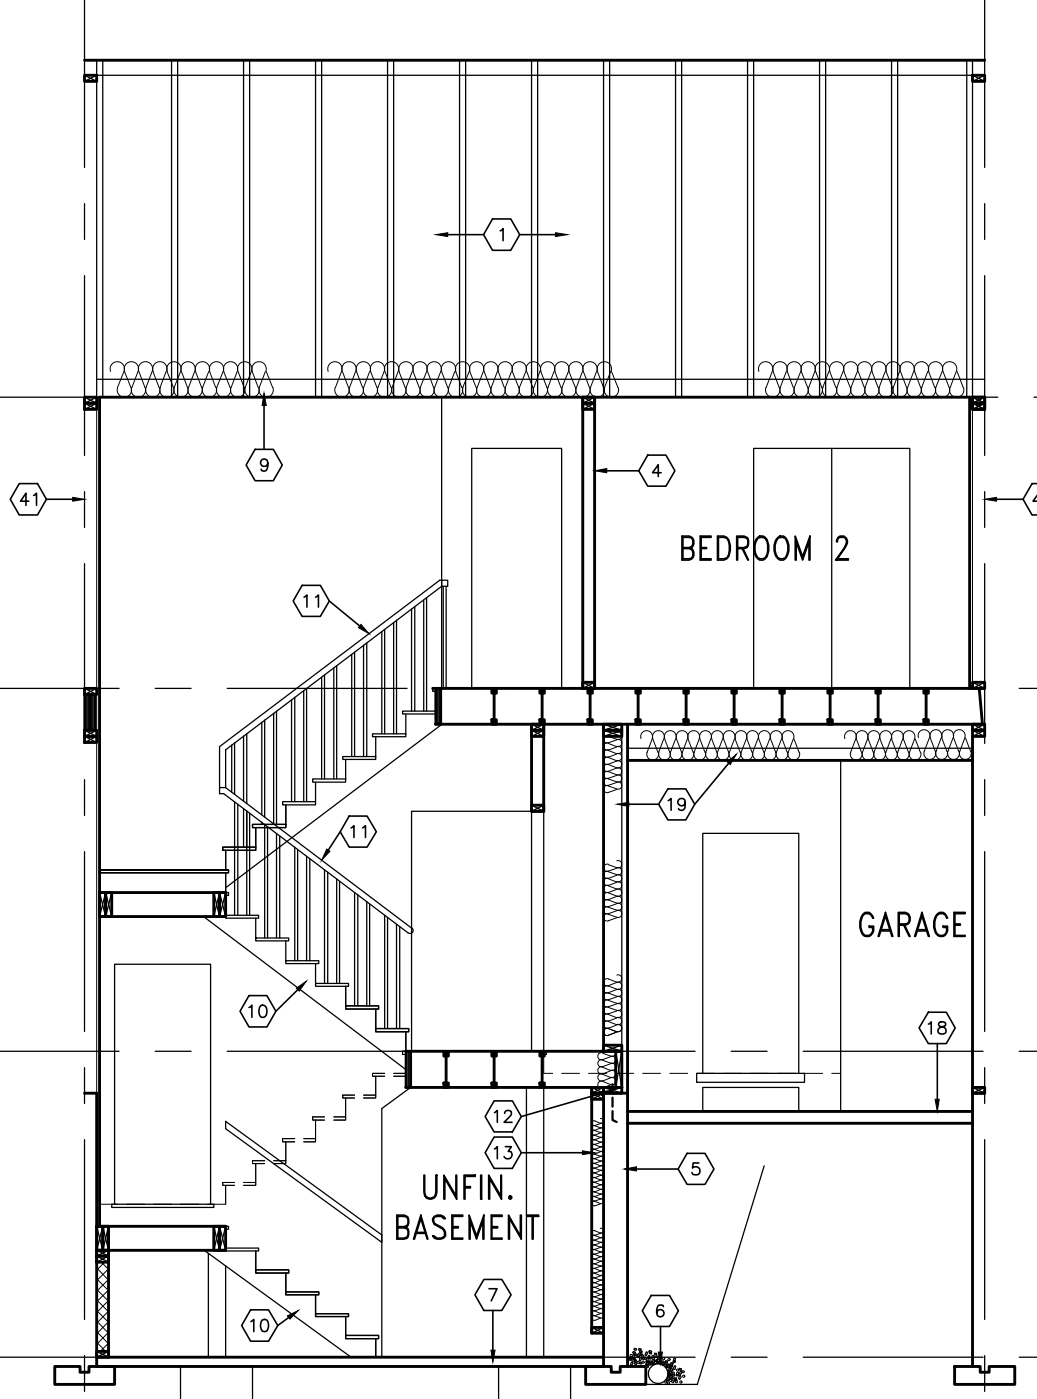

SECTION A-A ELEV. 3



18				9	REVISED PER BLDG. DEPT. COMMENTS.	APR. 10/17	GW
17				8	ISSUED FOR PERMIT.	MAR. 01/17	GW
16				7	ISSUED FOR PRICING.	DEC. 21/16	GW
15				6	CLOSET ADDED TO MASTER BEDROOM.	OCT. 27/16	GW
14				5	REVISED. ADD SUNKEN FOYER COND.	OCT 03/16	WT
13				4	2nd FL. WINDOW PANELS. STAIR SHIFT 4".	SEP 06/16	GW
12				3	REPLACE PATIO DR w/ WINDOW	AUG 26/16	GW
11				2	REVISED PLANS & ELEVATIONS.	AUG 22/16	GW
10				1	ISSUED FOR CLIENT REVIEW.	AUG. 08/16	GW
no.	description	date	by	no.	description	date	by

The undersigned has reviewed and takes responsibility for this design
and has the qualifications and meets the requirements set out in the
Ontario Building Code to be a Designer.
qualification information
Richard Vink
signature
24488
BCIN
VA3 Design Inc.
42658
Contractor must verify all dimensions on the job and report any
discrepancy to the Designer before proceeding with the work. All
drawings and specifications are instruments of service and the property
of the Designer which must be returned at the completion of the work.
Drawings are not to be scaled.

VA3
DESIGN
255 Consumers Rd Suite 120
Toronto ON M2J 1R4
t 416.630.2255 f 416.630.4782
va3design.com

		IVY 3	
project name LECCO RIDGE DEV. INC.		municipality TOWN OF MILTON	project no. 16015
date 2016-07		SECTION A-A ELEV. 3	
drawn by AF	checked by 3/16" = 1'-0"	scale	file name 16015-IVY-3
GREG - H:\ARCHIVE\WORKING\2016\16015.GRE\UNITS\IVY\IVY 3\16015-IVY-3.dwg - Mon - Apr 10 2017 - 4:13 PM		drawing no. A5b	

RECEIVED
TOWN OF MILTON
MAR 29, 2017
IVY 3
BUILDING DIVISION

TOWN OF MILTON
PLANNING AND DEVELOPMENT
IVY 3 MODEL
BUILDING: REVIEWED
SCOTT SHERRIFFS
PLANS EXAMINER
APR 18, 2017
DATE
Neither the issuance of a permit nor carrying out of
inspections by the Town of Milton relieves the owner from
full responsibility for compliance with the provisions of
the Ontario Building Code Act and the Ontario Building
Code, both as amended, as well as other applicable
statutes and regulations of the Province of Ontario,
By-laws of the Region of Halton and Town of Milton


1883 SF.

It is the builder's complete responsibility to
ensure that all plans submitted for approval
fully comply with the Architectural Guidelines
and all applicable regulations and requirements
including zoning provisions and any provisions
in the subdivision agreement. The Control
Architect is not responsible in any way for
examining or approving site (lotting) plans or
working drawings with respect to any zoning or
building code or permit matter or that any
house can be properly built or located on its lot.

This is to certify that these plans comply
with the applicable Architectural Design
Guidelines approved by the Town of
MILTON.


ARCHITECTURAL REVIEW & APPROVAL
MAR 20 2017
John G. Williams Limited, Architect

= 1 HOUR PARTY WALL
(FIRE SEPARATION)
PARTY WALL DETAILS
See standard details page 4
for standard party wall
construction details

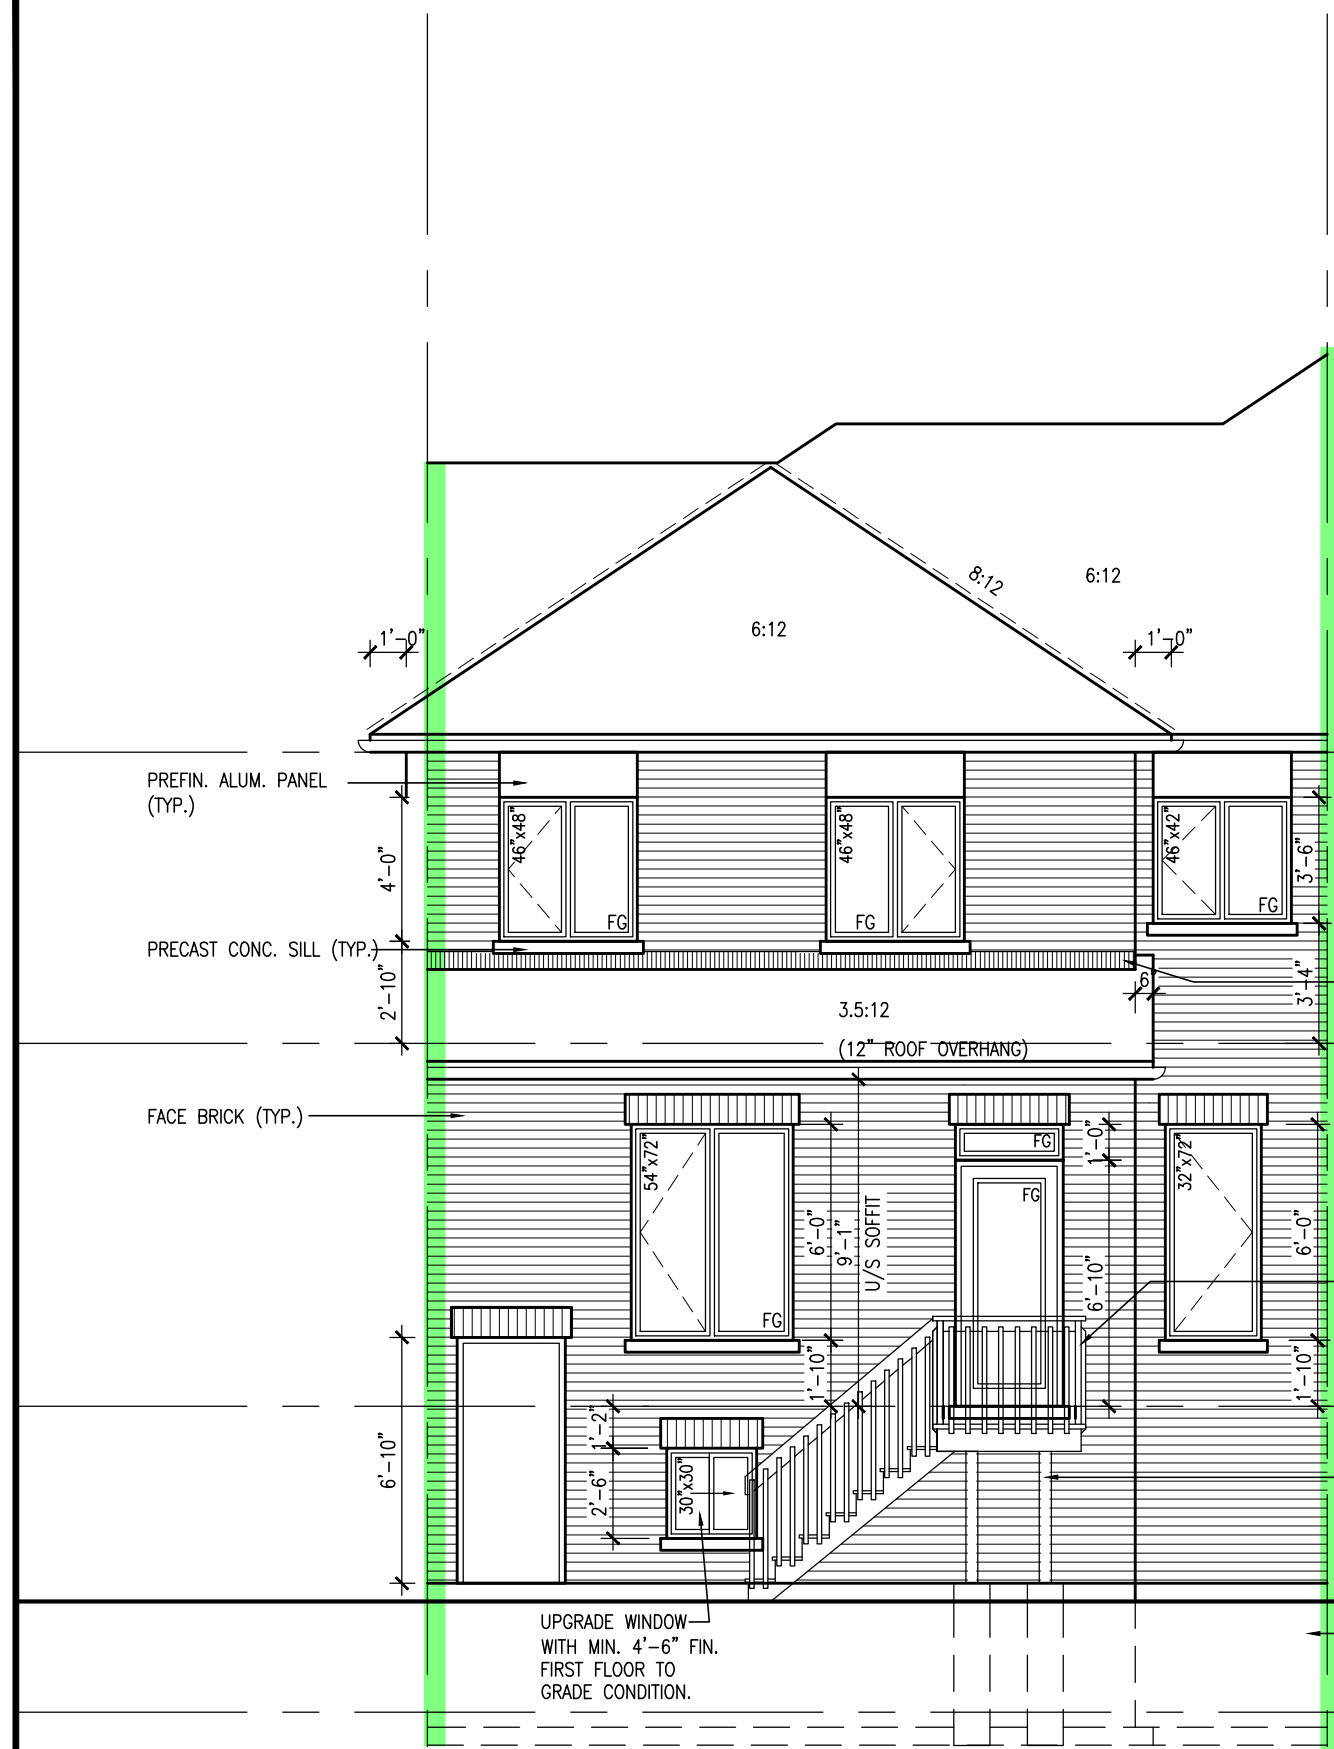

REAR ELEVATION ELEV. 3
DECK CONDITION (8R OR MORE)

DECK DETAILS
See standard details pages 5
and 5-2 for additional deck
construction details

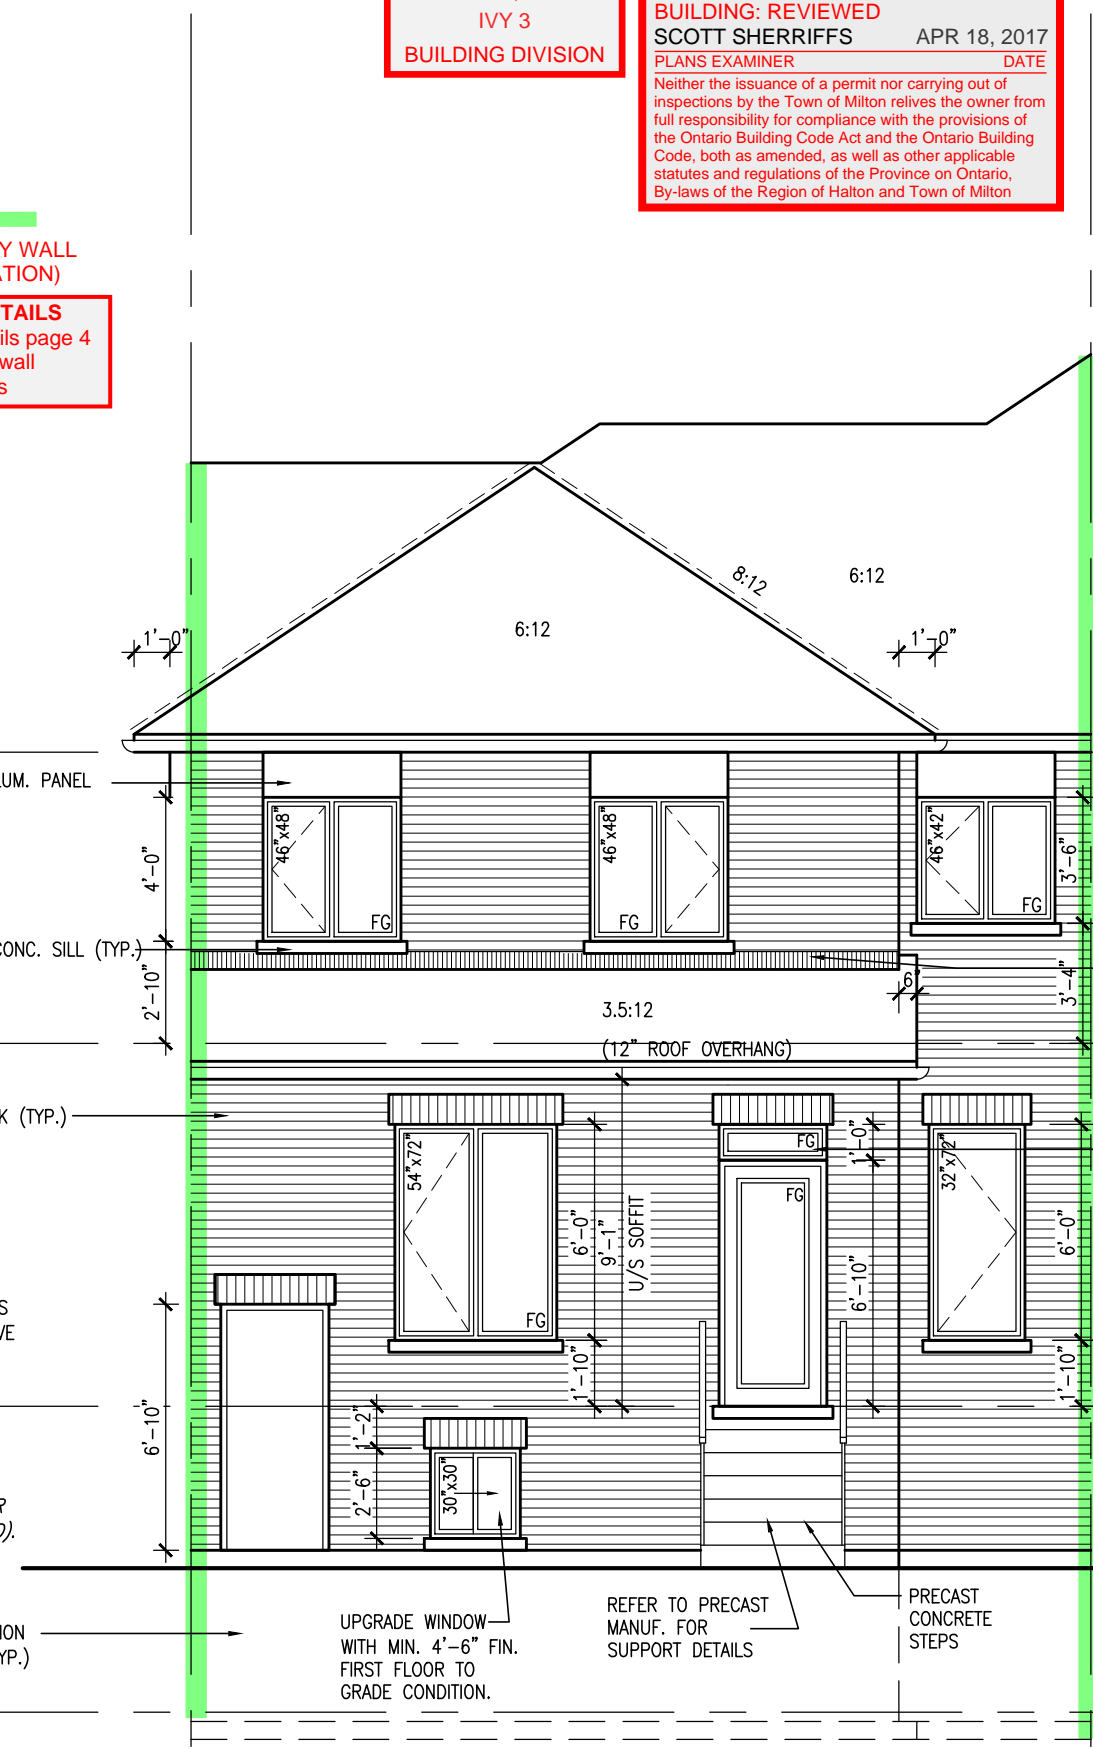

REAR ELEVATION ELEV. 3
DECK CONDITION (7R MAX.)

PRECAST STAIR/LANDING
Refer to master specifications
for anchorage details for
Parson's precast stair/landing

IVY 3
ENERGY STAR/ PANEL

18				9	REVISED PER BLDG. DEPT. COMMENTS.	APR. 10/17	GW
17				8	ISSUED FOR PERMIT.	MAR. 01/17	GW
16				7	ISSUED FOR PRICING.	DEC. 21/16	GW
15				6	CLOSET ADDED TO MASTER BEDROOM.	OCT. 27/16	GW
14				5	REVISED. ADD SUNKEN FOYER COND.	OCT 03/16	WT
13				4	2nd FL. WINDOW PANELS. STAIR SHIFT 4".	SEP 06/16	GW
12				3	REPLACE PATIO DR w/ WINDOW	AUG 26/16	GW
11				2	REVISED PLANS & ELEVATIONS.	AUG 22/16	GW
10				1	ISSUED FOR CLIENT REVIEW.	AUG. 08/16	GW
no.	description	date	by	no.	description	date	by

The undersigned has reviewed and takes responsibility for this design
and has the qualifications and meets the requirements set out in the
Ontario Building Code to be a Designer.
qualification information
Richard Vink
signature
24488
BCIN
name
registration information
VA3 Design Inc.
42658
Contractor must verify all dimensions on the job and report any
discrepancy to the Designer before proceeding with the work. All
drawings and specifications are instruments of service and the property
of the Designer which must be returned at the completion of the work.
Drawings are not to be scaled.

VA3
DESIGN
255 Consumers Rd Suite 120
Toronto ON M2J 1R4
t 416.630.2255 f 416.630.4782
va3design.com

Greenpark.
project name
LECCO RIDGE DEV. INC.
municipality
TOWN OF MILTON
project no.
16015
date
2016-07
drawn by
AF
checked by
3/16" = 1'-0"
scale
16015-IVY-3
file name
16015-IVY-3
drawing no.
A7b
REG - H:\ARCHIVE\WORKING\2016\16015\GRE\UNITS\IVY\IVY 3\16015-IVY-3.dwg - Mon - Apr 10 2017 - 4:13 PM