

SITE NAME: LECCO RIDGE  
BUILDER: GREENPARK HOMES

LOT 100  
TYPE: JUNIPER 9

GFA: 3475

DATE: Mar-17  
LO# 73317

WINTER NATURAL AIR CHANGE RATE 0.316  
SUMMER NATURAL AIR CHANGE RATE 0.108

HEAT LOSS ΔT °F. 72  
HEAT GAIN ΔT °F. 14

CSA-F280-12  
ENERGYSTAR

ROOM USE	EXP. WALL	CLG. HT.	MBR	ENS	BED-2	BED-3	BED-4	BATH	BED-5	ENS-4	ENS-5
	37	10	28	15	45	37	18	17	9	9	9
FACTORS											
GRS.WALL AREA	370		252	135	428	352	63	162	153	81	
GLAZING	LOSS GAIN	LOSS GAIN	LOSS GAIN	LOSS GAIN	LOSS GAIN	LOSS GAIN	LOSS GAIN	LOSS GAIN	LOSS GAIN	LOSS GAIN	LOSS GAIN
NORTH	17.9 15.8	0 0 0	9 161 143	15 268 238	0 0 0	0 0 0	7 125 111	0 0 0	0 0 0	0 0 0	0 0 0
EAST	17.9 41.4	0 0 0	0 0 0	0 0 0	52 928 2154	40 714 1657	0 0 0	0 0 0	11 196 456	0 0 0	0 0 0
SOUTH	17.9 24.8	0 0 0	0 0 0	0 0 0	0 0 0	8 143 198	0 0 0	24 428 594	0 0 0	8 143 198	0 0 0
WEST	17.9 41.4	34 607 1408	18 321 746	0 0 0	0 0 0	0 0 0	0 0 0	0 0 0	0 0 0	0 0 0	0 0 0
SKYLT.	30.6 101.2	0 0 0	0 0 0	0 0 0	0 0 0	0 0 0	0 0 0	0 0 0	0 0 0	0 0 0	0 0 0
DOORS	24.1 4.7	0 0 0	0 0 0	0 0 0	0 0 0	0 0 0	0 0 0	0 0 0	0 0 0	0 0 0	0 0 0
NET EXPOSED WALL	2.6 0.5	336 879 170	225 589 114	120 314 61	376 983 190	304 794 154	56 147 28	138 361 70	142 372 72	73 191 37	0 0 0
NET EXPOSED BSMT WALL ABOVE GR	3.3 0.6	0 0 0	0 0 0	0 0 0	0 0 0	0 0 0	0 0 0	0 0 0	0 0 0	0 0 0	0 0 0
EXPOSED CLG	1.4 0.7	336 463 230	159 219 109	255 351 175	302 416 207	250 344 171	84 116 58	306 422 210	84 116 58	180 248 123	0 0 0
NO ATTIC EXPOSED CLG	2.2 1.1	0 0 0	28 63 31	0 0 0	55 124 61	20 45 22	0 0 0	0 0 0	0 0 0	0 0 0	0 0 0
EXPOSED FLOOR	2.2 0.4	0 0 0	0 0 0	0 0 0	357 783 151	0 0 0	84 184 36	0 0 0	0 0 0	0 0 0	0 0 0
BASEMENT/CRAWL HEAT LOSS		0	0	0	0	0	0	0	0	0	0
SLAB ON GRADE HEAT LOSS		0	0	0	0	0	0	0	0	0	0
SUBTOTAL HT LOSS		1949	1353	933	3233	2040	571	1211	684	582	358
SUB TOTAL HT GAIN		1808	1142	473	2763	2202	232	874	585	31	
LEVEL FACTOR / MULTIPLIER	0.20 0.32	0.20 0.32	0.20 0.32	0.20 0.32	0.20 0.32	0.20 0.32	0.20 0.32	0.20 0.32	0.20 0.32	0.20 0.32	0.20 0.32
AIR CHANGE HEAT LOSS	617	428	296	1024	646	181	384	217	184	31	
AIR CHANGE HEAT GAIN	157	99	41	241	192	20	76	51	31		
DUCT LOSS	0	0	0	0	426	0	75	0	0	0	
DUCT GAIN	0	0	0	0	393	0	25	0	0	0	
HEAT GAIN PEOPLE	240	2	480	1	240	1	240	0	240	0	0
HEAT GAIN APPLIANCES/LIGHTS		686	0	686	686	686	0	686	0	0	0
TOTAL HT LOSS BTU/H		2566	1781	1229	4683	2687	828	1595	900	766	
TOTAL HT GAIN x 1.3 BTU/H		4072	1614	1873	5621	4316	361	2439	827	506	



ROOM USE	EXP. WALL	CLG. HT.	LV/DN	OFF	KT/IFM	LAUN	PWD	FOY	MUD	WUB	BAS
	50	11	29	11	78	0	11	17	21	19	196
FACTORS											
GRS.WALL AREA	550		319	858	0	121	204	273	181	1274	
GLAZING	LOSS GAIN	LOSS GAIN	LOSS GAIN	LOSS GAIN	LOSS GAIN	LOSS GAIN	LOSS GAIN	LOSS GAIN	LOSS GAIN	LOSS GAIN	LOSS GAIN
NORTH	17.9 15.8	0 0 0	0 0 0	0 0 0	0 0 0	0 0 0	0 0 0	0 0 0	9 161 143	10 179 158	0 0 0
EAST	17.9 41.4	0 0 0	40 714 1657	0 0 0	0 0 0	0 0 0	0 0 0	0 0 0	0 0 0	0 0 0	0 0 0
SOUTH	17.9 24.8	38 678 941	0 0 0	0 0 0	0 0 0	0 0 0	0 0 0	0 0 0	0 0 0	10 179 248	0 0 0
WEST	17.9 41.4	0 0 0	0 0 0	124 2214 5136	0 0 0	0 0 0	0 0 0	0 0 0	0 0 0	5 89 207	0 0 0
SKYLT.	30.6 101.2	0 0 0	0 0 0	0 0 0	0 0 0	0 0 0	0 0 0	0 0 0	0 0 0	0 0 0	0 0 0
DOORS	24.1 4.7	0 0 0	0 0 0	0 0 0	0 0 0	0 0 0	45 1082 209	20 481 93	20 481 93	20 481 93	0 0 0
NET EXPOSED WALL	2.6 0.5	512 1340 259	279 730 141	734 1921 371	0 0 0	121 317 61	159 416 80	244 638 123	161 420 81	0 0 0	0 0 0
NET EXPOSED BSMT WALL ABOVE GR	3.3 0.6	0 0 0	0 0 0	0 0 0	0 0 0	0 0 0	0 0 0	0 0 0	0 0 0	588 1963 380	0 0 0
EXPOSED CLG	1.4 0.7	0 0 0	0 0 0	0 0 0	72 99 49	0 0 0	0 0 0	0 0 0	0 0 0	0 0 0	0 0 0
NO ATTIC EXPOSED CLG	2.2 1.1	0 0 0	0 0 0	10 22 11	0 0 0	0 0 0	0 0 0	0 0 0	0 0 0	0 0 0	0 0 0
EXPOSED FLOOR	2.2 0.4	0 0 0	0 0 0	0 0 0	28 61 12	0 0 0	0 0 0	0 0 0	0 0 0	0 0 0	0 0 0
BASEMENT/CRAWL HEAT LOSS		0	0	0	0	0	0	0	0	6613	
SLAB ON GRADE HEAT LOSS		0	0	0	0	0	0	0	0	0	
SUBTOTAL HT LOSS		2018	1444	4157	161	317	1498	1280	901	9503	1086
SUB TOTAL HT GAIN		1200	1798	5519	61	61	290	359	174	0.50 0.97	
LEVEL FACTOR / MULTIPLIER	0.30 0.56	0.30 0.56	0.30 0.56	0.30 0.56	0.20 0.32	0.30 0.56	0.30 0.56	0.30 0.56	0.30 0.56	10070	110
AIR CHANGE HEAT LOSS	1138	814	2344	481	51	179	845	722	31	0	
AIR CHANGE HEAT GAIN	105	157	481	21	5	5	25	31	0	0	
DUCT LOSS	0	0	0	0	99	0	0	0	0	0	
DUCT GAIN	0	0	0	0	240	0	0	0	0	0	
HEAT GAIN PEOPLE	240	0	0	1	240	0	0	0	0	0	0
HEAT GAIN APPLIANCES/LIGHTS		686	686	686	686	686	0	686	0	686	
TOTAL HT LOSS BTU/H		3156	2258	6501	233	495	2343	2002	901	19573	
TOTAL HT GAIN x 1.3 BTU/H		2588	3433	9003	1420	87	409	1400	226	2446	

TOTAL HEAT GAIN BTU/H: 43136

TONS: 3.59

LOSS DUE TO VENTILATION LOAD BTU/H: 2552

STRUCTURAL HEAT LOSS: 54497

TOTAL COMBINED HEAT LOSS BTU/H: 57049

SITE NAME: LECCO RIDGE  
BUILDER: GREENPARK HOMES

LOT 100  
TYPE: JUNIPER 9

DATE: Mar-17

GFA: 3475 LO# 73317

HEATING CFM 1316 COOLING CFM 1316  
TOTAL HEAT LOSS 54,497 TOTAL HEAT GAIN 42,642  
AIR FLOW RATE CFM 24.15 AIR FLOW RATE CFM 30.86

furnace pressure 0.6  
furnace filter 0.05  
a/c coil pressure 0.2  
available pressure  
for s/a & r/a 0.35

~\*AMANA  
AMVC960804CNA 80  
FAN SPEED  
LOW 1316  
MEDLOW 0  
MEDIUM 1389  
MEDIUM HIGH 0  
HIGH 1396

AFUE = 96.0 %  
INPUT (BTU/H) = 80,000  
OUTPUT (BTU/H) = 76,800  
DESIGN CFM = 1316  
CFM @ 6" E.S.P.

plenium pressure s/a 0.18  
max s/a dif. press. loss 0.02  
min adjusted pressure s/a 0.16  
r/a pressure 0.17  
r/a grille press. Loss 0.02  
adjusted pressure r/a 0.15

All S/A diffusers 4"x10" unless noted otherwise on layout.  
All S/A runs 5"Ø unless noted otherwise on layout.

RUN COUNT	4th	3rd	2nd	1st	Bas
S/A	0	0	14	8	5
R/A	0	0	5	2	1

RUN #	1	2	3	4	5	6	7	8	9	10	11	12	13	14	15	16	17	18	19	20	21	22	23	24
ROOM NAME	MBR	ENS	ENS	BED-2	BED-3	BED-4	BATH	BED-3	BED-4	MBR	ENS-5	LV/DN	OFF	KT/FM	KT/FM	KT/FM	MUD	PWD	FOY	ENS-4	BED-5	BAS	BAS	BAS
RM LOSS MBH.	1.28	0.89	0.89	1.23	2.34	1.34	0.83	2.34	1.34	1.28	0.77	3.16	2.26	2.17	2.17	2.17	2.00	0.50	2.34	0.90	1.59	4.09	4.09	4.09
CFM PER RUN HEAT	31	22	22	30	57	32	20	57	32	31	19	76	55	52	52	52	48	12	57	22	39	99	99	99
RM GAIN MBH.	2.04	0.81	0.81	1.87	2.81	2.16	0.36	2.81	2.16	2.04	0.51	2.59	3.43	3.00	3.00	3.00	1.40	0.09	0.41	0.83	2.44	0.53	0.53	0.53
CFM PER RUN COOLING	63	25	25	58	87	67	11	87	67	63	16	80	106	93	93	93	43	3	13	26	75	16	16	16
ADJUSTED PRESSURE	0.17	0.17	0.17	0.17	0.16	0.17	0.17	0.16	0.17	0.17	0.17	0.17	0.16	0.16	0.16	0.16	0.17	0.17	0.17	0.17	0.17	0.16	0.16	0.16
ACTUAL DUCT LGH.	27	59	43	47	47	75	51	50	66	41	21	39	59	22	31	39	44	19	45	65	50	38	29	13
EQUIVALENT LENGTH	150	180	140	170	130	180	150	140	170	150	190	160	180	150	150	120	120	160	130	140	160	110	150	170
TOTAL EFFECTIVE LENGTH	177	239	183	217	177	255	201	190	236	191	211	199	239	172	181	159	164	179	175	205	210	148	179	183
ADJUSTED PRESSURE	0.1	0.07	0.09	0.08	0.09	0.07	0.09	0.09	0.07	0.09	0.08	0.09	0.07	0.09	0.09	0.1	0.1	0.1	0.1	0.08	0.08	0.11	0.09	0.09
ROUND DUCT SIZE	5	4	4	5	5	5	4	5	5	5	4	5	6	6	6	5	4	4	5	4	5	5	6	6
HEATING VELOCITY (ft/min)	228	252	252	220	419	235	229	419	235	228	218	558	280	265	265	382	551	138	419	252	286	727	505	505
COOLING VELOCITY (ft/min)	463	287	287	426	639	492	126	639	492	463	184	587	540	474	474	683	493	34	95	298	551	117	82	82
OUTLET GRILL SIZE	3X10	3X10	3X10	3X10	3X10	3X10	3X10	3X10	3X10	3X10	3X10	3X10	4X10	4X10	4X10	3X10	3X10	3X10	3X10	3X10	3X10	4X10	4X10	4X10
TRUNK	B	A	B	A	D	C	D	D	C	B	B	D	C	B	A	A	A	D	C	C	D	A	B	D

RUN #	25	26	27
ROOM NAME	BAS	BAS	LAUN
RM LOSS MBH.	4.09	4.09	0.23
CFM PER RUN HEAT	99	99	6
RM GAIN MBH.	0.53	0.53	1.42
CFM PER RUN COOLING	16	16	44
ADJUSTED PRESSURE	0.16	0.16	0.17
ACTUAL DUCT LGH.	37	49	38
EQUIVALENT LENGTH	90	150	180
TOTAL EFFECTIVE LENGTH	127	199	218
ADJUSTED PRESSURE	0.13	0.08	0.08
ROUND DUCT SIZE	5	6	4
HEATING VELOCITY (ft/min)	727	505	69
COOLING VELOCITY (ft/min)	117	82	505
OUTLET GRILL SIZE	3X10	4X10	3X10
TRUNK	D	C	D

RECEIVED  
TOWN OF MILTON  
MAR 29, 2017  
17-4690  
BUILDING DIVISION

SUPPLY AIR TRUNK SIZE														RETURN AIR TRUNK SIZE											
TRUNK	STATIC	ROUND	RECT	VELOCITY				TRUNK	STATIC	ROUND	RECT	VELOCITY				TRUNK	STATIC	ROUND	RECT	VELOCITY				TRUNK	STATIC
CFM	PRESS.	DUCT	DUCT				(ft/min)	CFM	PRESS.	DUCT	DUCT				(ft/min)	CFM	PRESS.	DUCT	DUCT					CFM	PRESS.
TRUNK A	303	0.07	9.3	10	X	8	545	TRUNK G	0	0.00	0	0	X	8	0	TRUNK O	0	0.05	0	0	X	8	0	TRUNK O	0
TRUNK B	557	0.07	11.6	16	X	8	627	TRUNK H	0	0.00	0	0	X	8	0	TRUNK P	0	0.05	0	0	X	8	0	TRUNK P	0
TRUNK C	297	0.07	9.2	10	X	8	535	TRUNK I	0	0.00	0	0	X	8	0	TRUNK Q	0	0.05	0	0	X	8	0	TRUNK Q	0
TRUNK D	762	0.07	13.1	20	X	8	686	TRUNK J	0	0.00	0	0	X	8	0	TRUNK R	0	0.05	0	0	X	8	0	TRUNK R	0
TRUNK E	0	0.00	0	0	X	8	0	TRUNK K	0	0.00	0	0	X	8	0	TRUNK S	0	0.05	0	0	X	8	0	TRUNK S	0
TRUNK F	0	0.00	0	0	X	8	0	TRUNK L	0	0.00	0	0	X	8	0	TRUNK T	0	0.05	0	0	X	8	0	TRUNK T	0
																TRUNK U	0	0.05	0	0	X	8	0	TRUNK U	0
																TRUNK V	0	0.05	0	0	X	8	0	TRUNK V	0
																TRUNK W	0	0.05	0	0	X	8	0	TRUNK W	0
																TRUNK X	876	0.05	15	26	X	8	606	TRUNK X	876
																TRUNK Y	675	0.05	13.6	22	X	8	552	TRUNK Y	675
																TRUNK Z	440	0.05	11.6	16	X	8	495	TRUNK Z	440
																DROP	1316	0.05	17.5	24	X	12	658	DROP	1316

RETURN AIR #	1	2	3	4	5	6	7	8	9	10	11	12	13	14	15	16	17	18	19	20	21	22	23	24
AIR VOLUME	135	95	175	85	175	365	85	0	0	0	0	0	0	0	0	0	0	0	0	0	0	0	0	0
PLENUM PRESSURE	0.15	0.15	0.15	0.15	0.15	0.15	0.15	0.15	0.15	0.15	0.15	0.15	0.15	0.15	0.15	0.15	0.15	0.15	0.15	0.15	0.15	0.15	0.15	0.15
ACTUAL DUCT LGH.	42	58	57	59	22	24	54	1	1	1	1	1	1	1	1	1	1	1	1	1	1	1	1	1
EQUIVALENT LENGTH	230	145	165	205	185	225	190	0	0	0	0	0	0	0	0	0	0	0	0	0	0	0	0	0
TOTAL EFFECTIVE LH	272	203	222	264	207	249	244	1	1	1	1	1	1	1	1	1	1	1	1	1	1	1	1	1
ADJUSTED PRESSURE	0.05	0.07	0.07	0.06	0.07	0.06	0.06	14.80	14.80	14.80	14.80	14.80	14.80	14.80	14.80	14.80	14.80	14.80	14.80	14.80	14.80	14.80	14.80	14.80
ROUND DUCT SIZE	7.5	6	7.5	6	7.5	10.3	6	0	0	0	0	0	0	0	0	0	0	0	0	0	0	0	0	0
INLET GRILL SIZE	8	8	8	8	8	8	8	0	0	0	0	0	0	0	0	0	0	0	0	0	0	0	0	0
INLET GRILL SIZE	X	X	X	X	X	X	X	X	X	X	X	X	X	X	X	X	X	X	X	X	X	X	X	X
INLET GRILL SIZE	14	14	14	14	14	30	14	0	0	0	0	0	0	0	0	0	0	0	0	0	0	0	0	0

TYPE: JUNIPER 9  
SITE NAME: LECCO RIDGE

LO # 73317  
LOT 100

**RESIDENTIAL MECHANICAL VENTILATION DESIGN SUMMARY**

COMBUSTION APPLIANCES		9.32.3.1(1)
a)	<input checked="" type="checkbox"/> Direct vent (sealed combustion) only	
b)	<input type="checkbox"/> Positive venting induced draft (except fireplaces)	
c)	<input type="checkbox"/> Natural draft, B-vent or induced draft gas fireplace	
d)	<input type="checkbox"/> Solid Fuel (including fireplaces)	
e)	<input type="checkbox"/> No Combustion Appliances	

HEATING SYSTEM	
<input checked="" type="checkbox"/> Forced Air	<input type="checkbox"/> Non Forced Air
<input type="checkbox"/> Electric Space Heat	

HOUSE TYPE		9.32.1(2)
<input checked="" type="checkbox"/> I	Type a) or b) appliance only, no solid fuel	
<input type="checkbox"/> II	Type I except with solid fuel (including fireplaces)	
<input type="checkbox"/> III	Any Type c) appliance	
<input type="checkbox"/> IV	Type I, or II with electric space heat	
<input type="checkbox"/>	Other: Type I, II or IV no forced air	

SYSTEM DESIGN OPTIONS		O.N.H.W.P.
<input type="checkbox"/> 1	Exhaust only/Forced Air System	
<input type="checkbox"/> 2	HRV with Ducting/Forced Air System	
<input checked="" type="checkbox"/> 3	HRV Simplified/connected to forced air system	
<input type="checkbox"/> 4	HRV with Ducting/non forced air system	
<input type="checkbox"/>	Part 6 Design	

TOTAL VENTILATION CAPACITY		9.32.3.3(1)
Basement + Master Bedroom	2 @ 21.2 cfm	42.4 cfm
Other Bedrooms	4 @ 10.6 cfm	42.4 cfm
Kitchen & Bathrooms	6 @ 10.6 cfm	63.6 cfm
Other Rooms	6 @ 10.6 cfm	63.6 cfm
Table 9.32.3.A.	TOTAL	212.0 cfm

PRINCIPAL VENTILATION CAPACITY REQUIRED		9.32.3.4.(1)
1 Bedroom	31.8 cfm	
2 Bedroom	47.7 cfm	
3 Bedroom	63.6 cfm	
4 Bedroom	79.5 cfm	
5 Bedroom	95.4 cfm	
More than 5 - Part 6	TOTAL	95.4 cfm

SUPPLEMENTAL VENTILATION CAPACITY		9.32.3.5.
Total Ventilation Capacity	212	cfm
Less Principal Ventil. Capacity	96	cfm
Required Supplemental Capacity	116.0	cfm

PRINCIPAL EXHAUST FAN CAPACITY	
Model:	VANEE 50H
Location:	BSMT
96.0 cfm	3.0 sones
<input checked="" type="checkbox"/>	HVI Approved

PRINCIPAL EXHAUST HEAT LOSS CALCULATION				
CFM	ΔT °F	FACTOR	% LOSS	
96.0 CFM	X 72 F	X 1.08	X	0.34

SUPPLEMENTAL FANS		NUTONE		
Location	Model	cfm	HVI	Sones
ENS	QTXEN050C	50	<input checked="" type="checkbox"/>	0.3
BATH	QTXEN050C	50	<input checked="" type="checkbox"/>	0.3
ENS-5	QTXEN050C	50	<input checked="" type="checkbox"/>	0.3
PWD	QTXEN050C	50	<input checked="" type="checkbox"/>	0.3

HEAT RECOVERY VENTILATOR		9.32.3.11.
Model:	VANEE 50H	
96 cfm high	47 cfm low	
66 % Sensible Efficiency	<input checked="" type="checkbox"/> HVI Approved	
@ 32 deg F ( 0 deg C)		

LOCATION OF INSTALLATION	
Lot:	
Township:	
Address:	
Roll #	

**RECEIVED**  
**TOWN OF MILTON**  
**MAR 29, 2017**  
**17-4690**  
**BUILDING DIVISION**

BUILDER:		TOWN OF MILTON	
Name:	GR	PLANNING AND DEVELOPMENT	
Address:		BUILDING PERMIT: 17-4690	
City:		BUILDING: REVIEWED	
Telephone #:		SCOTT SHERRIFFS	
		APR 19, 2017	
		PLANS EXAMINER	
		DATE	
		Neither the issuance of a permit nor carrying out of inspections by the Town of Milton relieves the owner from full responsibility for compliance with the provisions of the Ontario Building Code Act and the Ontario Building Code, both as amended, as well as other applicable statutes and regulations of the Province of Ontario, By-laws of the Region of Halton and Town of Milton	

INSTALLING CONTRACTOR	
Name:	
Address:	
City:	
Telephone #:	
Fax #:	

DESIGNER CERTIFICATION	
I hereby certify that this ventilation system has been designed in accordance with the Ontario Building Code.	
Name:	HVAC Designs Ltd.
Signature:	<i>Michael O'Rourke</i>
HRAI #	001820
Date:	March-17

**HEAT LOSS AND GAIN SUMMARY SHEET**

MODEL: JUNIPER 9	LOT 100	BUILDER: GREENPARK HOMES
SFQT: 3475	LO# 73317	SITE: LECCO RIDGE

**DESIGN ASSUMPTIONS**

HEATING	°F	COOLING	°F
OUTDOOR DESIGN TEMP.	0	OUTDOOR DESIGN TEMP.	86
INDOOR DESIGN TEMP.	72	INDOOR DESIGN TEMP. (MAX 75°F)	72

**BUILDING DATA**

ATTACHMENT:	DETACHED	# OF STORIES (+BASEMENT):	3
FRONT FACES:	EAST	ASSUMED (Y/N):	Y
AIR CHANGES PER HOUR:	3.57	ASSUMED (Y/N):	Y
AIR TIGHTNESS CATEGORY:	AVERAGE	ASSUMED (Y/N):	Y
WIND EXPOSURE:	SHELTERED	ASSUMED (Y/N):	Y
HOUSE VOLUME (ft³):	49192.0	ASSUMED (Y/N):	Y
INTERNAL SHADING:	BLINDS/CURTAINS	ASSUMED OCCUPANTS:	6
INTERIOR LIGHTING LOAD (Btu/h/ft²):	1.50	DC BRUSHLESS MOTOR (Y/N):	Y
FOUNDATION CONFIGURATION	BCIN_1	DEPTH BELOW GRADE:	6.5 ft
LENGTH: 60.0 ft	WIDTH: 38.0 ft	EXPOSED PERIMETER:	196.0 ft

**2012 OBC - COMPLIANCE PACKAGE**

Component	Compliance Package ENERGYSTAR
Ceiling with Attic Space Minimum RSI (R)-Value	50
Ceiling Without Attic Space Minimum RSI (R)-Value	31
Exposed Floor Minimum RSI (R)-Value	31
Walls Above Grade Minimum RSI (R)-Value	20 + 5
Basement Walls Minimum RSI (R)-Value	20
Below Grade Slab Entire surface > 600 mm below grade Minimum RSI (R)-Value	-
Edge of Below Grade Slab ≤ 600 mm Below Grade Minimum RSI (R)-Value	10
Heated Slab or Slab ≤ 600 mm below grade Minimum RSI (R)-Value	10
Windows and Sliding Glass Doors Maximum U-Value	ZONE 2
Skylights Maximum U-Value	ZONE 2
Space Heating Equipment Minimum AFUE	0.95
HRV Minimum Efficiency	65%
Domestic Hot Water Heater Minimum EF	90% TE

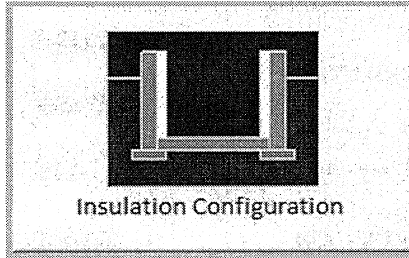
RECEIVED  
TOWN OF MILTON  
MAR 29, 2017  
17-4690  
BUILDING DIVISION

INDIVIDUAL BCIN: 19669  
MICHAEL O'ROURKE

*Michael O'Rourke*

## Residential Foundation Thermal Load Calculator

Supplemental tool for CAN/CSA-F280

Weather Station Description		
Province:	Ontario	
Region:	Milton	
Site Description		
Soil Conductivity:	Normal conductivity: dry sand, loam, clay	
Water Table:	Normal (7-10 m, 23-33 ft)	
Foundation Dimensions		
Floor Length (m):	18.3	 Insulation Configuration
Floor Width (m):	11.6	
Exposed Perimeter (m):	0.0	
Wall Height (m):	2.9	
Depth Below Grade (m):	2.0	
Window Area (m <sup>2</sup> ):	2.3	
Door Area (m <sup>2</sup> ):	3.7	
Radiant Slab		
Heated Fraction of the Slab:	0	
Fluid Temperature (°C):	33	
Design Months		
Heating Month	1	
Foundation Loads		
Heating Load (Watts):		1938

TYPE: JUNIPER 9  
LO# 73317

LOT 100

RECEIVED  
TOWN OF MILTON  
MAR 29, 2017  
17-4690  
BUILDING DIVISION

# Air Infiltration Residential Load Calculator

Supplemental tool for CAN/CSA-F280


Weather Station Description				
Province:	Ontario			
Region:	Milton			
Weather Station Location:	Open flat terrain, grass			
Anemometer height (m):	10			
Local Shielding				
Building Site:	Suburban, forest			
Walls:	Heavy			
Flue:	Heavy			
Highest Ceiling Height (m):	7.01			
Building Configuration				
Type:	Detached			
Number of Stories:	Two			
Foundation:	Full			
House Volume (m <sup>3</sup> ):	1393.0			
Air Leakage/Ventilation				
Air Tightness Type:	Present (1961-) (3.57 ACH)			
Custom BDT Data:	ELA @ 10 Pa.	1856.9 cm <sup>2</sup>		
	3.57	ACH @ 50 Pa		
Mechanical Ventilation (L/s):	Total Supply	Total Exhaust		
	45.3	45.3		
Flue Size				
Flue #:	#1	#2	#3	#4
Diameter (mm):	0	0	0	0
Natural Infiltration Rates				
Heating Air Leakage Rate (ACH/H):	0.316			
Cooling Air Leakage Rate (ACH/H):	0.108			

TYPE: JUNIPER 9  
LO# 73317

LOT 100

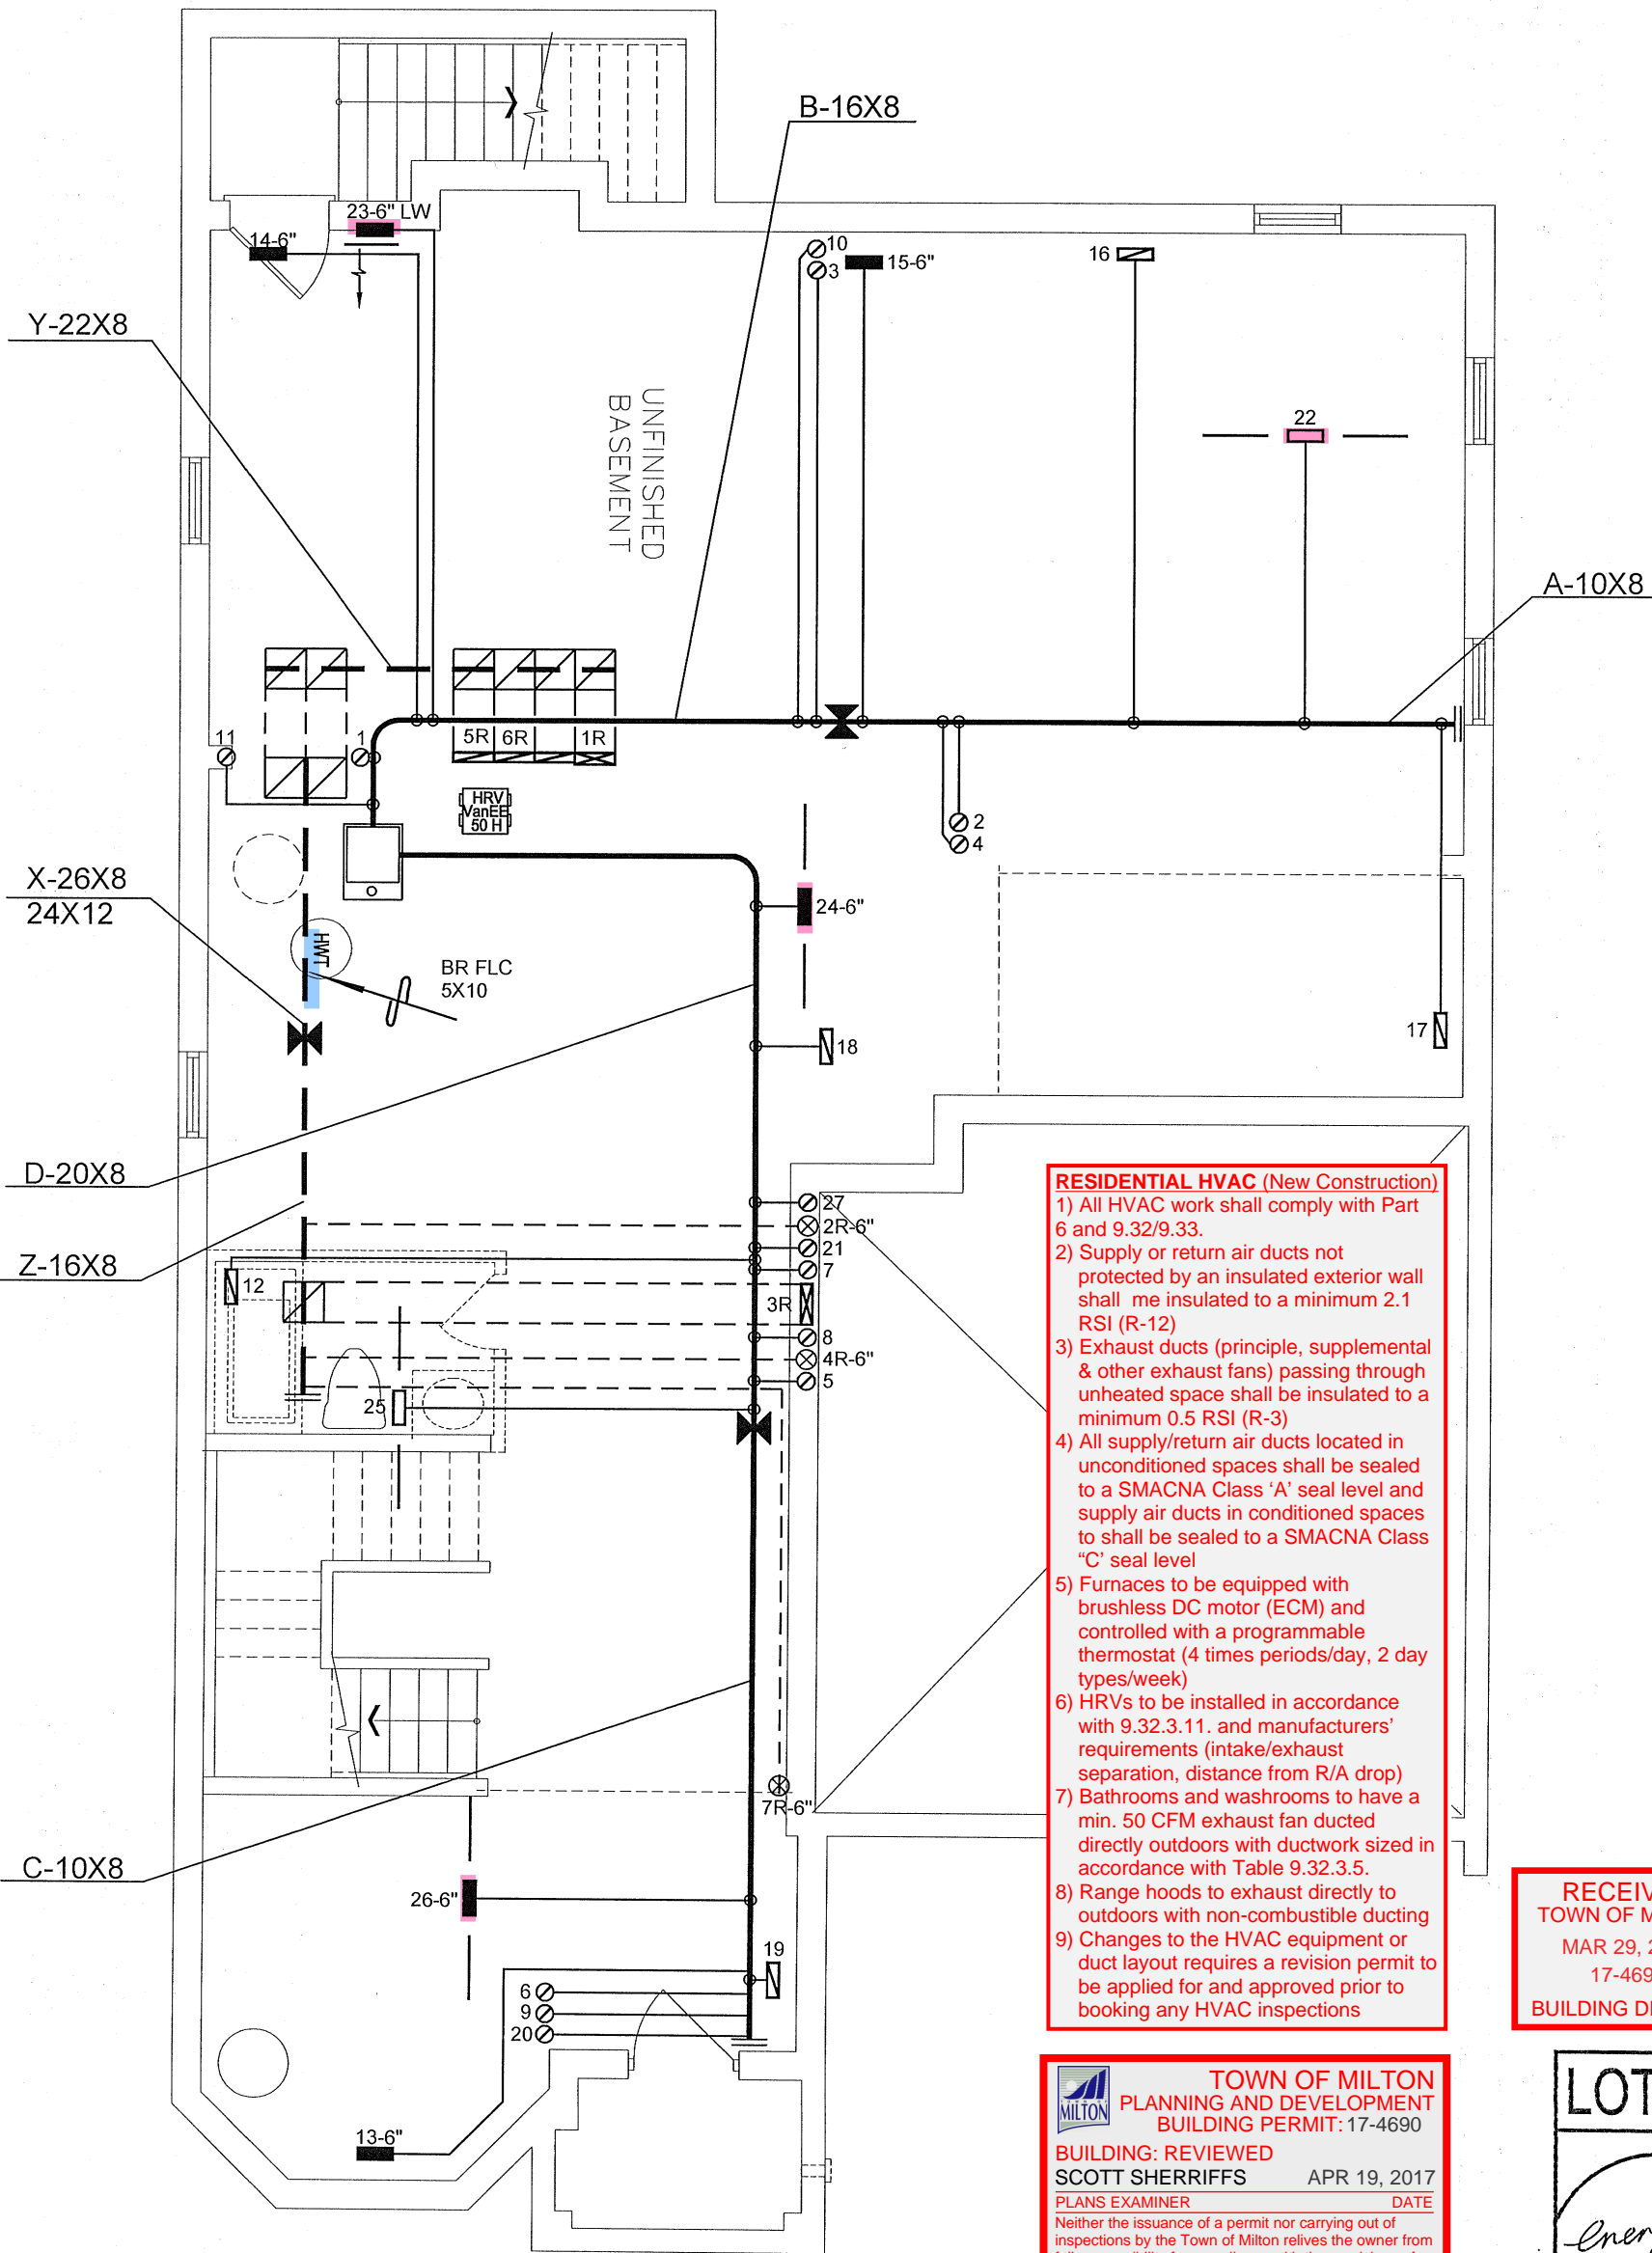RECEIVED  
TOWN OF MILTON  
MAR 29, 2017  
17-4690  
BUILDING DIVISION





**RESIDENTIAL HVAC (New Construction)**

- 1) All HVAC work shall comply with Part 6 and 9.32/9.33.
- 2) Supply or return air ducts not protected by an insulated exterior wall shall be insulated to a minimum 2.1 RSI (R-12)
- 3) Exhaust ducts (principle, supplemental & other exhaust fans) passing through unheated space shall be insulated to a minimum 0.5 RSI (R-3)
- 4) All supply/return air ducts located in unconditioned spaces shall be sealed to a SMACNA Class 'A' seal level and supply air ducts in conditioned spaces to shall be sealed to a SMACNA Class "C" seal level
- 5) Furnaces to be equipped with brushless DC motor (ECM) and controlled with a programmable thermostat (4 times periods/day, 2 day types/week)
- 6) HRVs to be installed in accordance with 9.32.3.11. and manufacturers' requirements (intake/exhaust separation, distance from R/A drop)
- 7) Bathrooms and washrooms to have a min. 50 CFM exhaust fan ducted directly outdoors with ductwork sized in accordance with Table 9.32.3.5.
- 8) Range hoods to exhaust directly to outdoors with non-combustible ducting
- 9) Changes to the HVAC equipment or duct layout requires a revision permit to be applied for and approved prior to booking any HVAC inspections

**TOWN OF MILTON**  
PLANNING AND DEVELOPMENT  
BUILDING PERMIT: 17-4690

**BUILDING: REVIEWED**  
**SCOTT SHERRIFFS** APR 19, 2017  
PLANS EXAMINER DATE

Neither the issuance of a permit nor carrying out of inspections by the Town of Milton relieves the owner from full responsibility for compliance with the provisions of the Ontario Building Code Act and the Ontario Building Code, both as amended, as well as other applicable statutes and regulations of the Province of Ontario, By-laws of the Region of Halton and Town of Milton

**RECEIVED**  
**TOWN OF MILTON**  
MAR 29, 2017  
17-4690  
**BUILDING DIVISION**

**LOT 100**

**ENERGY STAR**

**CSA-F280-12**


I MICHAEL O'ROURKE HAVE REVIEWED AND TAKE RESPONSIBILITY FOR THE DESIGN WORK AND AM QUALIFIED UNDER DIVISION C.3.2.5 OF THE BUILDING CODE.

*Michael O'Rourke*  
Michael O'Rourke, BCIN# 19669  
HVAC DESIGNS LTD.

HVAC LEGEND								3.		
SYMBOL	DESCRIPTION	SYMBOL	DESCRIPTION	SYMBOL	DESCRIPTION	SYMBOL	DESCRIPTION	2.		
	FLOOR SUPPLY AIR GRILLE		6" SUPPLY AIR BOOT ABOVE		14"x8" RETURN AIR GRILLE		RETURN AIR STACK ABOVE	1.		
	FLOOR SUPPLY AIR GRILLE 6" BOOT		SUPPLY AIR STACK FROM 2nd FLOOR		30"x8" RETURN AIR GRILLE		RETURN AIR STACK 2nd FLOOR	No.	Description	Date
	SUPPLY AIR BOOT ABOVE		6" SUPPLY AIR STACK 2nd FLOOR		FRA- FLOOR RETURN AIR GRILLE		REDUCER	REVISIONS		

ALL DRAWINGS, CALCULATIONS AND SPECIFICATIONS ARE THE PROPERTY OF HVAC DESIGNS LTD.© AND MAY NOT BE REPRODUCED, MODIFIED OR ALTERED WITHOUT EXPRESSED WRITTEN CONSENT. THE DRAWINGS ARE DATED AND USE OF THESE DRAWINGS AFTER ONE YEAR FROM THE DATED NOTED IS NOT AUTHORIZED. CONTRACTOR SHALL CHECK ALL CONDITIONS BEFORE PROCEEDING WITH WORK. LATEST MUNICIPAL APPROVED DRAWINGS ONLY TO BE USED DURING INSTALLATION OF HEATING SYSTEM. HVAC DESIGNS LTD. IS NOT LIABLE FOR ANY CLAIMS ARISING FROM UNAUTHORIZED USE OF THE DRAWINGS OR FROM ANY CHANGES TO ACCEPTED STANDARDS AND/OR THE ONTARIO BUILDING CODE.

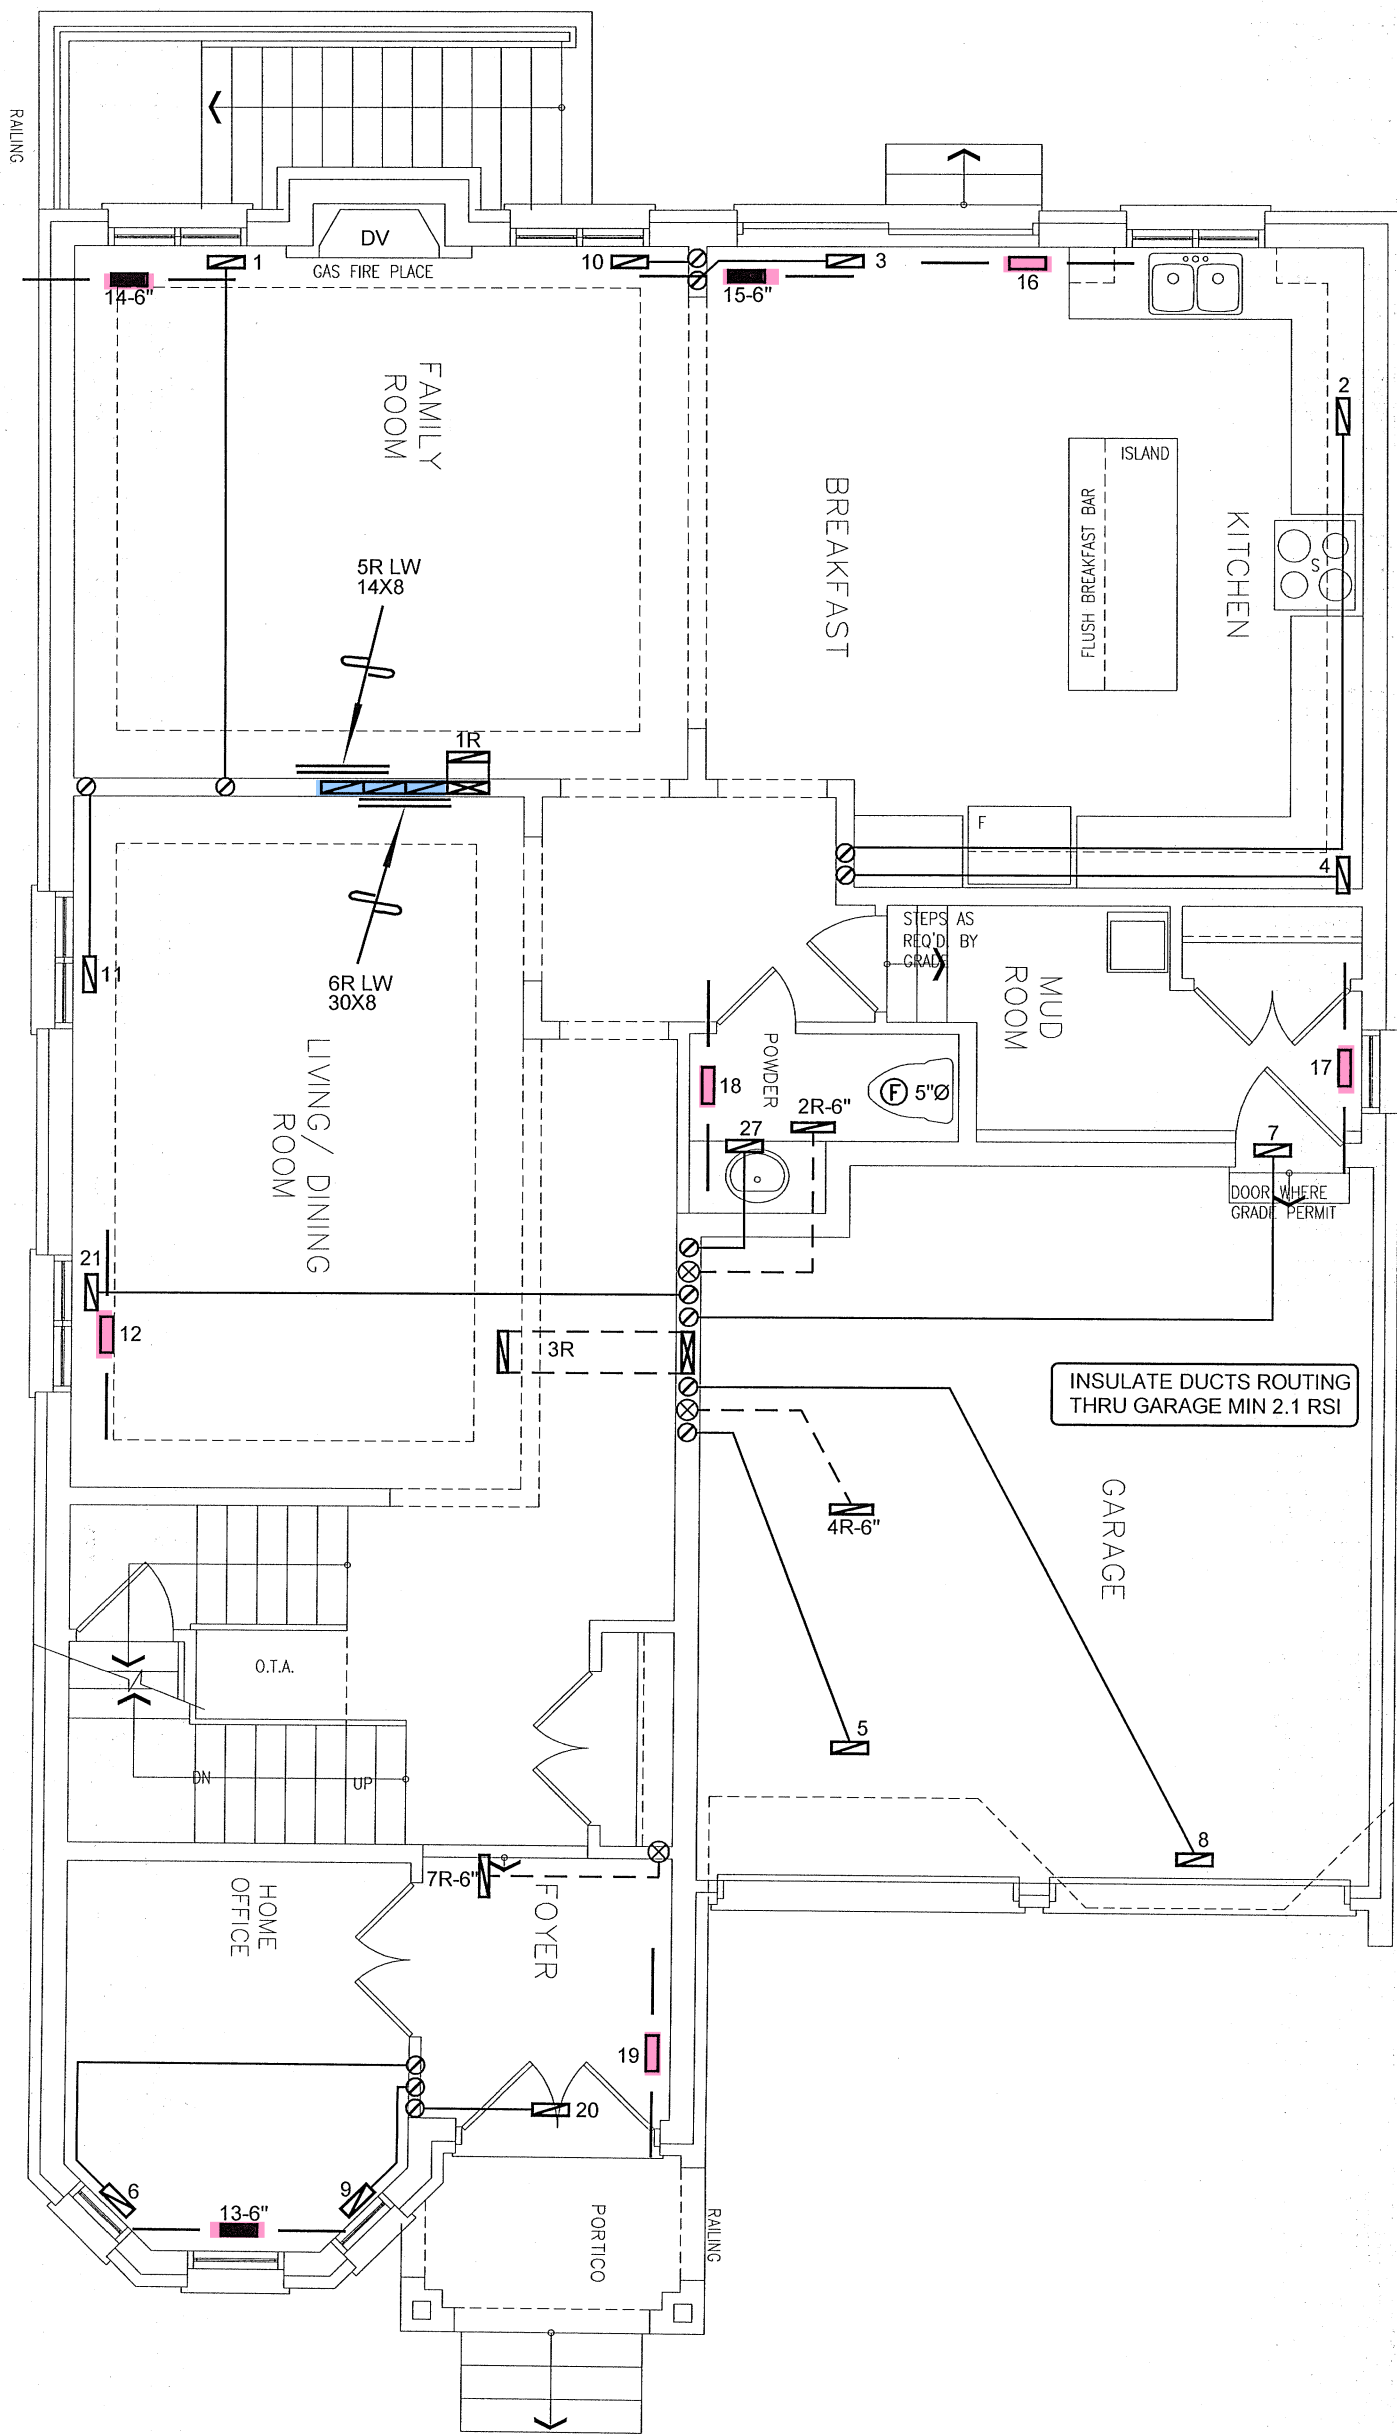Client GREENPARK HOMES		<div><p>375 Finley Ave - Suite 202 - Ajax, Ontario L1S 2E2 Tel. 905.619.2300 - 905.420.5300 Fax 905.619.2375 Email: info@hvacdesigns.ca Web: www.hvacdesigns.ca Specializing in Residential Mechanical Design Services</p></div>	HEAT LOSS 57049 BTU/H UNIT DATA		# OF RUNS S/A R/A FANS			Sheet Title		
Project Name LECCO RIDGE MILTON, ONTARIO			MAKE AMANA	3RD FLOOR					BASEMENT HEATING LAYOUT	
			MODEL AMVC960804CNA	2ND FLOOR		14	5	6		
LOT 100 JUNIPER 9		INPUT 80 MBTU/H	1ST FLOOR		8	2	2	Date	MAR/2017	
		OUTPUT 76.8 MBTU/H	BASEMENT		5	1	0	Scale	3/16" = 1'-0"	
		COOLING 3.5 TONS	ALL S/A DIFFUSERS 4"x10" UNLESS NOTED OTHERWISE ON LAYOUT. ALL S/A RUNS 5"Ø UNLESS NOTED OTHERWISE ON LAYOUT. UNDERCUT DOORS 1" min. FOR R/A							BCIN# 19669
		FAN SPEED 1316 cfm @ 0.5" w.c.								LO# 73317
3475 sqft		Installation to comply with the latest Ontario Building Code. All supply branch outlets shall be equipped with a manual balancing damper. Ductwork which passes through the garage or unheated spaces shall be adequately insulated and be gas-proofed.								



RECEIVED  
TOWN OF MILTON  
MAR 29, 2017  
17-4690  
BUILDING DIVISION

LOT 100

Energy

ENERGY STAR

CSA-F280-12

I MICHAEL O'Rourke HAVE REVIEWED AND TAKE RESPONSIBILITY FOR THE DESIGN WORK AND AM QUALIFIED UNDER DIVISION C.3.2.3 OF THE BUILDING CODE.


Michael O'Rourke  
Michael O'Rourke, BCIN# 19669  
HVAC DESIGNS LTD.

HVAC LEGEND								3.		
	FLOOR SUPPLY AIR GRILLE		6" SUPPLY AIR BOOT ABOVE		14"x8" RETURN AIR GRILLE		RETURN AIR STACK ABOVE	2.		
	FLOOR SUPPLY AIR GRILLE 6" BOOT		SUPPLY AIR STACK FROM 2nd FLOOR		30"x8" RETURN AIR GRILLE		RETURN AIR STACK 2nd FLOOR	1.		
	SUPPLY AIR BOOT ABOVE		6" SUPPLY AIR STACK 2nd FLOOR		FRA- FLOOR RETURN AIR GRILLE		REDUCER	No.	Description	Date

ALL DRAWINGS, CALCULATIONS AND SPECIFICATIONS ARE THE PROPERTY OF HVAC DESIGNS LTD.© AND MAY NOT BE REPRODUCED, MODIFIED OR ALTERED WITHOUT EXPRESSED WRITTEN CONSENT. THE DRAWINGS ARE DATED AND USE OF THESE DRAWINGS AFTER ONE YEAR FROM THE DATED NOTED IS NOT AUTHORIZED. CONTRACTOR SHALL CHECK ALL CONDITIONS BEFORE PROCEEDING WITH WORK. LATEST MUNICIPAL APPROVED DRAWINGS ONLY TO BE USED DURING INSTALLATION OF HEATING SYSTEM. HVAC DESIGNS LTD. IS NOT LIABLE FOR ANY CLAIMS ARISING FROM UNAUTHORIZED USE OF THE DRAWINGS OR FROM ANY CHANGES TO ACCEPTED STANDARDS AND/OR THE ONTARIO BUILDING CODE.


Client <b>GREENPARK HOMES</b>	<b>HVAC DESIGNS LTD.</b> 375 Finley Ave - Suite 202 - Ajax, Ontario L1S 2E2 Tel. 905.619.2300 - 905.420.5300 Fax 905.619.2375 Email: info@hvacdesigns.ca Web: www.hvacdesigns.ca Specializing in Residential Mechanical Design Services	<b>TOWN OF MILTON</b> PLANNING AND DEVELOPMENT BUILDING PERMIT: 17-4690 <b>BUILDING: REVIEWED</b> SCOTT SHERRIFFS PLANS EXAMINER APR 19, 2017 DATE Neither the issuance of a permit nor carrying out of inspections by the Town of Milton relieves the owner from full responsibility for compliance with the provisions of the Ontario Building Code Act and the Ontario Building Code, both as amended, as well as other applicable statutes and regulations of the Province of Ontario, By-laws of the Region of Halton and Town of Milton	Sheet Title <b>FIRST FLOOR HEATING LAYOUT</b> Date MAR/2017 Scale 3/16" = 1'-0" BCIN# 19669 LO# 73317
Project Name <b>LECCO RIDGE MILTON, ONTARIO</b>	Installation to comply with the latest Ontario Building Code. All supply branch outlets shall be equipped with a manual balancing damper. Ductwork which passes through the garage or unheated spaces shall be adequately insulated and be gas-proofed.		
LOT 100 JUNIPER 9	3475 sqft		



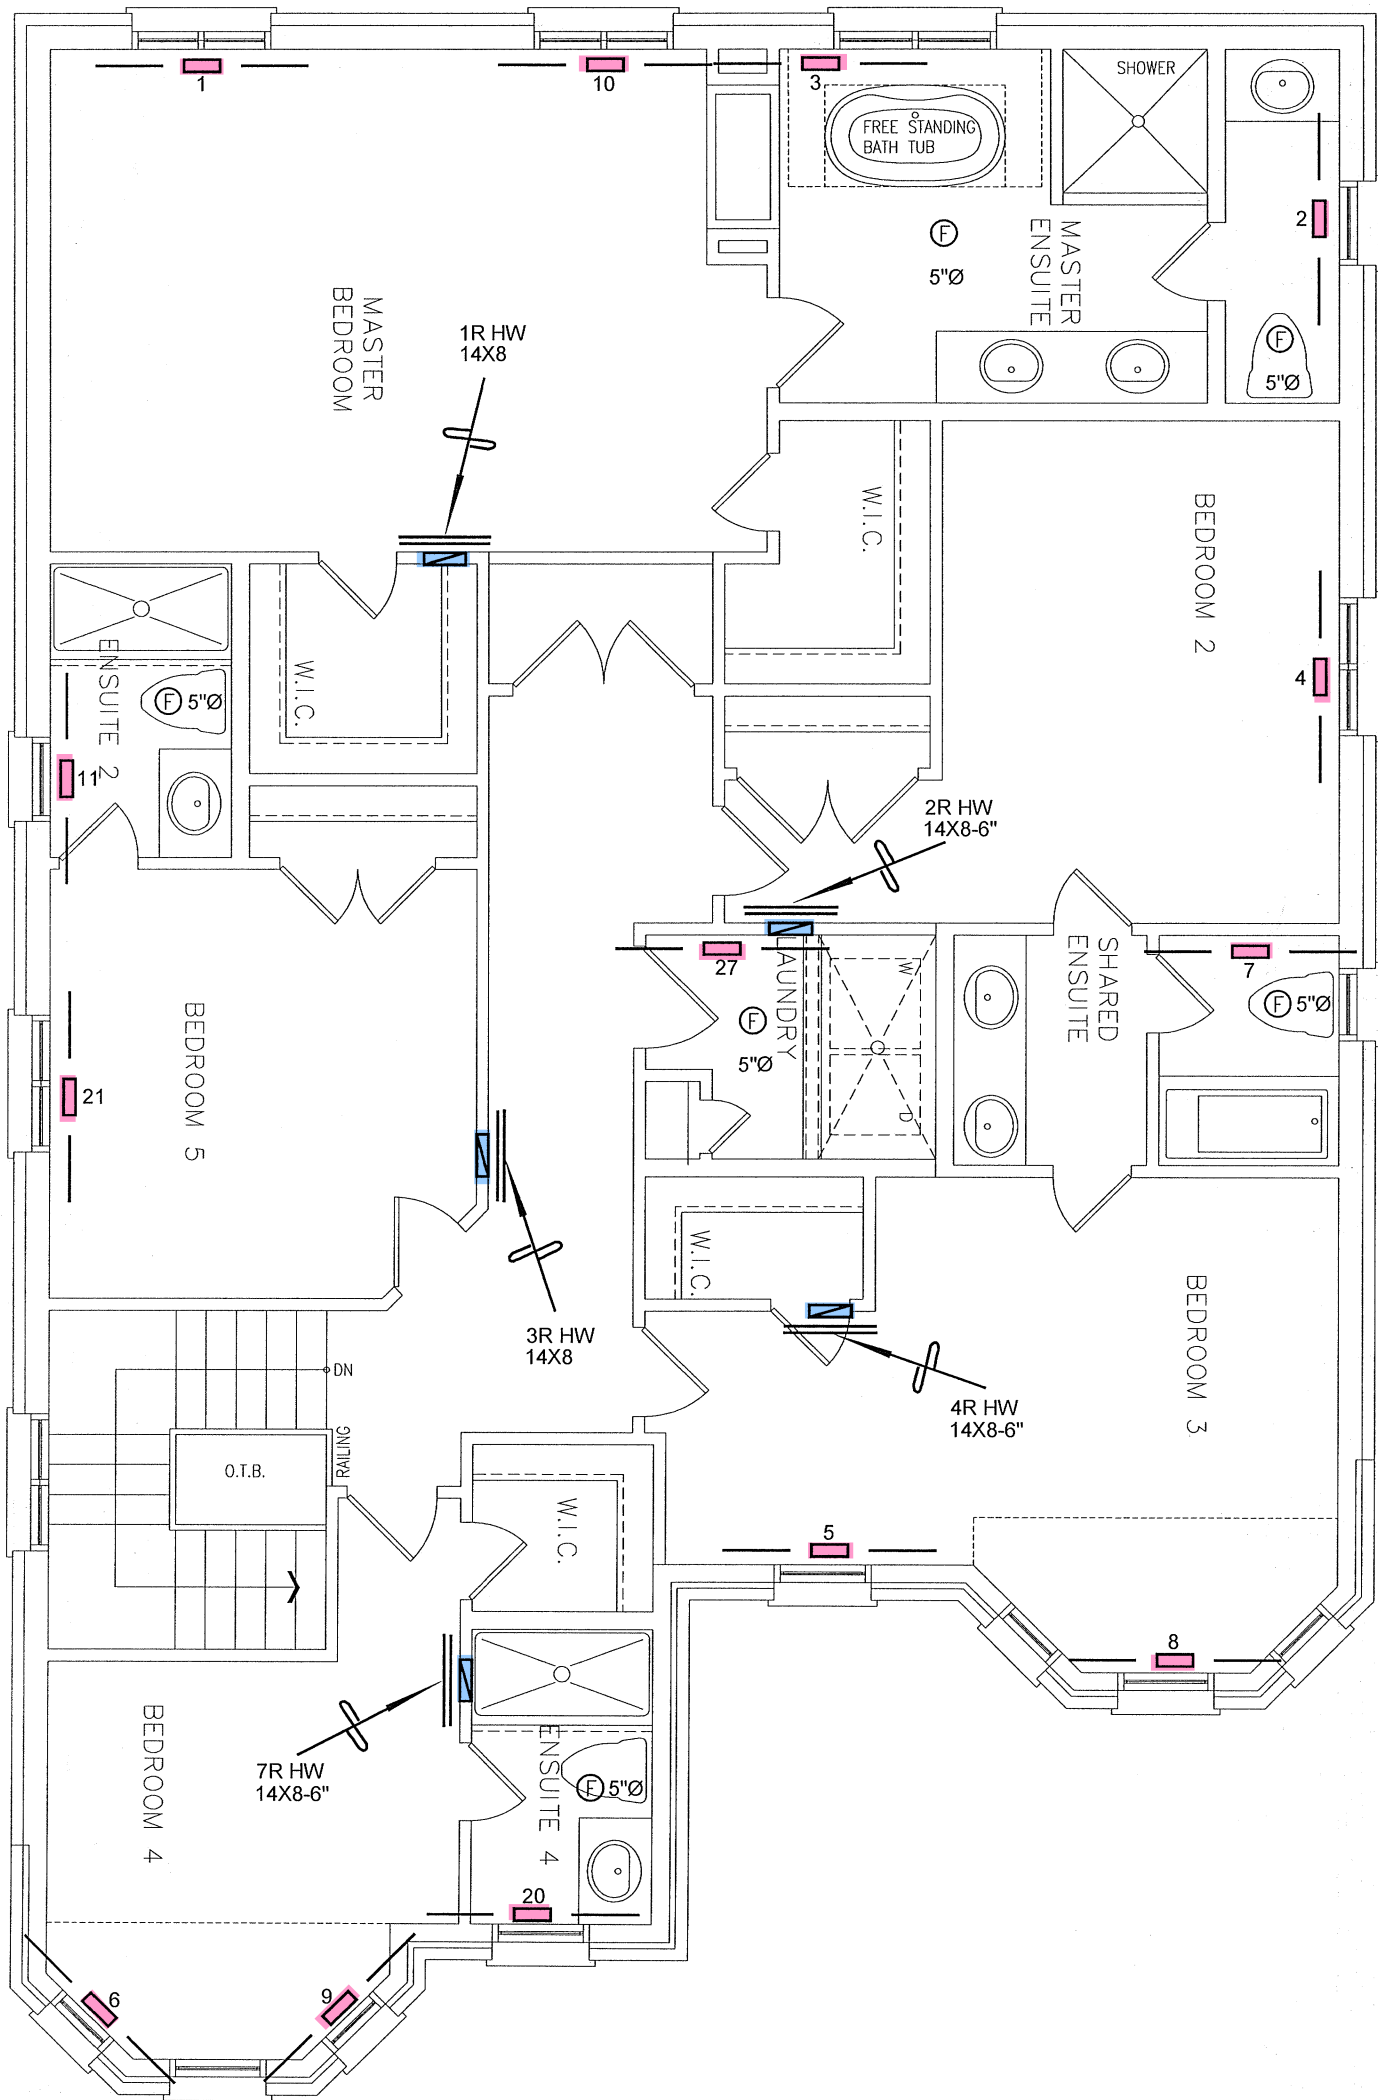


RECEIVED  
TOWN OF MILTON  
MAR 29, 2017  
17-4690  
BUILDING DIVISION

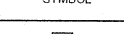
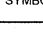
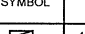
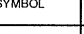

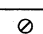
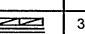
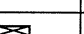
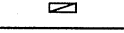



LOT 100



ENERGY STAR

CSA-F280-12

I MICHAEL O'ROURKE HAVE REVIEWED AND TAKE RESPONSIBILITY FOR THE DESIGN WORK AND AM QUALIFIED UNDER DIVISION C.32.5 OF THE BUILDING CODE.  
  
Michael O'Rourke, BCIN# 19669  
HVAC DESIGNS LTD.

HVAC LEGEND								3.		
SYMBOL	DESCRIPTION	SYMBOL	DESCRIPTION	SYMBOL	DESCRIPTION	SYMBOL	DESCRIPTION	2.		
	FLOOR SUPPLY AIR GRILLE		6" SUPPLY AIR BOOT ABOVE		14"x8" RETURN AIR GRILLE		RETURN AIR STACK ABOVE	1.		
	FLOOR SUPPLY AIR GRILLE 6" BOOT		SUPPLY AIR STACK FROM 2nd FLOOR		30"x8" RETURN AIR GRILLE		RETURN AIR STACK 2nd FLOOR	No.	Description	Date
	SUPPLY AIR BOOT ABOVE		6" SUPPLY AIR STACK 2nd FLOOR		FRA- FLOOR RETURN AIR GRILLE		REDUCER	REVISIONS		

ALL DRAWINGS, CALCULATIONS AND SPECIFICATIONS ARE THE PROPERTY OF HVAC DESIGNS LTD.© AND MAY NOT BE REPRODUCED, MODIFIED OR ALTERED WITHOUT EXPRESSED WRITTEN CONSENT. THE DRAWINGS ARE DATED AND USE OF THESE DRAWINGS AFTER ONE YEAR FROM THE DATED NOTED IS NOT AUTHORIZED. CONTRACTOR SHALL CHECK ALL CONDITIONS BEFORE PROCEEDING WITH WORK. LATEST MUNICIPAL APPROVED DRAWINGS ONLY TO BE USED DURING INSTALLATION OF HEATING SYSTEM. HVAC DESIGNS LTD. IS NOT LIABLE FOR ANY CLAIMS ARISING FROM UNAUTHORIZED USE OF THE DRAWINGS OR FROM ANY CHANGES TO ACCEPTED STANDARDS AND/OR THE ONTARIO BUILDING CODE.

Client <b>GREENPARK HOMES</b>		 375 Finley Ave - Suite 202 - Ajax, Ontario L1S 2E2 Tel. 905.619.2300 - 905.420.5300 Fax 905.619.2375 Email: info@hvacdsgns.ca Web: www.hvacdsgns.ca Specializing in Residential Mechanical Design Services	 <b>TOWN OF MILTON</b> PLANNING AND DEVELOPMENT BUILDING PERMIT: 17-4690 BUILDING: REVIEWED SCOTT SHERRIFFS APR 19, 2017 PLANS EXAMINER DATE Neither the issuance of a permit nor carrying out of inspections by the Town of Milton relieves the owner from full responsibility for compliance with the provisions of the Ontario Building Code Act and the Ontario Building Code, both as amended, as well as other applicable statutes and regulations of the Province of Ontario, By-laws of the Region of Halton and Town of Milton	Sheet Title <b>SECOND FLOOR HEATING LAYOUT</b>		
Project Name <b>LECCO RIDGE MILTON, ONTARIO</b>				Date MAR/2017	Scale 3/16" = 1'-0"	
LOT 100 JUNIPER 9		Installation to comply with the latest Ontario Building Code. All supply branch outlets shall be equipped with a manual balancing damper. Ductwork which passes through the garage or unheated spaces shall be adequately insulated and be gas-proofed.		BCIN# 19669		
3475 sqft				LO#	73317	