

SITE NAME: LECCO RIDGE

WUP

DATE: Feb-17

WINTER NATURAL AIR CHANGE RATE 0.307

HEAT LOSS AT °F. 72

CSA-F280-12

BUILDER: GREENPARK HOMES

TYPE: JUNIPER 11

GFA: 2961

LO# 72388

SUMMER NATURAL AIR CHANGE RATE 0.105

HEAT GAIN AT °F. 14

ENERGYSTAR

ROOM USE	EXP. WALL	CLG. HT.	MBR	ENS	WIC	BED-2	BED-3	BED-4	BATH	ENS-4			
			37	24	7	12	25	36	7	8			
			10	9	9	9	9	10	9	9			
FACTORS													
GRS.WALL AREA	LOSS	GAIN	370	216	63	108	225	360	63	72			
GLAZING	LOSS	GAIN											
NORTH	17.9	15.8	0	0	0	9	161	143	0	0	0	0	0
EAST	17.9	41.4	0	0	0	0	0	0	0	0	0	16	286
SOUTH	17.9	24.8	36	643	892	0	0	0	0	0	0	0	0
WEST	17.9	41.4	22	393	911	21	375	870	11	196	456	0	0
SKYLT.	30.6	101.2	0	0	0	0	0	0	0	0	0	0	0
DOORS	24.1	4.7	0	0	0	0	0	0	0	0	0	0	0
NET EXPOSED WALL	2.6	0.5	312	816	158	186	487	94	52	136	26	91	238
NET EXPOSED BSMT WALL ABOVE GR	3.3	0.6	0	0	0	0	0	0	0	0	0	0	0
EXPOSED CLG	1.4	0.7	304	419	208	113	156	77	112	154	77	203	280
NO ATTIC EXPOSED CLG	2.2	1.1	0	0	0	30	67	33	0	0	0	0	0
EXPOSED FLOOR	2.2	0.4	0	0	0	0	0	0	0	0	0	193	423
BASEMENT/CRAWL HEAT LOSS			0	0	0	0	0	0	0	0	0	0	0
SLAB ON GRADE HEAT LOSS			0	0	0	0	0	0	0	0	0	0	0
SUBTOTAL HT LOSS			2271		1245	487		821		1616		2392	
SUB TOTAL HT GAIN				2169		1217		559		454		1163	
LEVEL FACTOR / MULTIPLIER	0.20	0.27							0.20	0.27			
AIR CHANGE HEAT LOSS	619								224				
AIR CHANGE HEAT GAIN			147			83		38		31		79	
DUCT LOSS	0		0			0		0		206		0	
DUCT GAIN			0			0		0		226		0	
HEAT GAIN PEOPLE	240	2	480	1	240	0	0	1	240	1	240	1	240
HEAT GAIN APPLIANCES/LIGHTS			775		0	0	0	775		775		775	
TOTAL HT LOSS BTU/H			2890		1585	619		1045		2263		3044	
TOTAL HT GAIN x 1.3 BTU/H			4643		2002	776		1951		3228		5074	

TOWN OF MILTON
PLANNING AND DEVELOPMENT
JUNIPER 11F MODEL

BUILDING: REVIEWED
SCOTT SHERRIFFS APR 11, 2017
PLANS EXAMINER DATE

Neither the issuance of a permit nor carrying out of inspections by the Town of Milton relieves the owner from full responsibility for compliance with the provisions of the Ontario Building Code Act and the Ontario Building Code, both as amended, as well as other applicable statutes and regulations of the Province of Ontario, By-laws of the Region of Halton and Town of Milton

RECEIVED
TOWN OF MILTON
MAR 29, 2017
JUNIPER 11F
BUILDING DIVISION

ROOM USE	EXP. WALL	CLG. HT.	LV/DN	KT/FM	LAUN	W/R	FOY					WUP	BAS
			50	76	21	26	30					19	177
			10	10	9	11	10					10	10
FACTORS													
GRS.WALL AREA	LOSS	GAIN	500	760	189	286	300					181	1151
GLAZING	LOSS	GAIN											
NORTH	17.9	15.8	0	0	0	0	0	0	0	0	0	0	0
EAST	17.9	41.4	50	893	2071	0	0	0	0	0	0	0	0
SOUTH	17.9	24.8	50	893	1238	42	750	1040	0	0	0	56	1000
WEST	17.9	41.4	0	0	0	95	1696	3935	0	0	0	0	0
SKYLT.	30.6	101.2	0	0	0	0	0	0	0	0	0	0	0
DOORS	24.1	4.7	0	0	0	0	0	0	20	481	93	20	481
NET EXPOSED WALL	2.6	0.5	400	1047	202	615	1609	311	147	385	74	255	667
NET EXPOSED BSMT WALL ABOVE GR	3.3	0.6	0	0	0	0	0	0	0	0	0	0	0
EXPOSED CLG	1.4	0.7	12	17	8	6	8	4	240	331	164	0	0
NO ATTIC EXPOSED CLG	2.2	1.1	0	0	0	0	0	0	0	0	0	0	0
EXPOSED FLOOR	2.2	0.4	0	0	0	0	0	0	0	0	0	0	0
BASEMENT/CRAWL HEAT LOSS			0	0	0	0	0	0	0	0	0	0	0
SLAB ON GRADE HEAT LOSS			0	0	0	0	0	0	0	0	0	0	0
SUBTOTAL HT LOSS			2848		4206		1465		1345		2067		1593
SUB TOTAL HT GAIN				3520		5489		1279		396		901	
LEVEL FACTOR / MULTIPLIER	0.30	0.46							0.30	0.46			
AIR CHANGE HEAT LOSS	1311								399		619		951
AIR CHANGE HEAT GAIN			239			372		87		27		108	
DUCT LOSS	0		0			0		0		0		0	
DUCT GAIN			0			0		0		0		0	
HEAT GAIN PEOPLE	240	0	0	1	240	0	0	0	0	0	0	0	0
HEAT GAIN APPLIANCES/LIGHTS			775		775		775		775		775		775
TOTAL HT LOSS BTU/H			4159		6142		1864		1964		3018		901
TOTAL HT GAIN x 1.3 BTU/H			5895		8939		3096		550		2212		818

TOTAL HEAT GAIN BTU/H: 41519

TONS: 3.46

LOSS DUE TO VENTILATION LOAD BTU/H: 2354

STRUCTURAL HEAT LOSS: 47836

TOTAL COMBINED HEAT LOSS BTU/H: 50190

SITE NAME: LECCO RIDGE
BUILDER: GREENPARK HOMES

WUP
TYPE: JUNIPER 11

DATE: Feb-17

GFA: 2961 LO# 72388

HEATING CFM 1316 COOLING CFM 1316
TOTAL HEAT LOSS 47,836 TOTAL HEAT GAIN 41,064
AIR FLOW RATE CFM 27.51 AIR FLOW RATE CFM 32.05

furnace pressure 0.6
furnace filter 0.05
a/c coil pressure 0.2
available pressure for s/a & r/a 0.35

~*AMANA
FAN SPEED 80
LOW 1316
MEDLOW 0
MEDIUM 1389
MEDIUM HIGH 0
HIGH 1396

AFUE = 96.0 %
INPUT (BTU/H) = 80,000
OUTPUT (BTU/H) = 76,800

DESIGN CFM = 1316
CFM @ 6" E.S.P.

TEMPERATURE RISE 54 °F

RUN COUNT	4th	3rd	2nd	1st	Bas
S/A	0	0	11	7	5
R/A	0	0	5	2	1

All S/A diffusers 4"x10" unless noted otherwise on layout.

All S/A runs 5"Ø unless noted otherwise on layout.

RUN #	1	2	3	4	5	6	7	8	10	11	12	13	14	15	16	17	18	19	21	22	23	24
ROOM NAME	MBR	ENS	WIC	BED-2	BED-3	BED-4	BATH	BED-4	MBR	ENS-4	LV/DN	LV/DN	KT/FM	KT/FM	KT/FM	LAUN	W/R	FOY	BAS	BAS	BAS	BAS
RM LOSS MBH.	1.44	1.58	0.62	1.05	2.26	1.52	1.09	1.52	1.44	0.99	2.08	2.08	2.05	2.05	2.05	1.86	1.96	3.02	3.43	3.43	3.43	3.43
CFM PER RUN HEAT	40	44	17	29	62	42	30	42	40	27	57	57	56	56	56	51	54	83	94	94	94	94
RM GAIN MBH.	2.32	2.00	0.78	1.95	3.23	2.54	0.46	2.54	2.32	1.19	2.95	2.95	2.98	2.98	2.98	3.10	0.55	2.21	0.21	0.21	0.21	0.21
CFM PER RUN COOLING	74	64	25	63	103	81	15	81	74	38	94	94	96	96	96	99	18	71	7	7	7	7
ADJUSTED PRESSURE	0.17	0.17	0.17	0.17	0.16	0.16	0.17	0.16	0.17	0.17	0.16	0.16	0.16	0.16	0.16	0.16	0.17	0.16	0.16	0.16	0.16	0.16
ACTUAL DUCT LGH.	38	40	34	33	42	58	34	47	43	35	37	33	26	20	32	36	27	19	23	44	12	27
EQUIVALENT LENGTH	150	120	160	100	130	140	130	130	130	120	130	130	120	130	100	120	100	120	110	160	130	140
TOTAL EFFECTIVE LENGTH	188	160	194	133	172	188	174	177	173	155	167	163	146	150	132	156	127	139	133	204	142	167
ADJUSTED PRESSURE	0.09	0.11	0.09	0.13	0.09	0.09	0.1	0.09	0.1	0.11	0.1	0.1	0.11	0.11	0.12	0.1	0.14	0.12	0.12	0.08	0.11	0.1
ROUND DUCT SIZE	5	5	4	4	6	5	4	5	5	4	5	5	5	5	5	6	4	5	5	6	5	5
HEATING VELOCITY (ft/min)	294	323	195	333	316	308	344	308	294	310	419	419	411	411	411	260	620	609	690	479	690	690
COOLING VELOCITY (ft/min)	543	470	287	723	525	595	172	595	543	436	690	690	705	705	705	505	207	521	51	36	51	51
OUTLET GRILL SIZE	3X10	3X10	3X10	3X10	4X10	3X10	3X10	3X10	3X10	3X10	3X10	3X10	3X10	3X10	3X10	4X10	3X10	3X10	3X10	4X10	3X10	3X10
TRUNK	B	A	B	A	E	E	E	D	B	E	D	D	A	A	B	B	A	E	A	B	E	D

RUN #	25
ROOM NAME	BAS
RM LOSS MBH.	3.43
CFM PER RUN HEAT	94
RM GAIN MBH.	0.21
CFM PER RUN COOLING	7
ADJUSTED PRESSURE	0.16
ACTUAL DUCT LGH.	36
EQUIVALENT LENGTH	120
TOTAL EFFECTIVE LENGTH	156
ADJUSTED PRESSURE	0.1
ROUND DUCT SIZE	5
HEATING VELOCITY (ft/min)	690
COOLING VELOCITY (ft/min)	51
OUTLET GRILL SIZE	3X10
TRUNK	D

RECEIVED
TOWN OF MILTON
MAR 29, 2017
JUNIPER 11F
BUILDING DIVISION

SUPPLY AIR TRUNK SIZE										RETURN AIR TRUNK SIZE									
TRUNK	STATIC	ROUND	RECT	VELOCITY						TRUNK	STATIC	ROUND	RECT	VELOCITY					
CFM	PRESS.	DUCT	DUCT						(ft/min)	CFM	PRESS.	DUCT	DUCT						(ft/min)
TRUNK A	333	0.11	8.6	10	x	8	599			TRUNK G	0	0.00	0	0	x	8	0		
TRUNK B	298	0.08	8.9	10	x	8	536			TRUNK H	0	0.00	0	0	x	8	0		
TRUNK C	631	0.08	11.8	18	x	8	631			TRUNK I	0	0.00	0	0	x	8	0		
TRUNK D	344	0.09	9.1	10	x	8	619			TRUNK J	0	0.00	0	0	x	8	0		
TRUNK E	682	0.09	11.8	18	x	8	682			TRUNK K	0	0.00	0	0	x	8	0		
TRUNK F	0	0.00	0	0	x	8	0			TRUNK L	0	0.00	0	0	x	8	0		

RETURN AIR #	1	2	3	4	5	6	7	8	9	10	11	12	13	14	15	16	17	18	19	20	21	22	23	24
AIR VOLUME	155	85	75	135	390	135	135	0	0	0	0	0	0	0	0	0	0	0	0	0	0	0	0	0
PLENUM PRESSURE	0.15	0.15	0.15	0.15	0.15	0.15	0.15	0.15	0.15	0.15	0.15	0.15	0.15	0.15	0.15	0.15	0.15	0.15	0.15	0.15	0.15	0.15	0.15	0.15
ACTUAL DUCT LGH.	52	63	60	67	33	46	62	1	1	1	1	1	1	1	1	1	1	1	1	1	1	1	1	1
EQUIVALENT LENGTH	200	205	215	230	185	225	235	0	0	0	0	0	0	0	0	0	0	0	0	0	0	0	0	0
TOTAL EFFECTIVE LENGTH	252	268	275	297	218	271	297	1	1	1	1	1	1	1	1	1	1	1	1	1	1	1	1	1
ADJUSTED PRESSURE	0.06	0.06	0.05	0.05	0.07	0.05	0.05	14.80	14.80	14.80	14.80	14.80	14.80	14.80	14.80	14.80	14.80	14.80	14.80	14.80	14.80	14.80	14.80	14.80
ROUND DUCT SIZE	7.5	6	6	7.5	10.2	7.5	7.5	0	0	0	0	0	0	0	0	0	0	0	0	0	0	0	0	0
INLET GRILL SIZE	8	8	8	8	8	8	8	0	0	0	0	0	0	0	0	0	0	0	0	0	0	0	0	0
INLET GRILL SIZE	X	X	X	X	X	X	X	X	X	X	X	X	X	X	X	X	X	X	X	X	X	X	X	X

TYPE: JUNIPER 11
SITE NAME: LECCO RIDGE

LO # 72388
WUP

RESIDENTIAL MECHANICAL VENTILATION DESIGN SUMMARY

COMBUSTION APPLIANCES		9.32.3.1(1)
a)	<input checked="" type="checkbox"/> Direct vent (sealed combustion) only	
b)	<input type="checkbox"/> Positive venting induced draft (except fireplaces)	
c)	<input type="checkbox"/> Natural draft, B-vent or induced draft gas fireplace	
d)	<input type="checkbox"/> Solid Fuel (including fireplaces)	
e)	<input type="checkbox"/> No Combustion Appliances	

HEATING SYSTEM	
<input checked="" type="checkbox"/> Forced Air	<input type="checkbox"/> Non Forced Air
<input type="checkbox"/> Electric Space Heat	

HOUSE TYPE		9.32.1(2)
<input checked="" type="checkbox"/> I	Type a) or b) appliance only, no solid fuel	
<input type="checkbox"/> II	Type I except with solid fuel (including fireplaces)	
<input type="checkbox"/> III	Any Type c) appliance	
<input type="checkbox"/> IV	Type I, or II with electric space heat	
<input type="checkbox"/> Other:	Type I, II or IV no forced air	

SYSTEM DESIGN OPTIONS		O.N.H.W.P.
<input type="checkbox"/> 1	Exhaust only/Forced Air System	
<input type="checkbox"/> 2	HRV with Ducting/Forced Air System	
<input checked="" type="checkbox"/> 3	HRV Simplified/connected to forced air system	
<input type="checkbox"/> 4	HRV with Ducting/non forced air system	
<input type="checkbox"/>	Part 6 Design	

TOTAL VENTILATION CAPACITY		9.32.3.3(1)
Basement + Master Bedroom	2 @ 21.2 cfm	42.4 cfm
Other Bedrooms	3 @ 10.6 cfm	31.8 cfm
Kitchen & Bathrooms	5 @ 10.6 cfm	53 cfm
Other Rooms	4 @ 10.6 cfm	42.4 cfm
Table 9.32.3.A.	TOTAL	169.6 cfm

PRINCIPAL VENTILATION CAPACITY REQUIRED		9.32.3.4.(1)
1 Bedroom	31.8 cfm	
2 Bedroom	47.7 cfm	
3 Bedroom	63.6 cfm	
4 Bedroom	79.5 cfm	
5 Bedroom	95.4 cfm	
More than 5 - Part 6	TOTAL	79.5 cfm

SUPPLEMENTAL VENTILATION CAPACITY		9.32.3.5.
Total Ventilation Capacity	169.6	cfm
Less Principal Ventil. Capacity	86	cfm
Required Supplemental Capacity	83.6	cfm

PRINCIPAL EXHAUST FAN CAPACITY	
Model:	VANEE 40H+
Location:	BSMT
86.0 cfm	3.0 sones
<input checked="" type="checkbox"/>	HVI Approved

PRINCIPAL EXHAUST HEAT LOSS CALCULATION	
CFM	ΔT °F
86.0 CFM	72 F
X	X
FACTOR	% LOSS
1.08	0.35
X	

SUPPLEMENTAL FANS		NUTONE	
Location	Model	cfm	HVI
ENS	QTXEN050C	50	<input checked="" type="checkbox"/>
BATH	QTXEN050C	50	<input checked="" type="checkbox"/>
ENS-4	QTXEN050C	50	<input checked="" type="checkbox"/>
W/R	QTXEN050C	50	<input checked="" type="checkbox"/>

HEAT RECOVERY VENTILATOR		9.32.3.11.
Model:	VANEE 40H+	
86 cfm high	37 cfm low	
65 % Sensible Efficiency	<input checked="" type="checkbox"/> HVI Approved	
@ 32 deg F (0 deg C)		

LOCATION OF INSTALLATION	
Lot:	
Township:	
Address:	
Roll #	

RECEIVED
TOWN OF MILTON
MAR 29, 2017
JUNIPER 11F
BUILDING DIVISION

BUILDER:		TOWN OF MILTON	
Name:		PLANNING AND DEVELOPMENT	JUNIPER 11F MODEL
Address:		BUILDING: REVIEWED	DATE
City:		SCOTT SHERRIFFS	APR 11, 2017
Telephone #:		PLANS EXAMINER	



Neither the issuance of a permit nor carrying out of inspections by the Town of Milton relieves the owner from full responsibility for compliance with the provisions of the Ontario Building Code Act and the Ontario Building Code, both as amended, as well as other applicable statutes and regulations of the Province of Ontario, By-laws of the Region of Halton and Town of Milton

INSTALLING CONTRACTOR	
Name:	
Address:	
City:	
Telephone #:	Fax #:

DESIGNER CERTIFICATION	
I hereby certify that this ventilation system has been designed in accordance with the Ontario Building Code.	
Name:	HVAC Designs Ltd.
Signature:	<i>Michael O'Rourke</i>
HRAI#	001820
Date:	February-17

HEAT LOSS AND GAIN SUMMARY SHEET

MODEL: JUNIPER 11	WUP	BUILDER: GREENPARK HOMES
SFQT: 2961	LO# 72388	SITE: LECCO RIDGE

DESIGN ASSUMPTIONS

HEATING	°F	COOLING	°F
OUTDOOR DESIGN TEMP.	0	OUTDOOR DESIGN TEMP.	86
INDOOR DESIGN TEMP:	72	INDOOR DESIGN TEMP. (MAX 75°F)	72

BUILDING DATA

ATTACHMENT:	DETACHED	# OF STORIES (+BASEMENT):	3
FRONT FACES:	EAST	ASSUMED (Y/N):	Y
AIR CHANGES PER HOUR:	3.57	ASSUMED (Y/N):	Y
AIR TIGHTNESS CATEGORY:	AVERAGE	ASSUMED (Y/N):	Y
WIND EXPOSURE:	SHELTERED	ASSUMED (Y/N):	Y
HOUSE VOLUME (ft³):	40435.5	ASSUMED (Y/N):	Y
INTERNAL SHADING:	BLINDS/CURTAINS	ASSUMED OCCUPANTS:	5
INTERIOR LIGHTING LOAD (Btu/h/ft²):	1.27	DC BRUSHLESS MOTOR (Y/N):	Y
FOUNDATION CONFIGURATION	BCIN_1	DEPTH BELOW GRADE:	6.5 ft
LENGTH: 38.5 ft	WIDTH: 50.0 ft	EXPOSED PERIMETER:	177.0 ft

2012 OBC - COMPLIANCE PACKAGE

Component	Compliance Package ENERGYSTAR
Ceiling with Attic Space Minimum RSI (R)-Value	50
Ceiling Without Attic Space Minimum RSI (R)-Value	31
Exposed Floor Minimum RSI (R)-Value	31
Walls Above Grade Minimum RSI (R)-Value	20 + 5
Basement Walls Minimum RSI (R)-Value	20
Below Grade Slab Entire surface > 600 mm below grade Minimum RSI (R)-Value	-
Edge of Below Grade Slab ≤ 600 mm Below Grade Minimum RSI (R)-Value	10
Heated Slab or Slab ≤ 600 mm below grade Minimum RSI (R)-Value	10
Windows and Sliding Glass Doors Maximum U-Value	ZONE 2
Skylights Maximum U-Value	ZONE 2
Space Heating Equipment Minimum AFUE	0.95
HRV Minimum Efficiency	65%
Domestic Hot Water Heater Minimum EF	90% TE


RECEIVED
TOWN OF MILTON
MAR 29, 2017
JUNIPER 11F
BUILDING DIVISION

INDIVIDUAL BCIN: 19669

MICHAEL O'ROURKE

Residential Foundation Thermal Load Calculator

Supplemental tool for CAN/CSA-F280

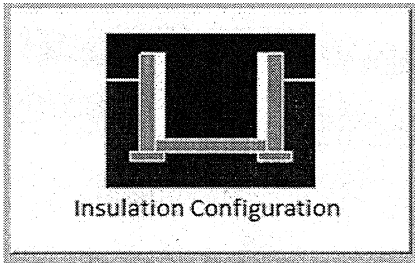Weather Station Description		
Province:	Ontario	
Region:	Milton	
Site Description		
Soil Conductivity:	Normal conductivity: dry sand, loam, clay	
Water Table:	Normal (7-10 m, 23-33 ft)	
Foundation Dimensions		
Floor Length (m):	11.7	 Insulation Configuration
Floor Width (m):	15.2	
Exposed Perimeter (m):	0.0	
Wall Height (m):	2.9	
Depth Below Grade (m):	2.0	
Window Area (m ²):	0.8	
Door Area (m ²):	3.7	
Radiant Slab		
Heated Fraction of the Slab:	0	
Fluid Temperature (°C):	33	
Design Months		
Heating Month	1	
Foundation Loads		
Heating Load (Watts):		1705

TYPE: JUNIPER 11

WUP

LO# 72388


RECEIVED
TOWN OF MILTON
MAR 29, 2017
JUNIPER 11F
BUILDING DIVISION

Supplemental tool for CAN/CSA-F280

TYPE: JUNIPER 11
LO# 72388

WUP

RECEIVED
TOWN OF MILTON
MAR 29, 2017
JUNIPER 11F
BUILDING DIVISION

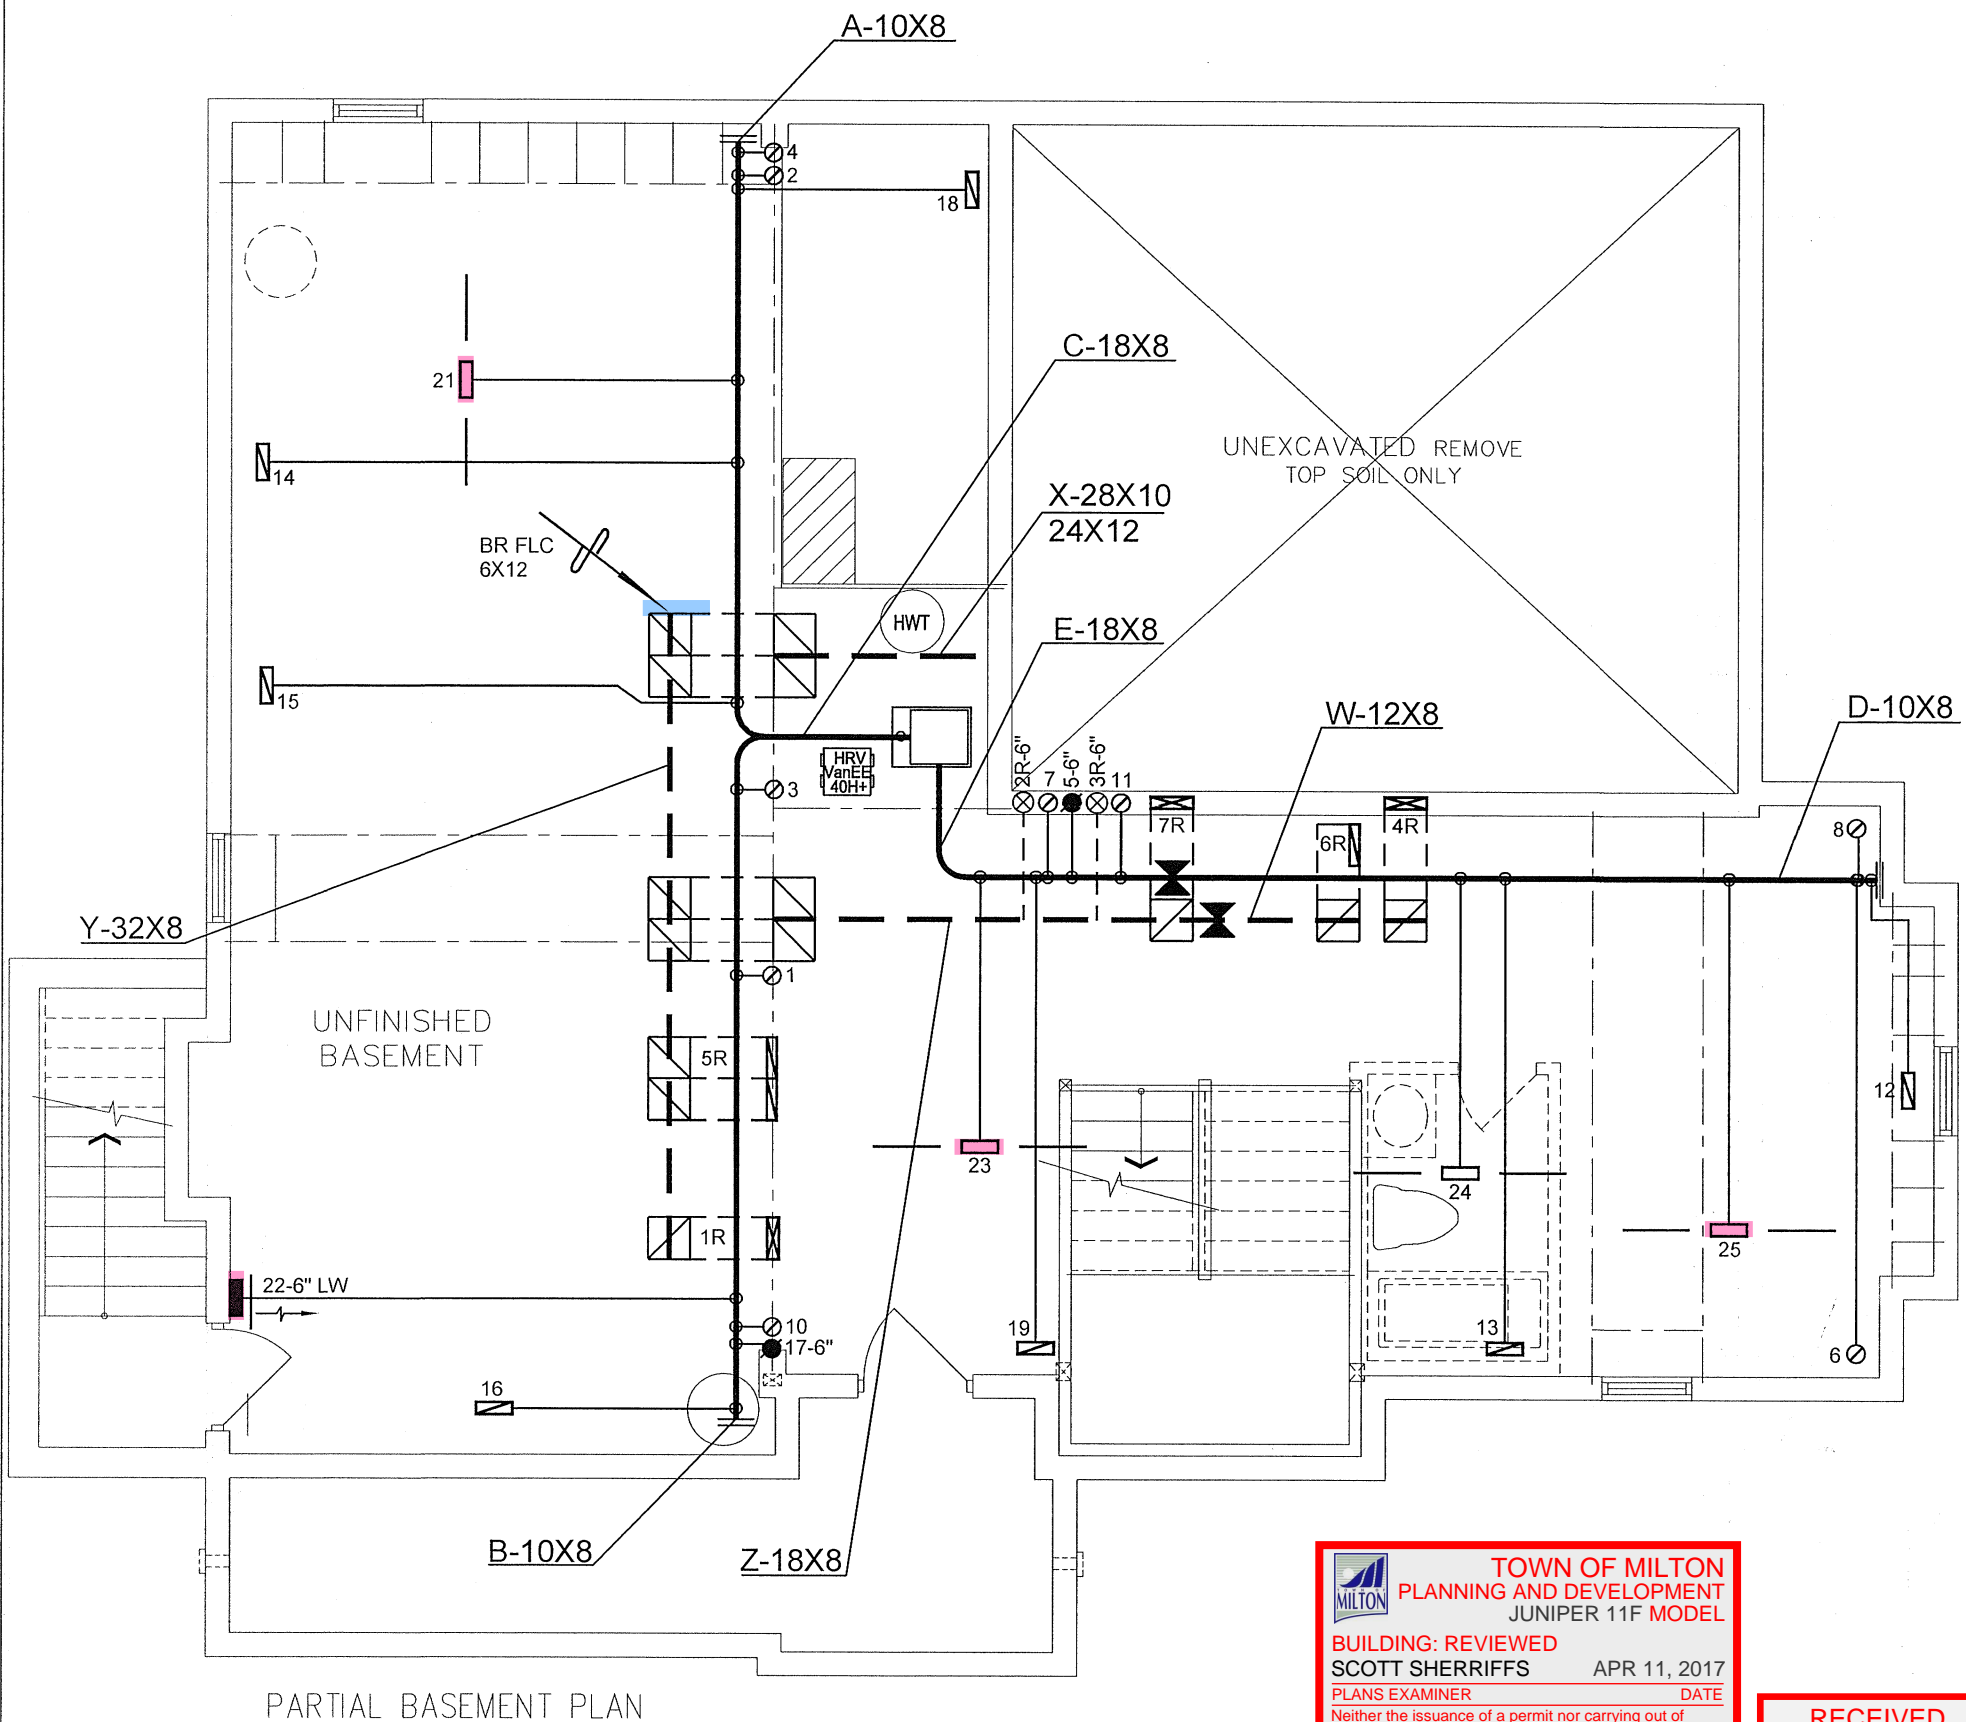

TOWN OF MILTON
PLANNING AND DEVELOPMENT
JUNIPER 11F MODEL

BUILDING: REVIEWED
SCOTT SHERRIFFS

APR 11, 2017

PLANS EXAMINER

DATE

Neither the issuance of a permit nor carrying out of inspections by the Town of Milton relieves the owner from full responsibility for compliance with the provisions of the Ontario Building Code Act and the Ontario Building Code, both as amended, as well as other applicable statutes and regulations of the Province of Ontario, By-laws of the Region of Halton and Town of Milton

RECEIVED

TOWN OF MILTON

MAR 29, 2017

JUNIPER 11F

BUILDING DIVISION

ENERGY STAR

CSA-F280-12

- RESIDENTIAL HVAC (New Construction)**
1) All HVAC work shall comply with Part 6 and 9.32/9.33.
2) Supply or return air ducts not protected by an insulated exterior wall shall be insulated to a minimum 2.1 RSI (R-12)
3) Exhaust ducts (principle, supplemental & other exhaust fans) passing through unheated space shall be insulated to a minimum 0.5 RSI (R-3)
- 4) All supply/return air ducts located in unconditioned spaces shall be sealed to a SMACNA Class 'A' seal level and supply air ducts in conditioned spaces to shall be sealed to a SMACNA Class "C" seal level
5) Furnaces to be equipped with brushless DC motor (ECM) and controlled with a programmable thermostat (4 times periods/day, 2 day types/week)
- 6) HRVs to be installed in accordance with 9.32.3.11. and manufacturers' requirements (intake/exhaust separation, distance from R/A drop)
7) Bathrooms and washrooms to have a min. 50 CFM exhaust fan ducted directly outdoors with ductwork sized in accordance with Table 9.32.3.5.
8) Range hoods to exhaust directly to outdoors with non-combustible ducting
9) Changes to the HVAC equipment or duct layout requires a revision permit to be applied for and approved prior to booking any HVAC inspections

I MICHAEL O'Rourke HAVE REVIEW AND TAKE RESPONSIBILITY FOR THE DESIGN WORK AND AM QUALIFIED UNDER DIVISION C, 3.2.5 OF THE BUILDING CODE.

Michael O'Rourke
Michael O'Rourke, BCIN# 19669
HVAC DESIGNS LTD.

HVAC LEGEND							
SYMBOL	DESCRIPTION	SYMBOL	DESCRIPTION	SYMBOL	DESCRIPTION	SYMBOL	DESCRIPTION
	FLOOR SUPPLY AIR GRILLE		6" SUPPLY AIR BOOT ABOVE		14"x8" RETURN AIR GRILLE		RETURN AIR STACK ABOVE
	FLOOR SUPPLY AIR GRILLE 6" BOOT		SUPPLY AIR STACK FROM 2nd FLOOR		30"x8" RETURN AIR GRILLE		RETURN AIR STACK 2nd FLOOR
	SUPPLY AIR BOOT ABOVE		6" SUPPLY AIR STACK 2nd FLOOR		FRA- FLOOR RETURN AIR GRILLE		REDUCER
						REVISIONS	
						No.	Description
						Date	

ALL DRAWINGS, CALCULATIONS AND SPECIFICATIONS ARE THE PROPERTY OF HVAC DESIGNS LTD.© AND MAY NOT BE REPRODUCED, MODIFIED OR ALTERED WITHOUT EXPRESSED WRITTEN CONSENT. THE DRAWINGS ARE DATED AND USE OF THESE DRAWINGS AFTER ONE YEAR FROM THE DATED NOTED IS NOT AUTHORIZED. CONTRACTOR SHALL CHECK ALL CONDITIONS BEFORE PROCEEDING WITH WORK. LATEST MUNICIPAL APPROVED DRAWINGS ONLY TO BE USED DURING INSTALLATION OF HEATING SYSTEM. HVAC DESIGNS LTD. IS NOT LIABLE FOR ANY CLAIMS ARISING FROM UNAUTHORIZED USE OF THE DRAWINGS OR FROM ANY CHANGES TO ACCEPTED STANDARDS AND/OR THE ONTARIO BUILDING CODE.

Client

GREENPARK HOMES

Project Name

LECCO RIDGE
MILTON, ONTARIO

JUNIPER 11 WUP 2961 sqft

375 Finley Ave - Suite 202 - Ajax, Ontario
L1S 2E2 Tel. 905.619.2300 - 905.420.5300 Fax 905.619.2375
Email: info@hvacdsgns.ca
Web: www.hvacdesigns.ca
Specializing in Residential Mechanical Design Services

Installation to comply with the latest Ontario Building Code. All supply branch outlets shall be equipped with a manual balancing damper. Ductwork which passes through the garage or unheated spaces shall be adequately insulated and be gas-proofed.

HEAT LOSS 50190 BTU/H
UNIT DATA

MAKE

AMANA

MODEL

AMVC960804CNA

INPUT

80

MBTU/H

OUTPUT

76.8

MBTU/H

COOLING

3.5

TONS

FAN SPEED

1316

cfm @ 0.5" w.c.

OF RUNS S/A R/A FANS

3RD FLOOR

2ND FLOOR

11

5

3

1ST FLOOR

7

2

2

BASEMENT

5

1

0

Sheet Title

BASEMENT
HEATING
LAYOUT

Date


FEB/2017

Scale

3/16" = 1'-0"


BCIN# 19669

LO# 72388

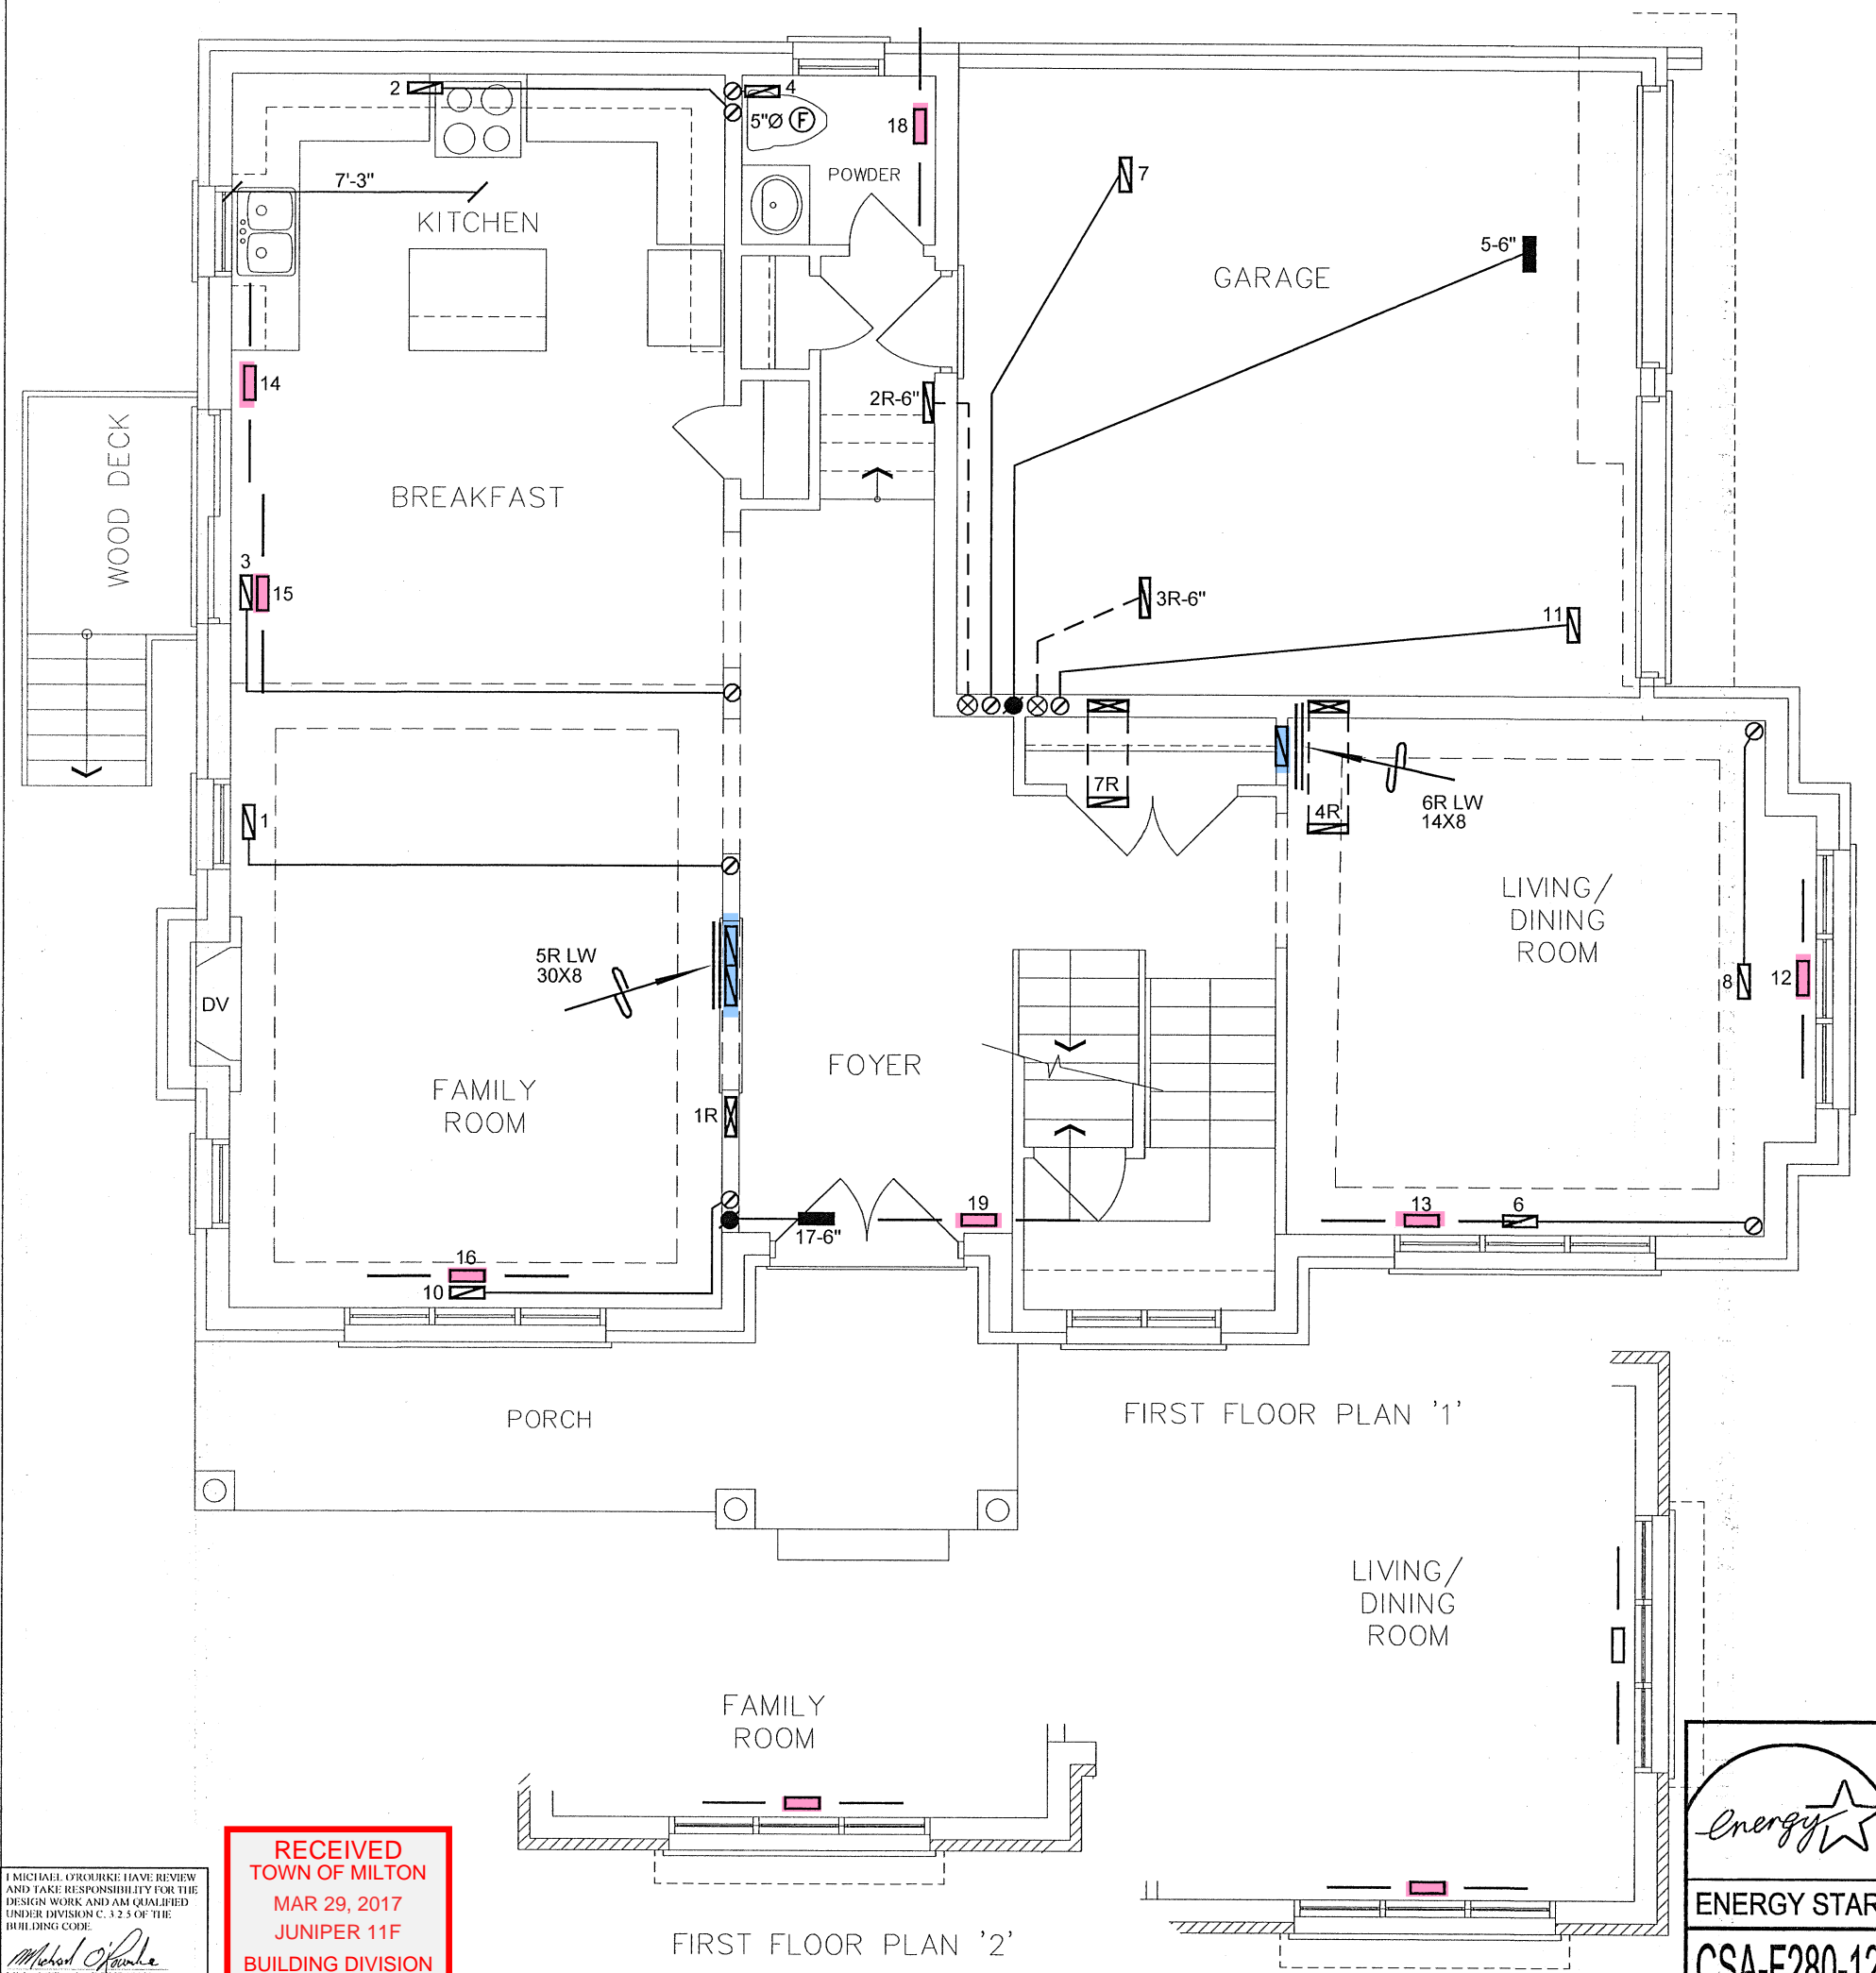

I MICHAEL O'ROURKE HAVE REVIEWED AND TAKE RESPONSIBILITY FOR THE DESIGN WORK AND AM QUALIFIED UNDER DIVISION C.3.2.5 OF THE BUILDING CODE.
Michael O'Rourke
Michael O'Rourke, BCIN# 19669
HVAC DESIGNS LTD.

RECEIVED
TOWN OF MILTON
MAR 29, 2017
JUNIPER 11F
BUILDING DIVISION

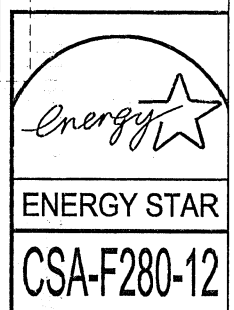

HVAC LEGEND							3.		
SYMBOL	DESCRIPTION	SYMBOL	DESCRIPTION	SYMBOL	DESCRIPTION	SYMBOL	DESCRIPTION	2.	
	FLOOR SUPPLY AIR GRILLE		6" SUPPLY AIR BOOT ABOVE		14"x8" RETURN AIR GRILLE		RETURN AIR STACK ABOVE	1.	
	FLOOR SUPPLY AIR GRILLE 6" BOOT		SUPPLY AIR STACK FROM 2nd FLOOR		30"x8" RETURN AIR GRILLE		RETURN AIR STACK 2nd FLOOR	No.	Description
	SUPPLY AIR BOOT ABOVE		6" SUPPLY AIR STACK 2nd FLOOR		FRA- FLOOR RETURN AIR GRILLE		REDUCER		Date

ALL DRAWINGS, CALCULATIONS AND SPECIFICATIONS ARE THE PROPERTY OF HVAC DESIGNS LTD.© AND MAY NOT BE REPRODUCED, MODIFIED OR ALTERED WITHOUT EXPRESSED WRITTEN CONSENT. THE DRAWINGS ARE DATED AND USE OF THESE DRAWINGS AFTER ONE YEAR FROM THE DATED NOTED IS NOT AUTHORIZED. CONTRACTOR SHALL CHECK ALL CONDITIONS BEFORE PROCEEDING WITH WORK. LATEST MUNICIPAL APPROVED DRAWINGS ONLY TO BE USED DURING INSTALLATION OF HEATING SYSTEM. HVAC DESIGNS LTD. IS NOT LIABLE FOR ANY CLAIMS ARISING FROM UNAUTHORIZED USE OF THE DRAWINGS OR FROM ANY CHANGES TO ACCEPTED STANDARDS AND/OR THE ONTARIO BUILDING CODE.

Client GREENPARK HOMES	HVAC DESIGNS LTD. 375 Finley Ave - Suite 202 - Ajax, Ontario L1S 2E2 Tel. 905.619.2300 - 905.420.5300 Fax 905.619.2375 Email: info@hvacdsgns.ca Web: www.hvacdsgns.ca Specializing in Residential Mechanical Design Services	TOWN OF MILTON PLANNING AND DEVELOPMENT JUNIPER 11F MODEL BUILDING: REVIEWED SCOTT SHERRIFFS APR 11, 2017 PLANS EXAMINER DATE Neither the issuance of a permit nor carrying out of inspections by the Town of Milton relieves the owner from full responsibility for compliance with the provisions of the Ontario Building Code Act and the Ontario Building Code, both as amended, as well as other applicable statutes and regulations of the Province of Ontario, By-laws of the Region of Halton and Town of Milton	Sheet Title FIRST FLOOR HEATING LAYOUT Date FEB/2017 Scale 3/16" = 1'-0" BCIN# 19669 LO# 72388
Project Name LECCO RIDGE MILTON, ONTARIO	Installation to comply with the latest Ontario Building Code. All supply branch outlets shall be equipped with a manual balancing damper. Ductwork which passes through the garage or unheated spaces shall be adequately insulated and be gas-proofed.		
JUNIPER 11 WUP 2961 sqft			

