

CONSTRUCTION SUMMARY

Saddle Ridge (G) - Lecco Ridge Developments Inc.

TEL: RES.: 647-545-9107



PURCHASERS: PATHIRAGE C KASTURIARACHCHI and SANKA M KASTURIARACHCHI

LOT / PHASE Block 341 TH 4 / 1	REG. PLAN # 20M-1184	HOUSE TYPE Ivy 2 Elev 2		
-----------------------------------	-------------------------	----------------------------	--	--

CABINETRY ACCESSORIES

1 - KITCHEN CABINETRY BASE - PIE CUT CORNER CABINET - BASE CABINETRY - STANDARD 03Nov17 Note:	
1 - PANTRY UNIT UPGRADE - TO GO FROM 300MM TO 600MM DEEP - PRICE IS PER FOOT - STANDARD 03Nov17 Note:	
1 - KITCHEN CABINETRY UPPER - FULL DEPTH ABOVE FRIDGE - WITH GABLES - 600MM - PRICE IS EACH - STANDARD 03Nov17 Note:	

CONSTRUCTION

1 - SMOOTH CEILINGS ON FIRST FLOOR ONLY 03Nov17 Note:	
--	--

DOORS AND WINDOWS

1 - THROUGHOUT - INTERIOR DOORS ONLY - WEISER WINSTON SATIN CHROME LEVERS 03Nov17 Note:	
--	--

ELECTRICAL

1 - STANDARD DINING ROOM LIGHT TO BE CENTERED BETWEEN LIVING AND DINING ROOM 03Nov17 Note:	
1 - RELOCATE STANDARD KITCHEN LIGHT TO BE CENTERED OVER ISLAND 03Nov17 Note:	
6 - POT LIGHT - LOW VOLTAGE LED - FIRST FLOOR INSTALLATION 21Sep17 Note: new promo balance \$2980.00	

PLUMBING

1 - WASHROOM - 3 PIECE ROUGH-IN IN BASEMENT 06Mar17 Note:	
--	--

PROMOTIONAL

1 - LESS BALANCE OF CREDIT FROM PURCHASER EXTRA SHEET IN OFFER 03Nov17 Note:	
1 - PARTIAL REDEMPTION OF PROMOTIONAL PACKAGE \$\$\$\$\$\$ BALANCE FORWARD TO BE USED AT A LATER DATE. ORIGINAL PROMOTIONAL PACKAGE OF \$\$\$\$\$ AS PER SCHEDULE PE DATED MMMDDYYYY. 21Sep17 Note:	
1 - PARTIAL REDEMPTION OF PROMOTIONAL PACKAGE \$\$\$\$\$\$ BALANCE FORWARD TO BE USED AT A LATER DATE. ORIGINAL PROMOTIONAL PACKAGE OF \$\$\$\$\$ AS PER SCHEDULE PE DATED MMMDDYYYY. 06Mar17 Note: ORIGINAL PROMO PACKAGE - \$5000.00 BALANCE FORWARD - \$4360.00	

STAIRS AND RAILINGS

1 - STAINED STAIRS, RAILING AND PICKETS - STANDARD STAIRCASE - PRICE IS PER SET 03Nov17 Note:	
--	--

RECEIVED NOV 03 2017

CONSTRUCTION SUMMARY				
Saddle Ridge (G) - Lecco Ridge Developments Inc.				
PURCHASERS: PATHIRAGE C KASTURIARACHCHI and SANKA M KASTURIARACHCHI			TEL: RES.: 647-545-9107	
LOT / PHASE	REG. PLAN #	HOUSE TYPE		
Block 341 TH 4 / 1	20M-1184	Ivy 2 Elev 2		

EXTRAS AS PER OFFER

Five (5) White Appliances as per PE Appliances <i>Worksheet</i> Note:	
The Vendor agrees that notwithstanding any other term or provision in this Agreement included in the Purchase Price and in addition to those items detailed in Schedule GP to the Agreement of Purchase and Sale, the Purchaser is entitled to a credit of Fiv <i>Worksheet</i> Note:	
The Purchaser acknowledges that the Purchase Price is inclusive of all credits and promotional packages available at the time of purchase. <i>Worksheet</i> Note:	

This Document is Extremely Time Sensitive - Printed 3 Nov 17 at 11:49

Purchasers:PATHIRAGE C KASTURIARACHCHI & SANKA M

Property: Block 341 TH 4

Telephone Res. / Bus: (647) 545-9107 /

Project: Lecco Ridge Developments Inc.

Decor Advisor: Candace Forza

Model and Elevation: Ivy 2 Elev 2

Lock Date: 3-Nov-17

3-Nov-17

Plan #: 20M-1184

Layout Changes: ☐ Yes ☒ No

Sketch Attached: ☒ Yes ☐ No

Exterior Colour Scheme:

1. Cabinetry

	Style and Colour	Hardware
Kitchen / Breakfast	Everest P790XZ9	2002
Laundry Room	BASEMENT	N/A
Powder Room	Everest P790XZ9	1001
Master Ensuite Bathroom	MONACO W350XZ4	1001
Main Bathroom	Everest P790XZ9	1001
	N/A	N/A
	N/A	N/A
	N/A	N/A
	N/A	N/A

Appliances:

Built In Appliances ☐ Yes ☒ No

Slide In Stove ☐ Yes ☒ No

Dishwasher Cabinet

☐ Closed ☒ Open

41" Upper Cabinets ☒ Yes ☐ No

Please NOTE: Standard Cabinet Height is 30"

Stove Opening

NOTE: If not specified, opening will be set to builder's standard opening of approximately 30" width

Fridge Opening

NOTE: If not specified, opening will be set to builder's standard opening of approximately 37" width x 74" height

** Refer to Construction Summary

2. Counters

	Counter	Edge
Kitchen / Breakfast	LAMINATE-KALAHARI TOPAZ-4588K-07	
Laundry Room	N/A	
Powder Room	LAMINATE-PALOMA BISQUE-6729-46	
Master Ensuite Bathroom	LAMINATE-CALCUTTA MARBLE-4925K-07	
Main Bathroom	LAMINATE-NEUTRAL GLACE-4143-60	
	N/A	
	N/A	
	N/A	
	N/A	

** Refer to Construction Summary

Initials:

Purchasers:PATHIRAGE C KASTURIARACHCHI & SANKA M

Property: Block 341 TH 4

Telephone Res. / Bus: (647) 545-9107 /

Project: Lecco Ridge Developments Inc.

Decor Advisor: Candace Forza

Model and Elevation: Ivy 2 Elev 2

Lock Date: 3-Nov-17

3-Nov-17

Plan #: 20M-1184

3. Ceramic Flooring

Entrance Vestibule	TILE-BEACHES IVORY-13X13	<input type="checkbox"/>	
Main Hall	LAMINATE	<input type="checkbox"/>	
Kitchen / Breakfast	TILE-BEACHES IVORY-13X13	<input type="checkbox"/>	METAL STRIP
Laundry Room	N/A	<input type="checkbox"/>	
Powder Room	TILE-BEACHES IVORY-13X13	<input type="checkbox"/>	METAL STRIP
Master Ensuite Bathroom	TILE-RAINBOW WHITE-13X13	<input type="checkbox"/>	METAL STRIP
Main Bathroom	TILE-BEACHES IVORY-13X13	<input type="checkbox"/>	METAL STRIP
GARAGE ENTRY	TILE-BEACHES IVORY-13X13	<input type="checkbox"/>	
	N/A	<input type="checkbox"/>	
	N/A	<input type="checkbox"/>	
	N/A	<input type="checkbox"/>	

** Refer to Construction Summary

4. Ceramic Wall Tile

Master Ensuite Bathroom	Selection	Describe
Tub Deck Wall	TILE-NATURALE GRIGIO-8X10	***LAID HORIZONTALLY***
Tub Deck	N/A	
Tub Deck Skirt	N/A	
Shower Stall	TILE-NATURALE GRIGIO-8X10	***LAID HORIZONTALLY***
Bathtub Enclosure Walls	N/A	
	N/A	
Main Bathroom	TILE-CARRARA MATTE-8X10	***LAID HORIZONTALLY***
	N/A	
	N/A	
	N/A	
Kitchen Backsplash	N/A	

** Refer to Construction Summary - STANDARD GROUT THROUGHOUT UNLESS SPECIFIED

5. Plumbing Fixtures

All Bathrooms

White

N/A

N/A

Whirlpool

N/A ☐ Yes ☒ No

Dishwasher Rough-In

☒ Yes ☐ No

Waterline for Fridge

☐ Yes ☒ No

** Refer to Construction Summary

6. Trim Carpentry

Interior Doors	CLERMONT
Interior Trim	As Per Construction Specifications
Door Handles	SATIN CHROME LEVER
Exterior Front Door Handle	SATIN CHROME CHELSEA

** Refer to Construction Summary

Initials:  

Purchasers:PATHIRAGE C KASTURIARACHCHI & SANKA M

Property:Block 341 TH 4

Telephone Res. / Bus: (647) 545-9107 /

Project:Lecco Ridge Developments Inc.

Decor Advisor:Candace Forza

Model and Elevation:Ivy 2 Elev 2

Lock Date:3-Nov-17

3-Nov-17

Plan #:20M-1184

7. Other Flooring

Main Hall	LAMINATE-TORLYS-MANHATTAN-BOARDWALK ACACIA-TL-15019
Living Room	LAMINATE-TORLYS-MANHATTAN-BOARDWALK ACACIA-TL-15019
Dining Room	LAMINATE-TORLYS-MANHATTAN-BOARDWALK ACACIA-TL-15019
Family Room	N/A
Den / Library / Study	LAMINATE-TORLYS-MANHATTAN-BOARDWALK ACACIA-TL-15019
Basement Landing(If Applies)	N/A
Lower Landing (If Applies)	N/A
Upper Landing	LAMINATE-TORLYS-MANHATTAN-BOARDWALK ACACIA-TL-15019
Upper Hall	CARPET-SHAW-NEWBERN-TAUPE-55105
Master Bedroom	CARPET-SHAW-NEWBERN-TAUPE-55105
Bedroom #2	CARPET-SHAW-NEWBERN-TAUPE-55105
Bedroom #3	CARPET-SHAW-NEWBERN-TAUPE-55105
Bedroom #4	N/A
Bedroom #5	N/A
	N/A
	N/A
	N/A
Underpad	TypeArea
	STANDARDSECOND FLOOR ONLY

** Refer to Construction Summary

8. Railings and Pickets

Railing Type	AS PER CONSTRUCTION SPECIFICATIONS	Colour	TORLYS BOARDWALK ACACIA
Picket Type	AS PER CONSTRUCTION SPECIFICATIONS	Colour	TORLYS BOARDWALK ACACIA
Stringer / Riser	AS PER CONSTRUCTION SPECS	Colour	TORLYS BOARDWALK ACACIA
Treads	AS PER CONSTRUCTION SPECS	Colour	TORLYS BOARDWALK ACACIA
Red Oak Stairs with Semi Gloss Finish			<input checked="" type="radio"/> Yes <input type="radio"/> No

** Refer to Construction Summary

9. Wall Paint Flat Finish

Main & Upper Hall	25 OYSTER	Master Bedroom	22 WARM GREY
Living Room	25 OYSTER	Bedroom #2	25 OYSTER
Dining Room	25 OYSTER	Bedroom #3	25 OYSTER
Kitchen / Breakfast	25 OYSTER	Bedroom #4	N/A
Family Room	N/A	Bedroom #5	N/A
Powder Room	25 OYSTER	Master Ensuite	22 WARM GREY
Laundry Room	N/A	Main Bathroom	25 OYSTER
Den/Library	25 OYSTER		N/A
Trim Paint-Semi Gloss	BIRCH WHITE		N/A
	N/A		N/A
	N/A		N/A

Smooth Ceilings First Floor ☒ Yes ☐ No

** Refer to Construction Summary

Purchasers:PATHIRAGE C KASTURIARACHCHI & SANKA M

Property: Block 341 TH 4

Telephone Res. / Bus: (647) 545-9107 /

Project: Lecco Ridge Developments Inc.

Decor Advisor: Candace Forza

Model and Elevation: Ivy 2 Elev 2

Lock Date: 3-Nov-17

3-Nov-17

Plan #: 20M-1184

10. Plaster Mouldings and Medallions

Entrance Vestibule	N/A	N/A	Kitchen/Breakfast	N/A	N/A
Main Hall	N/A	N/A	Den/Library	N/A	N/A
Living Room	N/A	N/A	Lower Landing	N/A	N/A
Dining Room	N/A	N/A		N/A	N/A
Family Room	N/A	N/A			

** Refer to Construction Summary

11. Fireplace

	Living Room			Family Room			Other Room - Specify		
	Purchased	As Per Plan	N/A	Purchased	As Per Plan	N/A	Purchased	As Per Plan	N/A
	<input type="radio"/>	<input type="radio"/>	<input checked="" type="radio"/>	<input type="radio"/>	<input type="radio"/>	<input checked="" type="radio"/>	<input type="radio"/>	<input type="radio"/>	<input checked="" type="radio"/>
Fireplace Type	N/A			N/A			N/A		
Mantle Type	N/A			N/A			N/A		
Colour / Stain	N/A			N/A			N/A		
Surround	N/A			N/A			N/A		
Hearth	N/A			N/A			N/A		

** Refer to Construction Summary

12. Heating and Air Conditioning

Air Conditioning	NO	Gas Provisions Stove	NO
Gas Provisions Dryer	NO	Gas Provisions Barbecue	NO
Comment			

** Refer to Construction Summary

13. Electrical

Plugs and Switches	<input checked="" type="radio"/> White	DECOR	Above Kitchen Cabinet Light	<input type="radio"/> Yes	<input checked="" type="radio"/> No
Hood Fan	STANDARD WHITE		Below Kitchen Cabinet Light	<input type="radio"/> Yes	<input checked="" type="radio"/> No
Appliances	Built in Cooktop	Built in Oven	Gas Stove	Microwave	
	<input type="radio"/> Yes <input checked="" type="radio"/> No	<input type="radio"/> Yes <input checked="" type="radio"/> No	<input type="radio"/> Yes <input checked="" type="radio"/> No	<input type="radio"/> Yes <input checked="" type="radio"/> No	
Dishwasher Rough-in	Yes				

** Refer to Construction Summary

14. General Comments

** Refer to Construction Summary


Disclaimers and Notes

1) Colours of all materials are as close as possible to builder's selection, but not necessarily identical due to variances in manufacturing.


2) Any extras listed above are null and void unless accompanied by a separate invoice/amendment. Said invoice must be paid in full.

3) The Purchaser agrees that this colour selection is final and that no changes will be permitted, unless required by the Vendor.

4) The Purchaser acknowledges reading and accepting document which contains other miscellaneous disclaimers.


Signature: 

Date: NOV. 3/17

Signature: 

Date: 03-nov-17

Page 4 of 4

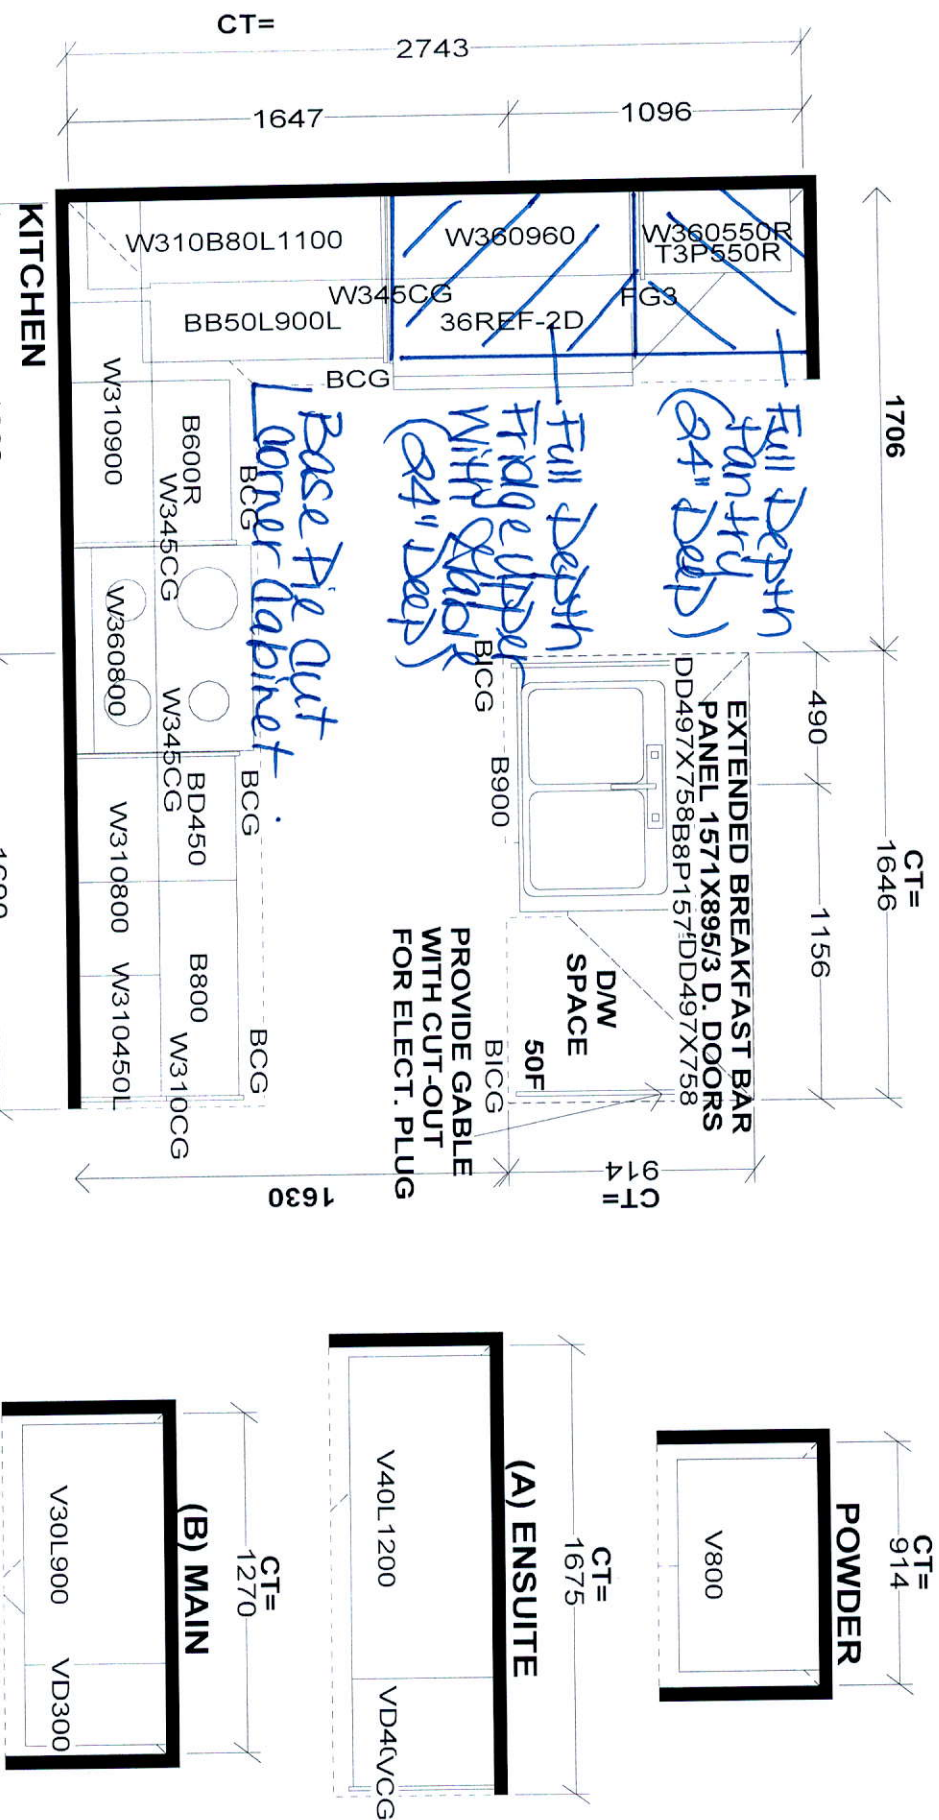

S e l b a I n d u s t r i e s

STANDARD FEATURES:

- 9' CEILINGS WITH D/C BOX
- 1040MM HIGH UPPER CABINETS
- DISHWASHER SPACE
- DUMMY DOORS ON EXPOSED BACKS
- LAMINATE KITCHEN & VANITY COUNTERTOPS

This drawing is the intellectual property of SELBA INDUSTRIES INC. and is an original design which must not be released or copied unless applicable fee has been paid or job order placed.



JOB NUMBER:
BUILDER: GREENPARK HOMES
SITE NAME: LECCO RIDGE, Milton
MODEL: IVY 2X ELEV 1,2,3
LOT #:
DESIGNER: KS
DATE: FEB 13 17



1,641 SQ. FT.

343, 345 & 347

6 Potlights

Relocate Standard
- right to Above
Island.

