**Greenpark** 

	CONS	STRUCTION SUMMARY		
W	Saddle Ridge	e (G) - Lecco Ridge Developments I	Inc.	
PURCHASERS: WAHEE	D AKHTAR and SHABNUM HA	ABIB	1	T.D.Y
LOT / PHASE	REG. PLAN#	House		TEL:
105 / 1	20M-1184	HOUSE TYPE Juniper 7 Elev 2		
		Jumper / Elev 2		
CABINETRY				
1 - KITCHEN -MONACO	CABINETRY WITH UPGRADE	STAIN		
22Mar18 Note:				
CABINETRY ACCESSO	ORIES!			
1 - KITCHEN CABINETRY	BASE - POT/PAN DRAWERS	(CADIMET) CTANDADO		
22Mar18 Note:	- TO THE TOTAL PROPERTY	(CABINET) - STANDARD		
1 - KITCHEN CABINETRY	' BASE - PIE CUT CORNER CA	BINET - BASE CABINETRY - STANDAR	D	
22Mar18 Note:				
1 - KITCHEN CARINETRY	LIDDED ELLI DEDEN ADOLU			
22Mar18 Note:	OFFER - FULL DEPTH ABOV	E FRIDGE - WITH GABLES - 600MM - PR	RICE IS EACH - STANDA	ARD
1 - PANTRY UNIT UPGRA	DE - TO GO FROM 300MM TO	600MM DEEP - PRICE IS PER FOOT - ST	CANDARD	
22Mar18 Note:		13.12.13.13.13.13.13.13.13.13.13.13.13.13.13.	ANDARD	
CONSTRUCTION				
1 - PLEASE NOTE THAT N	O FURTHER STRUCTURAL CE	HANGES WILL BE PERMITTED.		
20Dec16 Note:	o moe round er	MINGES WILL BE FERMITTED.		
1 - ADD BASEMENT WALL	K-UP			+-
20Dec16 Note:				
ELECTRICAL				
1 - PLUG - ELECTRICAL PI	LUG - TO BE INSTALLED OVE	R STOVE FOR FUTURE MICROWAVE/H	IOOD FAN	
05Feb18 Note:				
1 - RELOCATE STANDARD	VITOUEN LIGHT TO DE CENT			
05Feb18 Note:	KITCHEN LIGHT TO BE CEN	TERED OVER ISLAND		
1 - STANDARD DINING RO	OM LIGHT TO BE CENTERED	BETWEEN LIVING AND DINING ROOM	1	
05Feb18 Note:		III SOOM MARKATAN EE S PARE I B		
1 DIVIG BY DOMESTS				
	UG - TO BE INSTALLED OVE	R FIREPLACE		
05Feb18 Note:				
1 - 200 AMP ELECTRICAL S	SERVICE			
05Feb18 Note:				
TREPLACE AND ACCE	SSORIES			
	OR BARBECUE - FIRST FLOOR			
22 <i>Mar18</i> Note:	OK BARBECUE - FIRST FLOOR			
	OR STOVE (INCLUDES ELECTI	RICAL OUTLET) - FIRST FLOOR		
22Mar18 Note:				
ARDWOOD FLOORING	G			
- HARDWOOD – GROUP C	SERIES 5 INCH - IN LIEU OF	2 1/4 INCH NATURAL RED OAK FIRS	ST FLOOR COMPLETE	
22Mar18 Note:				
ROMOTIONAL				
	RCHASER EXTRA SHEET IN O	FFFR		
20Dec16 Note:				
				1

STAIRS AND RAILINGS

Greenpark.

	CO	NSTRUCTION SUMMARY		
DIDCHASEDS WATER	Saddle R	idge (G) - Lecco Ridge Developments Inc		
PURCHASERS: WAHEED	AKHTAR and SHABNUM	HABIB		TEL:
LOT/PHASE 105/1	REG. PLAN # 20M-1184	HOUSE TYPE Juniper 7 Elev 2		1221
1 - 1¾" SQUARE PICKETS			1	,
22Mar18 Note: STAIRC	ASE			
1 V CDCCVP V V				
1 - V GROOVE HANDRAIL				
22Mar18 Note: STAIRCA	ASE			
1 - STAINED STAIRS DAIL	INC AND DIGHTER OF THE			
22Mar18 Note:	ING AND PICKETS – STA	NDARD STAIRCASE - PRICE IS PER SET		
22mar 18 Hote.				
	EX	TRAS AS PER OFFER		
The Purchaser acknowledge	s that the Purchase Price	is inclusive of all credits and promotional packages ava	ilable at the time	-6
•		ma promotional packages ava	nable at the time	OI
Worksheet Note:				

This Document is Extremely Time Sensitive - Printed 22 Mar 18 at 15:22

The Vendor agrees that notwithstanding any other term or provision in this Agreement included in the Purchase Price and in

addition to those items detailed in Schedule GP to the Agreement of Purchase and Sale, the Purchaser is entitled to a credit of Ten Worksheet Note:

Greenpa	rk.	INTERIOR COLOUR SCHEME				
Purchasers:	WAHEED AKHTAR	& SHABNUM HABIB	Property: 105			
Telephone Res. / Bus:	/	The second secon	V. 180	Pidgo Dovolonos salat		
Decor Advisor:	Candace Forza	Model and	l Elevation: Juniper	Ridge Developments Inc.		
-ock Date:	22-Mar-18	22-Mar-18	Plan #:			
Layout Changes:	es No Sket	tch Attached: Yes				
1. Cabinetry			- Laterior Goldi	ur ocheme:		
(itchen / Breakfast	Style and Colour MONACO W821XZ4			Hardwar		
aundry Room	ELISSE			2004		
owder Room	MONACO W350XZ4			Standar		
laster Ensuite Bathroom	MONACO W350XZ4			2004		
nsuite Bath - Bedroom 2	MONACO W350XZ4			2004		
nsuite Bath - Bedroom 3/		the second secon		2004		
	N/A			2004		
	N/A			N/A		
				N/A		
	N/A			N/A		
opliances:	Built In Appliance	s Yes No	s	lide In Stove ( ) Yes   No		
shwasher Cabinet	○ Closed ● O	pen 41" Upper Cabin		Please NOTE: Standard Cabinet Height is		
idge Opening	Summary		ill be set to builder's standard o			
idge Opening	Summary					
idge Opening Refer to Construction	Summary					
Refer to Construction  Counters  chen / Breakfast		NOTE: If not specified, opening w	ill be set to builder's standard o			
Refer to Construction  Counters  tchen / Breakfast undry Room	Counter LAMINATE-CARRAR/ N/A	NOTE: If not specified, opening with the specified of the	ill be set to builder's standard o			
Refer to Construction  Counters  tchen / Breakfast undry Room wder Room	Counter LAMINATE-CARRAR/ N/A LAMINATE-CALCUTT	NOTE: If not specified, opening with the specified of the	ill be set to builder's standard o			
Refer to Construction  Counters  chen / Breakfast undry Room wder Room ster Ensuite Bathroom	Counter LAMINATE-CARRAR/ N/A LAMINATE-CALCUTT LAMINATE-CALCUTT	NOTE: If not specified, opening with the specified of the	ill be set to builder's standard o			
Refer to Construction  Counters  Chen / Breakfast  undry Room wder Room ster Ensuite Bathroom suite Bath - Bedroom 2	Counter LAMINATE-CARRAR/ N/A LAMINATE-CALCUTT LAMINATE-CALCUTT	NOTE: If not specified, opening with the specified of the	ill be set to builder's standard o			
Counters  tchen / Breakfast undry Room wder Room ester Ensuite Bathroom suite Bath - Bedroom 2	Counter LAMINATE-CARRAR/ N/A LAMINATE-CALCUTT LAMINATE-CALCUTT LAMINATE-CALCUTT LAMINATE-CALCUTT	NOTE: If not specified, opening with the specified of the	ill be set to builder's standard o			
Counters  tchen / Breakfast undry Room exter Ensuite Bathroom suite Bath - Bedroom 3/4	Counter LAMINATE-CARRAR/ N/A LAMINATE-CALCUTT LAMINATE-CALCUTT LAMINATE-CALCUTT LAMINATE-CALCUTT	NOTE: If not specified, opening with the specified of the	ill be set to builder's standard o	pening of approximately 37" width x 74" heigi		
Counters  tchen / Breakfast undry Room wder Room ester Ensuite Bathroom suite Bath - Bedroom 2	Counter LAMINATE-CARRAR/ N/A LAMINATE-CALCUTT LAMINATE-CALCUTT LAMINATE-CALCUTT LAMINATE-CALCUTT N/A N/A	NOTE: If not specified, opening with the specified of the	ill be set to builder's standard o			
Refer to Construction  Counters  Chen / Breakfast  undry Room wder Room ster Ensuite Bathroom suite Bath - Bedroom 2	Counter LAMINATE-CARRAR/ N/A LAMINATE-CALCUTT LAMINATE-CALCUTT LAMINATE-CALCUTT LAMINATE-CALCUTT	NOTE: If not specified, opening with the specified of the	ill be set to builder's standard o			

Initials:

Durche	' <b>k</b>					
	WAHEED AKHTAR & SHABNU	M HABIB	Property:	105		
Telephone Res. / Bus: Decor Advisor:	1		Project:	Lec	co Ric	lge Developments Inc.
T	Candace Forza	Model and				
Lock Date:	22-Mar-18 22-N	Mar-18		Plai	n #:	20M-1184
3. Ceramic Flooring						
Entrance Vestibule	TILE-ESSENZE GRIGIO-13X13		, , , , , , , , , , , , , , , , , , ,	t a 45		shold-If App.
Main Hall	STRIP	2007/2 - 121 %		1	META	AL STRIP
Kitchen / Breakfast	TILE-ESSENZE GRIGIO-13X13				NACTA	N. OTDID
Laundry Room	TILE-ESSENZE GRIGIO-13X13					AL STRIP
Powder Room	TILE-ESSENZE GRIGIO-13X13				IVIC 17	AL STRIP
Master Ensuite Bathroom	TILE-ESSENZE GRIGIO-13X13				META	AL STRIP
Ensuite Bath - Bedroom 2	TILE-ESSENZE GRIGIO-13X13		100000000000000000000000000000000000000			L STRIP
Ensuite Bath - Bedroom 3/4	TILE-ESSENZE GRIGIO-13X13					L STRIP
MUDROOM	TILE-ESSENZE GRIGIO-13X13					
	N/A					
* Refer to Construction Su	N/A					
1. Ceramic Wall Tile						
Master Ensuite Bathroom	Selection		Des	cribe		
Tub Deck V						
	eck N/A					
Tub Deck S						
Bathtub Enclosure W	Stall TILE-LUC. CONCEPT NEVE-8X16					
Datitab Eliciosale W	N/A			taet.		
insuite Bath - Bedroom 2	TILE-LUC. CONCEPT NEVE-8X16					
insuite Bath - Bedroom 3/4						
	N/A					
	N/A					
itchen Backsplash	N/A					
5. Plumbing Fixtures	ummary - STANDARD GROUT	THROUGHOU	TUNLESS	SPE	CIFIE	D
I Bathrooms	White	Wh	irlpool			
	N/A					N/A ○ Yes ● No
	N/A					
	N/A			ishw	asher	Rough-In Yes No
	N/A					for Fridge Yes No
	N/A					
	limmany					
Refer to Construction S	uniniary			-		
Refer to Construction So	animary	# - 12 (E.E.				
. Trim Carpentry terior Doors	CLASSIQUE					
. Trim Carpentry		EBOARD - COLC	DNIAL			
Trim Carpentry erior Doors erior Trim or Handles	CLASSIQUE	ns	DNIAL			

Initials:

Greenpark. INTERIOR COLOUR SCHEME Purchasers: WAHEED AKHTAR & SHABNUM HABIB Property: 105 Telephone Res. / Bus: Project: Lecco Ridge Developments Inc. Decor Advisor: Candace Forza Model and Elevation: Juniper 7 Elev 2 Lock Date: 22-Mar-18 22-Mar-18 Plan #: 20M-1184 7. Utiler Flooring Main Hall STRIP-VINTAGE-NSS-ETCHED ESTATE-MAPLE-UV OIL-TAHITI-5" Living Room STRIP-VINTAGE-NSS-ETCHED ESTATE-MAPLE-UV OIL-TAHITI-5" **Dining Room** STRIP-VINTAGE-NSS-ETCHED ESTATE-MAPLE-UV OIL-TAHITI-5" Family Room STRIP-VINTAGE-NSS-ETCHED ESTATE-MAPLE-UV OIL-TAHITI-5" Den / Library / Study STRIP-VINTAGE-NSS-ETCHED ESTATE-MAPLE-UV OIL-TAHITI-5" Basement Landing(If Applies) Lower Landing (If Applies) N/A **Upper Landing** STRIP-VINTAGE-NSS-ETCHED ESTATE-MAPLE-UV OIL-TAHITI-5" **Upper Hall** LAMINATE-PARK LANE - GREY VARNISHED OAK TL-U1305 Master Bedroom LAMINATE-PARK LANE - GREY VARNISHED OAK TL-U1305 Bedroom #2 LAMINATE-PARK LANE - GREY VARNISHED OAK TL-U1305 Bedroom #3 LAMINATE-PARK LANE - GREY VARNISHED OAK TL-U1305 Bedroom #4 LAMINATE-PARK LANE - GREY VARNISHED OAK TL-U1305 Bedroom #5 N/A N/A N/A N/A Underpad Туре Area N/A N/A \*\* Refer to Construction Summary

8.	Railings	and	<b>Pickets</b>
----	----------	-----	----------------

Railing Type V-GROOVE Colour VINTAGE TAHITI Picket Type 1 3/4" SQUARE PICKETS Colour VINTAGE TAHITI Stringer / Riser As Per Construction Specifications Colour VINTAGE TAHITI **Treads** As Per Construction Specifications Colour VINTAGE TAHITI Red Oak Stairs with Semi Gloss Finish Yes O No

\*\* Refer to Construction Summary

## 9. Wall Paint Flat Finish


Main & Upper Hall 22 WARM GREY **Master Bedroom** 22 WARM GREY Living Room 22 WARM GREY Bedroom #2 22 WARM GREY **Dining Room** 22 WARM GREY Bedroom #3 22 WARM GREY Kitchen / Breakfast 22 WARM GREY Bedroom #4 22 WARM GREY **Family Room** 22 WARM GREY Bedroom #5 N/A **Powder Room** 22 WARM GREY **Master Ensuite** 22 WARM GREY Laundry Room 22 WARM GREY Ensuite Bath - Bedroom 2 22 WARM GREY Den/Library 22 WARM GREY Ensuite Bath - Bedroom 3/4 22 WARM GREY Trim Paint-Semi Gloss BIRCH WHITE **Mud Room** 22 WARM GREY N/A N/A N/A N/A **Smooth Ceilings First Floor** Yes No

\*\* Refer to Construction Summary

Initials:

aree	npa	rk.			IN	ITERIOR (	COLOUR S	CHEME			
Purchasers:		WAHEE	AKHT	AR & S	НАВИИМ Н	ARIR	Dronout	105			
Telephone Res. / Bus: Decor Advisor: Lock Date:		1		,		ADID	Property:		0000 U.S.		
		Candace	Forza			Madaland		Lecco Ridge De		nents Inc.	
		22-Mar-18			22-Mar-		Elevation:	Juniper 7 Elev 2			
10. Plaste	r Mouldi		3	one	22-IVIAI-	10		<b>Plan #:</b> 20M	-1184		
Entrance V	estibule	N/A	Cuaiii	N/A		Vitalia (D					
Main Hall Living Room Dining Room Family Room		N/A		N/A		Kitchen/Breakfast		N/A	N/A		
		N/A N/A N/A		N/A		Den/Library Lower Landing		N/A	N/A		
				N/A		Lower Lan	laing	N/A		N/A	
								N/A	N/A		
** Refer to		A COS OF	arv	N/A							
			u. y								
				-							
11. Firepla	ice						-				
	Living Roo	m			Family Rooi	m		Other Room -	Specify		
	Purchased	As Per Plan	N/A		Purchased	As Per Plan	N/A		As Per Plan	n N/A	
	0		•							•	
Fireplace Type Mantle Type	N/A				FLAT ON W			N/A			-
Colour / Stain	N/A					-STANDARD		N/A			
Surround	N/A N/A		= = = =	=		NSTRUCTION	SPECIFICATI	ONS N/A			
Hearth	N/A				BIANCO			N/A			
** Refer to Co		Summan			NO			N/A			,
Comment * Refer to Co	nstruction	Summary									
13. Electric	al										
Plugs and Swi		White		Ь	ECOR		A D				
Hood Fan	tones	STANDAR	D WHI		ECOK			(itchen Cabinet	_	-	No
Appliances		Built in C			Built in (	Oven		litchen Cabinet Stove		377	) No
		Yes	<ul><li>No</li></ul>		Yes (	■ No	Yes	28	_	icrowave	
Dishwasher R	ough-in	Yes			J 100 1	- NO	163	○ No	Y	es	Vo
* Refer to Cor	1.0 <del>70</del> 77										
110101 10 001	otraction	Julilliary									
14. General	Commo	nte						714			
* Refer to Cons											
Disclaimers	and Note	es —									
1) Colours o variances	f all mater in manufa	rials are as acturing.	close	as pos	sible to buil	der's selec	tion, but no	t necessarily id	dentica	I due to	
2) Any extra must be p	s listed ab aid in full.	ove are nu	ıll and	void ui	nless accom	panied by	a separate	invoice/amendi	ment. S	aid invoid	ce
3) The Purch by the Ver	naser agre ndor.	es that this	s colou	ır seled	tion is final	and that no	o changes v	will be permitte	d, unle	ss require	ed
disclaime	aser ackn	owledges	reading	1	accepting do	i	hich contai	ns other misce	llaneou	S	
Signature:	N M	MAM	ell	Date:		Signature:	Shab	rum Habit	_ Date	22/3	118

Page 4 of 4

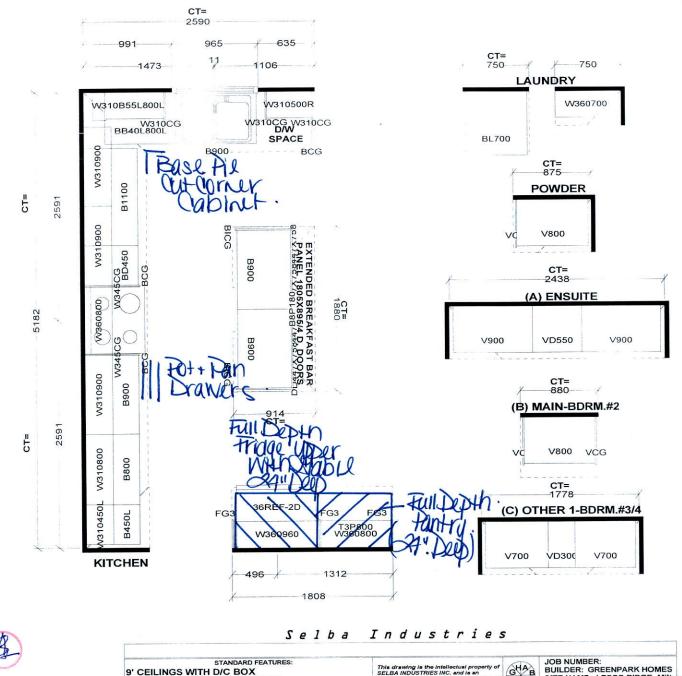







9' CEILINGS WITH D/C BOX 1040MM HIGH UPPER CABINETS DISHWASHER SPACE DUMMY DOORS ON EXPOSED BACKS
LAMINATE KITCHEN & VANITY COUNTERTOPS This drawing is the intellectual property of SELBA INDUSTRIES INC. and is an original desigh which must not be released or copied unless applicable fee has been paid or job order placed.



JOB NUMBER: BUILDER: GREENPARK HOMES SITE NAME: LECCO RIDGE, Milton MODEL: JUNIPER 7X ELEV 1,2 LOT #: DESIGNER: KS DATE: FEB 13 17

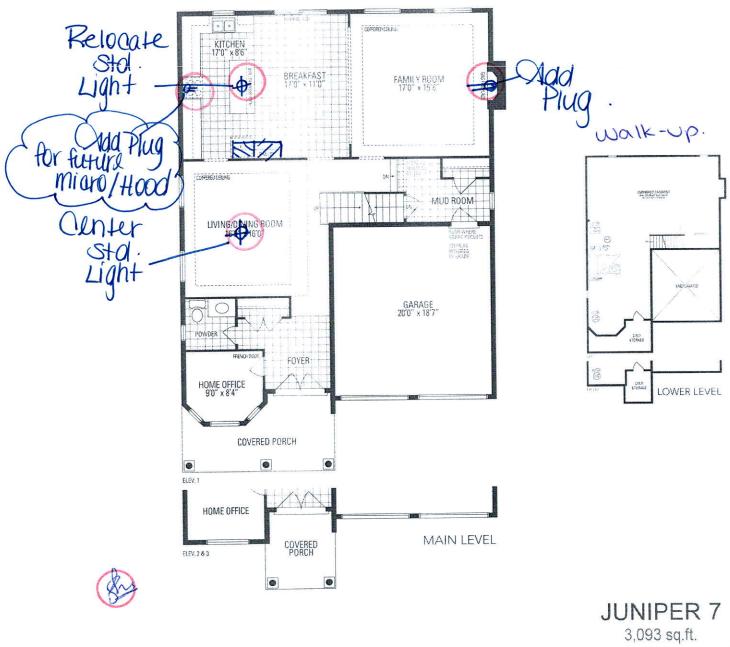

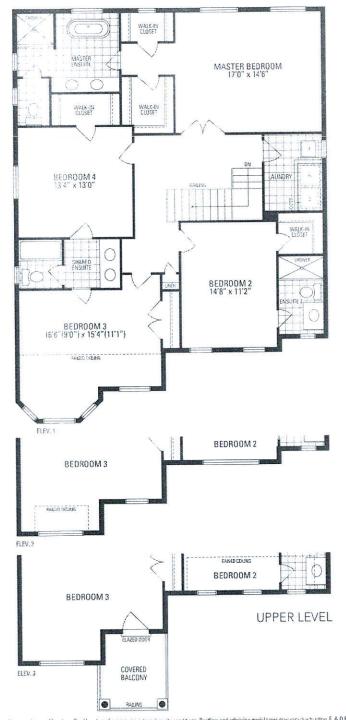

Drientables of home may be reversed and perchaser agrees to accept the same. Steps and perchaser agrees to accept the same agree to accept the same. Steps and perchaser agrees to accept the same agree to accept the same ag