



CITY OF HAMILTON
BUILDING DIVISION
Planning & Development Department
FEB 12 2018
REC BY _____ DATE _____
REFD TO _____ DATE _____

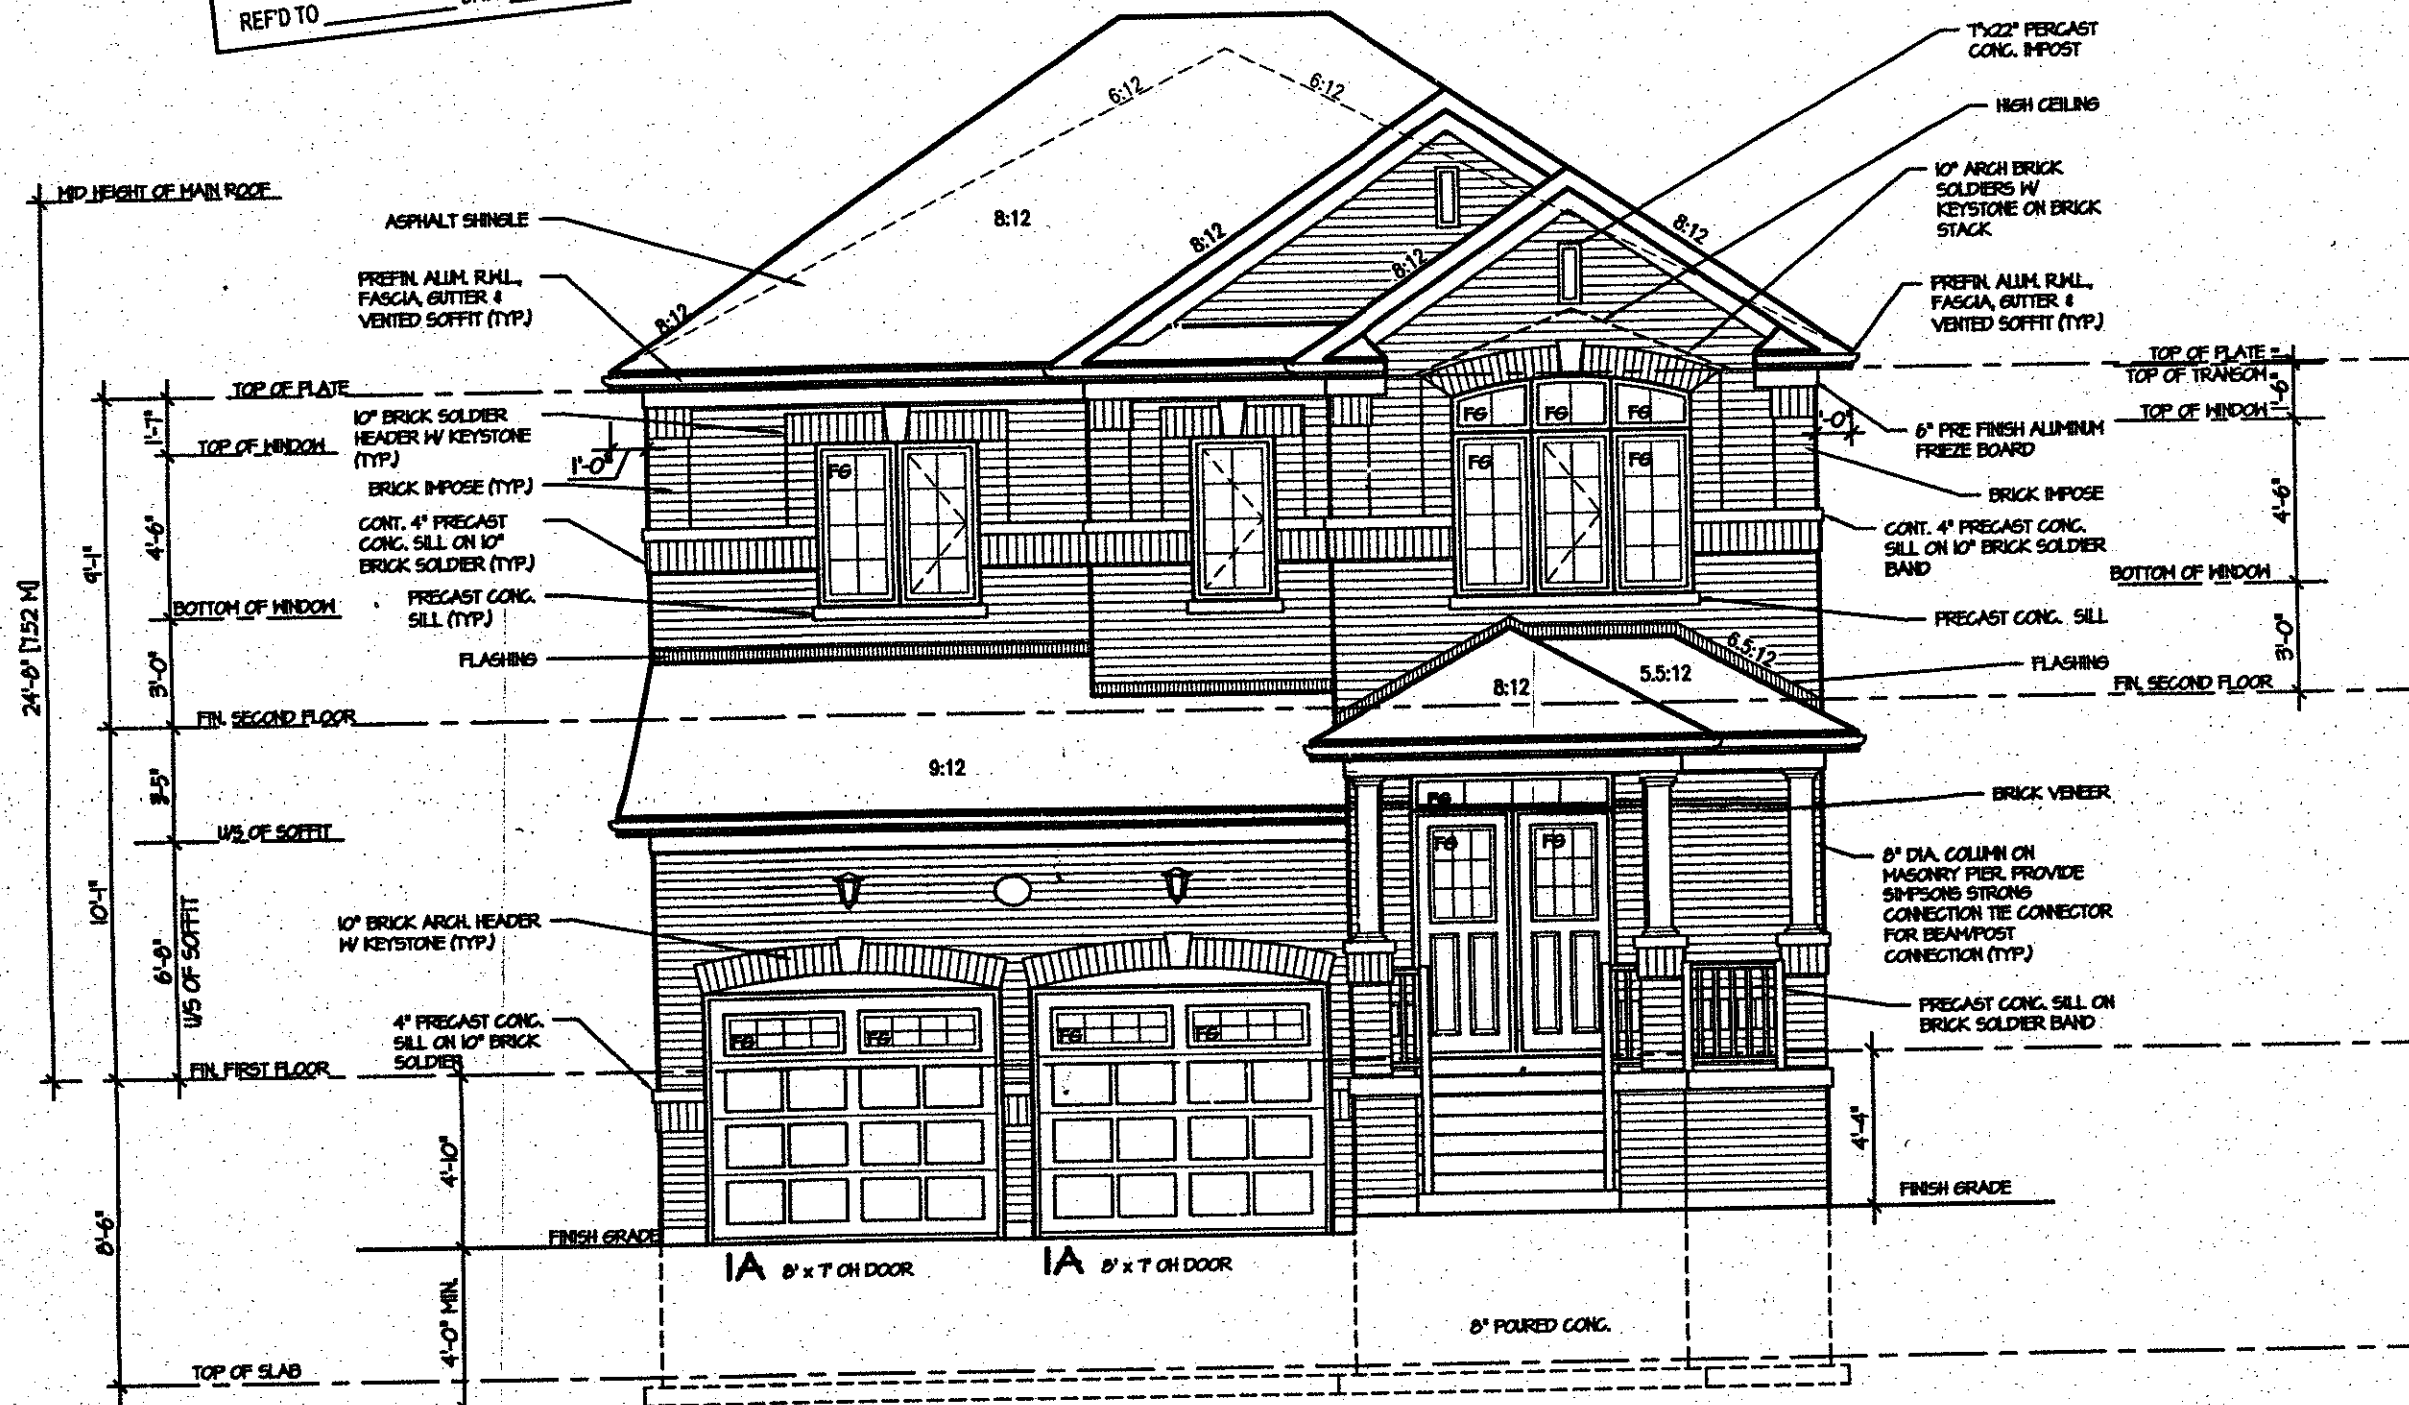

FRONT ELEVATION 1
FOR LOT 103

DROPPED FRONT GRADE CONDITION CHANGES:
- GARAGE ROOF DROPPED 1' 6"
- GARAGE ROOF SLOPE INCREASED TO 4:12

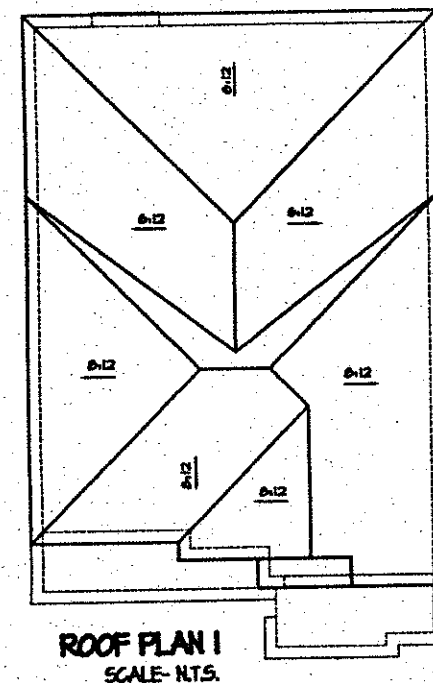

ROOF PLAN 1
SCALE- N.T.S.

CITY OF HAMILTON
Building Division
Permit No. **18-104584**
THESE STAMPED DRAWINGS SHALL BE AVAILABLE ON SITE
THE OWNER AND/OR CONTRACTOR SHALL COMPLY WITH
THE ONTARIO BUILDING CODE AND ALL OTHER APPLICABLE LAW
These drawings and/or specifications have been reviewed by
Room Clark **Mar 1/18**
FOR CHIEF BUILDING OFFICIAL DATE

It is the builder's complete responsibility to ensure that all plans submitted for approval fully comply with the Architectural Guidelines and all applicable regulations and requirements including zoning provisions and any provisions in the subdivision agreement. The Control Architect is not responsible in any way for examining or approving site (lotting) plans or working drawings with respect to any zoning or building code or permit matter or that any house can be properly built or located on its lot.
This is to certify that these plans comply with the applicable Architectural Design Guidelines approved by the City of HAMILTON.

JAN 29 2018

ROSEWOOD 1A
COMPLIANCE PACKAGE "A1"

5.			The undersigned has reviewed and takes responsibility for this design, and has the qualifications and meets the requirements set out in the Ontario Building Code to be a designer. QUALIFICATION INFORMATION Required unless design is exempt under Division C, Subsection 3.2.5 of the building code VIKAS GAJJAR NAME  SIGNATURE 28770 BCIN	REGION DESIGN INC. 8700 DUFFERIN ST. CONCORD, ONTARIO L4K 4S6 P (416) 736-4096 F (905) 860-0748	REGION DESIGN INC.	SHEET TITLE FRONT ELEVATION 1 FOR LOT 103		CONTRACTOR SHALL CHECK ALL DIMENSIONS AND ELEVATIONS BEFORE COMMENCING WITH WORK AND REPORT ANY DISCREPANCIES TO THE DESIGNER. PRINTS ARE NOT TO BE SCALED.		 Greenpark. PROJECT NAME RUSSEL GARDENS II
4.						SCALE 3/16"=1'-0"	BY ZMP	AREA 2670	PAGE No. 4A	
3.						DATE JAN 2018	TYPE	PROJECT 03-13-03		
2.	REVISED FOR LOT 103	JAN 2018								
1.	ISSUED FOR REVIEW	FEB 2017								
REVISIONS										