	CONSTRUCTION SUMMARY	RECEIVED MAY 02 2018
Mountainview Heights (G) - Russell Gardens Building Ltd.		
PURCHASERS: ZELJKO DUKIC and AJLA DUKIC		TEL: RES.: 289-828-1429

LOT / PHASE 114 / 2	REG. PLAN # 62M-1238	HOUSE TYPE Rosewood 1 Elev 3		
------------------------	-------------------------	---------------------------------	--	--

ELECTRICAL

11 - POT LIGHT - LOW VOLTAGE LED - FIRST FLOOR INSTALLATION 26Apr18 Note:	
1 - LIGHT AND SWITCH - NO FIXTURE INCLUDED - LIVING ROOM 26Apr18 Note:	
1 - PLUG - ELECTRICAL PLUG - TO BE INSTALLED OVER FIREPLACE 26Apr18 Note:	

PROMOTIONAL





1 - PARTIAL REDEMPTION OF PROMOTIONAL PACKAGE \$\$\$\$\$\$ BALANCE FORWARD TO BE USED AT A LATER DATE. ORIGINAL PROMOTIONAL PACKAGE OF \$\$\$\$\$ AS PER SCHEDULE PE DATED MMMDDYYYY. 26Apr18 Note: NEW PROMO BALANCE \$27,095.00	
--	--

EXTRAS AS PER OFFER

The Vendor agrees that notwithstanding any other term or provision in this Agreement included in the Purchase Price and in addition to those items detailed in Schedule GP to the Agreement of Purchase and Sale, the Purchaser is entitled to a credit of Ten Worksheet Note:	
The Purchaser acknowledges that the Purchase Price is inclusive of all credits and promotional packages available at the time of purchase. Worksheet Note:	

This Document is Extremely Time Sensitive - Printed 1 May 18 at 9:13

enpark
GROUP

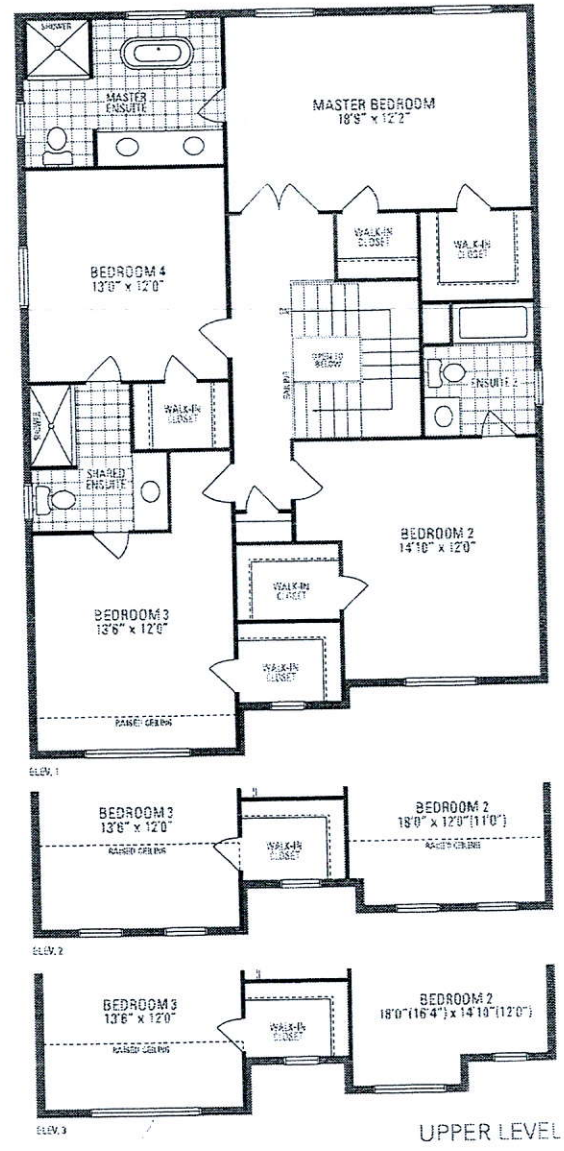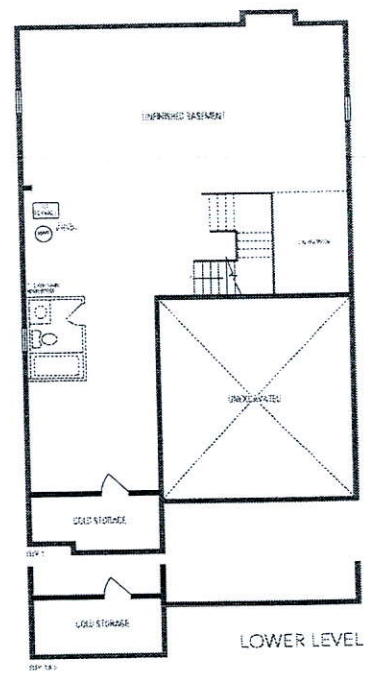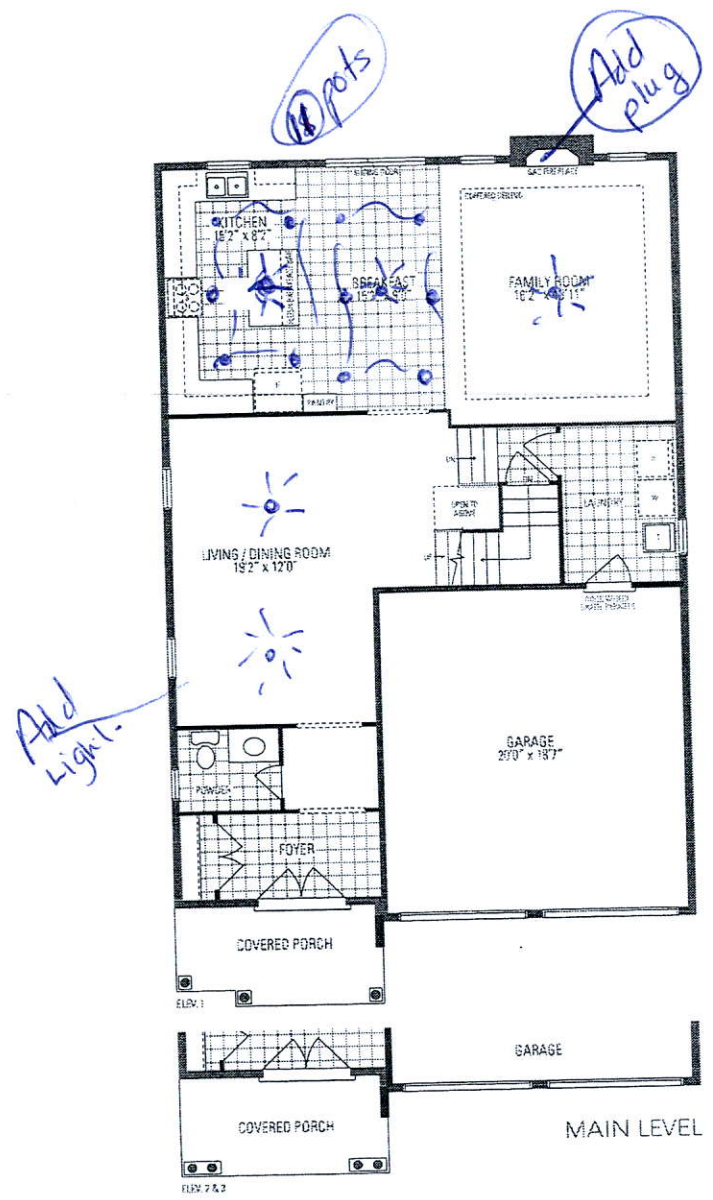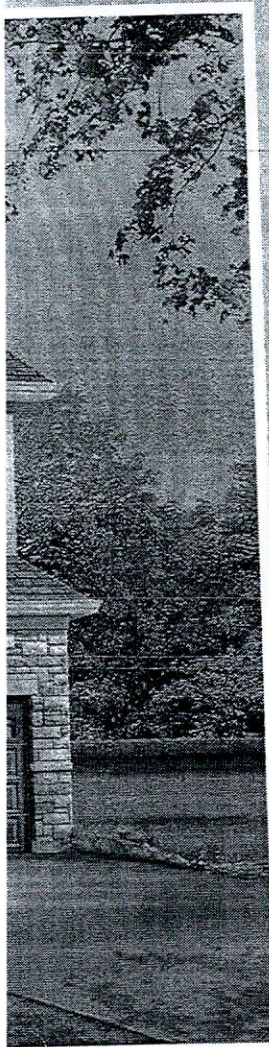

ROSEWOOD 1

2,655 sq.ft. includes 12 sq.ft. of open area

Orientation of home may be reversed and purchaser agrees to accept the same. Steps and porches may vary at any exterior entrance ways due to grading variance. Actual usable floor space may vary from this stated floor area. All renderings are artist's concept. Dimensions, specifications and architectural detailing subject to minor modifications. Final location of sump pump is based on site conditions. Roofline and adjoining model types may vary due to wiring. E & C.E. LEC Rosewood 1 • Copyright Sept. 2017