		CONSTRUCTION SUMMARY		RECEIVED MAY 02 2018	
PURCHASERS: CRAIG DOUGLAS WHITMORE and NICHOLE DEBORAH WHITMORE		Mountainview Heights (G) - Russell Gardens Building Ltd.		TEL: RES.: 905-978-7767	
LOT / PHASE	REG. PLAN #	HOUSE TYPE			
117 / 2	62M-1238	Rosewood 2 Elev 1			

ELECTRICAL

1 - LIGHT - EXTERIOR WITH INTERIOR SWITCH 01May18 Note: add in porch ceiling	
4 - POT LIGHT - EXTERIOR - SOFFIT MOUNT - REGULAR VOLTAGE 01May18 Note:	
1 - PLUG - ELECTRICAL PLUG - TO BE INSTALLED OVER FIREPLACE 01May18 Note:	
1 - 200 AMP ELECTRICAL SERVICE 01May18 Note:	
4 - PLUG - ELECTRICAL PLUG 01May18 Note: ON KITCHEN ISLAND,x2 one on each side IN MASTER ENSUITE VANITY AND BD2/3 VANITY SEE SKETCH	
1 - PLUG - ELECTRICAL PLUG WITH GFI AND SWITCH - FOR FESTIVE LIGHTING 01May18 Note:	
1 - RELOCATE STANDARD KITCHEN LIGHT TO BE CENTERED OVER ISLAND 01May18 Note:	

MIRRORS AND GLASS

1 - FRAMELESS GLASS SHOWER ENCLOSURE 01May18 Note: IN MASTER ENSUITE SHOWER	
--	--

PLUMBING

1 - MOVE TUB TO BEDROOM 2/3 ENSUITE AND ADD 5FT SHOWER TO BED 4 ENSUITE- 01May18 Note:	
---	--

PROMOTIONAL



1 - PARTIAL REDEMPTION OF PROMOTIONAL PACKAGE \$\$\$\$\$\$ BALANCE FORWARD TO BE USED AT A LATER DATE. ORIGINAL PROMOTIONAL PACKAGE OF \$\$\$\$ AS PER SCHEDULE PE DATED MMMDDYYYY. 01May18 Note: NEW PROMO BALANCE \$3725.00	
---	--

EXTRAS AS PER OFFER

The Vendor agrees that notwithstanding any other term or provision in this Agreement included in the Purchase Price and in addition to those items detailed in Schedule GP to the Agreement of Purchase and Sale, the Purchaser is entitled to a credit of Ten Worksheet Note:	
The Purchaser acknowledges that the Purchase Price is inclusive of all credits and promotional packages available at the time of purchase. Worksheet Note:	

This Document is Extremely Time Sensitive - Printed 1 May 18 at 10:12



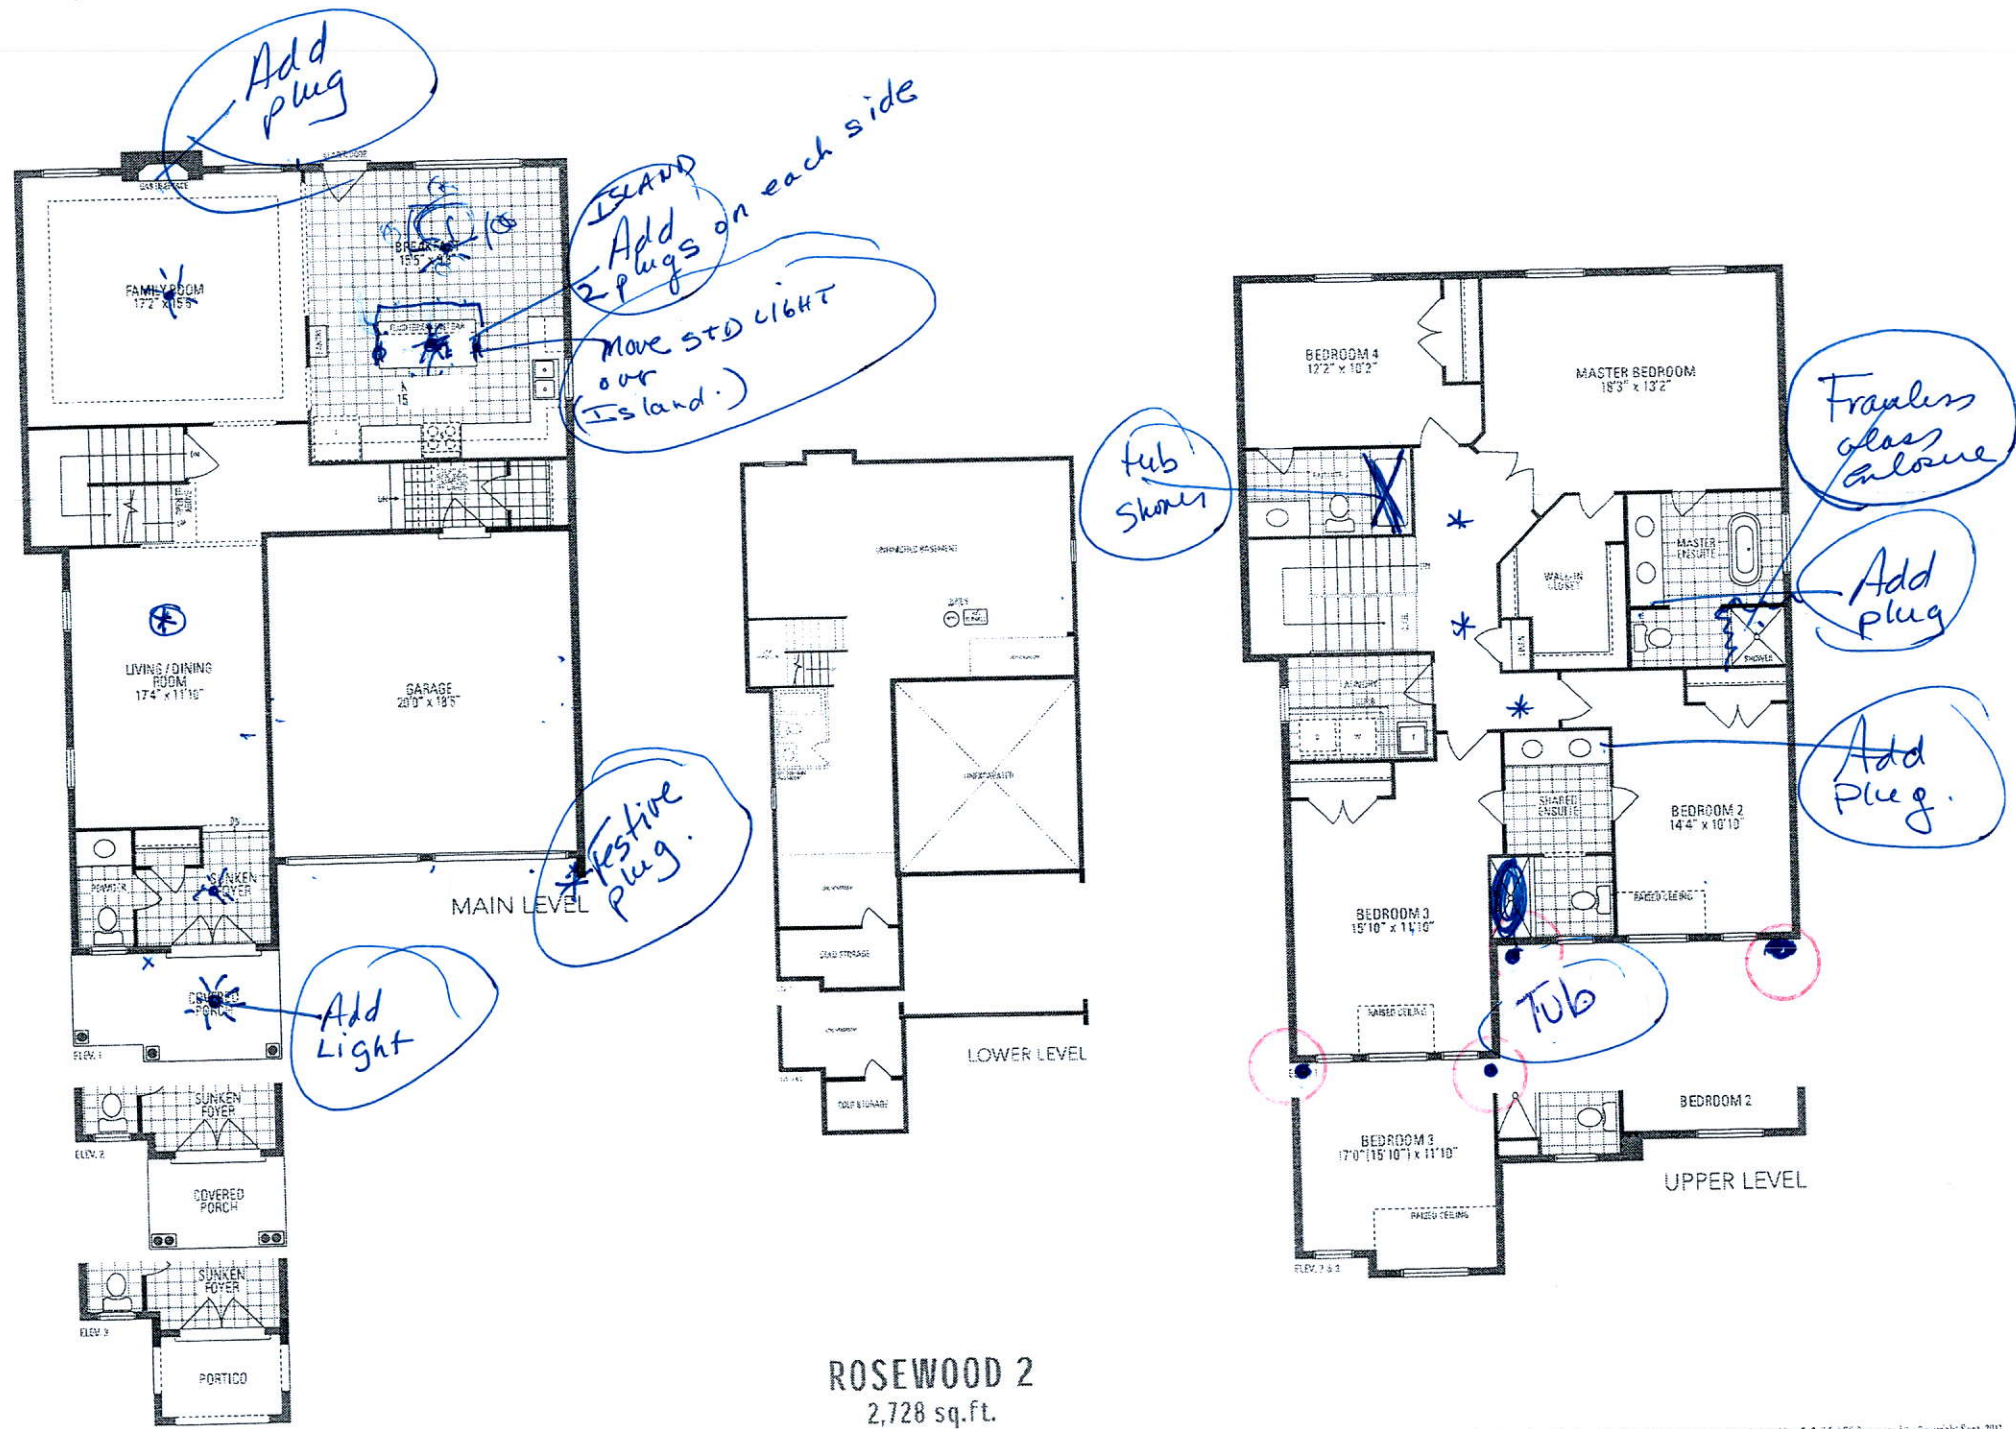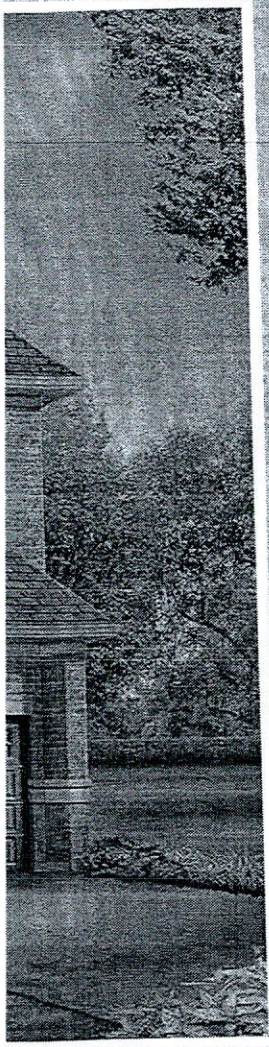

Orientation of home may be reversed and purchaser agrees to accept the same. Steps and porches may vary at any exterior entrance ways due to grading variance. Actual usable floor space may vary from the stated floor area. All renderings are artist's concept. Dimensions, specifications and architectural detailing subject to minor modifications. First location of sump pump is based on site conditions. Reworking and adjoining unit types may vary due to wiring. E. & J.E. L.P.C. Rosewood 2 - Copyright Sept. 2012