	CONSTRUCTION SUMMARY	RECEIVED MAY 0 4 2018
Mountainview Heights (G) - Russell Gardens Building Ltd.		
PURCHASERS: Michael ZELENKA and Carmela ZELENKA		TEL: RES.: 416-857-2957

LOT / PHASE	REG. PLAN #	HOUSE TYPE		
149 / 2	62M-1238	Rosewood 1 Elev 1		

CONSTRUCTION

1 - MASTER ENSUITE- ADD A STANDARDTILED SHOWER NICHE -14X20 -- IF CONSTRUCTION PERMITS 01May18 Note:	
---	--

ELECTRICAL

1 - 200 AMP ELECTRICAL SERVICE 01May18 Note:	
2 - POT LIGHT - EXTERIOR - SOFFIT MOUNT - REGULAR VOLTAGE 01May18 Note:	
1 - PLUG - ELECTRICAL PLUG - TO BE INSTALLED OVER FIREPLACE 01May18 Note:	
1 - LIGHT AND SWITCH - NO FIXTURE INCLUDED 01May18 Note: ADD OVER ISLAND-	

MIRRORS AND GLASS

1 - FRAMELESS GLASS SHOWER ENCLOSURE 01May18 Note: IN MASTER ENSUITE SHOWER	
--	--


PROMOTIONAL

1 - PARTIAL REDEMPTION OF PROMOTIONAL PACKAGE \$\$\$\$\$\$ BALANCE FORWARD TO BE USED AT A LATER DATE. ORIGINAL PROMOTIONAL PACKAGE OF \$\$\$\$ AS PER SCHEDULE PE DATED MMMDDYYYY. 01May18 Note: NEW PROMO BALANCE \$22,790.00	
--	--

EXTRAS AS PER OFFER

The Vendor agrees that notwithstanding any other term or provision in this Agreement included in the Purchase Price and in addition to those items detailed in Schedule GP to the Agreement of Purchase and Sale, the Purchaser is entitled to a credit of Ten Worksheet Note:	
The Purchaser acknowledges that the Purchase Price is inclusive of all credits and promotional packages available at the time of purchase. Worksheet Note:	

This Document is Extremely Time Sensitive - Printed 1 May 18 at 16:18



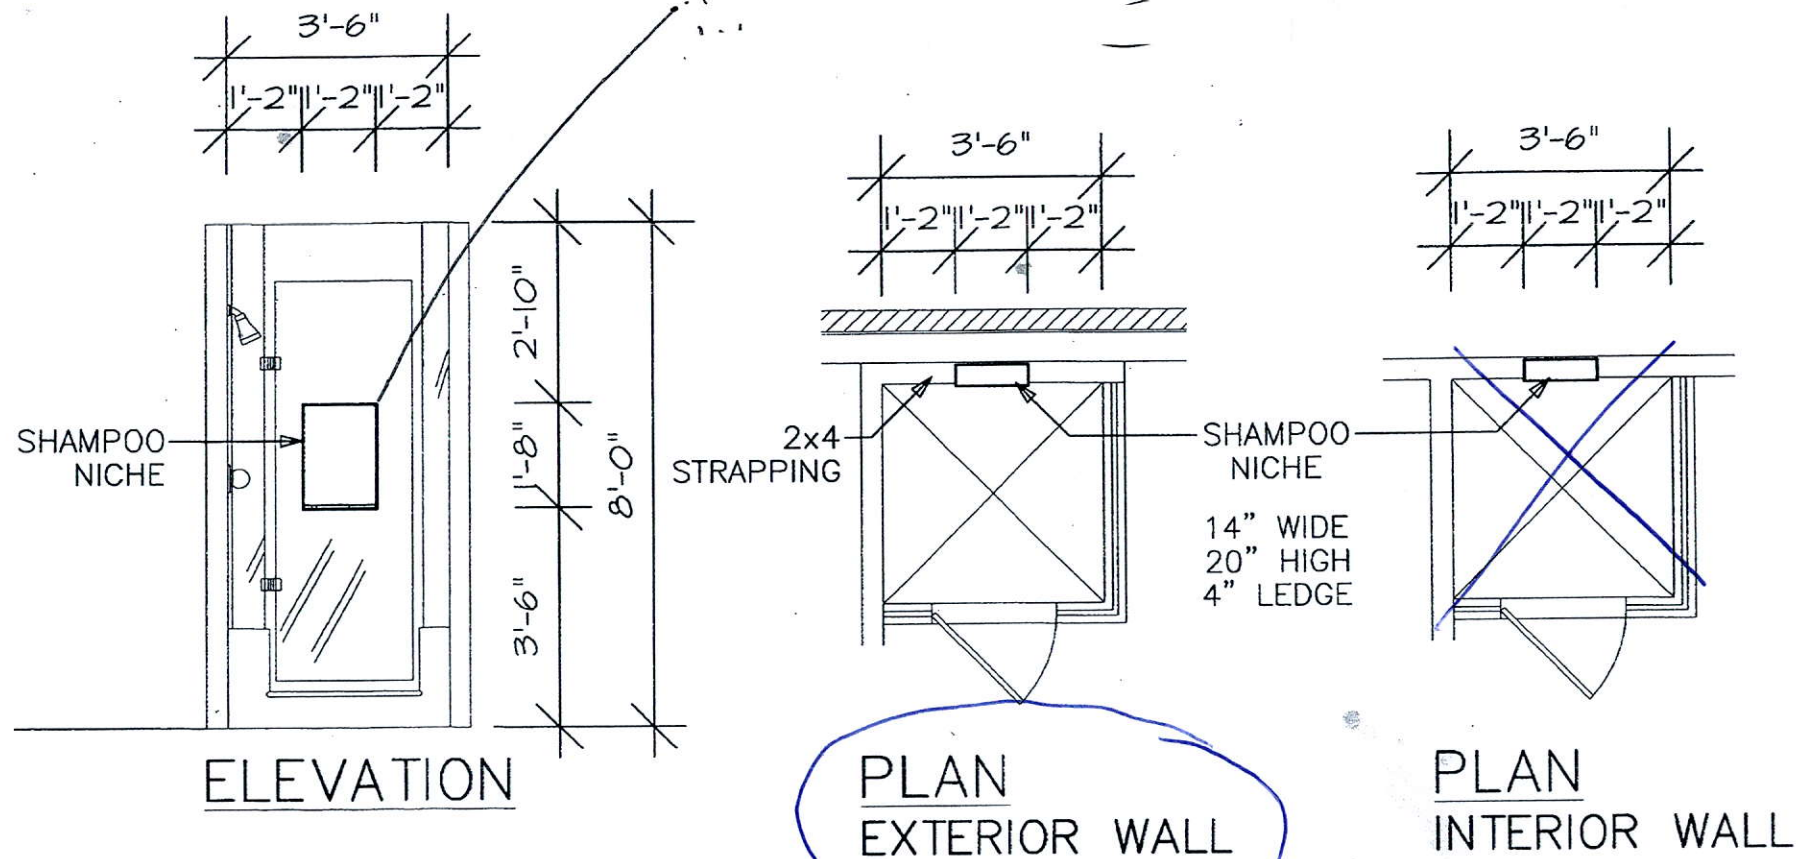


SHAMPOO NICHE (TYPICAL)

(NOTE: SHOWER STALL MAY VARY BY MODEL)



Lot. 149
Russell-
Gardens-

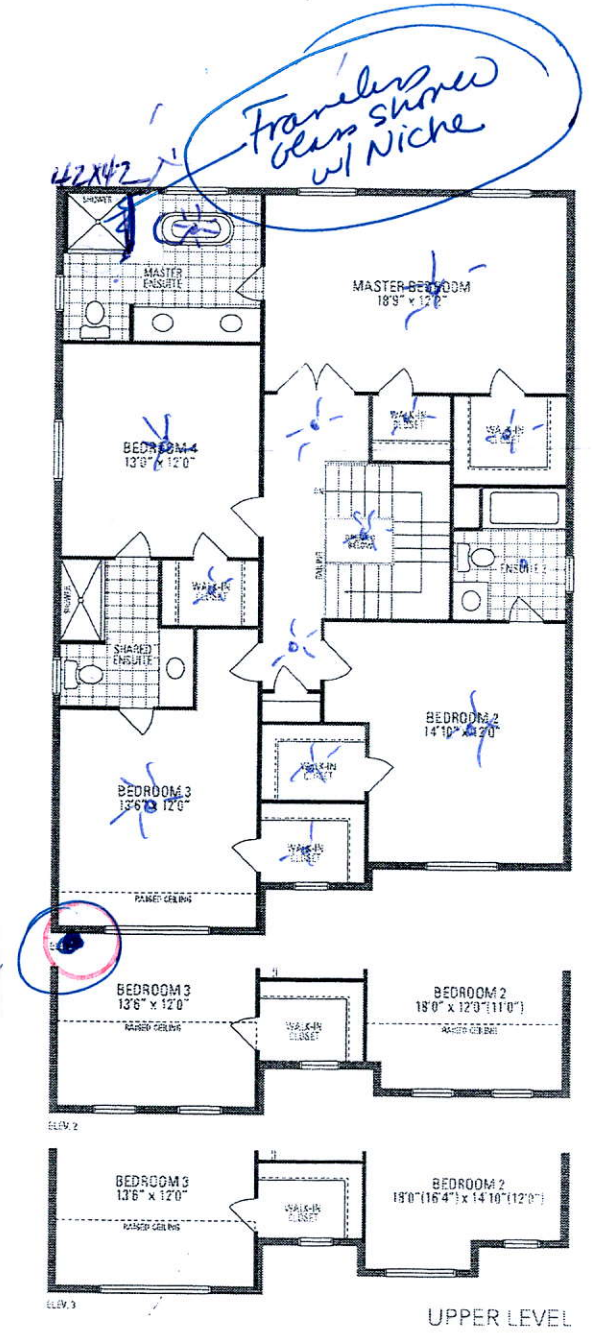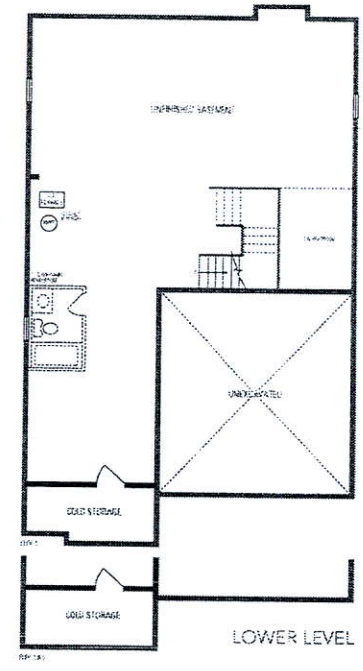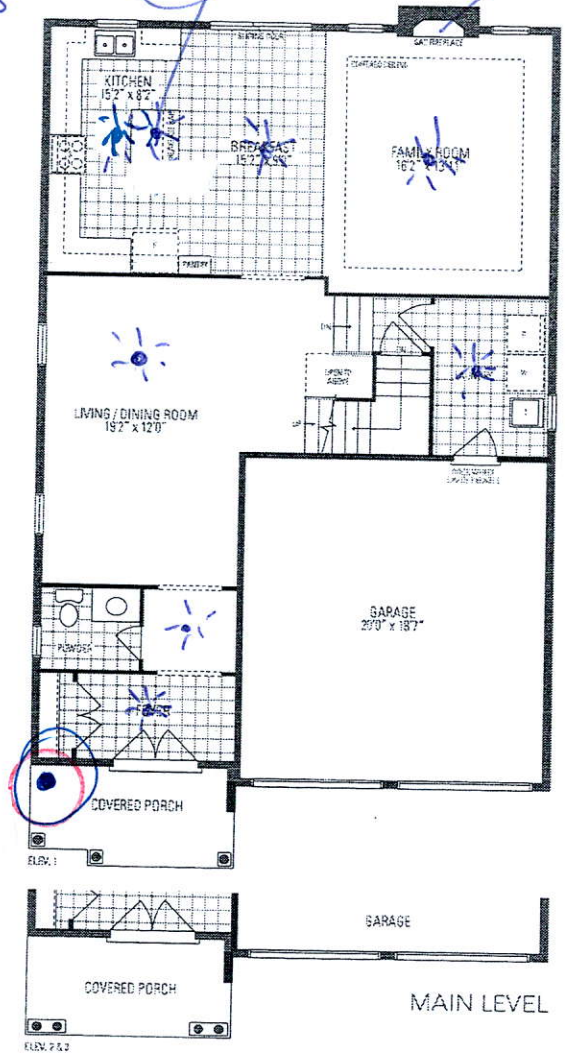

ROSEWOOD 1
2,655 sq.ft. includes 12 sq.ft. of open area

Orientation of home may be reversed and purchaser agrees to accept the same. Colors and finishes may vary at any exterior entrance ways due to grading variations. Actual usable floor space may vary from the stated floor area. All renderings are artist's concept. Dimensions, specifications and architectural detailing subject to minor modifications. Final location of sump pump is based on site conditions. Roofline and adjoining material types may vary due to pricing. F. & C.E. LFC Rosewood 1 - Copyright Sept. 2017