



CONSTRUCTION SUMMARY

Mountainview Heights (G) - Russell Gardens Building Ltd.

PURCHASERS: JONATHAN A DOS SANTOS BOZA and PENA LUGO KRISNEYRIS MILA

TEL: RES.: 647-923-6100

LOT / PHASE 165 / 2	REG. PLAN # 62M-1238	HOUSE TYPE Rosewood 3 Elev 1		
------------------------	-------------------------	---------------------------------	--	--

ELECTRICAL

1 - RELOCATE STANDARD KITCHEN LIGHT TO BE CENTERED OVER ISLAND 24Apr18 Note:	
30 - POT LIGHT - LOW VOLTAGE LED - FIRST FLOOR INSTALLATION 24Apr18 Note:	
1 - PLUG - ELECTRICAL PLUG - TO BE INSTALLED OVER FIREPLACE 24Apr18 Note:	
1 - 200 AMP ELECTRICAL SERVICE 24Apr18 Note:	

MIRRORS AND GLASS

1 - FRAMELESS GLASS SHOWER ENCLOSURE 24Apr18 Note: IN MASTER ENSUITE SHOWER	
---	--

PROMOTIONAL

1 - PARTIAL REDEMPTION OF PROMOTIONAL PACKAGE \$\$\$\$\$\$ BALANCE FORWARD TO BE USED AT A LATER DATE. ORIGINAL PROMOTIONAL PACKAGE OF \$\$\$\$\$ AS PER SCHEDULE PE DATED MMMDDYYYY. 24Apr18 Note: COMPLETE -	
---	--

EXTRAS AS PER OFFER

The Vendor agrees that notwithstanding any other term or provision in this Agreement included in the Purchase Price and in addition to those items detailed in Schedule GP to the Agreement of Purchase and Sale, the Purchaser is entitled to a credit of Ten Worksheet Note:	
The Purchaser acknowledges that the Purchase Price is inclusive of all credits and promotional packages available at the time of purchase. Worksheet Note:	


This Document is Extremely Time Sensitive - Printed 24 Apr 18 at 9:31

electrician, plumber,  
Construction.




RECEIVED MAY 04 2018



enpark GROUP

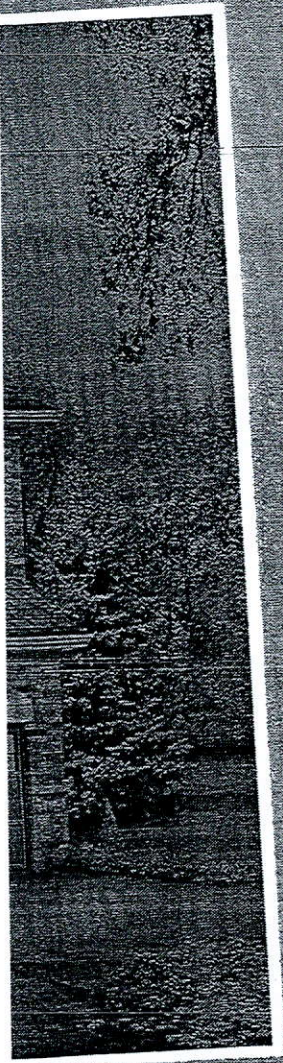

Lot 165  
Russell Gardens

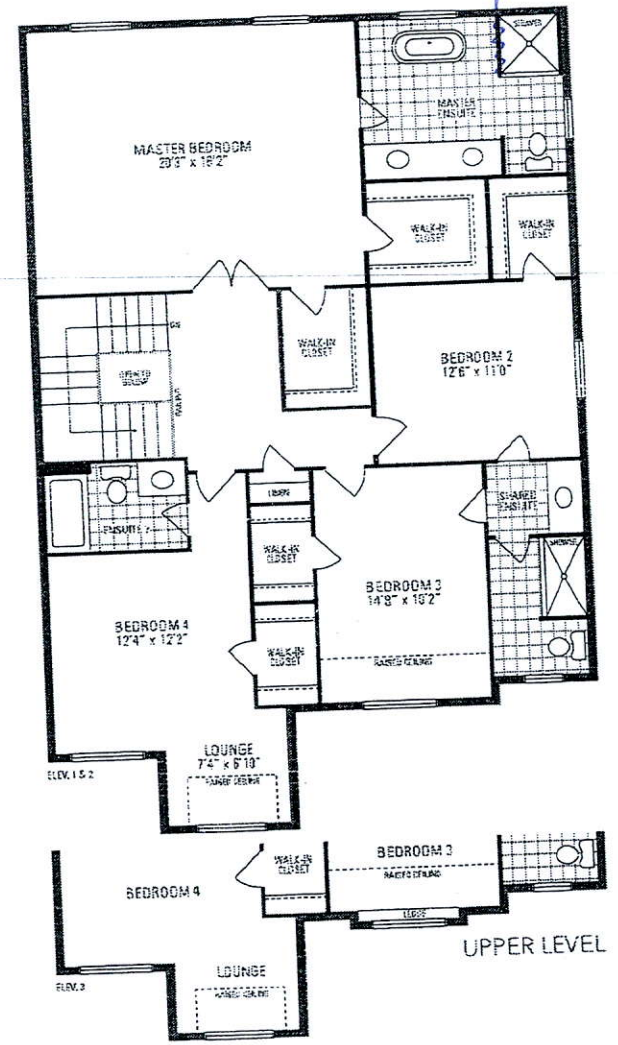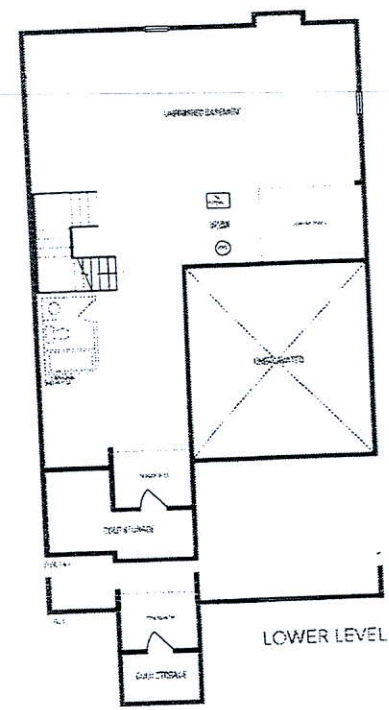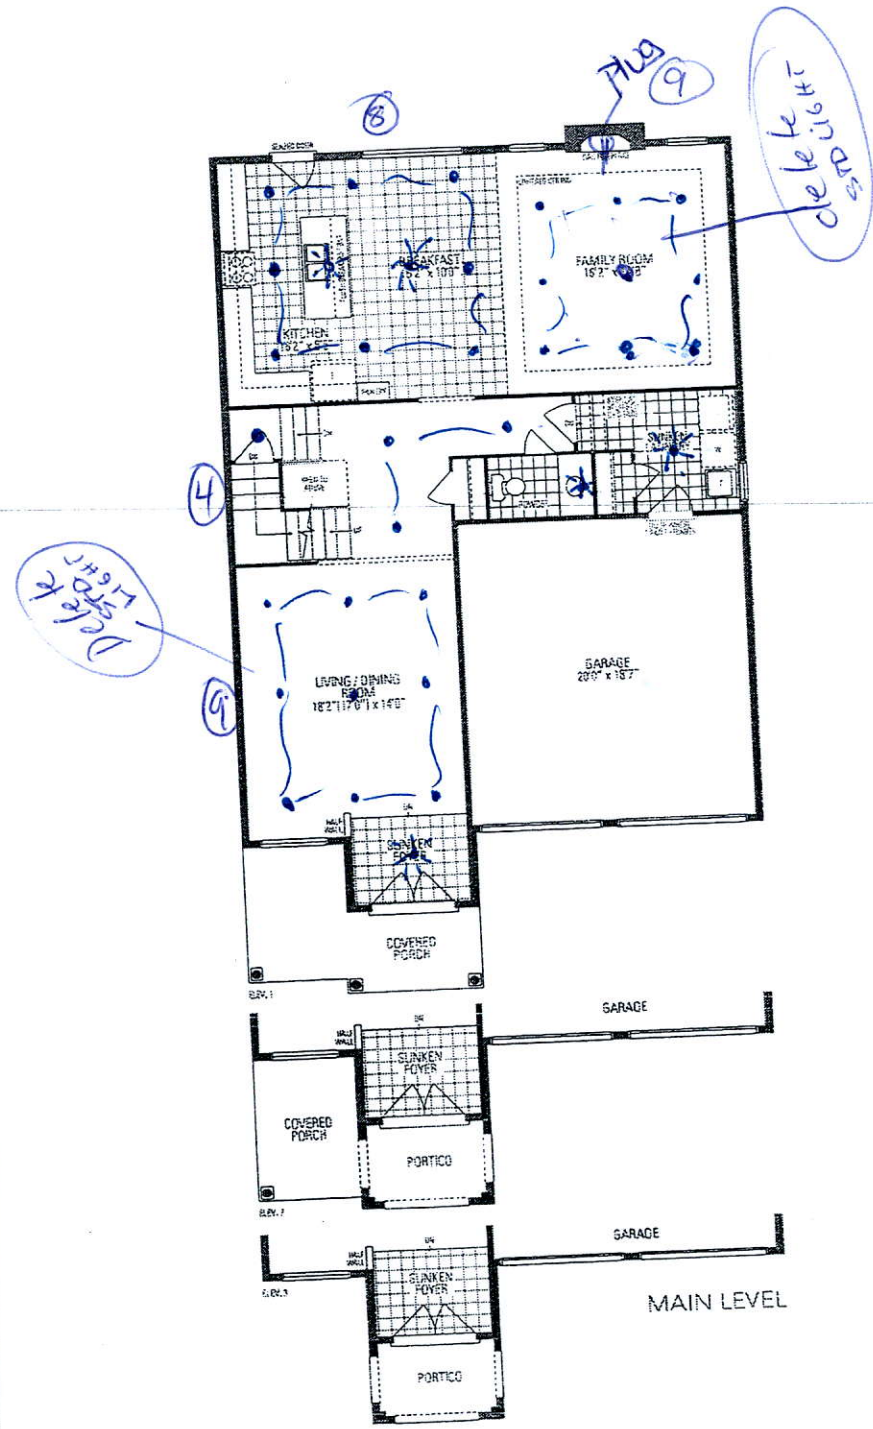

Frameless glass shower

**ROSEWOOD 3**  
2,870 sq.ft. includes 12 sq.ft. of open area

Orientation of home may be reviewed and purchaser agrees to accept the same. Steps and porches may vary at site; exterior entrance ways due to grading variance. Actual usable floor space may vary from the stated floor area. All renderings are artist's concept. Dimensions, specifications and architectural detailing subject to minor modifications. Final location of sump pump is based on site conditions. Roseline and adjoining mental types may vary due to zoning. E. & U.E. LFC Rosewood 3 - Copyright Sept L 2017