



CONSTRUCTION SUMMARY

Mountainview Heights (G) - Russell Gardens Building Ltd.

RECEIVED MAY 08 2018

PURCHASER: MOHAMMED GHUFRAN AHMED

TEL:

LOT / PHASE 166 / 2	REG. PLAN # 62M-1238	HOUSE TYPE Rosewood 7 Elev 3		
------------------------	-------------------------	---------------------------------	--	--

ELECTRICAL

1 - PLUG - ELECTRICAL PLUG WITH GFI AND SWITCH - FOR FESTIVE LIGHTING 25Apr18 Note:	
1 - PLUG - ELECTRICAL PLUG - TO BE INSTALLED OVER FIREPLACE 25Apr18 Note: IN FAMILY ROOM-	
1 - LIGHT AND SWITCH - NO FIXTURE INCLUDED - LIVING ROOM 25Apr18 Note:	
1 - 200 AMP ELECTRICAL SERVICE 25Apr18 Note:	

PLUMBING

1 - TOE TESTER - ADD TOE TESTER TO SHOWER 25Apr18 Note: IN MASTER ENSUITE SHOWER-	
--	--

PROMOTIONAL

1 - PARTIAL REDEMPTION OF PROMOTIONAL PACKAGE \$\$\$\$\$\$ BALANCE FORWARD TO BE USED AT A LATER DATE. ORIGINAL PROMOTIONAL PACKAGE OF \$\$\$\$\$ AS PER SCHEDULE PE DATED MMMDDYYYY. 25Apr18 Note: NEW PROMO BALANCE \$8380.00	
--	--



EXTRAS AS PER OFFER

The Vendor agrees that notwithstanding any other term or provision in this Agreement included in the Purchase Price and in addition to those items detailed in Schedule GP to the Agreement of Purchase and Sale, the Purchaser is entitled to a credit of Ten Worksheet Note:	
The Purchaser acknowledges that the Purchase Price is inclusive of all credits and promotional packages available at the time of purchase. Worksheet Note:	



This Document is Extremely Time Sensitive - Printed 25 Apr 18 at 11:03



enpark  
GROUP

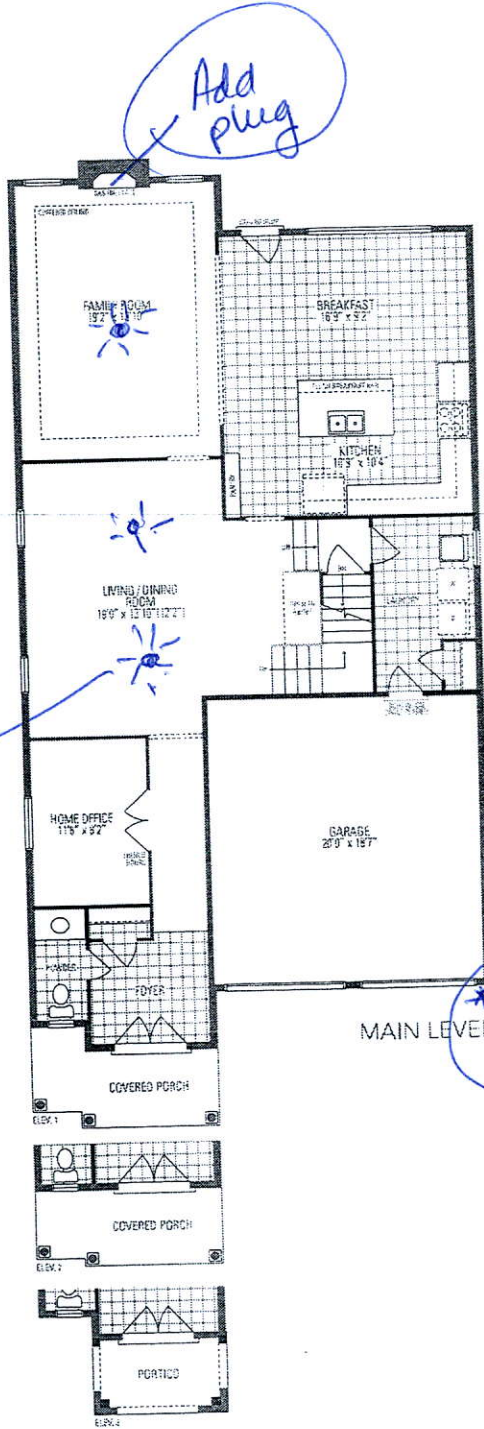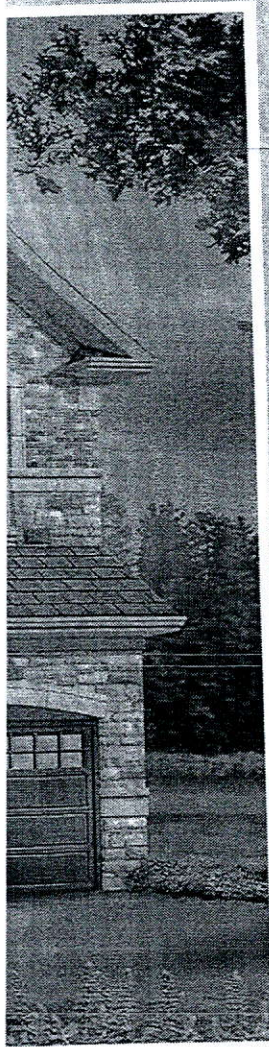

200 AMP

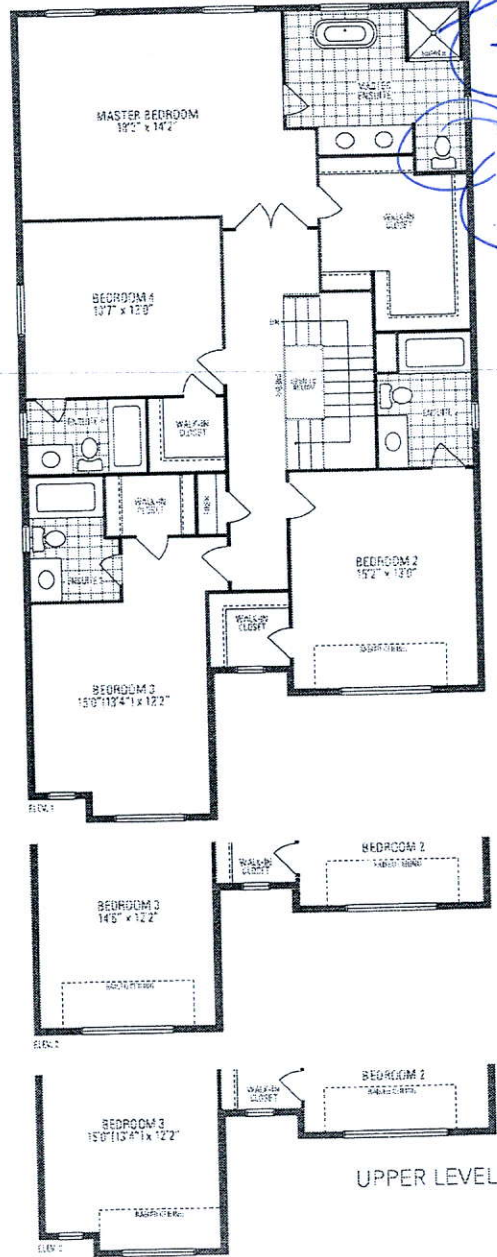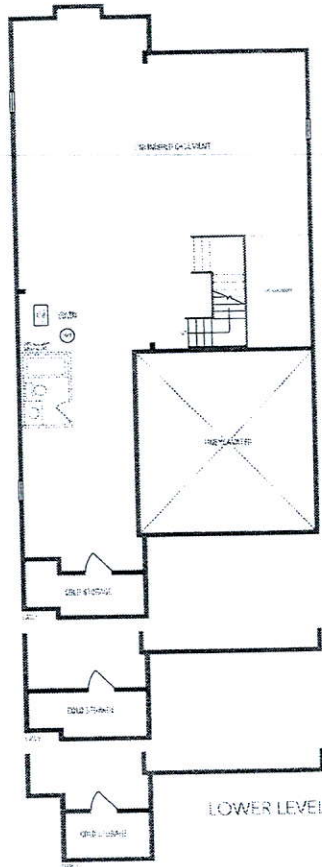

ROSEWOOD 7

3,205 sq.ft. includes 12 sq.ft. of open area

Orientation of home may be revised and purchaser agrees to accept the same. Steps and porches may vary at any exterior entrance ways due to grading variance. Actual usable floor space may vary from the stated floor area. All renderings are artist's concept. Dimensions, specifications and architectural detailing subject to minor modifications. Final location of pump pump is based on site conditions. Roughline and adjoining model types may vary due to siting. E. & J.E. LLC Rosewood 7 - Copyright Sept. 2012