



CONSTRUCTION SUMMARY

Mountainview Heights (G) - Russell Gardens Building Ltd.

RECEIVED APR 26 2018

PURCHASERS: Musahib M. BOMBAYWALA and Shabnam BOMBAYWALA

TEL: RES.: 416-464-0206

LOT / PHASE 89 / 2	REG. PLAN # 62M-1238	HOUSE TYPE Rosewood 11 Elev 2		
-----------------------	-------------------------	----------------------------------	--	--

ELECTRICAL

10 - POT LIGHT - EXTERIOR - SOFFIT MOUNT - REGULAR VOLTAGE 25Apr18 Note:	
1 - LIGHT AND SWITCH - NO FIXTURE INCLUDED - LIVING ROOM 25Apr18 Note:	
1 - PLUG - ELECTRICAL PLUG - TO BE INSTALLED OVER FIREPLACE 25Apr18 Note:	
1 - 200 AMP ELECTRICAL SERVICE 25Apr18 Note:	

MIRRORS AND GLASS

1 - FRAMELESS GLASS SHOWER ENCLOSURE 25Apr18 Note: ADD HALF WALL ON CABINET SIDE WITH UPPER IN FRAMELESS GLASS MASTER ENSUITE	
---	--

PLUMBING

1 - 5 FOOT SHOWER WITH SLIDING GLASS CHROME DOORS IN LIEU OF TUB 25Apr18 Note: IN BED 4 ENSUITE	
--	--

PROMOTIONAL



1 - LESS CREDIT FROM PURCHASER EXTRA SHEET IN OFFER 25Apr18 Note: NEW PROMO BALANCE \$860.00	
---	--

EXTRAS AS PER OFFER


The Vendor agrees that notwithstanding any other term or provision in this Agreement included in the Purchase Price and in addition to those items detailed in Schedule GP to the Agreement of Purchase and Sale, the Purchaser is entitled to a credit of Ten Worksheet Note:	
The Purchaser acknowledges that the Purchase Price is inclusive of all credits and promotional packages available at the time of purchase. Worksheet Note:	

This Document is Extremely Time Sensitive - Printed 26 Apr 18 at 14:33

rk
UP™

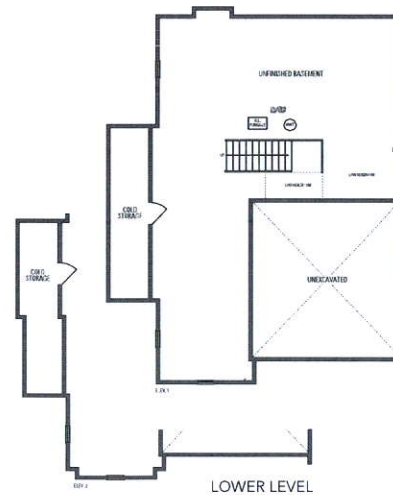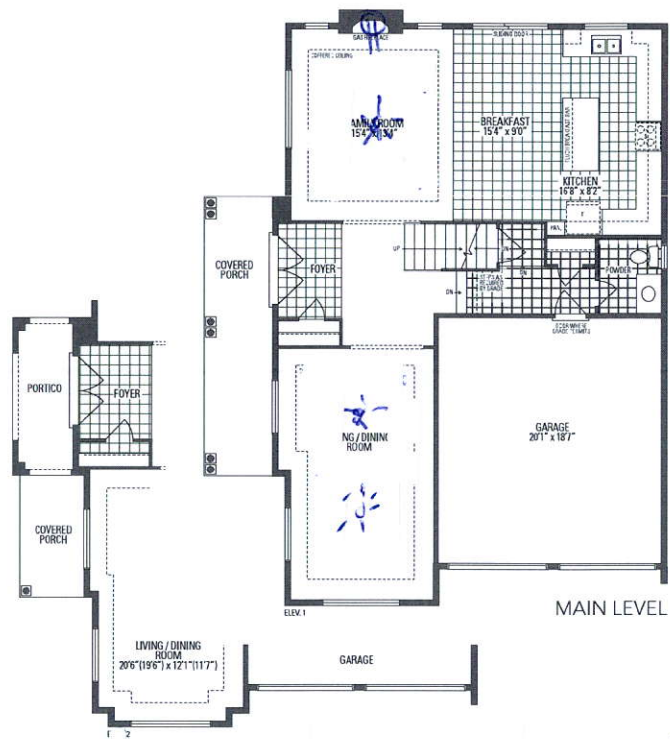

Shower
in lieu of
Tub

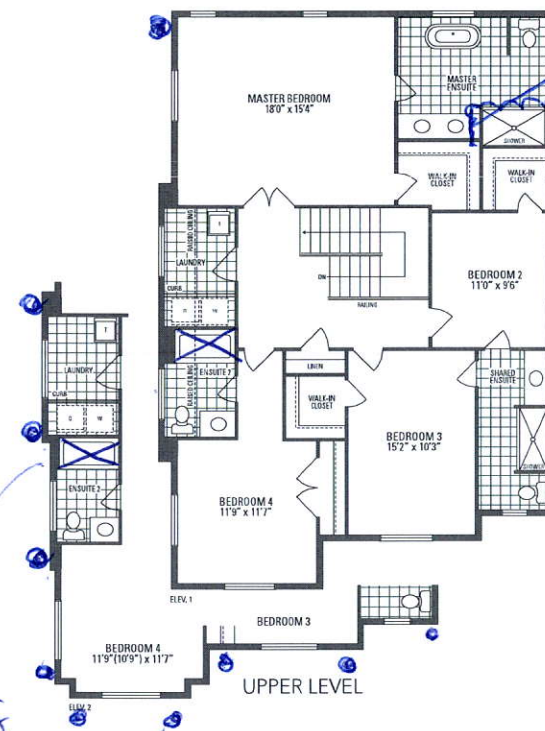

half wall
framed
glass
shower