

CONSTRUCTION SUMMARY

Mountainview Heights (G) - Russell Gardens Building Ltd.

PURCHASERS: ZELJKO DUKIC and AJLA DUKIC

TEL: RES.: 289-828-1429

LOT / PHASE 114 / 2	REG. PLAN # 62M-1238	HOUSE TYPE Rosewood 1 Elev 3		
------------------------	-------------------------	---------------------------------	--	--

ELECTRICAL

11 - POT LIGHT - LOW VOLTAGE LED - FIRST FLOOR INSTALLATION 26Apr18 Note:	
1 - LIGHT AND SWITCH - NO FIXTURE INCLUDED - LIVING ROOM 26Apr18 Note:	
1 - PLUG - ELECTRICAL PLUG - TO BE INSTALLED OVER FIREPLACE 26Apr18 Note:	

MIRRORS AND GLASS

RECEIVED JUN 07 2018

1 - FRAMELESS GLASS SHOWER ENCLOSURE 05Jun18 Note: MASTER ENSUITE BATHROOM - CHROME KNOB AND HINGES	NEW
---	-----

PROMOTIONAL




1 - PARTIAL REDEMPTION OF PROMOTIONAL PACKAGE \$24,095.00 BALANCE FORWARD TO BE USED AT A LATER DATE. ORIGINAL PROMOTIONAL PACKAGE OF \$30,000.00 AS PER SCHEDULE PE 05Jun18 Note:	
1 - PARTIAL REDEMPTION OF PROMOTIONAL PACKAGE \$\$\$\$\$\$ BALANCE FORWARD TO BE USED AT A LATER DATE. ORIGINAL PROMOTIONAL PACKAGE OF \$\$\$\$\$\$ AS PER SCHEDULE PE DATED MMMDDYYYY. 26Apr18 Note: NEW PROMO BALANCE \$27,095.00	

EXTRAS AS PER OFFER


The Vendor agrees that notwithstanding any other term or provision in this Agreement included in the Purchase Price and in addition to those items detailed in Schedule GP to the Agreement of Purchase and Sale, the Purchaser is entitled to a credit of Ten Worksheet Note:	
The Purchaser acknowledges that the Purchase Price is inclusive of all credits and promotional packages available at the time of purchase. Worksheet Note:	

This Document is Extremely Time Sensitive - Printed 7 Jun 18 at 13:48

enpark
GROUP

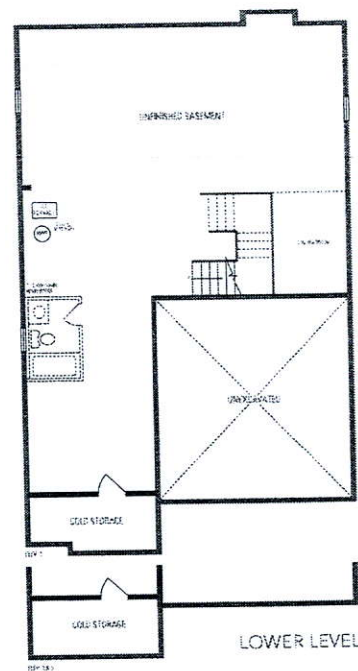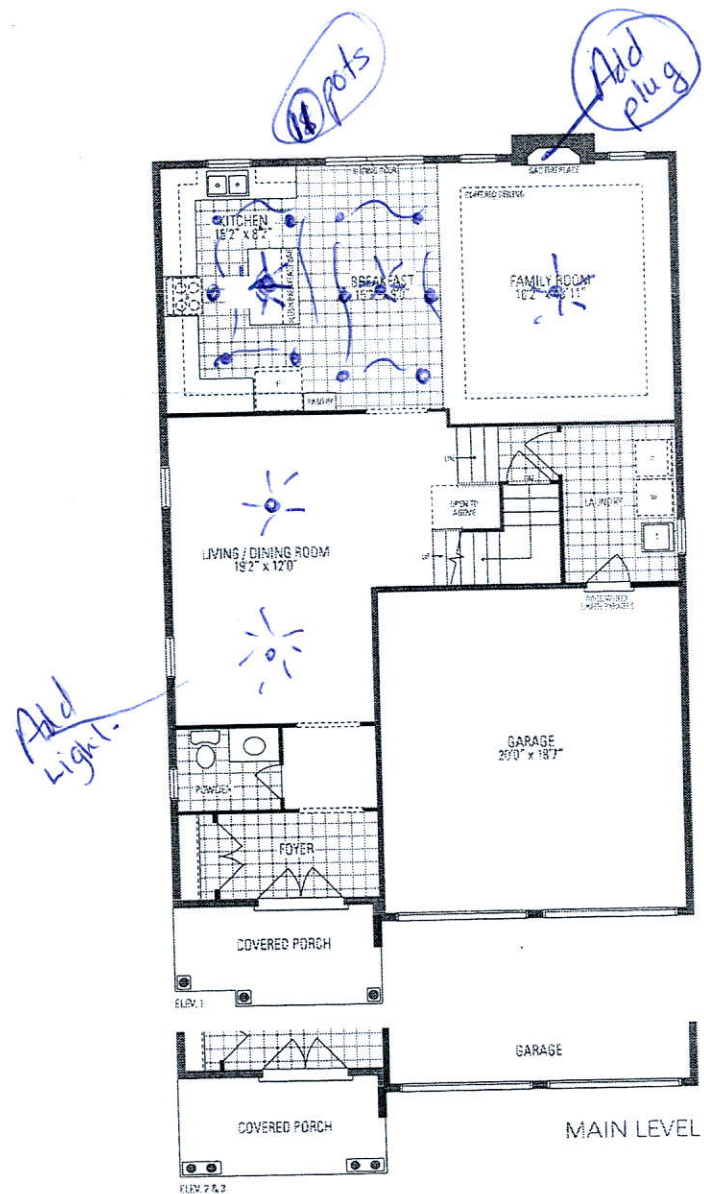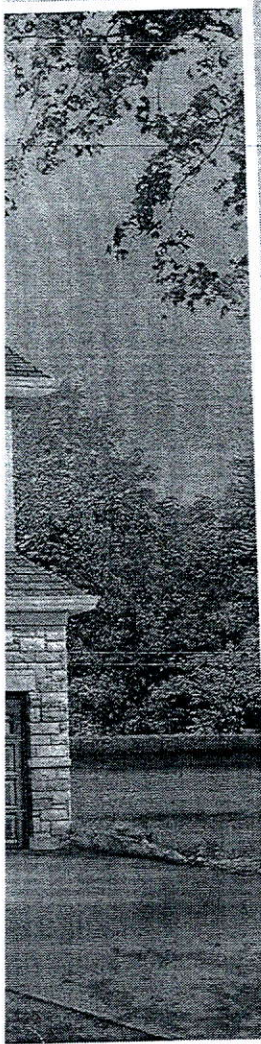

Frameless Glass Enclosure
Delete Wall

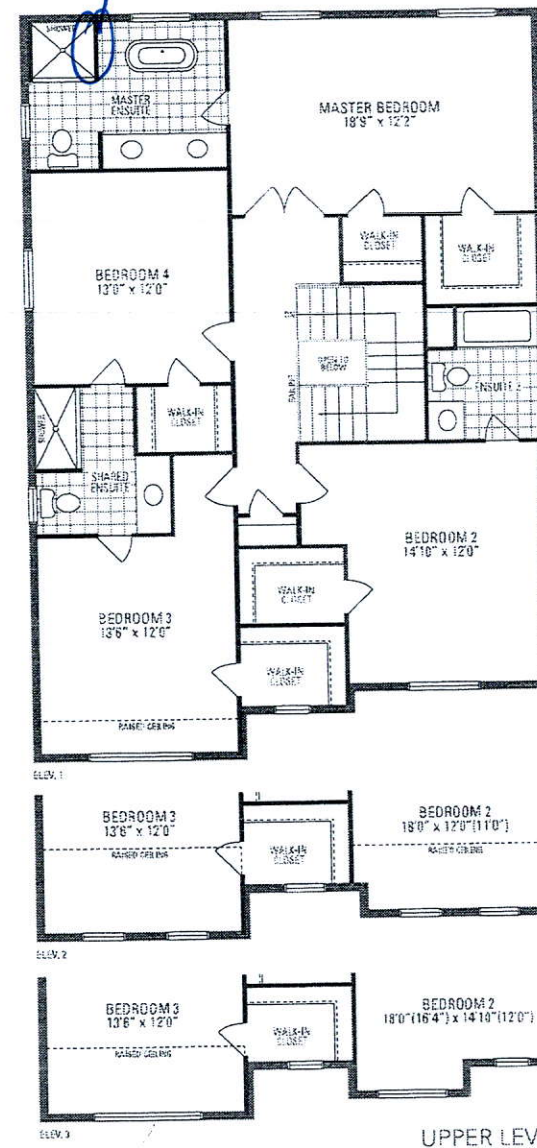

ROSEWOOD 1

2,655 sq.ft. includes 12 sq.ft. of open area

Orientation of house may be reversed and purchaser agrees to accept the same. Steps and porches may vary at any exterior entrance ways due to grading variance. Actual usable floor space may vary from the stated floor area. All renderings are artist's concept. Dimensions, specifications and architectural detailing subject to minor modifications. Final location of sump pump is based on site conditions. Roofline and adjoining mental types may vary due to using E. & D.E. I.E.C. Rosewood 1 • Copyright Sept. 1917