	<b>CONSTRUCTION SUMMARY</b>	<b>RECEIVED MAY 23 2018</b>
<b>Mountainview Heights (G) - Russell Gardens Building Ltd.</b>		
<b>PURCHASERS: MANJYOT SINGH CHANA and AMANDEEP SIDHU</b>		<b>TEL: RES.: 647-278-5254</b>

LOT / PHASE Block 214 TH 1 / 2	REG. PLAN # 62M-1238	HOUSE TYPE Dewberry 2E Elev 2		
-----------------------------------	-------------------------	----------------------------------	--	--

ELECTRICAL

2 - PLUG - ELECTRICAL PLUG 17May18 Note: LIVING/DINING ROOM & GREAT ROOM - INSTALLED 5' FROM FLOOR	
1 - RELOCATE STANDARD KITCHEN LIGHT TO BE CENTERED OVER ISLAND 17May18 Note:	

PLUMBING

1 - WATER LINE FOR FRIDGE - ROUGH-IN ONLY 17May18 Note:	
------------------------------------------------------------	--

PROMOTIONAL

1 - PARTIAL REDEMPTION OF PROMOTIONAL PACKAGE \$16,855.00 BALANCE FORWARD TO BE USED AT A LATER DATE. ORIGINAL PROMOTIONAL PACKAGE OF \$17,500.00 AS PER SCHEDULE PE 17May18 Note:	
---------------------------------------------------------------------------------------------------------------------------------------------------------------------------------------	--



EXTRAS AS PER OFFER

Five (5) White Appliances as per PE Appliances Worksheet Note:	
The Vendor agrees that notwithstanding any other term or provision in this Agreement included in the Purchase Price and in addition to those items detailed in Schedule GP to the Agreement of Purchase and Sale, the Purchaser is entitled to a credit of Sev Worksheet Note:	
The Purchaser acknowledges that the Purchase Price is inclusive of all credits and promotional packages available at the time of purchase. Worksheet Note:	

This Document is Extremely Time Sensitive - Printed 17 May 18 at 13:36


# DEWBERRY 2E 2,598 SQ.FT.

AVAILABLE IN BLOCK: 213, 214 & 215

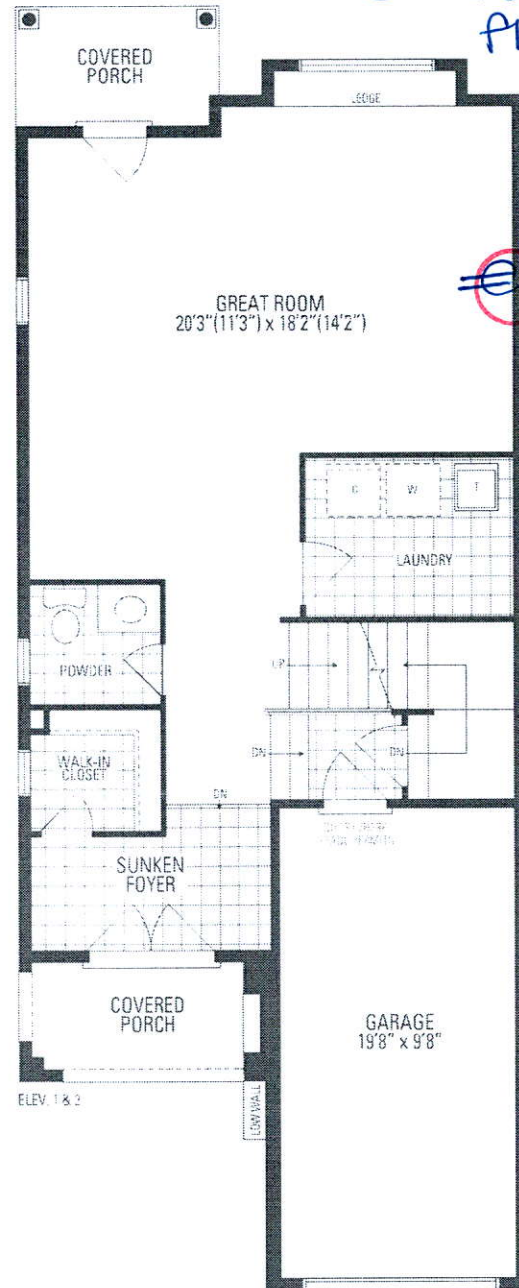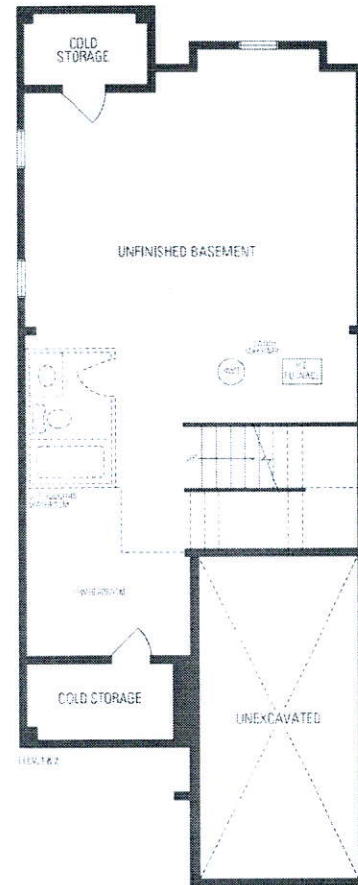

Add Plug  
5' from  
floor

Relocate  
Std. Light  
Above Island

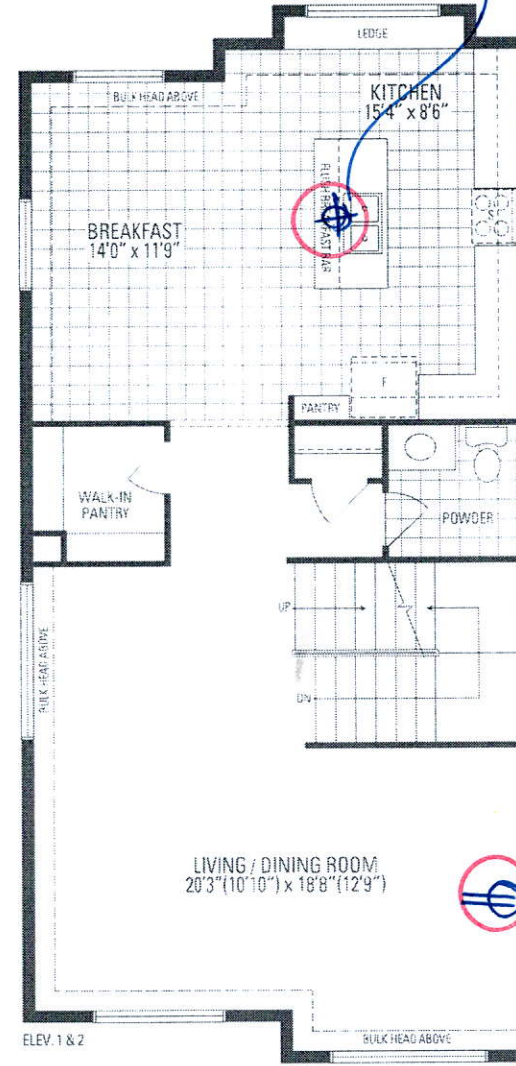

Add Plug 5'  
from floor

