





NOTE:  
CLOUD INDICATES CONDITION  
THAT DIFFERS FROM STANDARD  
UNIT.

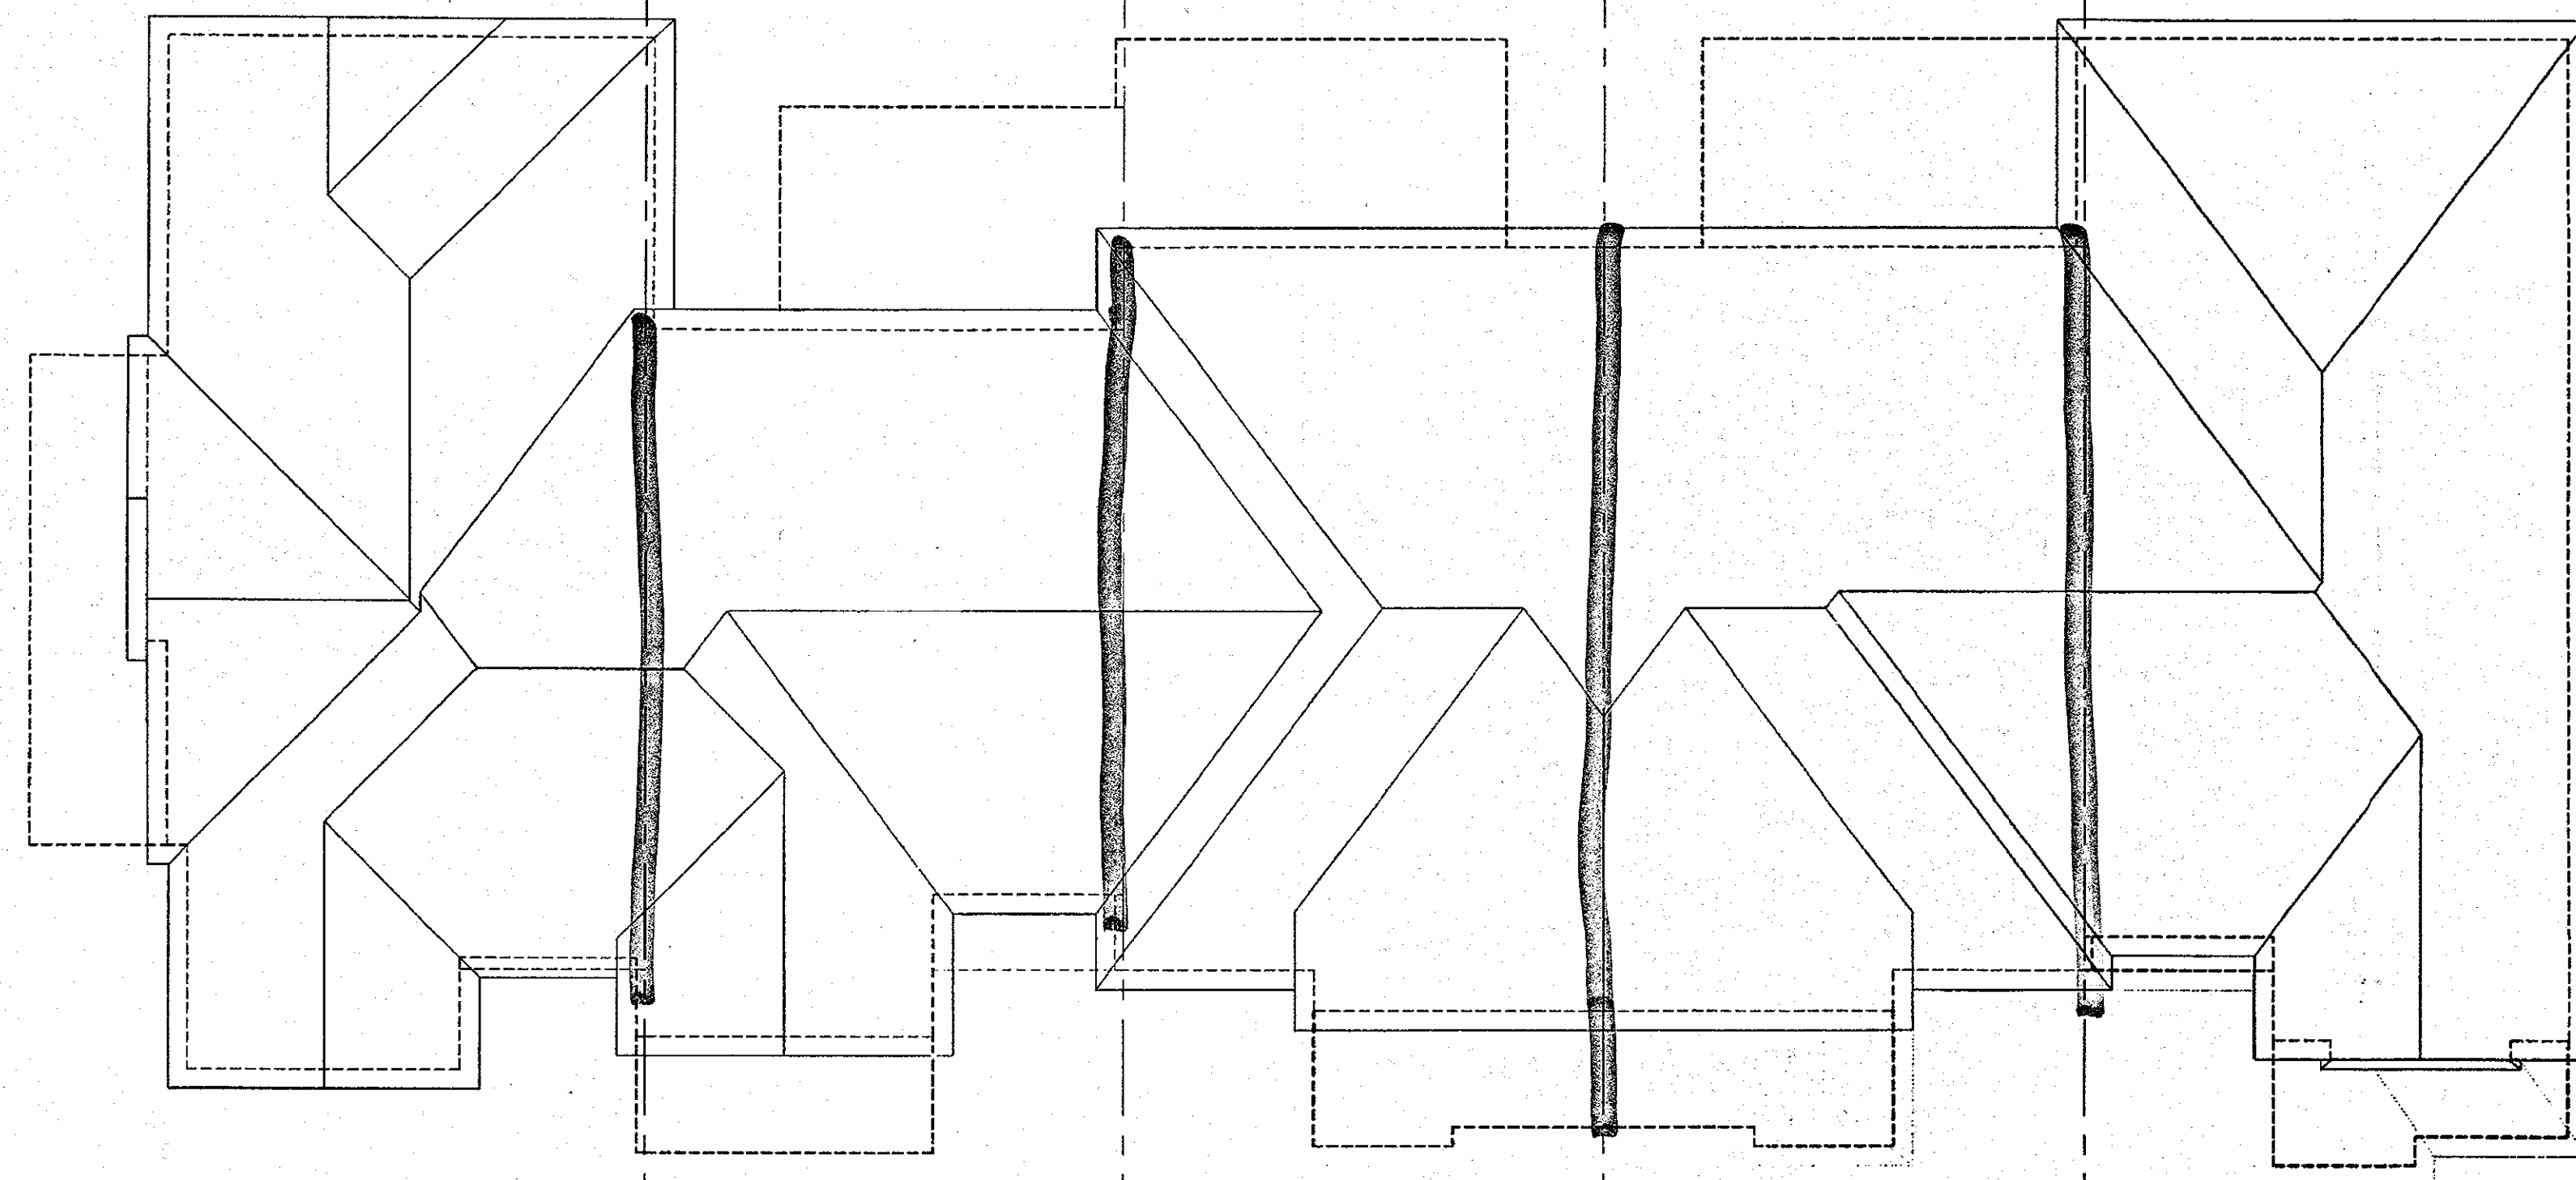

ROOF PLAN

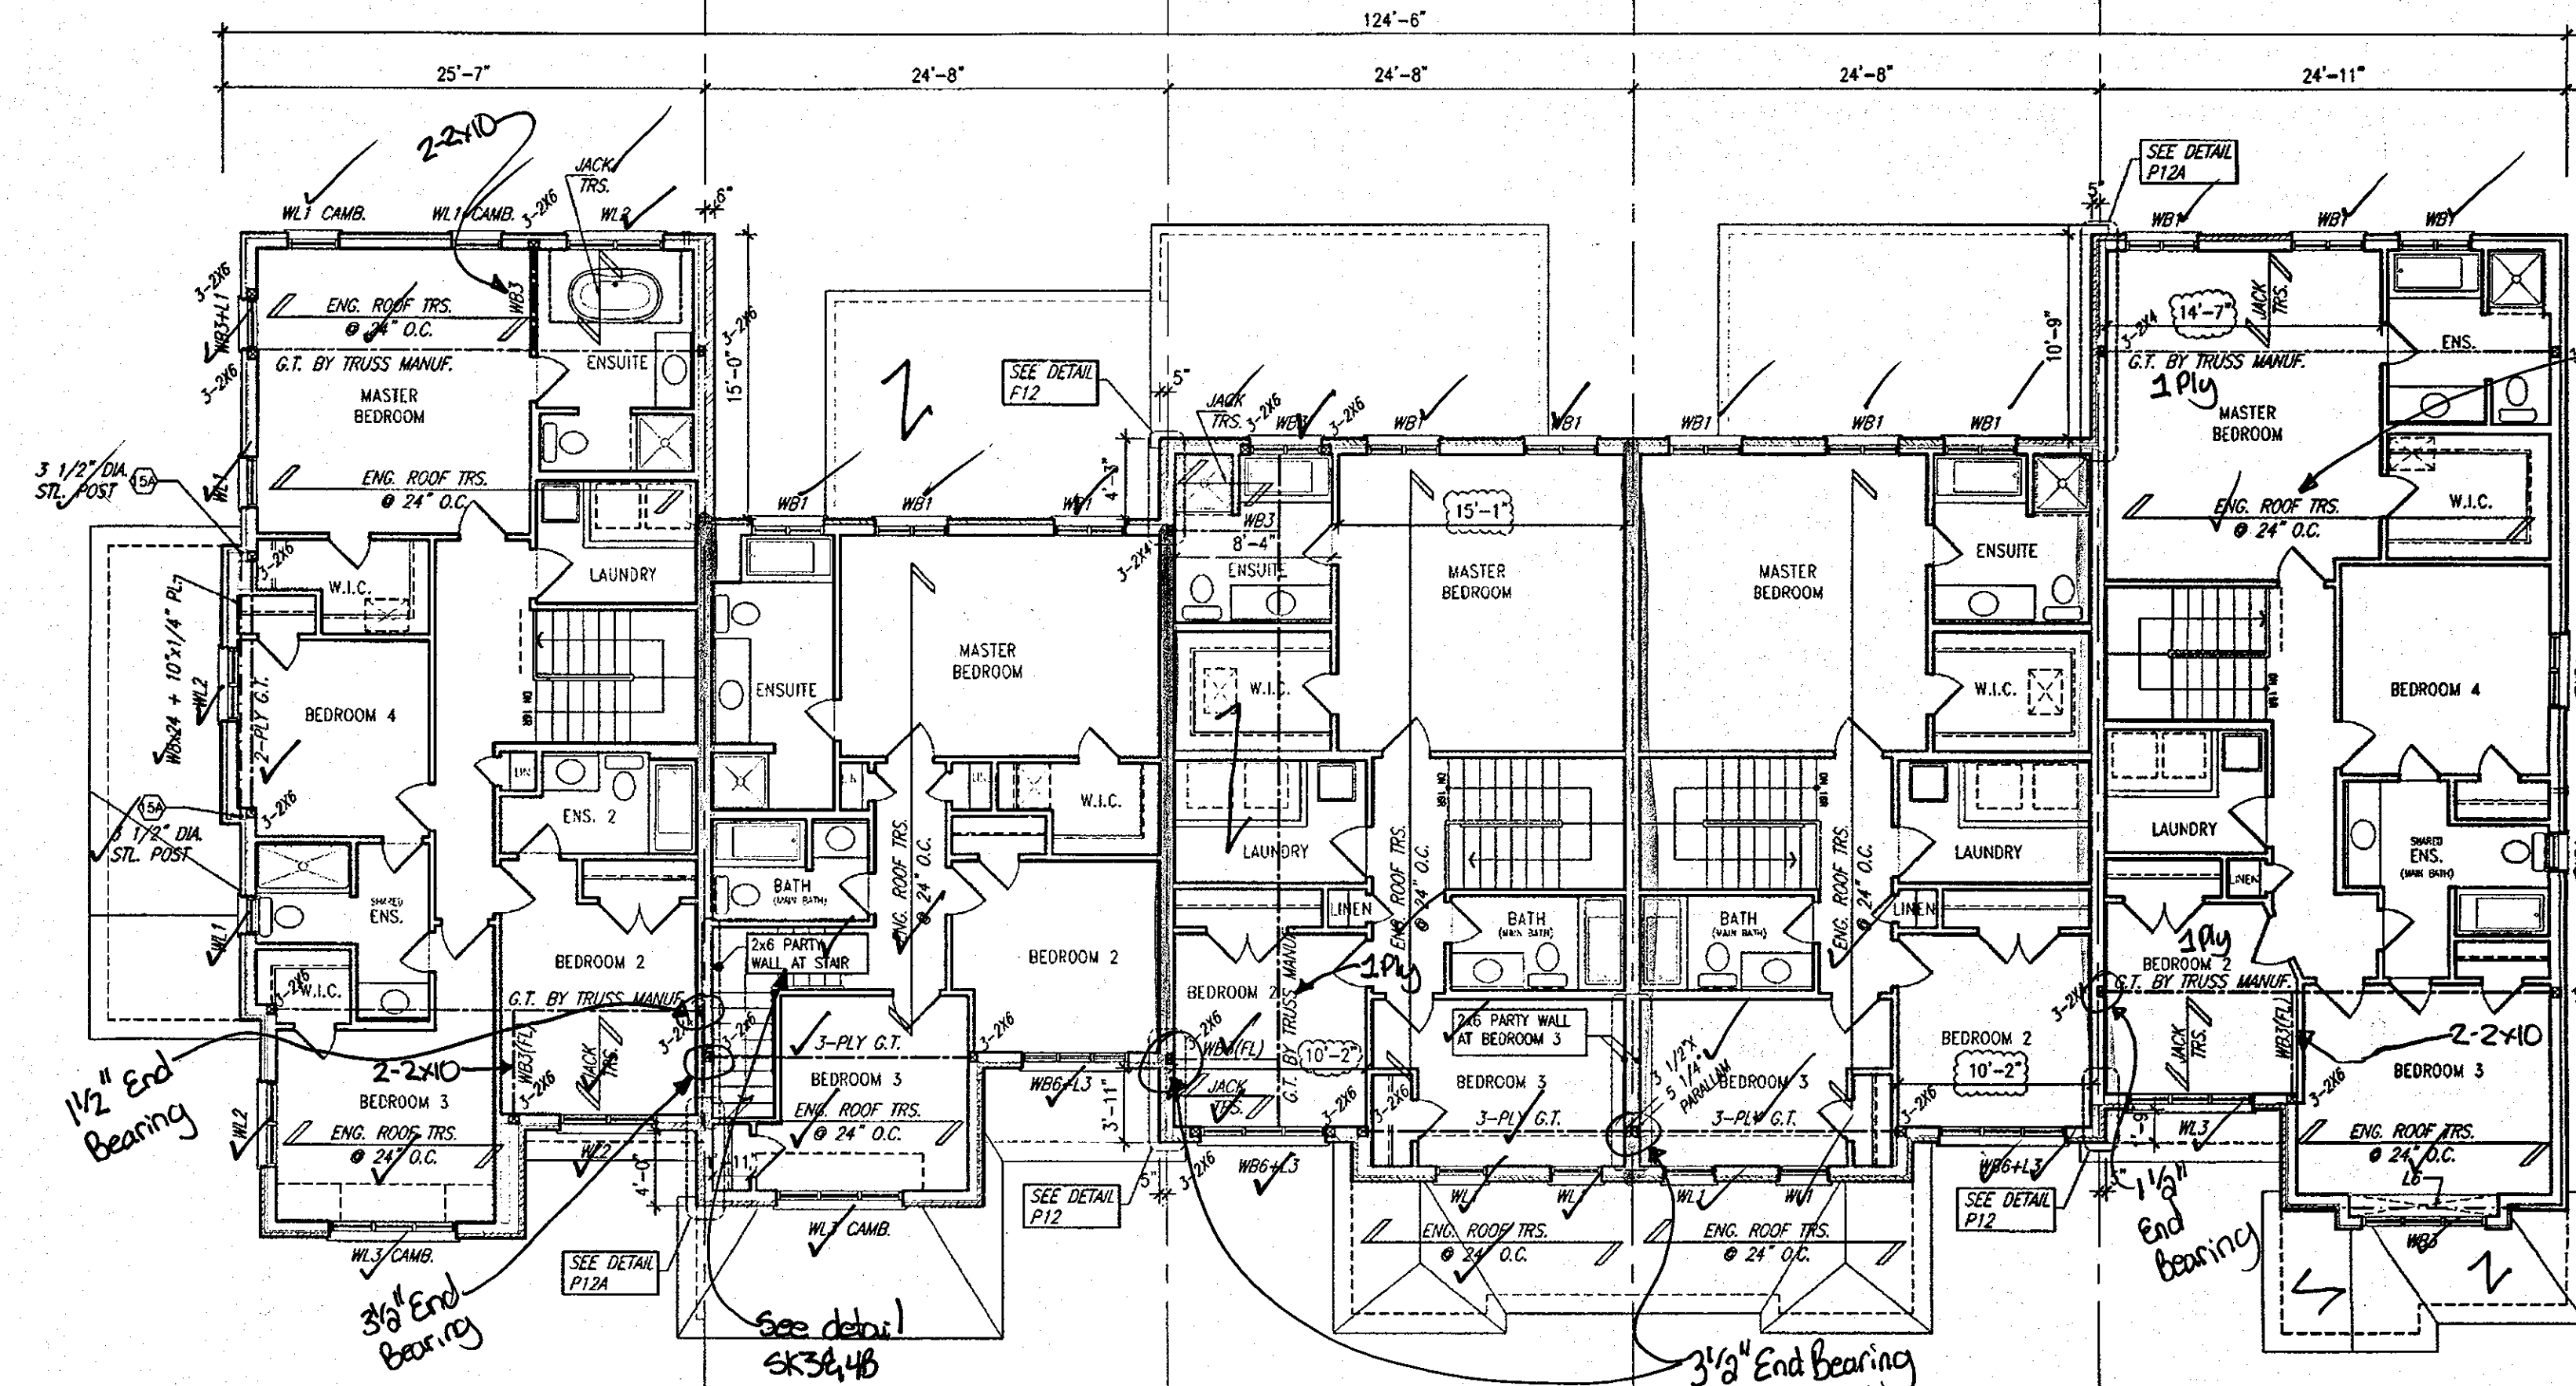

SECOND FLOOR PLAN

BUILDING AREA  
6436.9 S.F. (598.0 m<sup>2</sup>)

**PAD FOOTINGS**  
120 KPa. NATIVE SOIL. 80 KPa. ENGINEERED FILL SOIL.  
F1 = 42"x42"x18" CONCRETE PAD F1 = 48"x48"x20" CONCRETE PAD  
F2 = 36"x36"x18" CONCRETE PAD F2 = 40"x40"x18" CONCRETE PAD  
F3 = 30"x30"x12" CONCRETE PAD F3 = 34"x34"x14" CONCRETE PAD  
F4 = 24"x24"x12" CONCRETE PAD F4 = 28"x28"x12" CONCRETE PAD  
F5 = 16"x16"x8" CONCRETE PAD F5 = 18"x18"x8" CONCRETE PAD  
(REFER TO FLOOR PLAN FOR UNUSUAL SIZE PADS NOT ON CHART.)

**STRIP FOOTINGS - FOR 2 STOREY TOWNHOUSES**  
**FOOTINGS ON NATIVE SOIL (120 KPa.)**  
20"x6" CONCRETE STRIP FOOTINGS AS NOTED ON PLAN  
24"x6" CONCRETE STRIP FOOTINGS BELOW EXTERIOR WALLS (UNLESS OTHERWISE NOTED).  
24"x6" CONCRETE STRIP FOOTINGS (with REIN.) BELOW PARTY WALLS.  
32"x6" CONCRETE STRIP FOOTINGS (with REIN.) BELOW FIRE WALLS.  
**FOOTINGS ON ENGINEERED FILL (80 KPa.)**  
24"x6" CONCRETE STRIP FOOTINGS WITH REINFORCEMENT, AS NOTED ON PLAN  
32"x6" CONCRETE STRIP FOOTINGS BELOW EXTERIOR WALLS WITH REINFORCEMENT (UNLESS OTHERWISE NOTED).  
32"x6" CONCRETE STRIP FOOTINGS WITH REINFORCEMENT BELOW PARTY WALLS.  
44"x6" CONCRETE STRIP FOOTINGS WITH REINFORCEMENT BELOW FIRE WALLS.  
(REFER TO FLOOR PLAN FOR REINFORCEMENT)

ASSUME 120KPa/17.4kPa SOIL BEARING CAPACITY FOR NATIVE SOIL  
OR 80KPa/ 13.0kPa FOR ENGINEERED FILL  
SOIL BEARING TO BE VERIFIED ON-SITE BY SOILS ENGINEER

**VENEER CUT**  
WHEN VENEER CUT IS GREATER  
THAN 26", A 10" POURED  
CONCRETE FOUNDATION WALL IS  
REQUIRED.

**REFER TO INDIVIDUAL UNITS  
FOR THE FOLLOWING**  
-GROUND FLOOR ROOF  
STRUCTURE  
-BASEMENT AND GROUND  
FLOOR LINTELS  
-GROUND FLOOR AND  
SECOND FLOOR STRUCTURE  
-DOUBLE VOLUME WALL  
LOCATION AND DETAILS  
-CONCRETE SLABS

**NOTE:**  
ROOF TRUSSES AND  
SECOND FLOOR LINTELS  
SHOWN ON BLOCK PLANS

**SOFFIT VENTING**  
NO SOFFIT VENTING AT ROOF  
OVERLAP OF DEMISING LINE/  
PARTY WALL.

It is the builder's complete responsibility to ensure that all plans submitted for approval comply with the applicable building codes and all applicable requirements and regulations including zoning provisions and any approvals in the building agreement. The builder is responsible for obtaining all necessary permits and for ensuring that the work is completed in accordance with the approved plans and specifications. This is to certify that these plans comply with the applicable building codes and regulations approved by the City of Hamilton.

JOHN C. WILLIAMS LTD., ARCHITECT  
REGISTERED PROFESSIONAL ARCHITECT  
AND APPROVED:  
DATE: 2018.05.24  
The above certificate is given on the condition that the design is for the use and purpose stated and that the design is not to be used for any other purpose without the written consent of the architect.

APPROVED BY: [Signature]  
DATE: 2018.05.24  
CITY OF HAMILTON BUILDING DIVISION

CITY OF HAMILTON  
Building Division  
Permit No. 17-131925  
THESE STAMPED DRAWINGS SHALL BE AVAILABLE ON SITE  
THE OWNER AND/OR CONTRACTOR SHALL COMPLY WITH  
THE ONTARIO BUILDING CODE AND ALL OTHER APPLICABLE LAWS  
These drawings and specifications have been reviewed by:  
[Signature] May 24/18  
FOR THE BUILDING OFFICIAL

**COPY**  
CITY OF HAMILTON  
BUILDING DIVISION  
Planning & Development Department  
APR 24 2018  
REC'D BY: CB  
DATE: [Blank]  
DATE: [Blank]

APR 17 2018

BLK 216  
ELEV. 1

STRUDET INC.  
FOR STRUCTURE ONLY

**VAS DESIGN**  
255 Consumers Rd  
Suite 120  
Toronto ON M2J 1R4  
416.630.2255  
416.630.4782  
vasdesign.com

Richard Vink  
24485  
24485

**Greenpark.**  
RUSSELL GARDENS PH2  
WATERDOWN, ON. 16036  
HIGHGROVE SERIES  
BLOCK 216  
BLOCK 216 PLANS  
82

