


BURKE STREET

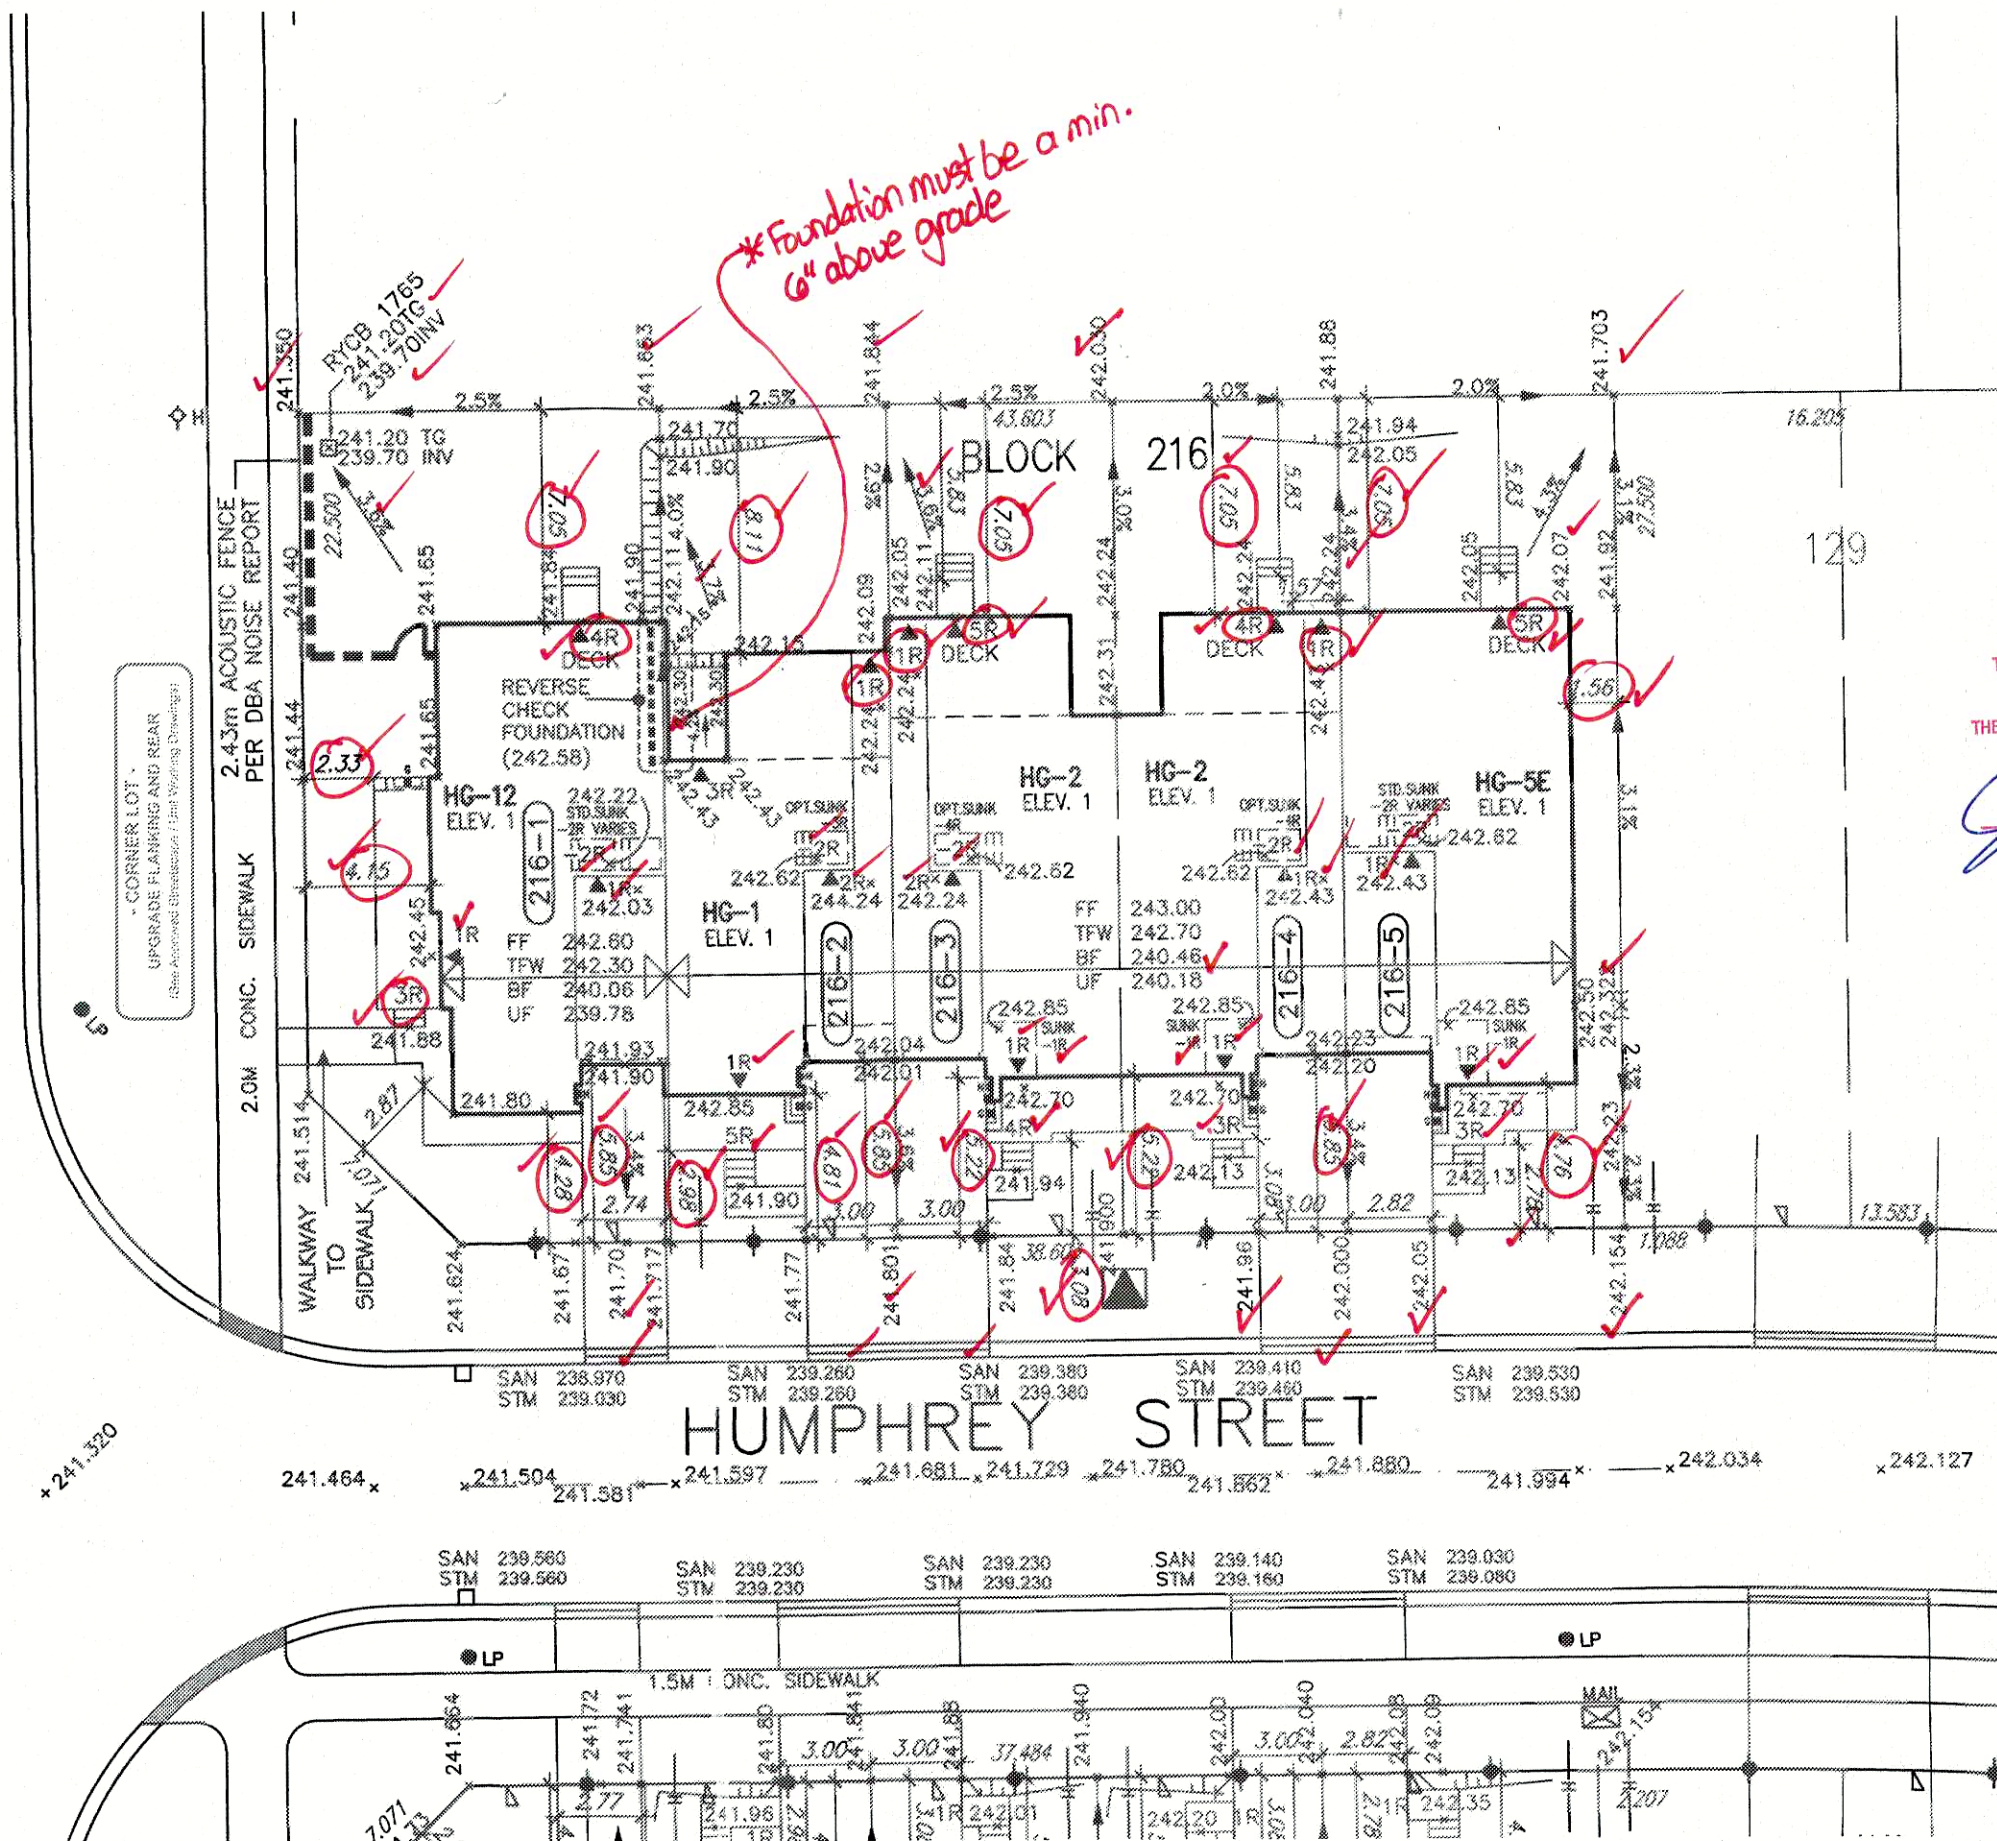

CITY OF HAMILTON
Building Division

Permit No. **17-131925**

THESE STAMPED DRAWINGS SHALL BE AVAILABLE ON SITE

THE OWNER AND/OR CONTRACTOR SHALL COMPLY WITH
THE ONTARIO BUILDING CODE AND ALL OTHER APPLICABLE LAW

These drawings and/or specifications have been reviewed by

FOR CHIEF BUILDING OFFICIAL **May 31/18** DATE

It is the builder's complete responsibility to ensure that all plans submitted for approval fully comply with the Architectural Guidelines and all applicable regulations and requirements including zoning provisions and any provisions in the subdivision agreement. The Control Architect is not responsible in any way for examining or approving site (lotting) plans or working drawings with respect to any zoning or building code or permit matter or that any house can be properly built or located on its lot.

This is to certify that these plans comply with the applicable Architectural Design Guidelines approved by the City of Hamilton.

JOHN G. WILLIAMS LTD., ARCHITECT
ARCHITECTURAL CONTROL REVIEW
AND APPROVAL

APPROVED BY:
DATE: **Apr 12, 2018**

The stamp certifies compliance with the applicable Design Guidelines only and does not constitute professional responsibility.

PROFESSIONAL ENGINEER
K.D. HOLLINGWORTH
100152747
PROVINCE OF ONTARIO

THIS LOT GRADING PLAN HAS BEEN REVIEWED BY METROPOLITAN CONSULTING INC. FOR CONFORMANCE WITH THE APPROVED SUBDIVISION GRADING DESIGN. THE PROPOSED GRADES ON THIS PLAN ARE IN GENERAL CONFORMITY WITH THE APPROVED GRADING PLAN AS IT RELATES TO THIS LOT AND ADJACENT LOTS. WHERE THE BASEMENT FLOOR ON OTHER LOTTING ELEVATIONS ARE PROVIDED AS A DIFFERENT ELEVATION THAN THAT SHOWN ON THE APPROVED SUBDIVISION PLANS THE SEWER LATERALS HAVE BEEN REVIEWED AND WE ARE SATISFIED THAT THE MINIMUM GRADES FOR THESE LATERALS CAN BE MAINTAINED IN ACCORDANCE WITH THE REQUIREMENTS OF THE O.S.C. AND CITY DESIGN ENGINEER. NOTE: THIS CERTIFICATION DOES NOT REPLACE THE BUILDER'S RESPONSIBILITY TO ENSURE THE SEWER LATERALS AND CHIMNEY ELEVATIONS PRIOR TO EXCAVATING FOR THE FOUNDATION. BY USE OF THIS PLAN THE BUILDER AGREES THAT THEY SHALL BE RESPONSIBLE FOR IMMEDIATELY REPORTING TO METROPOLITAN CONSULTING INC. ANY DISCREPANCY OR VARIATION BETWEEN THE LATERAL INFORMATION AND GRADING DETAILED ON THIS PLAN AND THE CONDITIONS FOUND ON THE FIELD.

COPY

CITY OF HAMILTON
BUILDING DIVISION
Planning & Development Department

MAY 16 2018

REC BY **CB** DATE **MAY 16 2018**
REF'D TO **CB** DATE

MAIN UNDERSIDE OF FOOTING (UF) SHOWN IS FOR STANDARD 0.20 (8") DEEP EXTERIOR WALL STRIP FOOTING ONLY.

NOTE: REFER TO LANDSCAPE DRAWINGS FOR ALL FENCING TYPES, HEIGHTS AND LOCATIONS. CONTRACTOR TO VERIFY PRIOR TO INSTALLATION.

BLOCK 216		
LOT/BLOCK No.	LOT WIDTH (M) @ 8.0m	LOT AREA (M ²)
216-1	11.95	316.19
216-2	7.50	206.25
216-3	7.50	206.25
216-4	7.50	206.25
216-5	9.15	251.64

Grading Notes:
It shall be the responsibility of the builder to have all grades and services verified and checked before construction by an approved grading engineer. These grades and the placement of storm and sanitary services off the street are to meet the requirements of the municipality having jurisdiction.

VA3 Design Inc. is to be notified promptly of any discrepancies at least 1 (one) week prior to excavation commences in order that the building can be re-sited. Failure to observe these conditions may require expensive remedial action that will not be the responsibility of or cost to VA3 Design Inc. Foundation wall shall be poured to a minimum of 6" above approved grades.

Finished grade lines as indicated on the house prototype are for reference only and do not necessarily depict finish grading conditions of any particular lot.

These drawings are to be read in conjunction with municipal approved site engineering drawings prepared by Metropolitan Consulting Inc.

1 ISSUED FOR CLIENT USE. A.S. 28/17 GW	2 ISSUED FOR PERMIT. OCT. 16/17 GW	3 REVISED PER BLDG. COMMENTS. DEC. 13/17 GW	4 REV. UNIT 2 REAR STEPS/ GRADES. APR. 08/18 GW	5	6
- PROPOSED VALVE - UP LIGHT POLE - HYDRA - TRANSFORMER - WATER SERVICE - DOUBLE STM/SAN. CONNECTION - SINGLE STM/SAN. CONNECTION - CATCH BASIN - CABLE TELEVISION PEDISTAL - BELL PEDISTAL	- FIN. OF ROOF - FINISHED FLOOR ELEVATION - UF UNDERSIDE FOOTING ELEVATION - BF FIN. BASEMENT FLOOR SLAB - TF 12" OF FOUNDATION WALL - UF UNDERSIDE FOOTING AT REAR - UF UNDERSIDE FOOTING AT FRONT - UF UNDERSIDE FOOTING AT SIDE - W.O.E. WALK OUT DECK - W.O.E. WALK OUT BASEMENT - REV REVERSE PLAN	- STREET SIGN - SUPER MAIL BOX - RECYCLING WALL 1.5m BLACK VINYL CHAIN LINK FENCE - ACOUSTICAL FENCE (SEE LANDSCAPE PLAN) - WOOD SCREEN FENCE (SEE LANDSCAPE PLAN) - HYDRO SERVICE LATERAL - SHADE DIRECTION - ENCROACHMENT	- PROVIDE 3/4" DIA. CLEAR STONE IN THIS AREA - THIS LOT CONTAINS ENGINEERED FILL - AIR CONDITIONER REQUIRED - RAIN WATER DOWNSPOUT LOCATION (DISCHARGE ONTO SPLASHPAD) - SIDE WINDOW LOCATION - EXTERIOR DOOR LOCATION - REDUCE SIDE YARD	VA3 DESIGN 255 Consumers Rd Suite 120 Toronto ON M2J 1R4 416.630.2255 / 416.630.4782 va3design.com	Greenpark. RUSSELL GARDENS PHASE 2 HAMILTON BLOCK SITING/GRADING 16036-RG2-SP SP1