



CONSTRUCTION SUMMARY

Mountainview Heights (G) - Russell Gardens Building Ltd.

PURCHASERS: ABHAY D TADWALKAR and AARTI A TADWALKAR

TEL:

LOT / PHASE 176 / 2	REG. PLAN # 62M-1238	HOUSE TYPE Rosewood 5 Elev 3		
------------------------	-------------------------	---------------------------------	--	--

CABINETRY ACCESSORIES

1 - KITCHEN CABINETRY UPPER - MICROWAVE SHELF STANDARD - 700MM WIDE - STANDARD 14Jun18 Note:	
1 - PANTRY UNIT UPGRADE - TO GO FROM 300MM TO 600MM DEEP - PRICE IS PER FOOT - STANDARD 14Jun18 Note:	
1 - KITCHEN CABINETRY UPPER - FULL DEPTH ABOVE FRIDGE - WITH GABLES - 600MM - PRICE IS EACH - STANDARD 14Jun18 Note:	
1 - KITCHEN - BLU MOTION DRAWERS 14Jun18 Note:	

CERAMIC TILE

1 - DELETE ALL CERAMIC BATHROOM ACCESSORIES - DELETE TOWEL BAR, PAPER HOLDER & SOAP DISH THROUGHOUT 14Jun18 Note:	
1 - TILE - UPGRADE 1 FLOOR TILE - - POWDER ROOM 14Jun18 Note:	
1 - TILE - UPGRADE 1 FLOOR TILE - - KITCHEN 14Jun18 Note:	
1 - TILE - UPGRADE 1 FLOOR TILE - - FOYER 14Jun18 Note:	

CONSTRUCTION

1 - SMOOTH CEILINGS ON FIRST FLOOR ONLY 01Jun18 Note:	
--	--

ELECTRICAL

[REDACTED] 18Jun18 Note:	
[REDACTED] 18Jun18 Note:	
1 - LIGHT AND SWITCH - NO FIXTURE INCLUDED 01Jun18 Note: MASTER ENSUITE BATHROOM - INSTALLED ABOVE TUB	
1 - ABOVE KITCHEN ISLAND - ADD LIGHT AND SWITCH - NO FIXTURE INCLUDED 01Jun18 Note:	
1 - PLUG - ELECTRICAL PLUG - TO BE INSTALLED OVER FIREPLACE 01Jun18 Note:	
1 - PLUG - ELECTRICAL PLUG - FOR MICROWAVE SHELF 01Jun18 Note:	
1 - 200 AMP ELECTRICAL SERVICE 18Apr18 Note:	

HARDWOOD FLOORING

1 - LAMINATE -UPGRADE TO LEXINGTON SERIES IN LIEU OF STANDARD LAMINATE 14Jun18 Note:	
1 - HARDWOOD – PROMO SERIES 4 7/16 INCH - IN LIEU OF 2 1/4 INCH NATURAL RED OAK - - MAIN HALL 14Jun18 Note:	

RECEIVED JUN 22 2018

CONSTRUCTION SUMMARY

Mountainview Heights (G) - Russell Gardens Building Ltd.

PURCHASERS: ABHAY D TADWALKAR and AARTI A TADWALKAR

TEL:

LOT / PHASE	REG. PLAN #	HOUSE TYPE		
176 / 2	62M-1238	Rosewood 5 Elev 3		
1 - HARDWOOD – PROMO SERIES 4 7/16 INCH - IN LIEU OF 2 1/4 INCH NATURAL RED OAK - - LIBRARY/DEN 14Jun18 Note:				
1 - HARDWOOD – PROMO SERIES 4 7/16 INCH - IN LIEU OF 2 1/4 INCH NATURAL RED OAK - - FAMILY ROOM 14Jun18 Note:				
1 - HARDWOOD – PROMO SERIES 4 7/16 INCH - IN LIEU OF 2 1/4 INCH NATURAL RED OAK - - DINING ROOM 14Jun18 Note:				

MIRRORS AND GLASS

1 - SHOWER DOOR HANDLE - CHROME D-RING WITH TOWEL BAR 14Jun18 Note: MASTER ENSUITE BATHROOM	
1 - FRAMELESS GLASS SHOWER ENCLOSURE 01Jun18 Note: MASTER ENSUITE BATHROOM - CHROME KNOB AND HINGES	

MISCELLANEOUS

1 - FURTHER DISCOUNT AS PER VENDOR 14Jun18 Note:	
--	--

PLUMBING

5 - MOEN BATHROOM ACCESSORIES - MASON CHROME - TOWEL BAR 24" #YB8094/YB8000 - PRICE IS EACH 14Jun18 Note: ALL BATHROOMS	
5 - MOEN BATHROOM ACCESSORIES - MASON CHROME - PAPER HOLDER #YB8099/YB8000 - PRICE IS EACH 14Jun18 Note: ALL BATHROOMS	
1 - WATER LINE FOR FRIDGE - ROUGH-IN ONLY 01Jun18 Note:	

PROMOTIONAL

1 - LESS BALANCE OF CREDIT FROM PURCHASER EXTRA SHEET IN OFFER 14Jun18 Note:	
1 - PARTIAL REDEMPTION OF PROMOTIONAL PACKAGE \$40.00 BALANCE FORWARD TO BE USED AT A LATER DATE. ORIGINAL PROMOTIONAL PACKAGE OF \$10,000.00 01Jun18 Note:	
1 - PARTIAL REDEMPTION OF PROMOTIONAL PACKAGE \$\$\$\$\$\$ BALANCE FORWARD TO BE USED AT A LATER DATE. ORIGINAL PROMOTIONAL PACKAGE OF \$\$\$\$\$ AS PER SCHEDULE PE DATED MMMDDYYYY. 18Apr18 Note: NEW PROMO BALANCE \$9135.00	

STAIRS AND RAILINGS

1 - STAINED STAIRS, RAILING AND PICKETS – STANDARD STAIRCASE - PRICE IS PER SET 14Jun18 Note:	
1 - V GROOVE HANDRAIL 14Jun18 Note: LARGER POST AND HANDRAIL FOR STAIRCASE	

CONSTRUCTION SUMMARY

Mountainview Heights (G) - Russell Gardens Building Ltd.

PURCHASERS: ABHAY D TADWALKAR and AARTI A TADWALKAR

TEL:

LOT / PHASE	REG. PLAN #	HOUSE TYPE		
176 / 2	62M-1238	Rosewood 5 Elev 3		

EXTRAS AS PER OFFER

The Vendor agrees that notwithstanding any other term or provision in this Agreement included in the Purchase Price and in addition to those items detailed in Schedule GP to the Agreement of Purchase and Sale, the Purchaser is entitled to a credit of Ten <i>Worksheet</i> Note:	
Standard Granite Counter in Kitchen including island with Standard Undermount Sink (Blanco #40008) ... ABOVE AS PER VENDORS STANDARD SAMPLES <i>Worksheet</i> Note:	
The Purchaser acknowledges that the Purchase Price is inclusive of all credits and promotional packages available at the time of purchase. <i>Worksheet</i> Note:	

This Document is Extremely Time Sensitive - Printed 18 Jun 18 at 13:37

Purchasers:

ABHAY D TADWALKAR & AARTI A TADWALKAR

Telephone Res. / Bus:

/

Decor Advisor:

Candace Forza

Lock Date:

14-Jun-18

Property:

176

Project:

Russell Gardens Building Ltd.

Model and Elevation:

Rosewood 5 Elev 3

Plan #:

62M-1238

Layout Changes:

☐ Yes ☒ No

Sketch Attached:

☒ Yes ☐ No

Exterior Colour Scheme:

1. Cabinetry

	Style and Colour	Hardware
Kitchen / Breakfast	MODENA WHITE	2004
Laundry Room	ELISSE	Standard
Powder Room	MODENA WHITE	2004
Master Ensuite Bathroom	MODENA WHITE	2004
Ensuite Bath - Bedroom 2	MODENA WHITE	2004
Ensuite Bath - Bedroom 3	MODENA WHITE	2004
Ensuite Bath - Bedroom 4	MODENA WHITE	2004
	N/A	N/A
	N/A	N/A

Appliances:

Built In Appliances

☐ Yes ☒ No

Slide In Stove

☐ Yes ☒ No

Dishwasher Cabinet

☐ Closed ☒ Open

41" Upper Cabinets

☒ Yes ☐ No

Please NOTE: Standard Cabinet Height is 30"

Stove Opening

NOTE: If not specified, opening will be set to builder's standard opening of approximately 30" width

Fridge Opening

NOTE: If not specified, opening will be set to builder's standard opening of approximately 37" width x 74" height

** Refer to Construction Summary

2. Counters

	Counter	Edge
Kitchen / Breakfast	GRANITE-NERO IMPALA	#320 PENCIL ROUND
Laundry Room	N/A	
Powder Room	LAMINATE-WHITE CARRARA 4924-38	
Master Ensuite Bathroom	LAMINATE-MADURA GARNET 4921K-52	
Ensuite Bath - Bedroom 2	LAMINATE-WHITE CARRARA 4924-38	
Ensuite Bath - Bedroom 3	LAMINATE-WHITE CARRARA 4924-38	
Ensuite Bath - Bedroom 4	LAMINATE-WHITE CARRARA 4924-38	
	N/A	
	N/A	

** Refer to Construction Summary

Initials:

AD

AT

Purchasers:

ABHAY D TADWALKAR & AARTI A TADWALKAR

Telephone Res. / Bus: /

Decor Advisor: Candace Forza

Lock Date: 14-Jun-18

Property: 176

Project: Russell Gardens Building Ltd.

Model and Elevation: Rosewood 5 Elev 3

14-Jun-18

Plan #: 62M-1238

3. Ceramic Flooring

		At a 45	Threshold-If App.
Entrance Vestibule	TILE-POSH KIGAL (NAT)12X24	<input type="checkbox"/>	METAL STRIP
Main Hall	STRIP	<input type="checkbox"/>	
Kitchen / Breakfast	TILE-POSH KIGAL (NAT)12X24	<input type="checkbox"/>	METAL STRIP
Laundry Room	TILE-ESSENZE GRIGIO-13X13	<input type="checkbox"/>	
Powder Room	TILE-POSH KIGAL (NAT)12X24	<input type="checkbox"/>	
Master Ensuite Bathroom	TILE-ESSENZE GRIGIO-13X13	<input type="checkbox"/>	METAL STRIP
Ensuite Bath - Bedroom 2	TILE-RAINBOW WHITE-13X13	<input type="checkbox"/>	METAL STRIP
Ensuite Bath - Bedroom 3	TILE-RAINBOW WHITE-13X13	<input type="checkbox"/>	METAL STRIP
Ensuite Bath - Bedroom 4	TILE-RAINBOW WHITE-13X13	<input type="checkbox"/>	METAL STRIP
	N/A	<input type="checkbox"/>	
	N/A	<input type="checkbox"/>	

** Refer to Construction Summary

4. Ceramic Wall Tile

Master Ensuite Bathroom	Selection	Describe
Tub Deck Wall	N/A	
Tub Deck	N/A	
Tub Deck Skirt	N/A	
Shower Stall	TILE-LUC BLANC GROENLANDIA-8X16	
Bathtub Enclosure Walls	N/A	
Ensuite Bath - Bedroom 2	TILE-LUC BLANC GROENLANDIA-8X16	
Ensuite Bath - Bedroom 3	TILE-LUC BLANC GROENLANDIA-8X16	
Ensuite Bath - Bedroom 4	TILE-LUC BLANC GROENLANDIA-8X16	
	N/A	
	N/A	
Kitchen Backsplash	N/A	

** Refer to Construction Summary - STANDARD GROUT THROUGHOUT UNLESS SPECIFIED

5. Plumbing Fixtures

All Bathrooms

White

N/A

N/A

Whirlpool

N/A

☐ Yes ☒ No

Dishwasher Rough-In

☒ Yes ☐ No

Waterline for Fridge

☒ Yes ☐ No

** Refer to Construction Summary

6. Trim Carpentry

Interior Doors	CLERMONT
Interior Trim	3" BB CASING WITH 5 1/4" BASEBOARD - COLONIAL
Door Handles	As Per Construction Specifications
Exterior Front Door Handle	As Per Construction Specifications

** Refer to Construction Summary

Initials:

AD

AT

Purchasers:

ABHAY D TADWALKAR & AARTI A TADWALKAR

Telephone Res. / Bus:

/

Decor Advisor:

Candace Forza

Lock Date:

14-Jun-18

Property: 176

Project: Russell Gardens Building Ltd.

Model and Elevation: Rosewood 5 Elev 3

Plan #: 62M-1238

7. Other Flooring

Main Hall	STRIP-MIRAGE-ALIVE-RED OAK-CASHMERE-EASTMAN-4 7/16"	
Living Room		
Dining Room	STRIP-MIRAGE-ALIVE-RED OAK-CASHMERE-EASTMAN-4 7/16"	
Family Room	STRIP-MIRAGE-ALIVE-RED OAK-CASHMERE-EASTMAN-4 7/16"	
Den / Library / Study	STRIP-MIRAGE-ALIVE-RED OAK-CASHMERE-EASTMAN-4 7/16"	
Basement Landing(If Applies)	N/A	
Lower Landing (If Applies)	STRIP-MIRAGE-ALIVE-RED OAK-CASHMERE-EASTMAN-4 7/16"	
Upper Landing	STRIP-MIRAGE-ALIVE-RED OAK-CASHMERE-EASTMAN-4 7/16"	
Upper Hall	LAMINATE-LEXINGTON - ROCKINGHAM OAK TL-21015-M	
Master Bedroom	LAMINATE-LEXINGTON - ROCKINGHAM OAK TL-21015-M	
Bedroom #2	LAMINATE-LEXINGTON - ROCKINGHAM OAK TL-21015-M	
Bedroom #3	LAMINATE-LEXINGTON - ROCKINGHAM OAK TL-21015-M	
Bedroom #4	LAMINATE-LEXINGTON - ROCKINGHAM OAK TL-21015-M	
Bedroom #5	N/A	
	N/A	
	N/A	
	N/A	
Underpad	Type	Area
	N/A	N/A

** Refer to Construction Summary

8. Railings and Pickets

Railing Type	V-GROOVE	Colour	MIRAGE EASTMAN
Picket Type	As Per Construction Specifications	Colour	MIRAGE EASTMAN
Stringer / Riser	As Per Construction Specifications	Colour	MIRAGE EASTMAN
Treads	As Per Construction Specifications	Colour	MIRAGE EASTMAN
Red Oak Stairs with Semi Gloss Finish		<input checked="" type="radio"/> Yes <input type="radio"/> No	

** Refer to Construction Summary

9. Wall Paint Flat Finish

Main & Upper Hall	25 OYSTER	Master Bedroom	25 OYSTER
Living Room	25 OYSTER	Bedroom #2	25 OYSTER
Dining Room	25 OYSTER	Bedroom #3	25 OYSTER
Kitchen / Breakfast	25 OYSTER	Bedroom #4	25 OYSTER
Family Room	25 OYSTER	Bedroom #5	N/A
Powder Room	43 BIRCH WHITE	Master Ensuite	43 BIRCH WHITE
Laundry Room	25 OYSTER	Ensuite Bath - Bedroom 2	43 BIRCH WHITE
Den/Library	25 OYSTER	Ensuite Bath - Bedroom 3	43 BIRCH WHITE
Trim Paint-Semi Gloss	BIRCH WHITE	Ensuite Bath - Bedroom 4	43 BIRCH WHITE
	N/A		N/A
	N/A		N/A

Smooth Ceilings First Floor

☒ Yes ☐ No

** Refer to Construction Summary

Purchasers:

ABHAY D TADWALKAR & AARTI A TADWALKAR

Telephone Res. / Bus:

/

Decor Advisor:

Candace Forza

Lock Date:

14-Jun-18

Property:

176

Project:

Russell Gardens Building Ltd.

Model and Elevation:

Rosewood 5 Elev 3

Plan #:

62M-1238

10. Plaster Mouldings and Medallions

Entrance Vestibule	N/A	N/A	Kitchen/Breakfast	N/A	N/A
Main Hall	N/A	N/A	Den/Library	N/A	N/A
Living Room	N/A	N/A	Lower Landing	N/A	N/A
Dining Room	N/A	N/A		N/A	N/A
Family Room	N/A	N/A			

** Refer to Construction Summary

11. Fireplace

Living Room			Family Room			Other Room - Specify		
Purchased	As Per Plan	N/A	Purchased	As Per Plan	N/A	Purchased	As Per Plan	N/A
<input type="radio"/>	<input type="radio"/>	<input checked="" type="radio"/>	<input type="radio"/>	<input checked="" type="radio"/>	<input type="radio"/>	<input type="radio"/>	<input type="radio"/>	<input checked="" type="radio"/>

Fireplace Type	N/A	FLAT ON WALL	N/A
Mantle Type	N/A	MANTLE M2-STANDARD	N/A
Colour / Stain	N/A	AS PER CONSTRUCTION SPECIFICATIONS	N/A
Surround	N/A	BIANCO	N/A
Hearth	N/A	NO	N/A

** Refer to Construction Summary

12. Heating and Air Conditioning

Air Conditioning	NO	Gas Provisions Stove	NO
Gas Provisions Dryer	NO	Gas Provisions Barbecue	NO

Comment

** Refer to Construction Summary

13. Electrical

Plugs and Switches	<input checked="" type="radio"/> White	DECOR	Above Kitchen Cabinet Light	<input type="radio"/> Yes	<input checked="" type="radio"/> No
Hood Fan	STANDARD WHITE		Below Kitchen Cabinet Light	<input type="radio"/> Yes	<input checked="" type="radio"/> No
Appliances	Built in Cooktop	Built in Oven	Gas Stove	Microwave	
	<input type="radio"/> Yes <input checked="" type="radio"/> No	<input type="radio"/> Yes <input checked="" type="radio"/> No	<input type="radio"/> Yes <input checked="" type="radio"/> No	<input checked="" type="radio"/> Yes <input type="radio"/> No	
Dishwasher Rough-in	Yes				

** Refer to Construction Summary

14. General Comments

** Refer to Construction Summary

Disclaimers and Notes

1) Colours of all materials are as close as possible to builder's selection, but not necessarily identical due to variances in manufacturing.

2) Any extras listed above are null and void unless accompanied by a separate invoice/amendment. Said invoice must be paid in full.

3) The Purchaser agrees that this colour selection is final and that no changes will be permitted, unless required by the Vendor.

4) The Purchaser acknowledges reading and accepting document which contains other miscellaneous disclaimers.

Signature: 


Date: June 14/18

Signature: 

Date: June 14/18



Page 4 of 4

Printed 6/14/2018 15:33:22

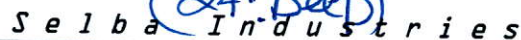


JOB NUMBER:
BUILDER: GREENPARK
SITE NAME: RUSSEL GARDENS
MODEL: ROSEWOOD 5X ELEV 2,3
LOT #:
DESIGNER: KS
DATE: AUG 29 17


enpark
GROUP

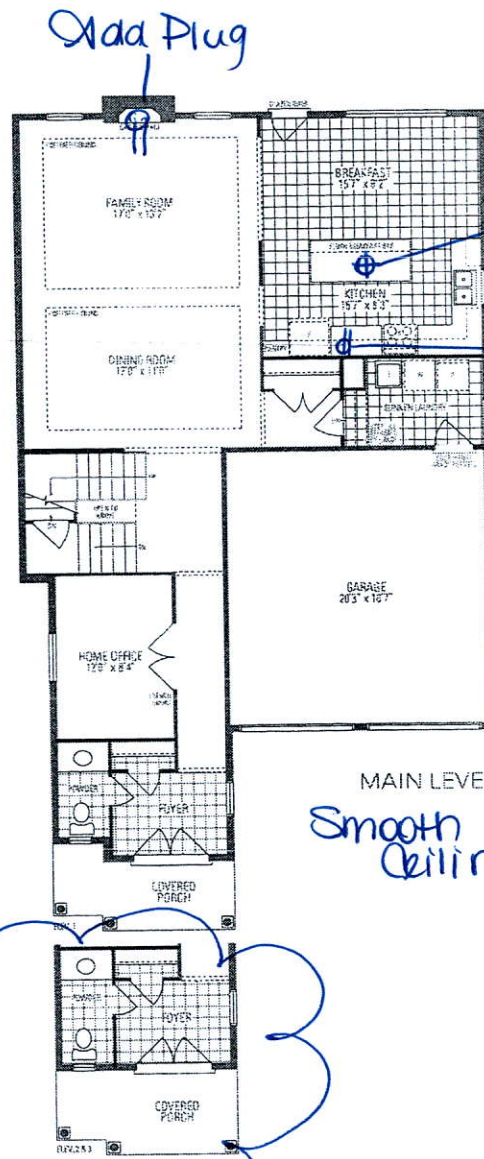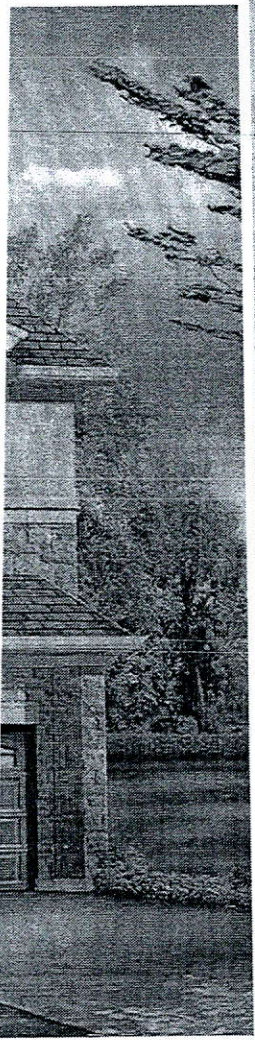

MAIN LEVEL
Smooth
Ceilings.

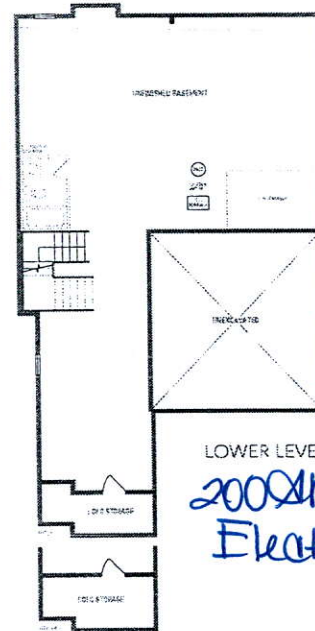

ROSEWOOD 5
3,002 sq.ft.

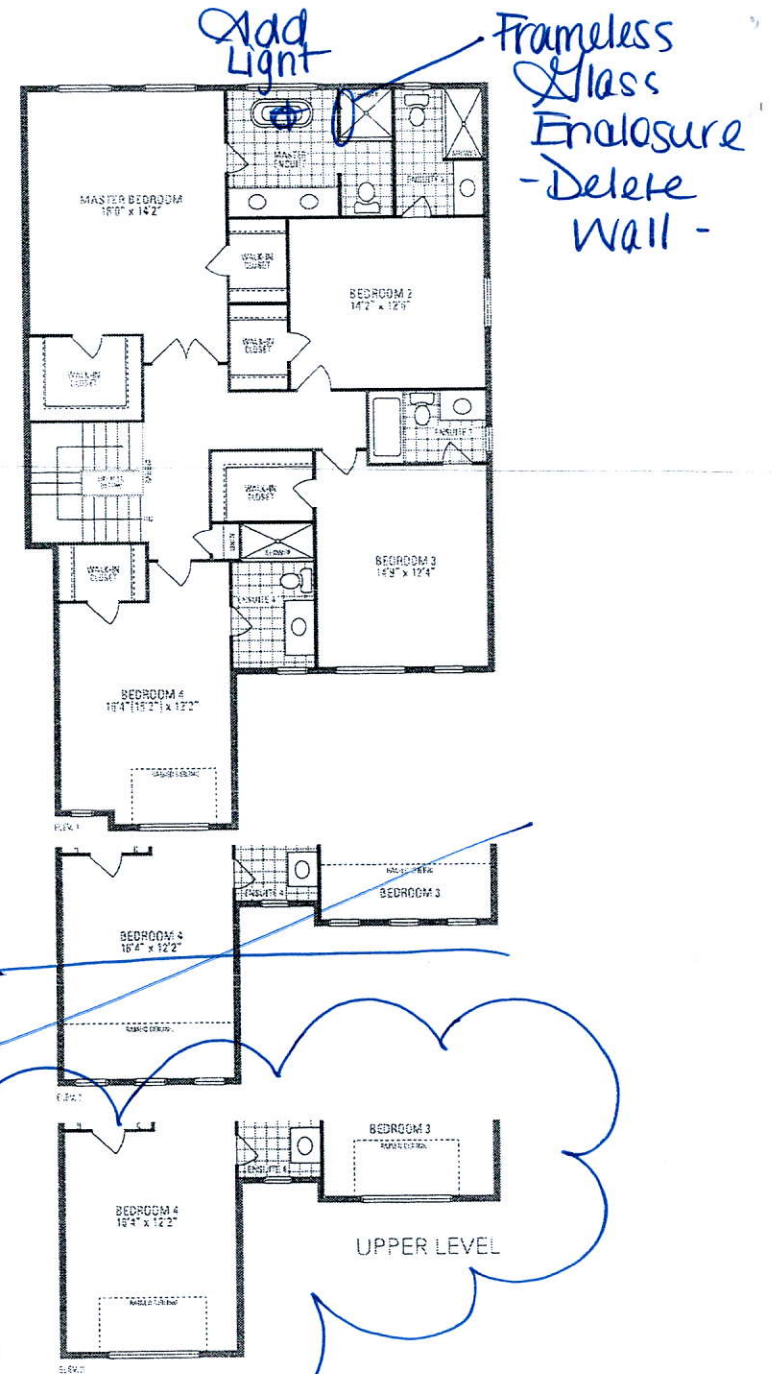

UPPER LEVEL



Orientation of home may be reversed and purchaser agrees to accept the same. Steps and porches may vary at any exterior entrance ways due to grading variations. Actual usable floor space may vary from the stated floor area. All renderings are artist's concept. Dimensions, specifications and architectural detailing subject to change without notice. Final location of every pump is subject to local code conditions. Roofline and adjoining material types may vary due to wind, F. & O.E. L.C. Rosewood 5 - Copyright Sept. 2017