

CONSTRUCTION SUMMARY

Mountainview Heights (G) - Russell Gardens Building Ltd.

RECEIVED JUN 27 2018



PURCHASER: MOHAMMED GHUFRAN AHMED

TEL:

LOT / PHASE	REG. PLAN #	HOUSE TYPE		
166 / 2	62M-1238	Rosewood 7 Elev 3		

ELECTRICAL

1 - PLUG - ELECTRICAL PLUG WITH GFI AND SWITCH - FOR FESTIVE LIGHTING 25Apr18 Note:		
1 - PLUG - ELECTRICAL PLUG - TO BE INSTALLED OVER FIREPLACE 25Apr18 Note: IN FAMILY ROOM-		
1 - LIGHT AND SWITCH - NO FIXTURE INCLUDED - LIVING ROOM 25Apr18 Note:		
1 - 200 AMP ELECTRICAL SERVICE 25Apr18 Note:		

PLUMBING

1 - TOE TESTERS TO REMAIN IN CONVERTED TUB TO SHOWERS IN ENSUITE 2 AND ENSITE 3- DO NOT DELETE 27Jun18 Note:	NEW	★
2 - 5 FOOT SHOWER WITH SLIDING GLASS CHROME DOORS IN LIEU OF TUB- ENSUITE 2 AND ENSUITE 3 27Jun18 Note:	NEW	★
1 - TOE TESTER - ADD TOE TESTER TO SHOWER 25Apr18 Note: IN MASTER ENSUITE SHOWER-		

PROMOTIONAL



1 - PARTIAL REDEMPTION OF PROMOTIONAL PACKAGE \$3,600 BALANCE FORWARD \$4,780 TO BE USED AT A LATER DATE. ORIGINAL PROMOTIONAL PACKAGE OF \$8,380 AS PER PE #22859 27Jun18 Note:	
1 - PARTIAL REDEMPTION OF PROMOTIONAL PACKAGE \$\$\$\$\$\$ BALANCE FORWARD TO BE USED AT A LATER DATE. ORIGINAL PROMOTIONAL PACKAGE OF \$\$\$\$\$\$ AS PER SCHEDULE PE DATED MMMDDYYYY. 25Apr18 Note: NEW PROMO BALANCE \$8380.00	

EXTRAS AS PER OFFER

The Vendor agrees that notwithstanding any other term or provision in this Agreement included in the Purchase Price and in addition to those items detailed in Schedule GP to the Agreement of Purchase and Sale, the Purchaser is entitled to a credit of Ten Worksheet Note:	
The Purchaser acknowledges that the Purchase Price is inclusive of all credits and promotional packages available at the time of purchase. Worksheet Note:	


This Document is Extremely Time Sensitive - Printed 27 Jun 18 at 17:04

enpark
GROUP

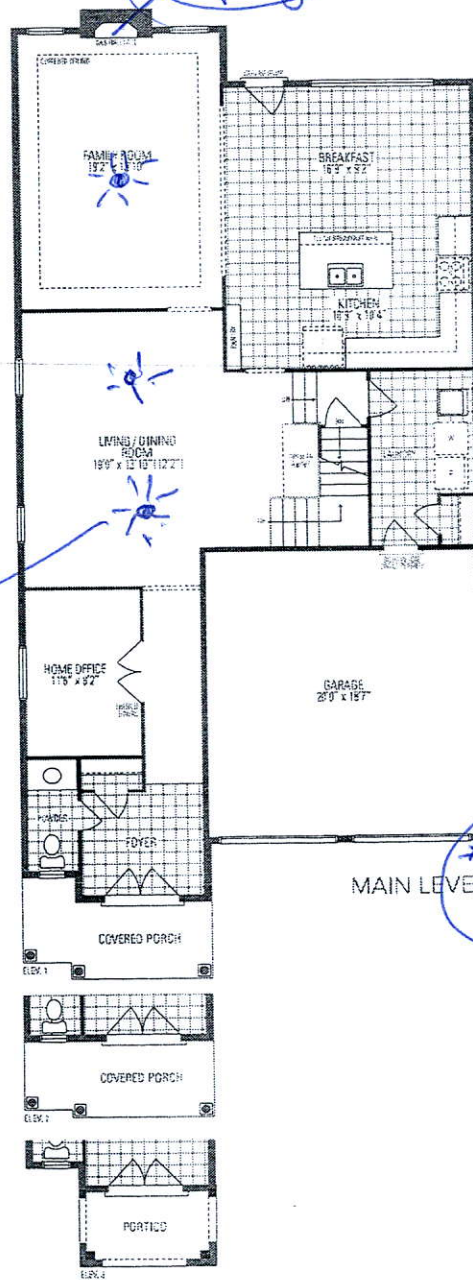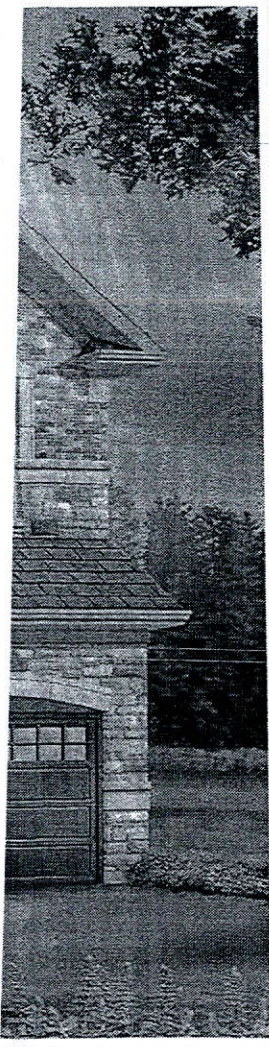


MAIN LEVEL

200 AMP

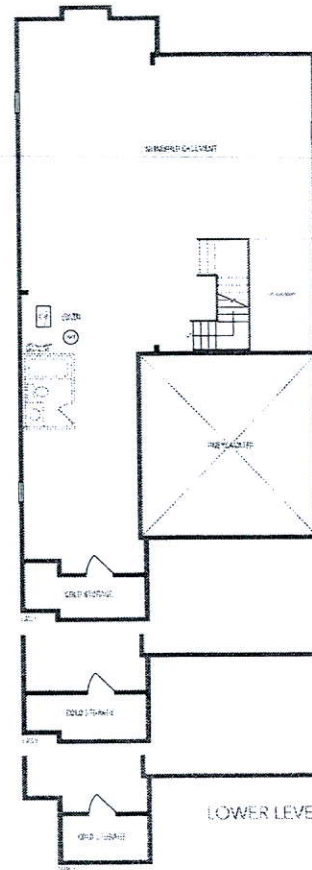

LOWER LEVEL

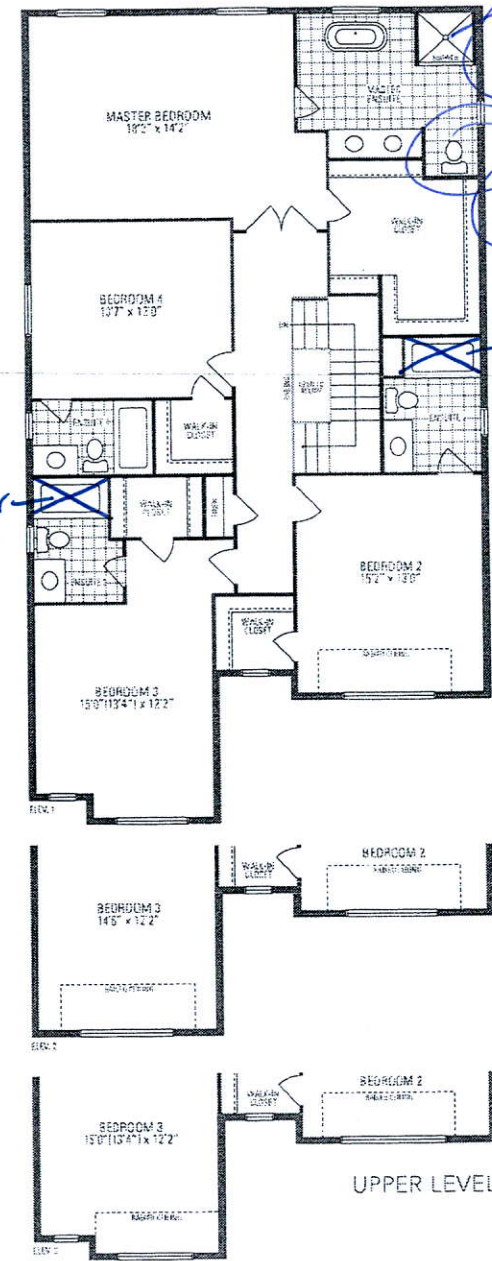

UPPER LEVEL

ROSEWOOD 7

3,205 sq.ft. includes 12 sq.ft. of open area

Orientation of home may be reversed and purchaser agrees to accept the same. Steps and porches may vary at any exterior entrance ways due to grading variations. Actual usable floor space may vary from the stated floor area. All renderings are artist's concept. Dimensions, specifications and architectural detailing subject to minor modifications. Final location of sump pump is based on site conditions. Profile and adjoining model types may vary due to lotting. E. & J.E. Rosewood 7 • Copyright Sept. 2017