



CONSTRUCTION SUMMARY

RECEIVED JUL 04 2018

Mountainview Heights (G) - Russell Gardens Building Ltd.

PURCHASERS: JACEK KRZYWICKI and AGNIESZKA KRZYWICKI

TEL: RES.: 416-458-4904

LOT / PHASE	REG. PLAN #	HOUSE TYPE		
Block 200 TH 5 / 2	62M-1238	Highgrove 5ES Elev 1		

PLUMBING

1 - WASHROOM - 3 PIECE ROUGH-IN IN BASEMENT

03Jul18 Note:

PROMOTIONAL

1 - PARTIAL REDEMPTION OF PROMOTIONAL PACKAGE \$6860.00 BALANCE FORWARD TO BE USED AT A LATER DATE. ORIGINAL PROMOTIONAL PACKAGE OF \$7500.00 AS PER SCHEDULE PE

03Jul18 Note:

EXTRAS AS PER OFFER

The Vendor agrees that notwithstanding any other term or provision in this Agreement included in the Purchase Price and in addition to those items detailed in Schedule GP to the Agreement of Purchase and Sale, the Purchaser is entitled to a credit of Sev

Worksheet Note:

Five (5) White Appliances as per PE Appliances

Worksheet Note:

SHIFT ISLAND 8INCH INTO KITCHEN AREA. AS PER ATTACHED ENGINEERING SKETCH DATED MARCH 28, 2018.

Worksheet Note:

REMOVE LINEN CLOSET, BEDROOM DOOR, WALLS AND CLOSET TO MAKE OPEN LOUNGE AREA. . AS PER ATTACHED ENGINEERING SKETCH DATED MARCH 28, 2018.

Worksheet Note:

REMOVE MASTER ENSUITE TUB AND RELOCATE TOILET. AS PER ATTACHED ENGINEERING SKETCH DATED MARCH 28, 2018.

Worksheet Note:

ADD LINEN SHELVES TO MASTER WALK-IN CLOSET. AS PER ATTACHED ENGINEERING SKETCH DATED MARCH 28, 2018.

Worksheet Note:

ADD SEAT TO SHOWER AND MAKE FRAMELESS GLASS. AS PER ATTACHED ENGINEERING SKETCH DATED MARCH 28, 2018.

Worksheet Note:

REMOVE DOOR FROM BEDROOM TO SHARED ENSUITE. AS PER ATTACHED ENGINEERING SKETCH DATED MARCH 28, 2018.

Worksheet Note:

EXTEND VANITY WITH SECOND SINK. AS PER ATTACHED ENGINEERING SKETCH DATED MARCH 28, 2018.

Worksheet Note:

The Purchaser acknowledges that the Purchase Price is inclusive of all credits and promotional packages available at the time of purchase.

Worksheet Note:


This Document is Extremely Time Sensitive - Printed 3 Jul 18 at 17:13

BLK.200 TH.5
RUSSEL GARDENS
PHASE 2

HIGHGROVE 5ES
ELEV. 1

REVISION:

1. SHIFT ISLAND 8" INTO KITCHEN AREA.

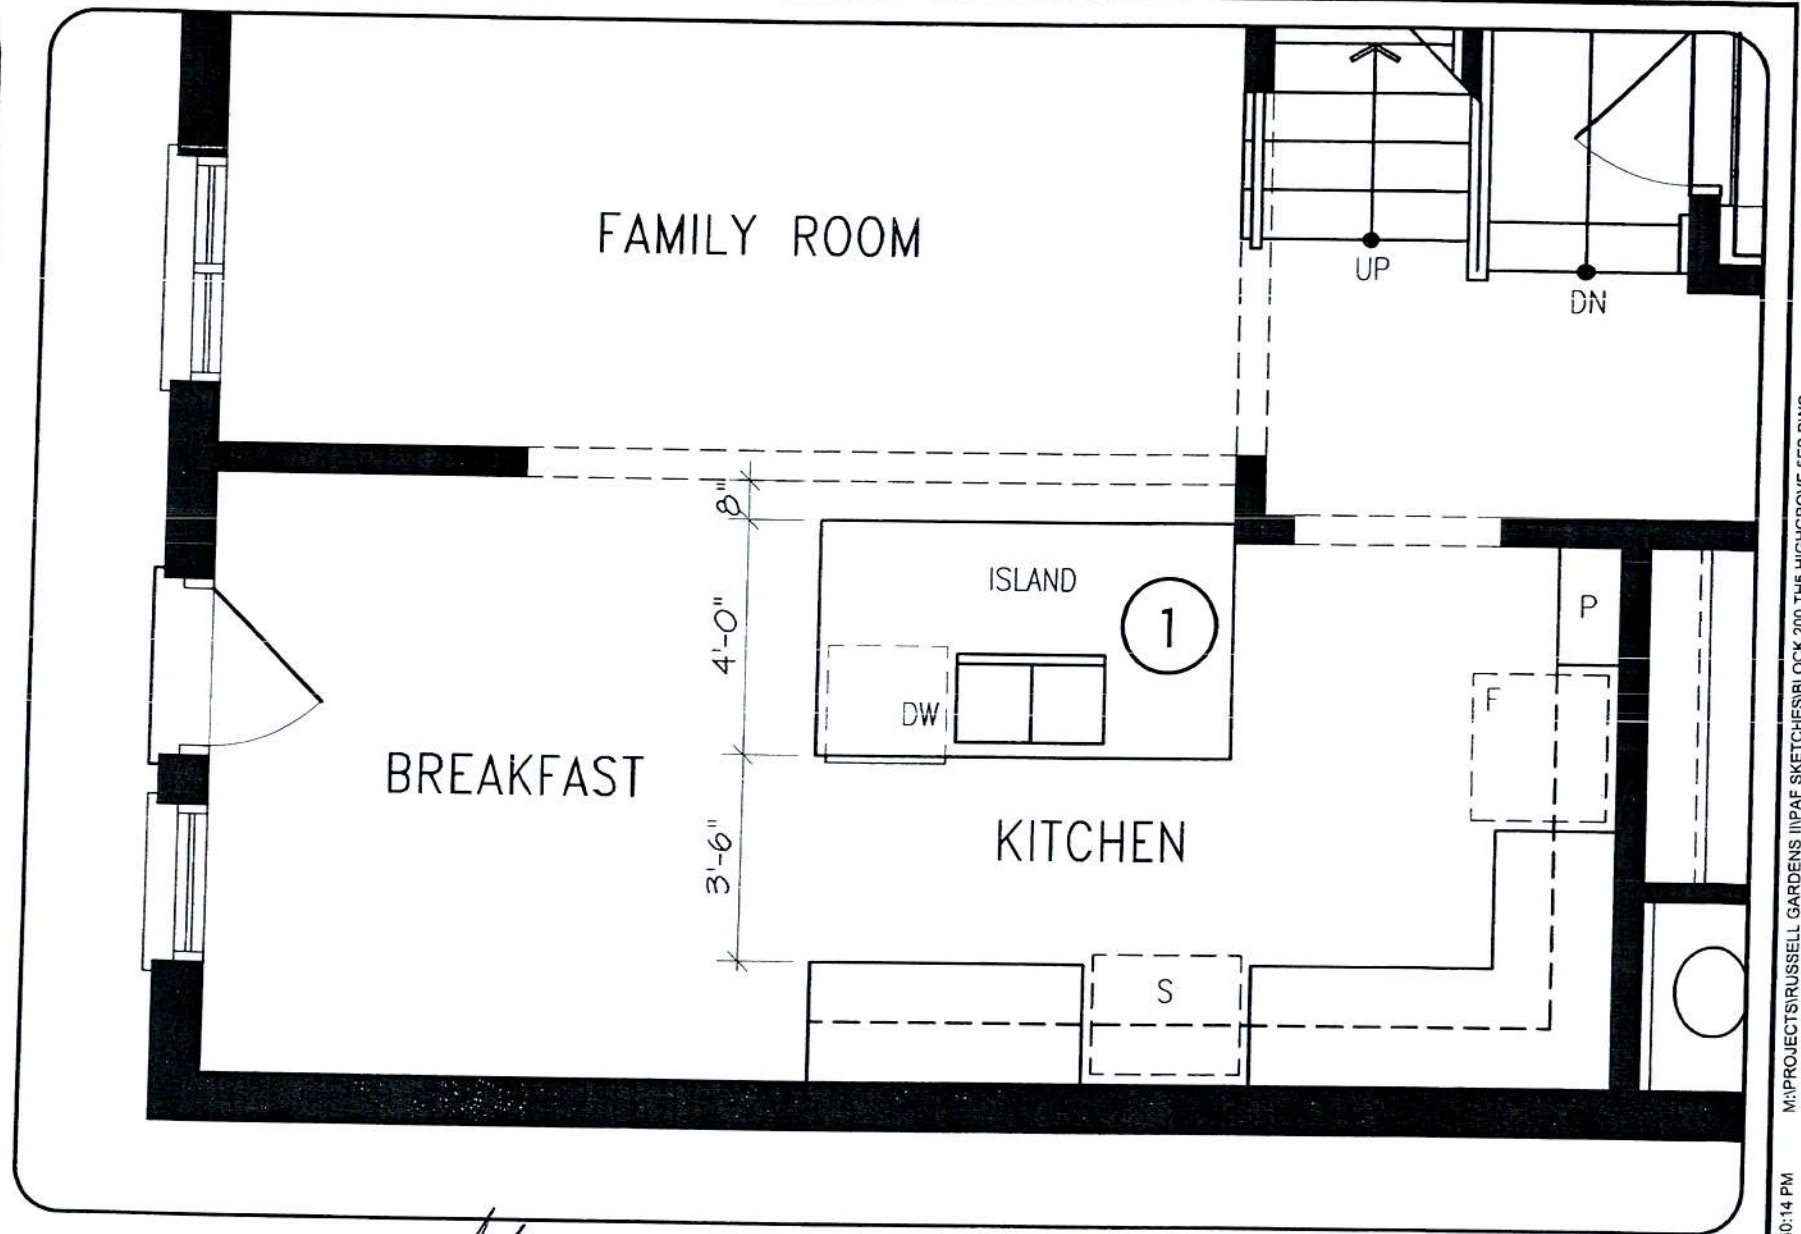

MAIN LEVEL

DISCLAIMERS: SKETCH NOT TO SCALE. DIMENSIONS, SPECIFICATIONS AND ARCHITECTURAL DETAILS SUBJECT TO MODIFICATION BY THE VENDOR. SKETCH IS ONLY FOR THE PURPOSE OF ILLUSTRATING REVISIONS REQUESTED BY THE PURCHASER AND ALL REVISIONS ARE SUBJECT TO VENDOR'S FINAL APPROVAL. ONLY REVISIONS ACCEPTED IN WRITING BY THE PURCHASER AND VENDOR ON A PURCHASER'S EXTRA SHEET WILL BE INCORPORATED INTO THE PLANS FILED WITH THE MUNICIPALITY. E. & O.E.

REGION
DESIGN
INC.

SCALE
BY MB

N.T.S.
PAGE No.
1 OF 3


Greenpark.

BLK.200 TH.5
RUSSEL GARDENS
PHASE 2

HIGHGROVE 5ES
ELEV. 1

REVISIONS:

1. REMOVE MASTER ENSUITE TUB AND RELOCATE TOILET. EXTEND VANITY WITH SECOND SINK. ADD SEAT TO SHOWER AND MAKE FRAMELESS GLASS.
2. ADD LINEN SHELVES TO MASTER WALK-IN CLOSET.

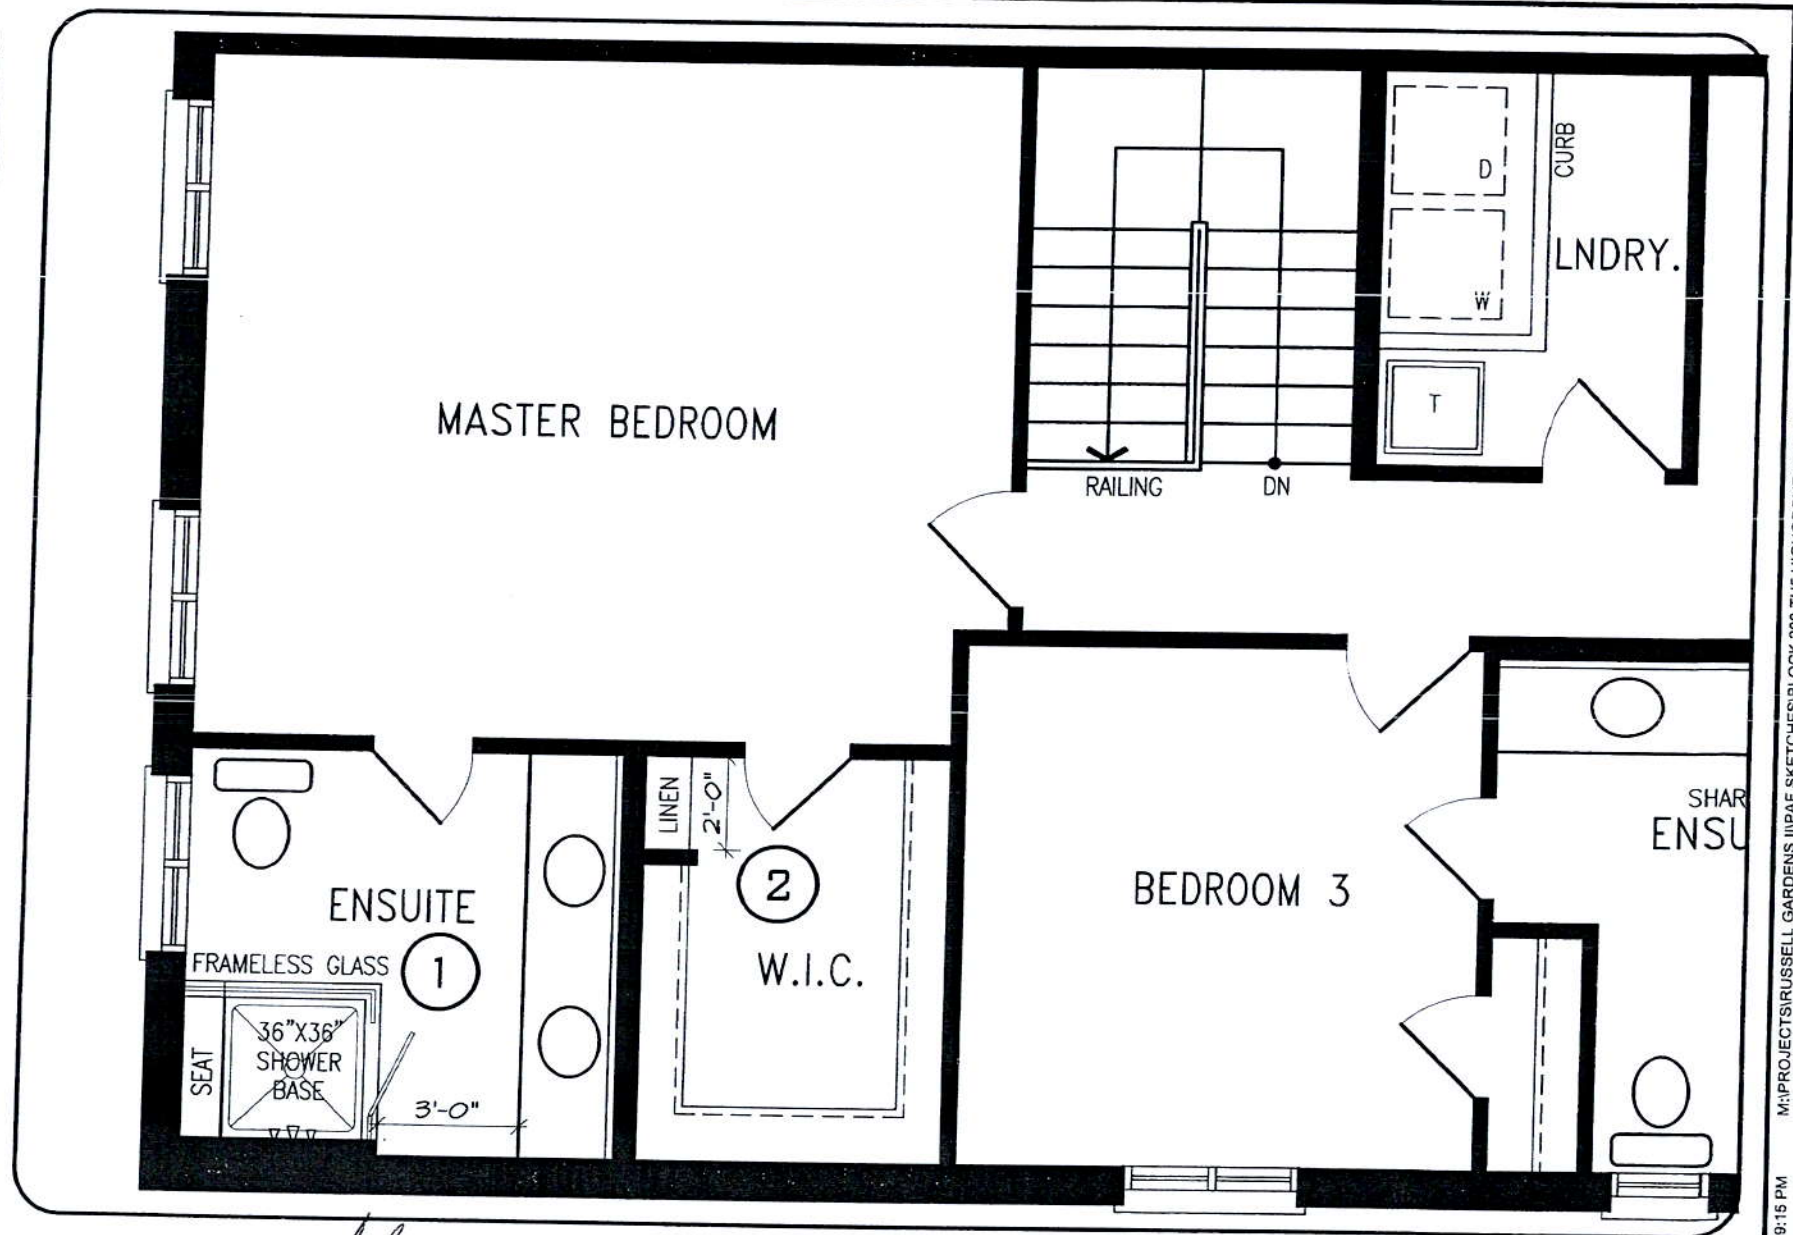

UPPER LEVEL

DISCLAIMERS: SKETCH NOT TO SCALE. DIMENSIONS, SPECIFICATIONS AND ARCHITECTURAL DETAILS SUBJECT TO MODIFICATION BY THE VENDOR. SKETCH IS ONLY FOR THE PURPOSE OF ILLUSTRATING REVISIONS REQUESTED BY THE PURCHASER AND ALL REVISIONS ARE SUBJECT TO VENDOR'S FINAL APPROVAL. ONLY REVISIONS ACCEPTED IN WRITING BY THE PURCHASER AND VENDOR ON A PURCHASER'S EXTRA SHEET WILL BE INCORPORATED INTO THE PLANS FILED WITH THE MUNICIPALITY. E. & O.E.

REGION
DESIGN
INC.

SCALE
BY MB

N.T.S.
PAGE No.
2 OF 3


Greenpark

BLK.200 TH.5
RUSSEL GARDENS
PHASE 2

HIGHGROVE 5ES
ELEV. 1

REVISIONS:

1. REMOVE LINEN CLOSET, BEDROOM DOOR, WALLS AND CLOSET TO MAKE OPEN LOUNGE AREA.
2. REMOVE DOOR FROM BEDROOM TO SHARED ENSUITE.

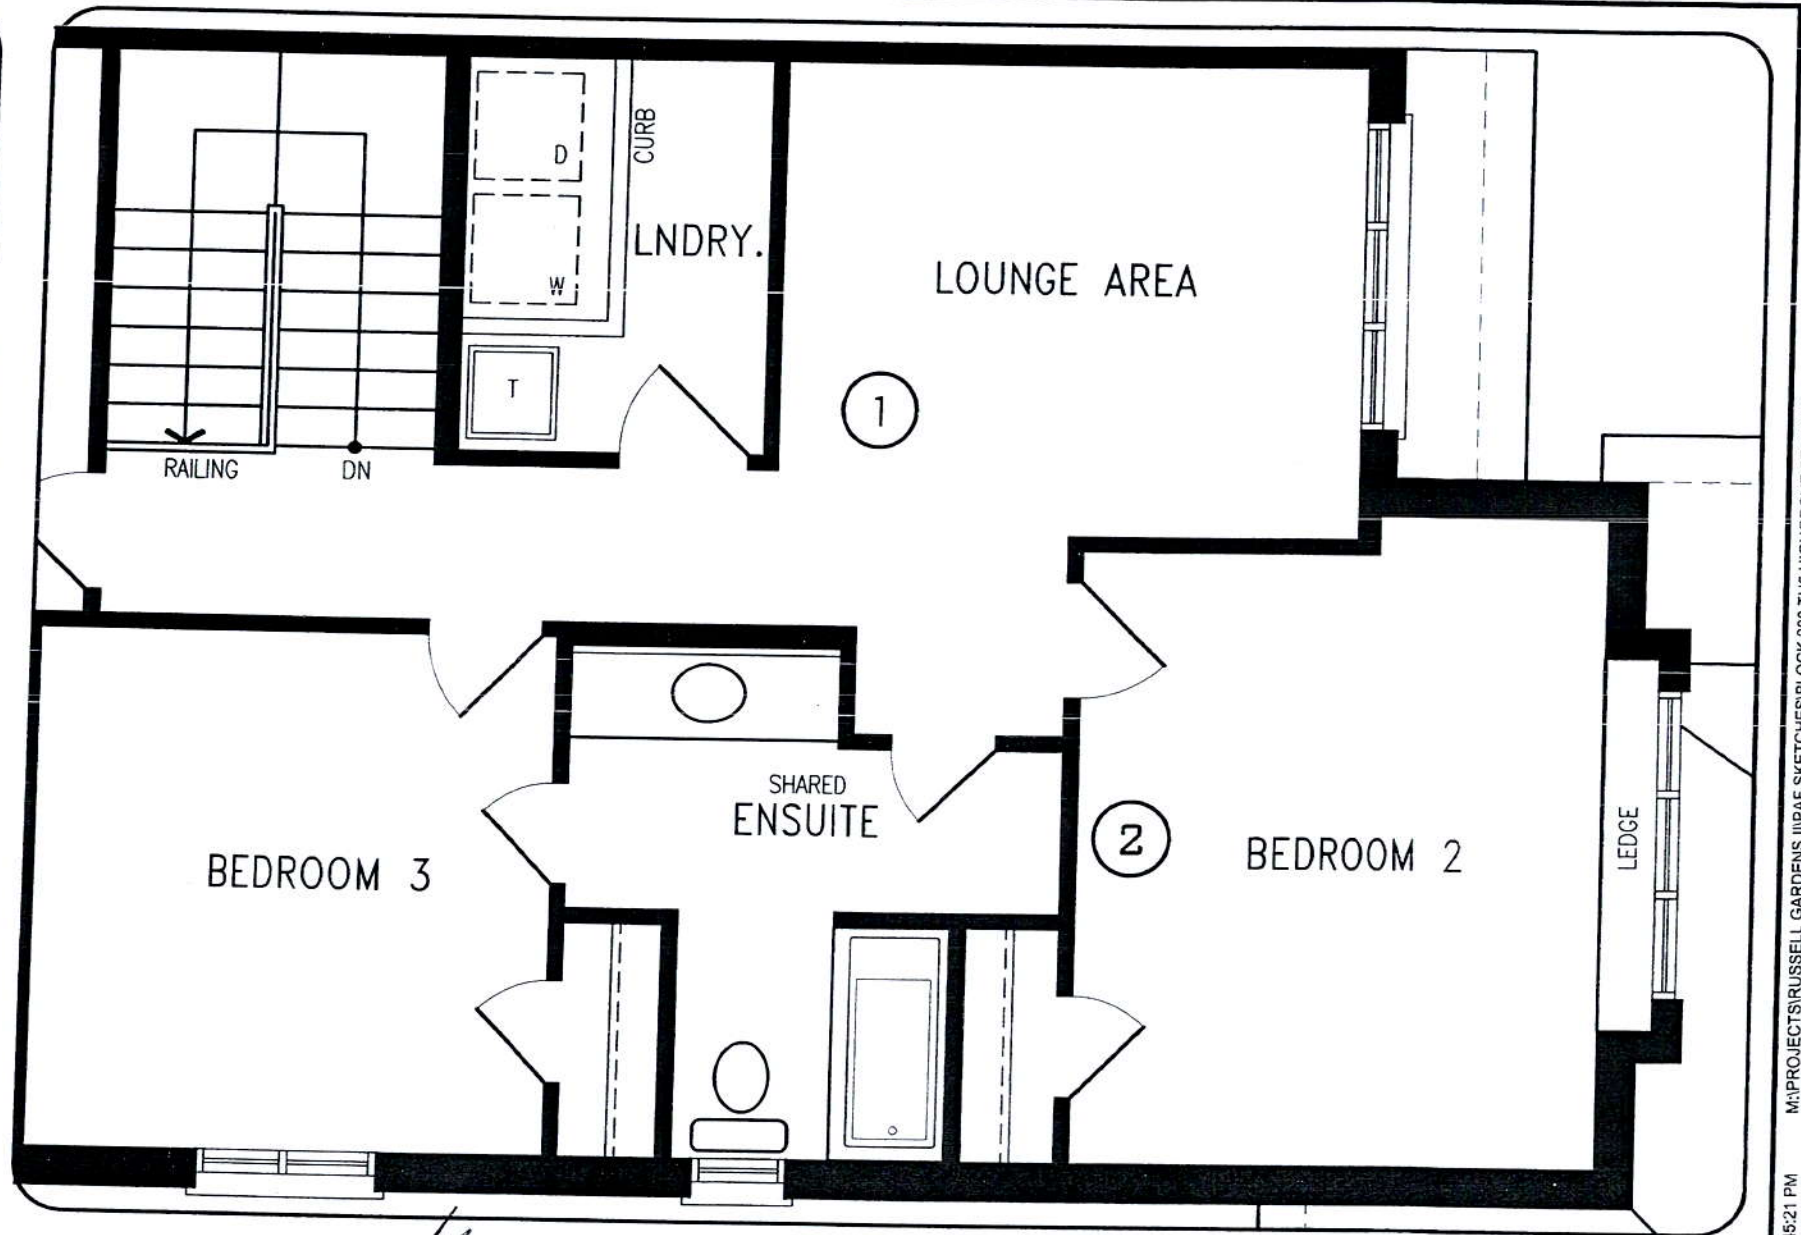

UPPER LEVEL

DISCLAIMERS: SKETCH NOT TO SCALE. DIMENSIONS, SPECIFICATIONS AND ARCHITECTURAL DETAILS SUBJECT TO MODIFICATION BY THE VENDOR. SKETCH IS ONLY FOR THE PURPOSE OF ILLUSTRATING REVISIONS REQUESTED BY THE PURCHASER AND ALL REVISIONS ARE SUBJECT TO VENDOR'S FINAL APPROVAL. ONLY REVISIONS ACCEPTED IN WRITING BY THE PURCHASER AND VENDOR ON A PURCHASER'S EXTRA SHEET WILL BE INCORPORATED INTO THE PLANS FILED WITH THE MUNICIPALITY. E. & O.E.

REGION
DESIGN
INC.

SCALE
N.T.S.
BY MB
PAGE No.
3 OF 3

Greenpark