



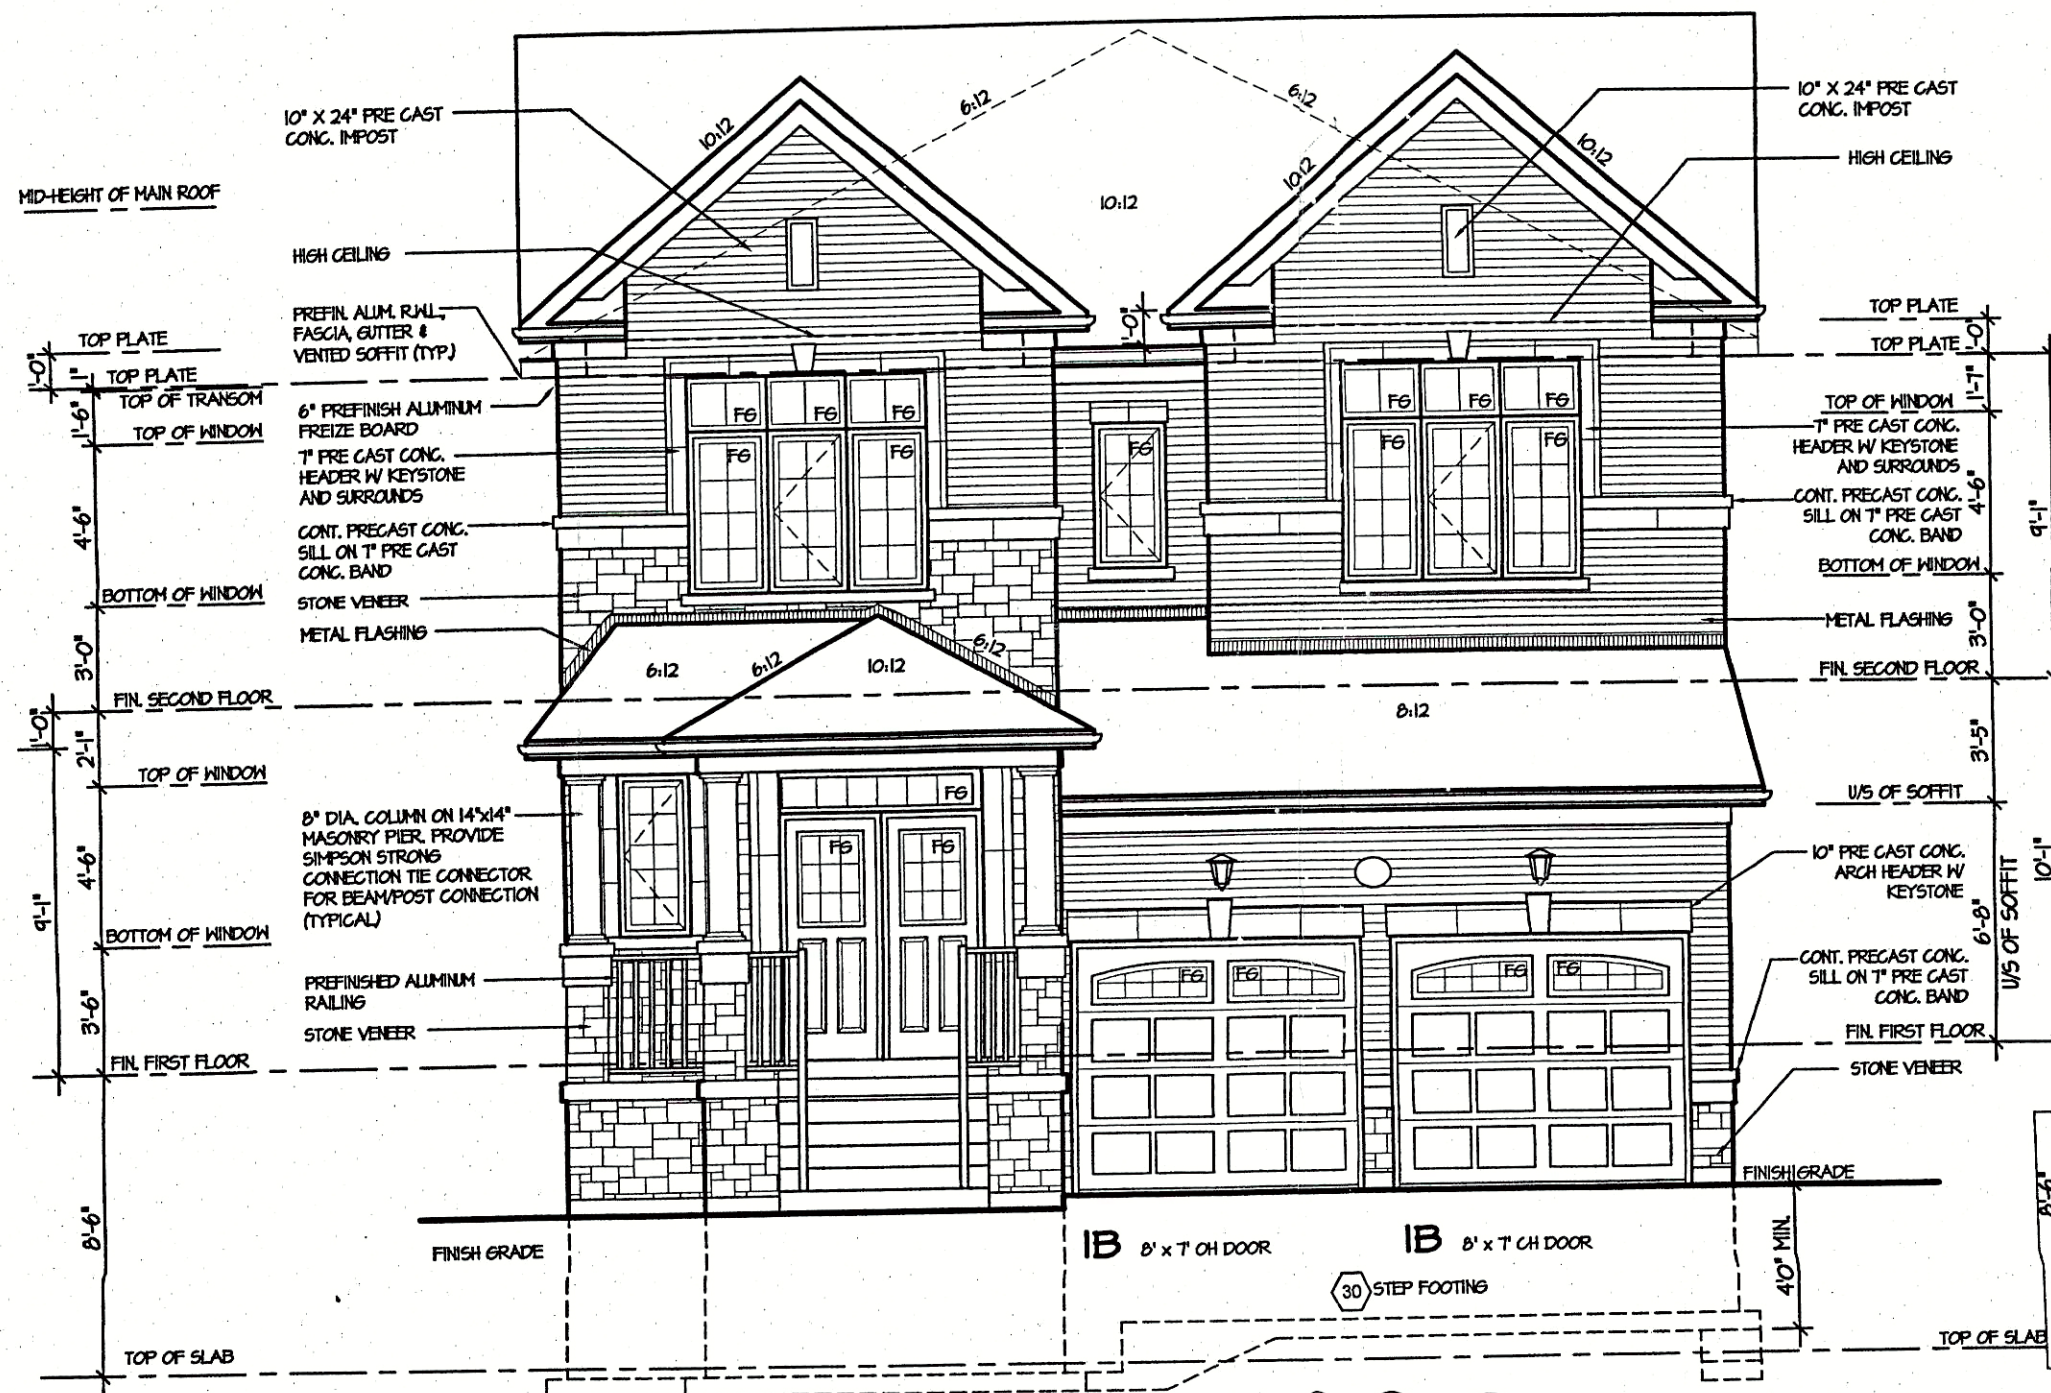

FRONT ELEVATION 2
FOR LOT 164

DROPPED FROM GRADE CONDITION CHANGES:
- GARAGE ROOF DROPPED 1'4"
- GARAGE ROOF SLOPE INCREASED TO 8:12

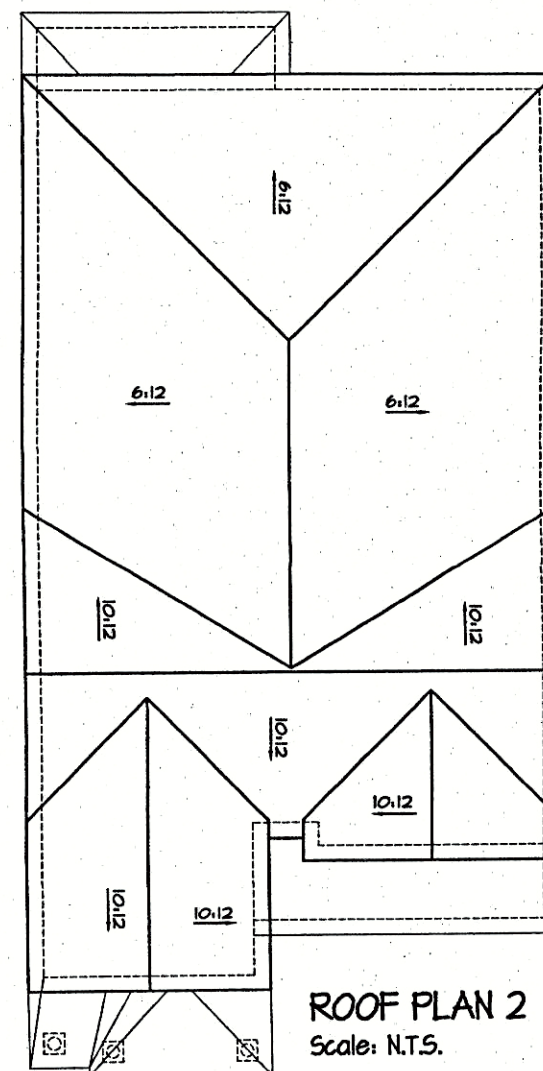

CITY OF HAMILTON
Building Division

Permit No. 18-110747

THESE STAMPED DRAWINGS SHALL BE AVAILABLE ON SITE

THE OWNER AND/OR CONTRACTOR SHALL COMPLY WITH
THE ONTARIO BUILDING CODE AND ALL OTHER APPLICABLE LAW

These drawings and/or specifications have been reviewed by

FOR CHIEF BUILDING OFFICIAL 6/18/18 DATE

CITY OF HAMILTON
BUILDING DIVISION
Planning & Development Department

JUN 01 2018

REC BY _____ DATE _____
REF'D TO _____ DATE _____

It is the builder's complete responsibility to ensure that all plans submitted for approval fully comply with the Architectural Guidelines and all applicable regulations and requirements including zoning provisions and any provisions in the subdivision agreement. The Control Architect is not responsible in any way for examining or approving site (lotting) plans or working drawings with respect to any zoning or building code or permit matter or that any house can be properly built or located on its lot.

This is to certify that these plans comply with the applicable Architectural Design Guidelines approved by the City of HAMILTON

ARCHITECTURAL REVIEW APPROVAL

DATE: 6/18/18

John C. [Signature] & [Signature] Architects

APR 27 2018

ROSEWOOD 7
COMPLIANCE PACKAGE "A1"

5.		
4.		
3.		
2.		
1.	ISSUED FOR REVIEW	NOV 2016
REVISIONS		

The undersigned has reviewed and takes responsibility for this design, and has the qualifications and meets the requirements set out in the Ontario Building Code to be a designer.

QUALIFICATION INFORMATION
Required unless design is exempt under Division C, Subsection 3.2.5 of the building code

VIKAS GAJJAR
NAME
28770
BCIN

SIGNATURE

REGION DESIGN INC.
8700 DUFFERIN ST.
CONCORD, ONTARIO
L4K 4S6
P (416) 736-4096
F (905) 660-0746

REGION DESIGN INC.

SHEET TITLE
FRONT ELEVATION ELEV. 2

SCALE 3/16"=1'-0"
DATE APR 2018

BY B.K.
TYPE

CONTRACTOR SHALL CHECK ALL DIMENSIONS AND ELEVATIONS BEFORE COMMENCING WITH WORK AND REPORT ANY DISCREPANCIES TO THE DESIGNER. PRINTS ARE NOT TO BE SCALED.

AREA 3,205
PAGE No. 4-2A
PROJECT 03-13-09

Greenpark

PROJECT NAME
RUSSEL GARDENS II