
K.D. HOLLINGWORTH 100152747

This is to certify that these plans comply with the applicable Architectural Design Guidelines approved by the City of HAMILTON.

04

John G. Willia S Limited, Architect



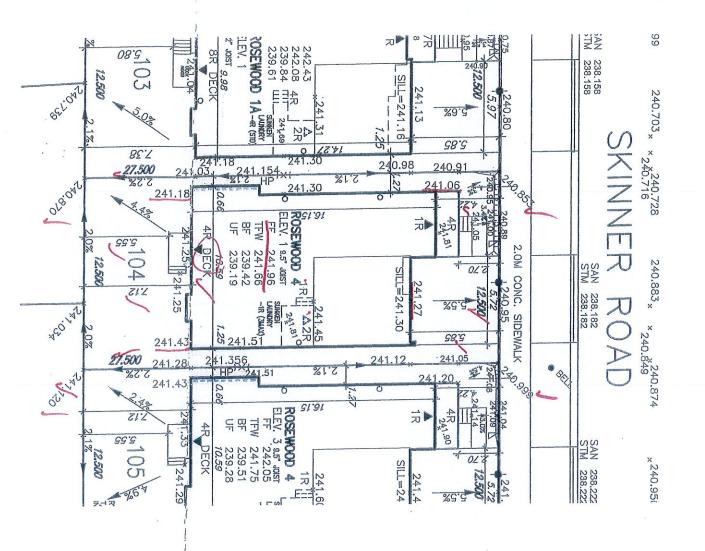

THESE STAMPED DRAWINGS SHALL BE AVAILABLE ON SITE THE OWNER AND/OR CONTRACTOR SHALL COMPLY WITH ONTARIO BUILDING CODE AND ALL OTHER APPLICABLE LAW

for specifications have been reviewed by JUL 1 9 2018

0

104

Stading Notes: It shall be the resp engineer: These gra having jurisdiction.

ibility of the builder to have all grades and services and the placement of storm and sanitary services.

s verified and checked before construction by an approved grading off the street are to meet the requirements of the municipality

WIDTH (M) (© 6.0m)

(M<sup>2</sup>)

M3 Design Inc. is to be notified promptly of any building can be re-sited. Failure to observe these cost to M3 Design Inc. Foundation wall shall be p

discrepancies at least 1 (ane) week prior to excavation commences in order that the conditions may require expensive remedial action that will not be the responsibility of or source to a minimum of  $\delta^n$  above approved grades.

and do not no

Finished grade lines as ind 11ty particular lot.

ted on the house

drawings are to be read in conju

NSTALL	CONTRA	IL FE	OTE:
INSTALLATION.	CTOR	NCING	NOTE: REFER TO LANDSCAPE DRAWINGS FOR
	TO VI	TYPE	70 [
	YES P	S. 活	ANDS
Section of the sectio	PRIOR	SILS	APE
	70	AND	DRAW
		LOCA	NGS

ACTOR TO VERIFY PRIOR TO ATTOM.
CATIONS.

No. OF RISERS

\*\*RANKED FLOOR ELEVATION

\*\*PARKED FLOOR ELEVATION

\*\*PARKED FLOOR SLAB

TOP OF ENWANTION WALL

UNDERSIDE FOOTING AT REAR

UNDERSIDE FOOTING AT REAR

UNDERSIDE FOOTING AT REAR

UNDERSIDE FOOTING AT SIDE

\*\*WALK OUT DECK\*\*

\*\*W

DESIGN

RUSSELL GARDENS PHASE 2

PE PLAN)

AC

AC

AR COMMINISTE DIVINIST

AND AR COMMINISTE DIVINIST

AND AND WITE DIVINISTOUT I

COSCHARGE ONTO SEPACE

SIDE WANDOW LOCATION

CONTROL

CONT

AIR CONDITIONER REQUIRED
RAW WATER DOWNSPOUT LOCATION
CIDSTANCE ONTO SERVISAPAD)
SIDE WANDOW LOCATION
EXTEROR DOOR LOCATION
REDUCE SIDE YARD

PROVIDE 3/4" DIA, CLEAR STONE IN THIS AREA

	AND DESCRIPTION OF THE PARTY OF	
1		nor
		north arrow

104 ared plan no.