

It is the builder's complete responsibility to ensure that all plans submitted for approval fully comply with the Architectural Guidelines and all applicable regulations and requirements including zoning provisions and any provisions in the subdivision agreement. The Control Architect is not responsible in any way for examining or approving site (lotting) plans or working drawings with respect to any zoning or building code or permit matter or that any house can be properly built or located on its lot.


This is to certify that these plans comply with the applicable Architectural Design Guidelines approved by the City of HAMILTON.

ARCHITECTURAL REVIEW APPROVAL

MAY 10 2018

John G. Williams Limited, Architect

THIS LOT GRADING PLAN HAS BEEN REVIEWED BY METROPOLITAN CONSULTING INC. FOR CONFORMANCE WITH THE APPROVED SUBDIVISION GRADING PLAN. THE PROPOSED GRADES ON THIS PLAN ARE IN GENERAL CONFORMANCE WITH THE APPROVED GRADING PLAN AS IT RELATES TO THIS LOT AND ADJACENT LOTS. WHERE THE BASEMENT FLOOR OR OTHER FOUNDATION ELEVATIONS ARE PROPOSED AT A DIFFERENCE ELEVATION THAN THAT SHOWN ON THE APPROVED SUBDIVISION PLANS THE SEWER LATERALS HAVE BEEN REVIEWED AND WE ARE SATISFIED THAT THE MINIMUM GRADES FOR THESE LATERALS CAN BE MAINTAINED IN ACCORDANCE WITH THE REQUIREMENTS OF THE O.B.C. AND CITY DESIGN CRITERIA. NOTE THIS CERTIFICATION DOES NOT REPLACE THE BUILDER'S RESPONSIBILITY TO EXPOSE THE SEWER LATERALS AND CONFIRM ELEVATIONS PRIOR TO EXCAVATING FOR THE FOUNDATION. BY USE OF THIS PLAN THE BUILDER AGREES THAT THEY SHALL BE RESPONSIBLE FOR IMMEDIATELY REPORTING TO METROPOLITAN CONSULTING ANY DISCREPANCY OR VARIATION BETWEEN THE LATERAL INFORMATION AND GRADES DEPICTED ON THIS PLAN AND THE CONDITIONS FOUND IN THE FIELD.

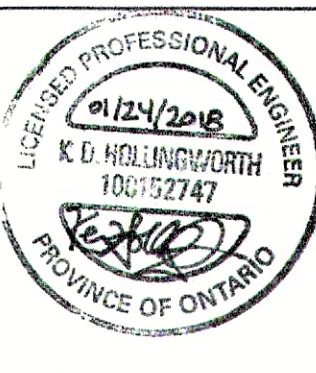

NO FIREWALL  
ORDINARY CONSTRUCTION

MAIN UNDERSIDE OF FOOTING (UF) SHOWN IS FOR STANDARD 0.20 (8") DEEP EXTERIOR WALL STRIP FOOTING ONLY.

NOTE: REFER TO LANDSCAPE DRAWINGS FOR ALL FENCING TYPES, HEIGHTS AND LOCATIONS. CONTRACTOR TO VERIFY PRIOR TO INSTALLATION.

BLOCK 200		
BLOCK No.	LOT WIDTH (M) (± 6.0m)	LOT AREA (M <sup>2</sup> )
200-1	9.44	419.78
200-2	7.50	247.30
200-3	7.50	223.76
200-4	7.50	211.26
200-5	12.34	295.90

**Grading Notes:**  
It shall be the responsibility of the builder to have all grades and services verified and checked before construction by an approved grading engineer. These grades and the placement of storm and sanitary services off the street are to meet the requirements of the municipality having jurisdiction.

VA3 Design Inc. is to be notified promptly of any discrepancies at least 1 (one) week prior to excavation commences in order that the building can be re-sited. Failure to observe these conditions may require expensive remedial action that will not be the responsibility of or cost to VA3 Design Inc. Foundation wall shall be poured to a minimum of 6" above approved grades.

Finished grade lines as indicated on the house prototype are for reference only and do not necessarily depict finish grading conditions of any particular lot.

These drawings are to be read in conjunction with municipal approved site engineering drawings prepared by Metropolitan Consulting Inc.



1 ISSUED FOR CLIENT USE. AUG. 28/17 GW

2 ISSUED FOR PERMIT. OCT. 16/17 GW

3 REVISED PER BLDG. COMMENTS. DEC. 13/17 GW

4

5

6

PROPOSED VALUE

LP LIGHT POLE

HYDRANT

TRANSFORMER

WATER SERVICE

DOUBLE STL/SAN. CONNECTION

SINGLE STL/SAN. CONNECTION

CATCH BASIN

CABLE TELEVISION PEDESTAL

BELL PEDESTAL

NO. OF RISERS

FF FINISHED FLOOR ELEVATION

UF UNDERSIDE FOOTING ELEVATION

BF FIN. BASEMENT FLOOR SLAB

TFW TOP OF FOUNDATION WALL

UFR UNDERSIDE FOOTING AT REAR

UFF UNDERSIDE FOOTING AT FRONT

UFS UNDERSIDE FOOTING AT SIDE

W.D.B. WALK OUT DECK

W.D.B. WALK OUT DECK

REV REVERSE PLAN

STREET SIGN

SUPER MAIL BOX

RETAINING WALL

1.5m BLACK VINYL CHAIN LINK FENCE

ACOUSTICAL FENCE (SEE LANDSCAPE PLAN)

WOOD SCREEN FENCE (SEE LANDSCAPE PLAN)

HYDRO SERVICE LATERAL

SMALL DIRECTION

EMBANKMENT

PROVIDE 3/4" DIA. CLEAR STONE IN THIS AREA

THIS LOT CONTAINS ENGINEERED FILL

AIR CONDITIONER REQUIRED

RAIN WATER DOWNSPOUT LOCATION (DISCHARGE ONTO SPLASHPAD)

SIDE WINDOW LOCATION

EXTERIOR DOOR LOCATION

REDUCE SIDE YARD

The undersigned has reviewed and takes responsibility for this design and has the qualifications and meets the requirements set out in the Ontario Building Code to be a Designer.

qualification information

Richard Vink 24488 BCN

name registration information

VA3 Design Inc. 42638

Builder to verify location of all hydronics, street lights, transformers and other services. If minimum dimensions are not maintained, builder is to relocate at his own expense. Builder to verify service connection elevations prior to constructing foundations.

**VA3 DESIGN**

255 Consumers Rd Suite 120  
Toronto ON M2J 1R4  
t 416.630.2255 f 416.630.4782  
va3design.com

**Greenpark**

project name  
RUSSELL GARDENS PHASE 2

municipality  
HAMILTON

date  
MAY 2017

checked by  
CW/BCC

scale  
1:250

file name  
16036-RG2-SP

lot/block no.  
BLOCK 200

registered plan no.  
16036

project no.  
16036

drawing no.  
SP1

BLOCK SITING/GRADING