

It is the builder's complete responsibility to ensure that all plans submitted for approval fully comply with the Architectural Guidelines and all applicable regulations and requirements including zoning provisions and any provisions in the subdivision agreement. The Control Architect is not responsible in any way for examining or approving site (lotting) plans or working drawings with respect to any zoning or building code or permit matter or that any house can be properly built or located on its lot.

This is to certify that these plans comply with the applicable Architectural Design Guidelines approved by the City of Hamilton.

ARCHITECTURAL REVIEW & APPROVAL

MAY 10 2018

John G. Williams Limited, Architect

CITY OF HAMILTON
Building Division


Permit No. 17-131847

THESE STAMPED DRAWINGS SHALL BE AVAILABLE ON SITE

THE OWNER AND/OR CONTRACTOR SHALL COMPLY WITH THE ONTARIO BUILDING CODE AND ALL OTHER APPLICABLE LAW

These drawings and/or specifications have been reviewed by

FOR CHIEF BUILDING OFFICIAL DATE AUG 1/18

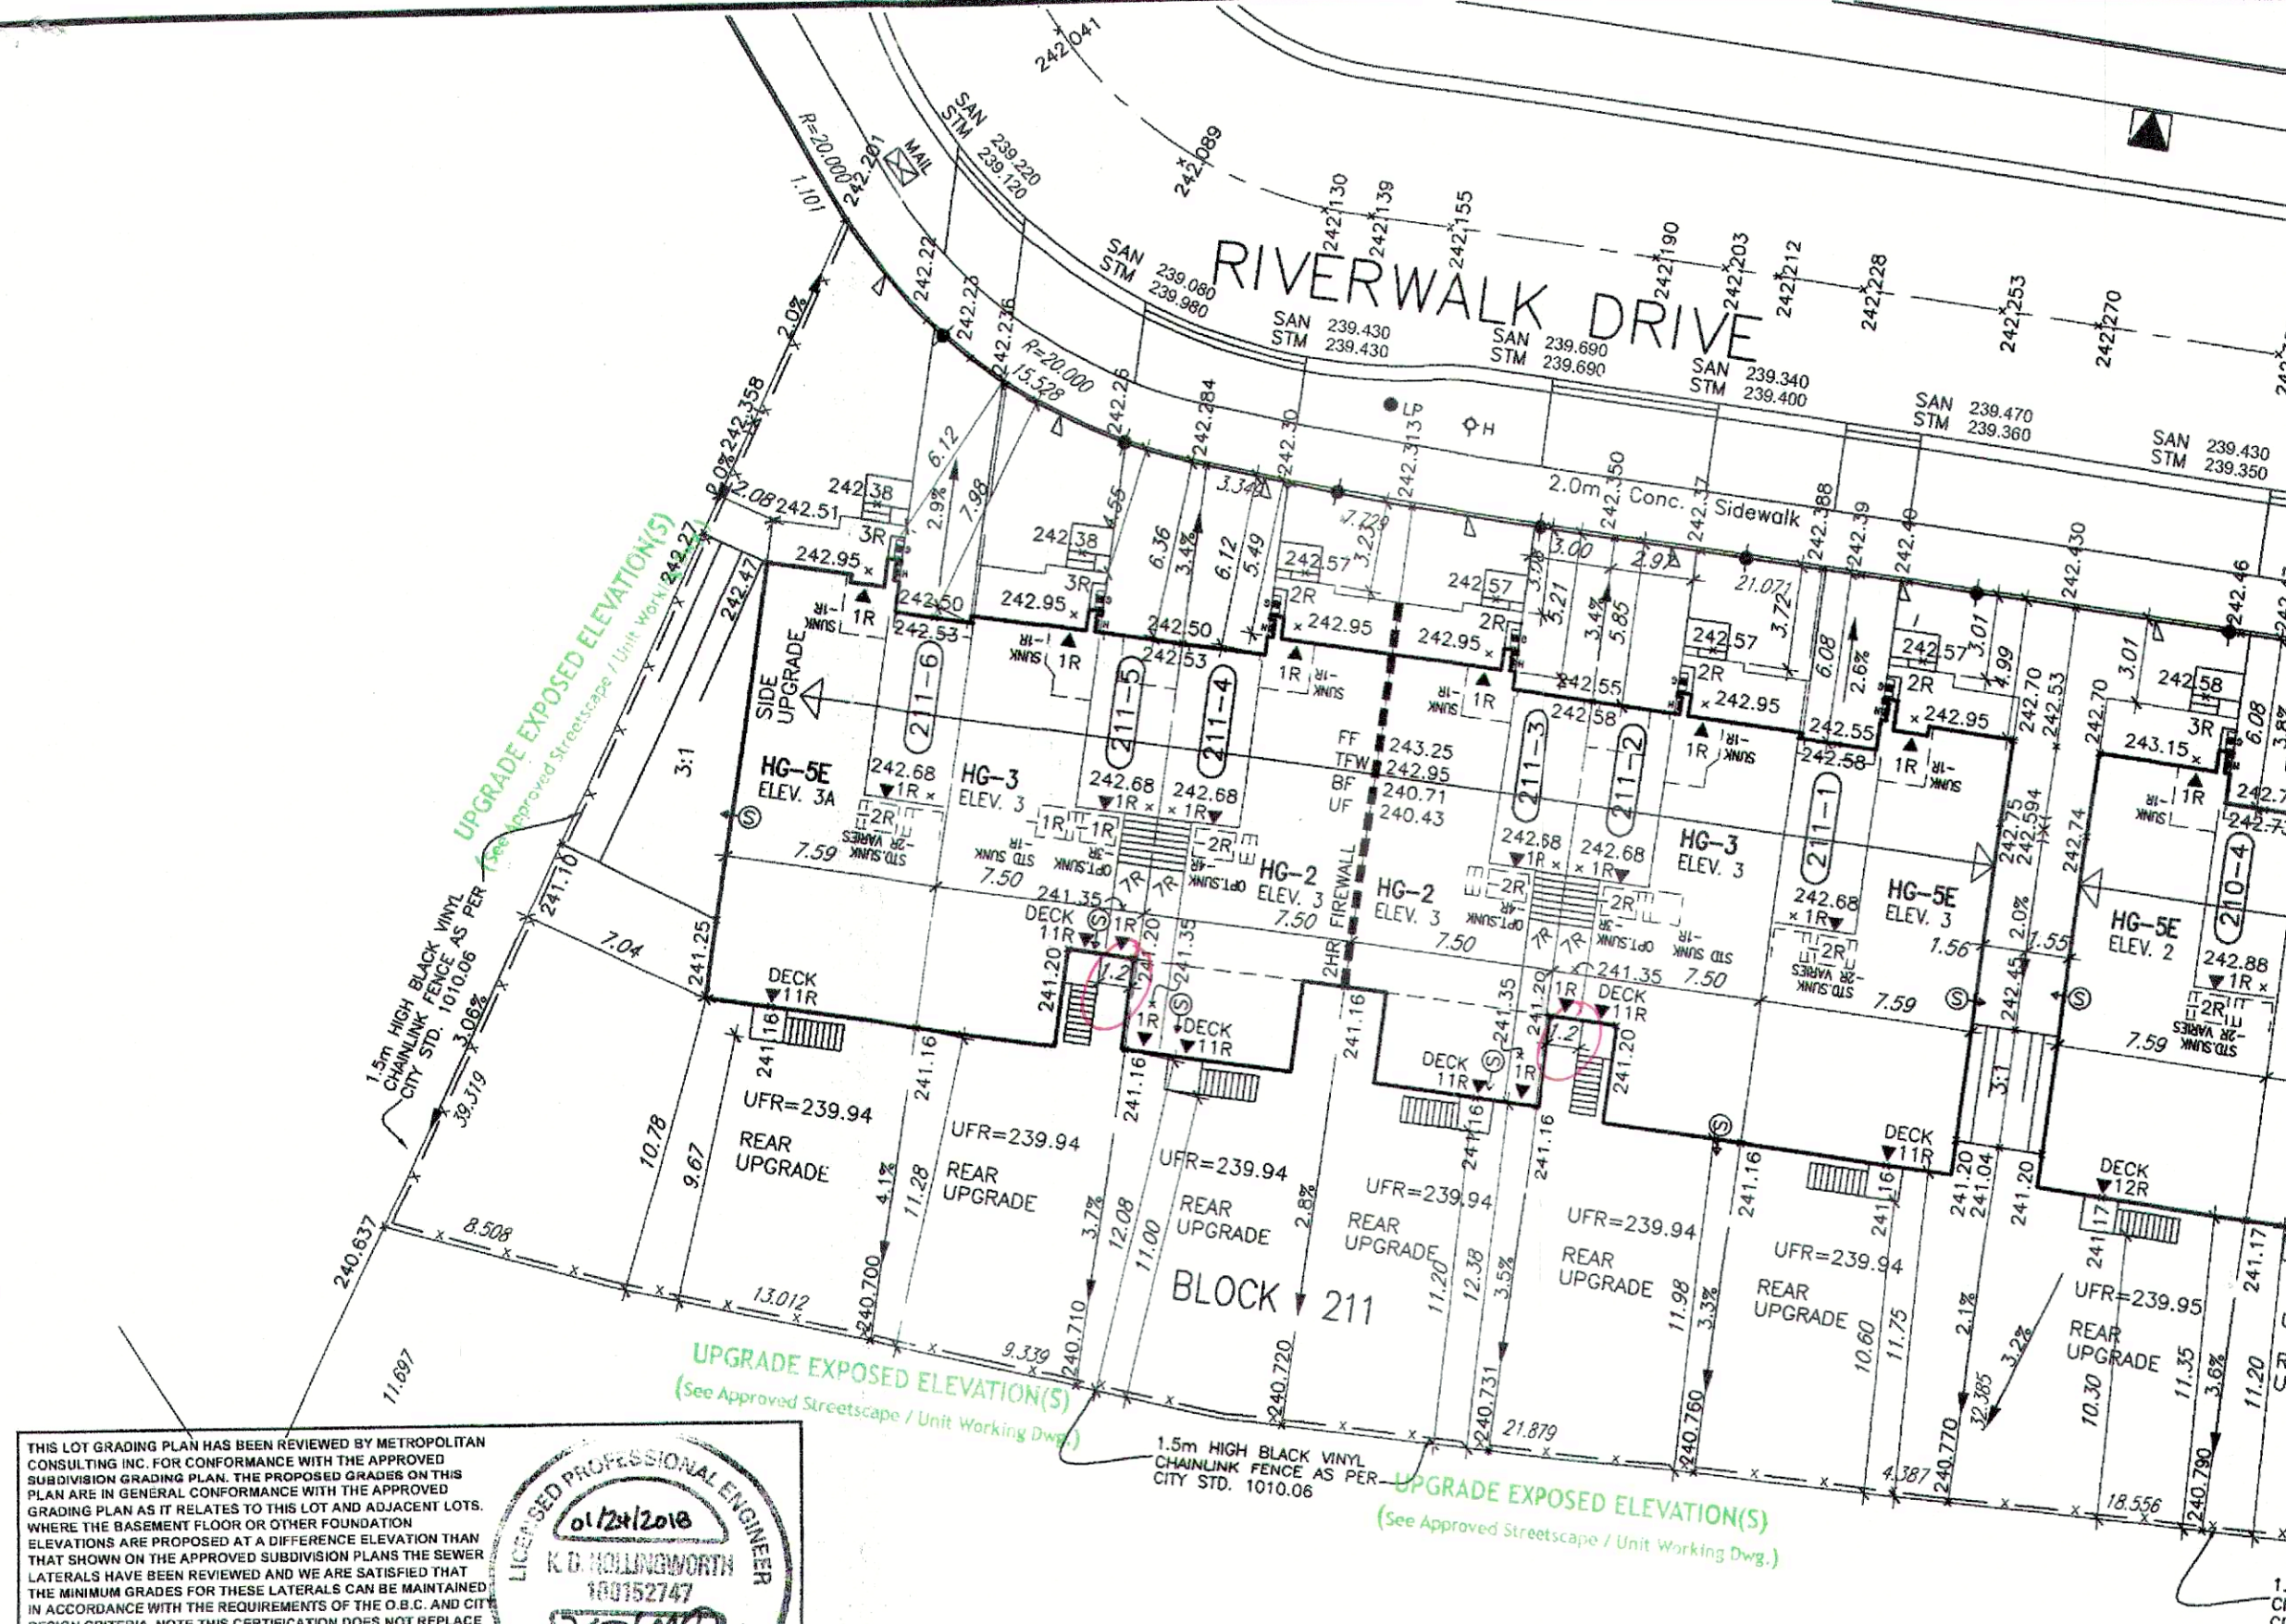

THIS LOT GRADING PLAN HAS BEEN REVIEWED BY METROPOLITAN CONSULTING INC. FOR CONFORMANCE WITH THE APPROVED SUBDIVISION GRADING PLAN. THE PROPOSED GRADES ON THIS PLAN ARE IN GENERAL CONFORMANCE WITH THE APPROVED GRADING PLAN AS IT RELATES TO THIS LOT AND ADJACENT LOTS. WHERE THE BASEMENT FLOOR OR OTHER FOUNDATION ELEVATIONS ARE PROPOSED AT A DIFFERENCE ELEVATION THAN THAT SHOWN ON THE APPROVED SUBDIVISION PLANS THE SEWER LATERALS HAVE BEEN REVIEWED AND WE ARE SATISFIED THAT THE MINIMUM GRADES FOR THESE LATERALS CAN BE MAINTAINED IN ACCORDANCE WITH THE REQUIREMENTS OF THE O.B.C. AND CITY DESIGN CRITERIA. NOTE THIS CERTIFICATION DOES NOT REPLACE THE BUILDER'S RESPONSIBILITY TO EXPOSE THE SEWER LATERALS AND CONFIRM ELEVATIONS PRIOR TO EXCAVATING FOR THE FOUNDATION. BY USE OF THIS PLAN THE BUILDER AGREES THAT THEY SHALL BE RESPONSIBLE FOR IMMEDIATELY REPORTING TO METROPOLITAN CONSULTING ANY DISCREPANCY OR VARIATION BETWEEN THE LATERAL INFORMATION AND GRADES DEPICTED ON THIS PLAN AND THE CONDITIONS FOUND IN THE FIELD.

Grading Notes:
It shall be the responsibility of the builder to have all grades and services verified and checked before construction by an approved grading engineer. These grades and the placement of storm and sanitary services off the street are to meet the requirements of the municipality having jurisdiction.

VA3 Design Inc. is to be notified promptly of any discrepancies at least 1 (one) week prior to excavation commences in order that the building can be re-sited. Failure to observe these conditions may require expensive remedial action that will not be the responsibility of or cost to VA3 Design Inc. Foundation wall shall be poured to a minimum of 6" above approved grades.

Finished grade lines as indicated on the house prototype are for reference only and do not necessarily depict finish grading conditions of any particular lot.

These drawings are to be read in conjunction with municipal approved site engineering drawings prepared by Metropolitan Consulting Inc.

NOTE: REFER TO LANDSCAPE DRAWINGS FOR ALL FENCING TYPES, HEIGHTS AND LOCATIONS. CONTRACTOR TO VERIFY PRIOR TO INSTALLATION.

BLOCK 211		
BLOCK No.	LOT WIDTH (M) (± 0.0m)	LOT AREA (M²)
211-1	9.15	297.77
211-2	7.50	245.62
211-3	7.50	246.98
211-4	7.50	248.51
211-5	7.64	251.17
211-6	9.78	457.37

MAIN UNDERSIDE OF FOOTING (UF) SHOWN IS FOR STANDARD 0.20 (8") DEEP EXTERIOR WALL STRIP FOOTING ONLY.

NOTE: SUMP PUMP REQUIRED
SUMP PUMPS CONNECTED TO STORM SEWER ARE REQUIRED AS PER THE APPROVED SITE ENGINEERING DRAWINGS. REFER TO DRAWINGS PREPARED BY METROPOLITAN CONSULTING INC. SHEETS W12010-N1 & W12010-GP1.

1 ISSUED FOR CLIENT USE. AUG. 28/17 GW

2 ISSUED FOR PERMIT. OCT. 16/17 GW

3 REVISED PER BLDG. COMMENTS. DEC. 13/17 GW

4

5

6

PROPOSED VALVE

LIGHT POLE

HYDRANT

TRANSFORMER

WATER SERVICE

DOUBLE STM./SAN. CONNECTION

SINGLE STM./SAN. CONNECTION

DITCH BASIN

CABLE TELEVISION PEDESTAL

BELL PEDESTAL

NO. OF RISERS

FURNISHED FLOOR ELEVATION

UNDERSIDE FOOTING ELEVATION

FIN. BASEMENT FLOOR SLAB

TOP OF FOUNDATION WALL

UNDERSIDE FOOTING AT REAR

UNDERSIDE FOOTING AT FRONT

UNDERSIDE FOOTING AT SIDE

W.O.D. WALK OUT DECK

W.O.D. WALK OUT BASEMENT

REVERSE PLAN

STREET SIGN

SUPER MAIL BOX

RETAINING WALL

1.5m BLACK VINYL CHAIN LINK FENCE

ACOUSTICAL FENCE (SEE LANDSCAPE PLAN)

WOOD SCREEN FENCE (SEE LANDSCAPE PLAN)

HYDRO SERVICE LATERAL

SMALL DIRECTION

EMBANKMENT

PROVIDE 3/4" DIA. CLEAR STONE IN THIS AREA

THIS LOT CONTAINS ENGINEERED FILL

AIR CONDITIONER REQUIRED

RAIN WATER DOWNSPOUT LOCATION (DISCHARGE ONTO SPLASHPAD)

SIDE WINDOW LOCATION

EXTERIOR DOOR LOCATION

REDUCE SIDE YARD

north arrow

VA3 DESIGN

255 Consumers Rd Suite 120
Toronto ON M2J 1R4
1 416.630.2255 f 416.630.4782
va3design.com

Greenpark

RUSSELL GARDENS PHASE 2

HAMILTON

BLOCK SITING/GRADING

16036-RG2-SP

SP1

project name

RUSSELL GARDENS PHASE 2

date

MAY 2017

checked by

scale

1:250

file name

16036-RG2-SP

drawing no.

SP1

the undersigned has reviewed and takes responsibility for this design and has the qualifications and meets the requirements set out in the Ontario Building Code to be a Designer.

qualification information

Richard Vink 24488 BCN

signature

42658

Builder to verify location of all hydrants, street lights, transformers and other services. If minimum dimensions are not maintained, builder is to relocate at his own expense.

Builder to verify service connection elevations prior to constructing foundations.

VA3 DESIGN

255 Consumers Rd Suite 120
Toronto ON M2J 1R4
1 416.630.2255 f 416.630.4782
va3design.com

Greenpark

RUSSELL GARDENS PHASE 2

HAMILTON

BLOCK SITING/GRADING

16036-RG2-SP

SP1

All drawings specifications, related documents and design are the copyright property of VA3 DESIGN. Reproduction of this property in whole or in part is strictly prohibited without VA3 DESIGN's written permission.