

It is the builder's complete responsibility to ensure that all plans submitted for approval fully comply with the Architectural Guidelines and all applicable regulations and requirements in the City of Hamilton. The Control Architect is not responsible for any way or examining or approving site (lotting) plan or working drawings with respect to any zoning or building code or permit matter or that any house can be properly built or located on its lot.

This is to certify that these plans comply with the applicable Architectural Design Guidelines approved by the City of HAMILTON.

JOHN G. WILLIAMS LTD., ARCHITECT  
ARCHITECTURAL REVIEW  
AND APPROVAL

APPROVED BY:

DATE: JUL 31, 2018  
The stamp certifies compliance with the applicable Design Guidelines only and bears no further professional responsibility.

CITY OF HAMILTON  
BUILDING DIVISION  
Planning & Development Department

AUG 01 2018

REC BY: \_\_\_\_\_ DATE: \_\_\_\_\_  
REF'D TO: \_\_\_\_\_ DATE: \_\_\_\_\_

CITY OF HAMILTON  
Building Division

Permit No. 18-128803

THESE STAMPED DRAWINGS SHALL BE AVAILABLE ON SITE

THE OWNER AND/OR CONTRACTOR SHALL COMPLY WITH THE ONTARIO BUILDING CODE AND ALL OTHER APPLICABLE LAW


These drawings and/or specifications have been reviewed by

FOR CHIEF BUILDING OFFICIAL

AUG 14 2018  
DATE




THIS LOT GRADING IS AN INDEPENDENT CHECK REVIEWED BY METROPOLITAN CONSULTING INC. FOR COMPLIANCE WITH THE APPROVED SUBDIVISION CONTROL PLAN. THE PROPOSED GRADES ON THIS PLAN ARE IN GENERAL CONFORMANCE WITH THE APPROVED GRADING PLAN AND IF ISOLATED TO THE LOT AND ADJACENT LOTS, THESE GRADES SHALL BE MAINTAINED IN ACCORDANCE WITH THE APPROVED SUBDIVISION PLANS. THE SEWER LATERALS HAVE BEEN REVIEWED AND WE ARE ADVISED THAT THE LATERALS CONFORM WITH THE REQUIREMENTS OF THE O.B.C. AND CITY DESIGN RESPONSIBILITIES TO EMPLOY THE BEST PRACTICES AND CONFORM WITH THE ONTARIO BUILDING CODE. THE FOUNDATION OF THE BUILDING SHALL BE DESIGNED TO BE IN ACCORDANCE WITH THE REQUIREMENTS OF THE O.B.C. AND CITY DESIGN RESPONSIBILITIES TO EMPLOY THE BEST PRACTICES AND CONFORM WITH THE ONTARIO BUILDING CODE. THE FOUNDATION OF THE BUILDING SHALL BE DESIGNED TO BE IN ACCORDANCE WITH THE REQUIREMENTS OF THE O.B.C. AND CITY DESIGN RESPONSIBILITIES TO EMPLOY THE BEST PRACTICES AND CONFORM WITH THE ONTARIO BUILDING CODE. THE FOUNDATION OF THE BUILDING SHALL BE DESIGNED TO BE IN ACCORDANCE WITH THE REQUIREMENTS OF THE O.B.C. AND CITY DESIGN RESPONSIBILITIES TO EMPLOY THE BEST PRACTICES AND CONFORM WITH THE ONTARIO BUILDING CODE.

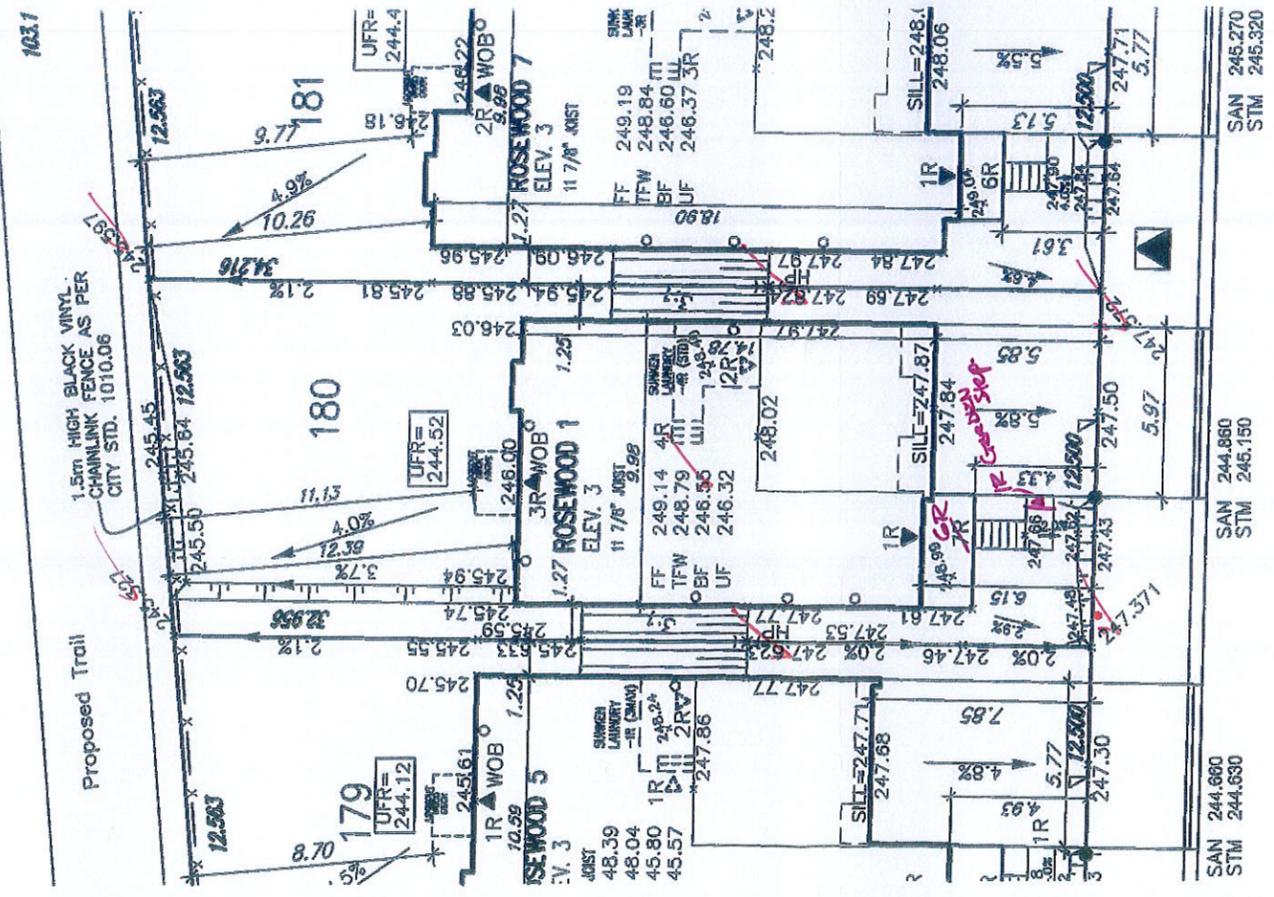

\*247.134 x 247.181 x 247.251 x 247.352 x 247.452 x 247.503 x 247.561  
HUMPHREY STREET

| LOT No. | LOT WIDTH (M) (± 0.0m) | LOT AREA (M <sup>2</sup> ) |
|---------|------------------------|----------------------------|
| 180     | 12.50                  | 420                        |

Grading Notes:  
It shall be the responsibility of the builder to have all grades and services verified and checked before construction by an approved grading engineer. The grades and the placement of storm and sanitary services off the street are to meet the requirements of the municipality having jurisdiction.  
VAB Design Inc. is to be notified promptly of any discrepancies at least 1 (one) week prior to excavation commencing in order that the building can be re-sited. Failure to observe these conditions may require expensive remedial action that will not be the responsibility of or cost to VAB Design Inc. Foundation wall shall be poured to a minimum of 5' above approved grades.  
Finished grade lines as indicated on the house prototype are for reference only and do not necessarily depict finish grading conditions of any particular lot.  
These drawings are to be read in conjunction with municipal approved site engineering drawings prepared by Metropolitan Consulting Inc.

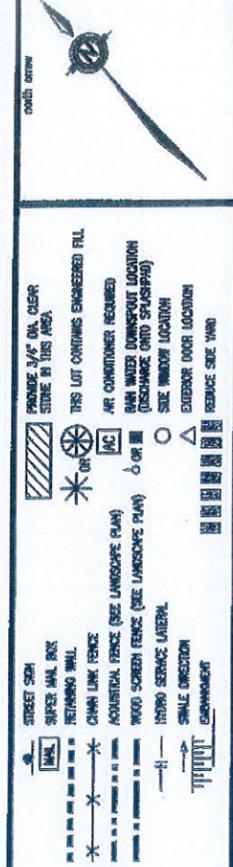

NOTE: REFER TO LANDSCAPE DRAWINGS FOR ALL FENCING TYPES, HEIGHTS AND LOCATIONS. CONTRACTOR TO VERIFY PRIOR TO INSTALLATION.

**Greenpark**  
RUSSELL GARDENS PHASE 2  
HAMILTON

180  
replacement plan no.

16036  
drawing no.

1  
sheet no.

Project Name: RUSSELL GARDENS PHASE 2  
Date: JULY 2018  
Drawn by: [Signature]  
Checked by: [Signature]

Scale: 1:250

Project No.: 16036-RR2-SP  
Drawing No.: 1

VAB DESIGN  
285 Consumers Rd Suite 120  
Toronto, ON M2J 1R4  
T: 416.630.2255 F: 416.630.4782  
vabdesign.com

Richard Vink  
24468  
42933

ISSUED FOR PERMIT: JULY 31/18 GH  
ISSUED FOR REVIEW: JULY 25/18 GH

All drawings, specifications, related documents and designs are the copyright property of VAB DESIGN. Reproduction of this property in whole or in part is strictly prohibited without VAB DESIGN's written permission.