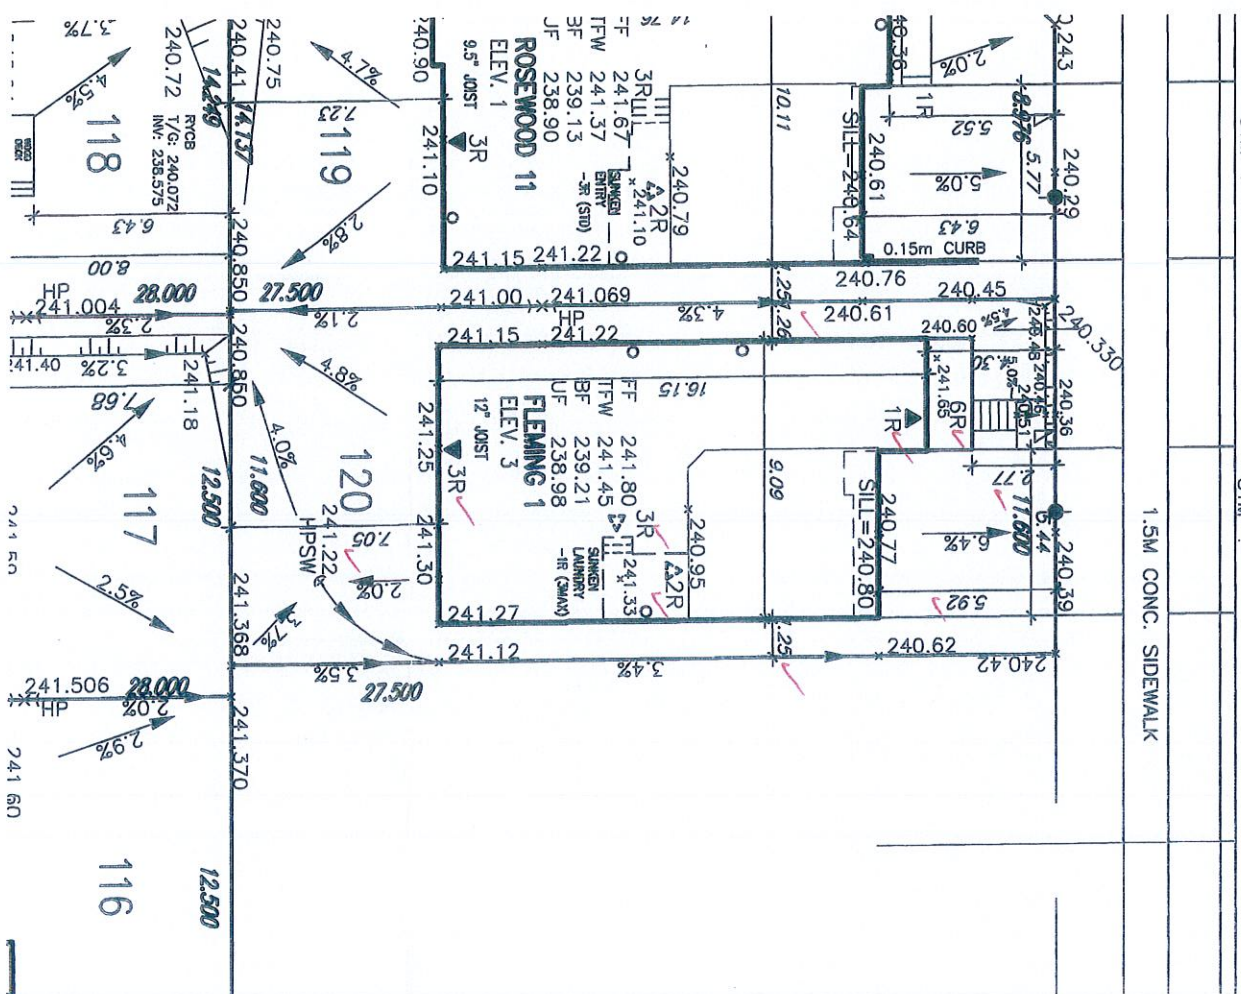


ARCHITECTURAL REVIEW & APPROVAL
MAY 28 2018
John G. Williams Limited, Architect

240.161 x 240.198 x 240.25
240.182 240.24 x
HUMPHREY STREET







 


 

Permit No. 18-118779

FOR CHIEF BUILDING OFFICIAL _____ DATE July 23/18

These drawings are to be read in conjunction with municipal approved site engineering drawings prepared by Metropolitan Consulting Inc.

<input checked="" type="checkbox"/> PROPOSED VALUE	✓	NO. OF REQUESTS	18
<input type="checkbox"/> UP	UP	FR	FR
<input type="checkbox"/> LOART POLE	LOART POLE	FR	FR
<input type="checkbox"/> H	H	FR	FR
<input checked="" type="checkbox"/> TRANSFORMER	TRANSFORMER	BY	BY
<input type="checkbox"/> WATER SERVICE	WATER SERVICE	TRW	TRW
<input type="checkbox"/> DOUBLE SW./SW. CONNECTION	DOUBLE SW./SW. CONNECTION	UPF	UPF
<input type="checkbox"/> SINGLE SW./SW. CONNECTION	SINGLE SW./SW. CONNECTION	UPF	UPF
<input type="checkbox"/> CATCH BASIN	CATCH BASIN	W.O.B.	W.O.B.
<input checked="" type="checkbox"/> TELEVISION POLYBIVAL	TELEVISION POLYBIVAL	WALK OUT D	WALK OUT D
<input type="checkbox"/> BELL PERSONAL	BELL PERSONAL	REV	REVERSE PLV

[illegible]


 PROVIDE 3/4" DIA. CLEAR STONE IN THIS AREA
 THIS LOT CONTAINS ENGINEERED FILL
 OR

 AIR CONDITIONER REQUIRED
 RAIN WATER DOWNSPOUT LOCATION
 SIDE WINDOW LOCATION
 EXTERIOR DOOR LOCATION
 REDUCE SIDE YARD


STREET SIGN
 SUPER MAIL BOX
 REMAINING WALL
 CHAIN LINK FENCE
 * ACoustical FENCE (SEE LANDSCAPE PLAN)
 WOOD SCREEN FENCE (SEE LANDSCAPE PLAN)
 H HOTO SERVICE LAUNDRY
 → SINGLE DIRECTION
 DRIVEMAN

9.	.	.	.
8.	.	.	.
7.	.	.	.
6.	.	.	.
5.	.	.	.
4.	.	.	.
3.	.	.	.
2	ISSUED FOR PERMIT.	MAY 18/18	GM
1	ISSUED FOR REVIEW.	MAY 11/18	GM
no. description		date	by

[illegible]

VAD
DESIGN
255 Consumers Rd. Suite 120
Toronto ON M2J 1R4
t 416.630.2255 f 416.630.4782
vad@vaden.com
vad3design.com

		lot/block no. 120
registered plan no. —		
project name RUSSELL GARDENS PHASE 2	municipality HAMILTON	project no. 16036
date MAY 2018	LOT SITING/GRADING	
drawn by GW	checked by —	life name 16036-RG2-SP
	scale 1:250	date rev 1 MAY 18 2018

As demand grows, retail demand at this is an exciting opportunity to be part of a team that is growing and expanding. We are looking for people who are passionate about their work and want to make a difference in the world. If you are interested in this position, please send us your resume and cover letter to hr@company.com.