


<div></div> <div>CONSTRUCTION SUMMARY</div> <div>Mountainview Heights (G) - Russell Gardens Building Ltd.</div> <div>PURCHASERS: VICTORIA ANN IANTORNO and MICHAEL M D'ANGELO</div> <div>TEL: RES.: 289-260-3994</div>				
LOT / PHASE Block 200 TH 3 / 2		REG. PLAN # 62M-1238	HOUSE TYPE Highgrove 2 Elev 1	

CABINETRY

1 - MASTER ENSUITE- SEE REVISED LAYOUT-
10Oct18 Note:

CONSTRUCTION

1 - MASTER ENSUITE- DELETE TUB AND SEE REVISED DESIGN FOR SHOWER-
10Oct18 Note:

PLUMBING


1 - MASTER ENSUITE- SEE REVISED DESIGN FOR MASTER ENSUITE SHOWER AND DELETE TUB-SEE SKETCH
10Oct18 Note:

PROMOTIONAL

1 - PARTIAL REDEMPTION OF PROMOTIONAL PACKAGE \$\$\$\$\$\$ BALANCE FORWARD TO BE USED AT A LATER DATE.
ORIGINAL PROMOTIONAL PACKAGE OF \$\$\$\$\$\$ AS PER SCHEDULE PE DATED MMMDDYYYY.
10Oct18 Note: NEW PROMO BALANCE \$7500.00

This Document is Extremely Time Sensitive - Printed 10 Oct 18 at 11:43

Russell Gardens

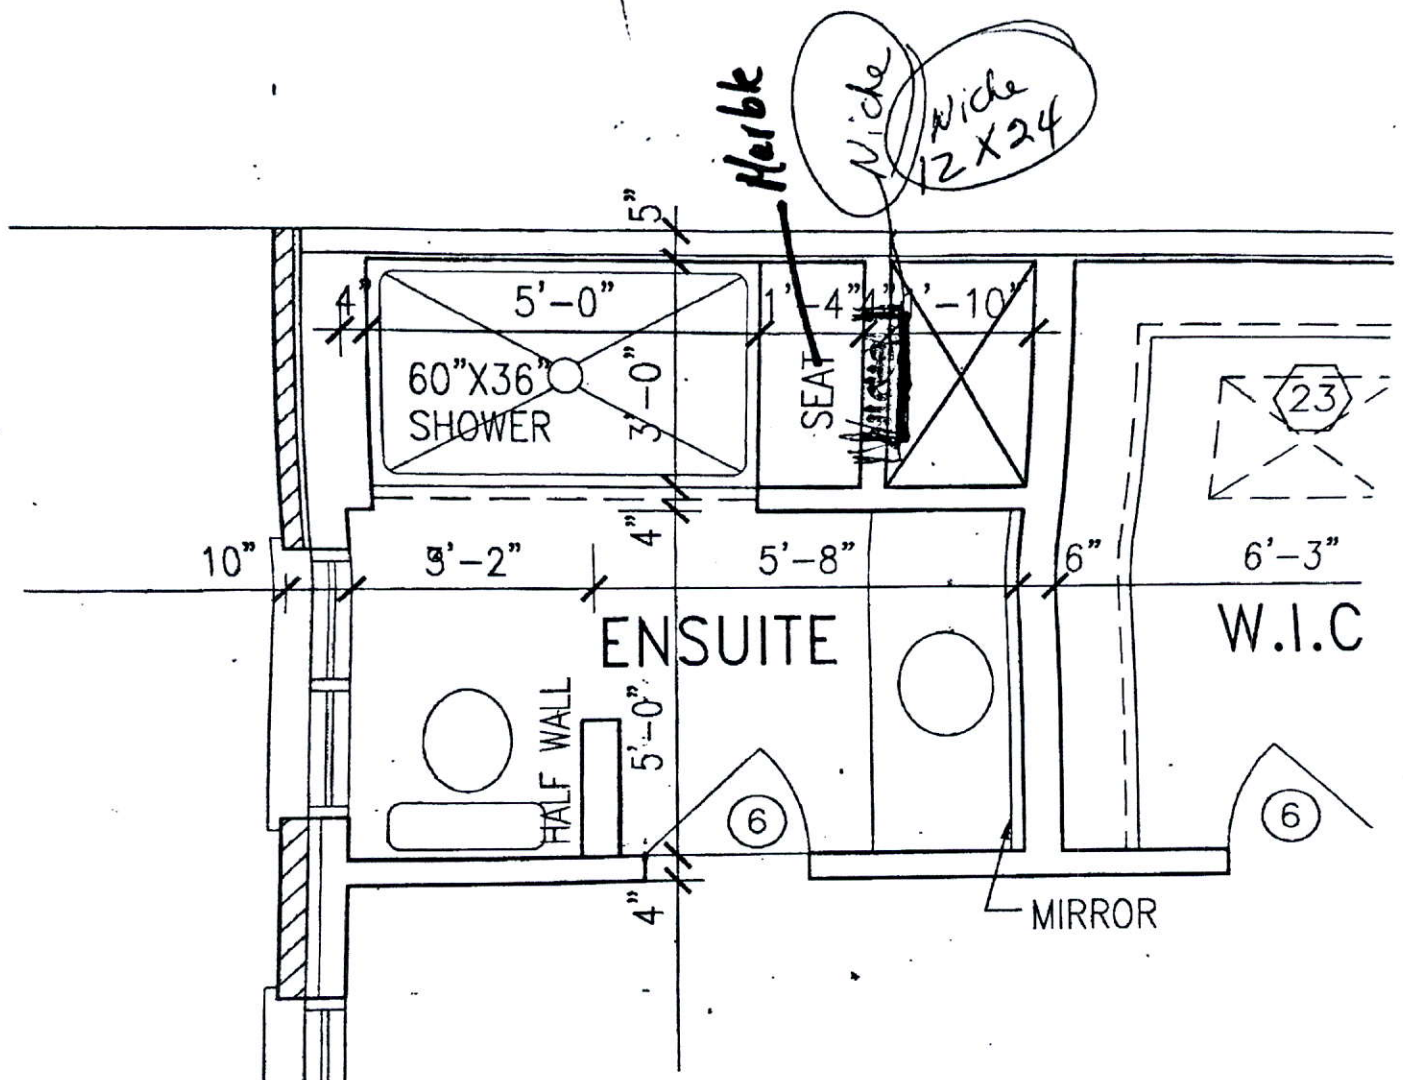

BUK 200 TH 3

~~X~~ *[Signature]*