	CONSTRUCTION SUMMARY	RECEIVED OCT 17 2018
Mountainview Heights (G) - Russell Gardens Building Ltd.		
PURCHASERS: MATTHEW DAVID PATTON and STEFANIE ALFANO		TEL: RES.: 647-501-8514

LOT / PHASE Block 218 TH 2 / 2	REG. PLAN # 62M-1238	HOUSE TYPE Highgrove 3 Elev 2		
-----------------------------------	-------------------------	----------------------------------	--	--

CONSTRUCTION

1 - MASTER ENSUITE- DELETE TUB- EXTEND SHOWER TO 5 FT. AND REDESIGN MASTER ENSUITE-SEE SKETCH 17Oct18 Note:	
--	--

PROMOTIONAL

1 - PARTIAL REDEMPTION OF PROMOTIONAL PACKAGE \$\$\$\$\$\$ BALANCE FORWARD TO BE USED AT A LATER DATE. ORIGINAL PROMOTIONAL PACKAGE OF \$\$\$\$ AS PER SCHEDULE PE DATED MMMDDYYYY. 17Oct18 Note: NEW PROMO BALANCE \$10,000.00	
--	--


EXTRAS AS PER OFFER

Five (5) White Appliances as per PE Appliances Worksheet Note:	
The Purchaser acknowledges that the Purchase Price is inclusive of all credits and promotional packages available at the time of purchase. Worksheet Note:	
The Vendor agrees that notwithstanding any other term or provision in this Agreement included in the Purchase Price and in addition to those items detailed in Schedule GP to the Agreement of Purchase and Sale, the Purchaser is entitled to a credit of Two Worksheet Note:	

This Document is Extremely Time Sensitive - Printed 17 Oct 18 at 15:30

BLK 218 TH2

H1646206 3

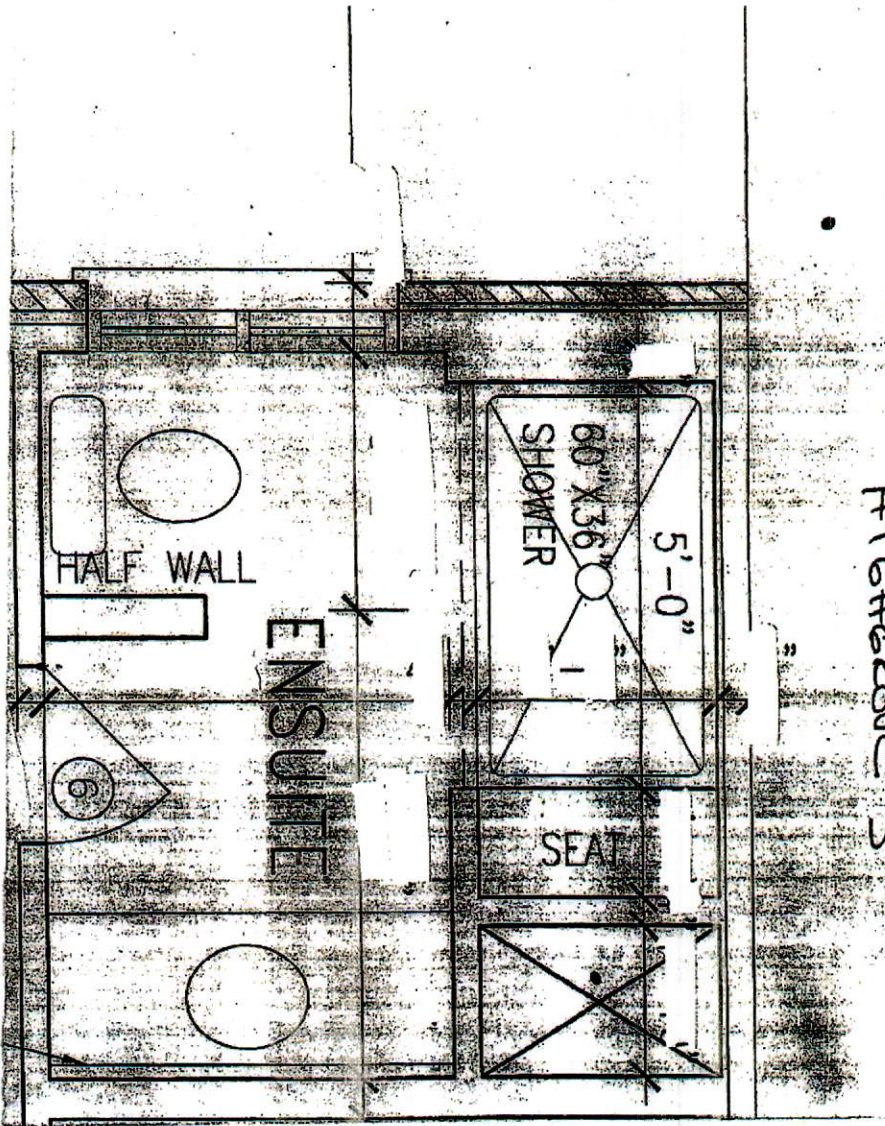

Matth Rall