

BK 210

2012 SF.

STRIP FOOTINGS - FOR SINGLES & SEMIS UP TO 2 STOREYS
 8" OR 10" FOUNDATION WALLS WITH 2"x8" / 2"x10" FLOOR JOISTS
 20"x6" CONCRETE STRIP FOOTINGS BELOW FOUNDATION WALLS.
 24"x8" CONCRETE STRIP FOOTINGS BELOW PARTY WALLS.
 FOUNDATION WALLS WITH ENGINEERED JOISTS OVER 16' SPANS
 24"x8" CONCRETE STRIP FOOTINGS BELOW FOUNDATION WALLS.
FOOTINGS ON ENGINEERED FILL
 24"x8" CONCRETE STRIP FOOTINGS WITH REINFORCING.
 BELOW EXTERIOR WALLS.
 30"x8" CONCRETE STRIP FOOTINGS WITH REINFORCING.
 BELOW PARTY WALLS.
 (REFER TO ENGINEER FILL FOOTING DETAIL)

ASSUME THE LARGER FOOTING SIZE WHEN TWO CONDITIONS APPLY
 ASSUMED 120 KPa (18 p.s.i.) SOIL BEARING CAPACITY FOR SINGLES OR 90 KPa FOR ENGINEERED FILL TO BE VERIFIED ON SITE.

PAD FOOTINGS
 120 KPa NATIVE SOIL 90 KPa ENGINEERED FILL SOIL
 F1 = 42"x42"x18" CONCRETE PAD F1 = 48"x48"x20" CONCRETE PAD
 F2 = 36"x36"x16" CONCRETE PAD F2 = 40"x40"x16" CONCRETE PAD
 F3 = 30"x30"x12" CONCRETE PAD F3 = 34"x34"x14" CONCRETE PAD
 F4 = 24"x24"x12" CONCRETE PAD F4 = 28"x28"x12" CONCRETE PAD
 F5 = 16"x16"x8" CONCRETE PAD F5 = 18"x18"x8" CONCRETE PAD
 (REFER TO FLOOR PLAN FOR UNUSUAL SIZE PADS NOT ON CHART.)

VENEER CUT
 WHEN VENEER CUT IS GREATER THAN 26", A 10" POURED CONCRETE FOUNDATION WALL IS REQUIRED.

EXPOSED CONCRETE (FLATWORK)
 ALL GARAGE SLABS, PORCH SLABS, STAIRS (EXPOSED CONC. FLAT WORK) TO BE 32 MPa WITH 5-8% AIR ENTRAINMENT.

BRICK VENEER LINTELS (WL)
 WL1 = 3-1/2" x 3-1/2" x 1/4" L (90x90x8.0L) + 2-2"x8" SPR. No.2
 WL2 = 4" x 3-1/2" x 5/16" L (100x90x8.0L) + 2-2"x8" SPR. No.2
 WL3 = 5" x 3-1/2" x 5/16" L (125x90x8.0L) + 2-2"x10" SPR. No.2
 WL4 = 6" x 3-1/2" x 3/8" L (150x90x10.0L) + 2-2"x12" SPR. No.2
 WL5 = 6" x 4" x 3/8" L (150x100x10.0L) + 2-2"x12" SPR. No.2
 WL6 = 5" x 3-1/2" x 5/16" L (125x90x8.0L) + 2-2"x12" SPR. No.2
 WL7 = 5" x 3-1/2" x 5/16" L (125x90x8.0L) + 3-2"x12" SPR. No.2
 WL8 = 5" x 3-1/2" x 5/16" L (125x90x8.0L) + 3-2"x10" SPR. No.2
 WL9 = 6" x 4" x 3/8" L (150x100x10.0L) + 3-2"x10" SPR. No.2

WOOD LINTELS AND BEAMS (WB)
 WB1 = 2-2"x8" (2-38x184) SPR. No.2
 WB2 = 3-2"x8" (3-38x184) SPR. No.2
 WB3 = 2-2"x10" (2-38x235) SPR. No.2
 WB4 = 3-2"x10" (3-38x235) SPR. No.2
 WB5 = 2-2"x12" (2-38x286) SPR. No.2
 WB6 = 3-2"x12" (3-38x286) SPR. No.2
 WB7 = 5-2"x12" (5-38x286) SPR. No.2
 WB11 = 4-2"x10" (4-38x235) SPR. No.2
 WB12 = 4-2"x12" (4-38x286) SPR. No.2

LAMINATED VENEER LUMBER (LVL) BEAMS
 LVL1A = 1-1 3/4"x7 1/4" (1-45x184)
 LVL1 = 2-1 3/4"x7 1/4" (2-45x184)
 LVL2 = 3-1 3/4"x7 1/4" (3-45x184)
 LVL3 = 4-1 3/4"x7 1/4" (4-45x184)
 LVL4A = 1-1 3/4"x9 1/2" (1-45x240)
 LVL4 = 2-1 3/4"x9 1/2" (2-45x240)
 LVL5 = 3-1 3/4"x9 1/2" (3-45x240)
 LVL5A = 4-1 3/4"x9 1/2" (4-45x240)
 LVL6A = 1-1 3/4"x11 7/8" (1-45x300)
 LVL6 = 2-1 3/4"x11 7/8" (2-45x300)
 LVL7 = 3-1 3/4"x11 7/8" (3-45x300)
 LVL8 = 2-1 3/4"x14" (2-45x356)
 LVL9 = 3-1 3/4"x14" (3-45x356)

LOOSE STEEL LINTELS (L)
 L1 = 3-1/2" x 3-1/2" x 1/4" L (90x90x8.0L)
 L2 = 4" x 3-1/2" x 5/16" L (100x90x8.0L)
 L3 = 5" x 3-1/2" x 5/16" L (125x90x8.0L)
 L4 = 6" x 3-1/2" x 3/8" L (150x90x10.0L)
 L5 = 6" x 4" x 3/8" L (150x100x10.0L)
 L6 = 7" x 4" x 3/8" L (180x100x10.0L)

DOOR SCHEDULE


NOS.	WIDTH	HEIGHT 8' TO 9'	HEIGHT 10' OR MORE	TYPE
1	2'-10"	6'-8"	8'-0"	INSULATED ENTRANCE DOOR
1a	2'-8"	6'-8"	8'-0"	INSULATED FRONT DOORS
2	2'-8"	6'-8"	8'-0"	WOOD & GLASS DOOR
3	2'-8"	6'-8"	8'-0"	INSULATED EXT. SLAB DOOR
4	2'-8"	6'-8"	8'-0"	INTERIOR SLAB DOOR
5	2'-6"	6'-8"	8'-0"	INTERIOR SLAB DOOR
6	2'-2"	6'-8"	8'-0"	INTERIOR SLAB DOOR
7	1'-6"	6'-8"	8'-0"	INTERIOR SLAB DOOR

CERAMIC TILE FOR CONVENTIONAL LUMBER (OBC 9.30.6)
 SPACE ALL CONVENTIONAL FLOOR JOISTS @ 12" O.C. BELOW ALL CERAMIC TILE AREAS.
 PROVIDE 1 ROW BRIDGING FOR SPANS OF 5'0"-7'0".
 2 ROWS FOR SPANS GREATER THAN 7'0".


NOTE: ROOF FRAMING
 REFER TO ROOF TRUSS SHOP DRAWINGS FOR ALL ROOF FRAMING INFORMATION UNLESS OTHERWISE NOTED.

PLANS NOT DRAWN TO ACTUAL GRADE. REFER TO FINAL APPROVED GRADING PLAN.

NOTE: ENGINEERED FLOOR FRAMING
 REFER TO ENGINEERED FLOOR FLAYOUTS FOR ALL ENGINEERED FLOOR FRAMING INFORMATION AND DETAILS. UNLESS OTHERWISE NOTED.

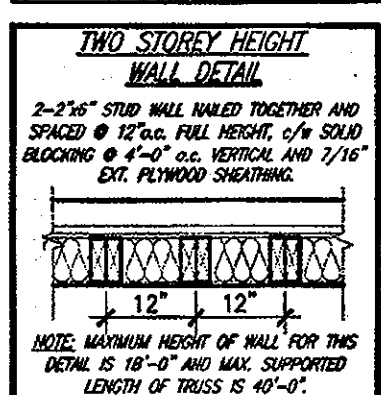

CITY OF HAMILTON
 BUILDING DIVISION
 Planning & Development Department
 NOV 16 2017
 REC. BY: _____ DATE: _____
 REF'D TO: _____ DATE: _____

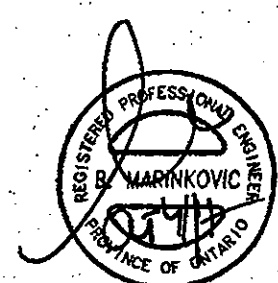

STRUDET INC.
 FOR STRUCTURE ONLY

It is the builder's complete responsibility to ensure that all plans submitted for approval fully comply with the Architectural Guidelines and all applicable regulations and requirements including zoning provisions and any provisions in the subdivision agreement. The Control Architect is not responsible in any way for examining or approving site (lotting) plans or working drawings with respect to any zoning or building code or permit matter or that any house can be properly built or located on its lot.

This is to certify that these plans comply with the applicable Architectural Design Guidelines approved by the City of HAMILTON.

UNINSULATED OPENINGS (PER OBC SB-12.3.1.1(7))

HIGHGROVE 4 AND ELEV. 1			
ELEVATION	WALL AREA S.F.	OPENING S.F.	PERCENTAGE
FRONT	485.11 S.F.	112.75 S.F.	23.24 %
LEFT SIDE	981.91 S.F.	0 S.F.	0.00 %
RIGHT SIDE	981.91 S.F.	0 S.F.	0.00 %
REAR	485.11 S.F.	130.24 S.F.	26.85 %
* OPENINGS OMITTED AS PER SB-12 3.1.1.9(4) MAX 19.9 S.F. REFER TO ELEVATION FOR LOCATION			
TOTAL SQ. FT.	2934.04 S.F.	242.99 S.F.	8.28 %
TOTAL SQ. M.	272.58 S.M.	22.57 S.M.	2.8 %

UNINSULATED OPENINGS (PER OBC SB-12.3.1.1(7))

HIGHGROVE 4 AND ELEV. 2			
ELEVATION	WALL AREA S.F.	OPENING S.F.	PERCENTAGE
FRONT	485.11 S.F.	123.50 S.F.	25.46 %
LEFT SIDE	1001.58 S.F.	0 S.F.	0.00 %
RIGHT SIDE	1001.58 S.F.	0 S.F.	0.00 %
REAR	485.11 S.F.	130.24 S.F.	26.85 %
* OPENINGS OMITTED AS PER SB-12 3.1.1.9(4) MAX 19.9 S.F. REFER TO ELEVATION FOR LOCATION			
TOTAL SQ. FT.	2973.38 S.F.	253.74 S.F.	8.53 %
TOTAL SQ. M.	276.23 S.M.	23.57 S.M.	8.53 %

UNINSULATED OPENINGS (PER OBC SB-12.3.1.1(7))

HIGHGROVE 4 AND ELEV. 3			
ELEVATION	WALL AREA S.F.	OPENING S.F.	PERCENTAGE
FRONT	485.11 S.F.	122.00 S.F.	25.15 %
LEFT SIDE	981.91 S.F.	0 S.F.	0.00 %
RIGHT SIDE	981.91 S.F.	0 S.F.	0.00 %
REAR	485.11 S.F.	130.24 S.F.	26.85 %
* OPENINGS OMITTED AS PER SB-12 3.1.1.9(4) MAX 19.9 S.F. REFER TO ELEVATION FOR LOCATION			
TOTAL SQ. FT.	2934.04 S.F.	252.24 S.F.	8.60 %
TOTAL SQ. M.	272.58 S.M.	23.43 S.M.	8.60 %

AREA CALCULATIONS ELEV '1'

GROUND FLOOR AREA	894 SF
SECOND FLOOR AREA	1107 SF
TOTAL FLOOR AREA	2001 SF
	(185.90 m2)
FIRST FLOOR OPEN AREA	00 SF
SECOND FLOOR OPEN AREA	11 SF
ADD TOTAL OPEN AREAS	+11 SF
ADD FINISHED BSMT AREA	+00 SF
GROSS FLOOR AREA	2012 SF
	(186.92 m2)
GROUND FLOOR COVERAGE	894 SF
GARAGE COVERAGE/AREA	310 SF
PORCH COVERAGE/AREA	106 SF
COVERAGE W/ PORCH	1310 SF
	(121.76 m2)
COVERAGE W/O PORCH	1204 SF
	(111.86 m2)

AREA CALCULATIONS ELEV '2'

GROUND FLOOR AREA	902 SF
SECOND FLOOR AREA	1108 SF
TOTAL FLOOR AREA	2010 SF
	(186.73 m2)
FIRST FLOOR OPEN AREA	00 SF
SECOND FLOOR OPEN AREA	11 SF
ADD TOTAL OPEN AREAS	+11 SF
ADD FINISHED BSMT AREA	+00 SF
GROSS FLOOR AREA	2021 SF
	(187.75 m2)
GROUND FLOOR COVERAGE	902 SF
GARAGE COVERAGE/AREA	310 SF
PORCH COVERAGE/AREA	53 SF
COVERAGE W/ PORCH	1265 SF
	(117.52 m2)
COVERAGE W/O PORCH	1213 SF
	(112.69 m2)

AREA CALCULATIONS ELEV '3'

GROUND FLOOR AREA	894 SF
SECOND FLOOR AREA	1099 SF
TOTAL FLOOR AREA	1993 SF
	(185.16 m2)
FIRST FLOOR OPEN AREA	00 SF
SECOND FLOOR OPEN AREA	11 SF
ADD TOTAL OPEN AREAS	+11 SF
ADD FINISHED BSMT AREA	+00 SF
GROSS FLOOR AREA	2004 SF
	(186.18 m2)
GROUND FLOOR COVERAGE	894 SF
GARAGE COVERAGE/AREA	310 SF
PORCH COVERAGE/AREA	99 SF
COVERAGE W/ PORCH	1303 SF
	(121.05 m2)
COVERAGE W/O PORCH	1204 SF
	(111.86 m2)

CITY OF HAMILTON
 Building Division

Permit No. 17-132133-00-R9

THESE STAMPED DRAWINGS SHALL BE AVAILABLE ON SITE

THE OWNER AND/OR CONTRACTOR SHALL COMPLY WITH THE ONTARIO BUILDING CODE AND ALL OTHER APPLICABLE LAWS

These drawings and/or specifications have been reviewed by:

B. R. K. DEC 1/17
 FOR CHIEF BUILDING OFFICIAL DATE

OCT 04 2017

HIGHGROVE 4
COMPLIANCE PACKAGE 'A1'

18									
17									
16									
15									
14									
13									
12									
11									
10									
9									
8									
7	REVISED, ISSUED FOR PERMIT.	SEP. 28/17	SW						
6	ISSUED FOR PERMIT.	AUG. 23/17	GW						
5	STRUCO REPLACED.	JUL. 05/17	GW						
4	REVISED AS PER CLIENT COMMENTS.	JUN. 21/17	WT						
3	CHANGED JOIST DEPTH/ FLOOR HEIGHTS	JUN. 13/17	GW						
2	REVISED PER CLIENT COMMENTS.	APR. 28/17	GW						
1	PRELIMINARY REVIEW.	APR. 12/17	GW						
no.	description	date	by	no.	description	date	by		

VAS DESIGN
 255 Consumers Rd Suite 120
 Toronto ON M2J 1R4
 416.630.2255 | 416.630.4782
 vasdesign.com

Greenpark. **HIGHGROVE 4**

project name: **RUSSELL GARDENS PH.2** municipality: **WATERDOWN, ON.** project no.: **16036**

date: **APRIL 2017** checked by: **GW** scale: **3/16" = 1'-0"** drawing no.: **A0**

TYPICAL NOTES & AREAS


16036-HIGHGROVE-4
 16036-HIGHGROVE-4.dwg - Thu - Sep 28 2017 - 5:22 PM

All drawings, specifications, related documents and design are the copyright property of VAS DESIGN. Reproduction of this property in whole or in part is strictly prohibited without VAS DESIGN's written permission.

BASEMENT WALL INSULATION
(TYP) 13
-6" (R20) CONTINUOUS BLANKET INSULATION. INSULATION UNINTERRUPTED BY FRAMING

BASEMENT INSULATION AT STAIR/SUNKEN AREAS where FRAMING IS REQ'D. FOR SUPPORT.
-2" (R10) CONTINUOUS INSULATION (RIGID or SPRAY FOAM).
-2"x4" @ 16" o.c. w/ R12 BATT INSULATION.
-EXTEND EXTERIOR WALL FOOTING TO SUPPORT 2"x4" WALL WHERE LOAD BEARING.

PARTY WALL AT GARAGE SIDE CONSTRUCTION
• REFER TO BLOCK PLANS TO CONFIRM WHETHER SK2 OR SK3 PARTY WALL IS TO BE BUILT.
• REFER TO DETAIL PAGES 4A OR 4B TO VERIFY PARTY WALL THICKNESS/CONSTRUCTION.

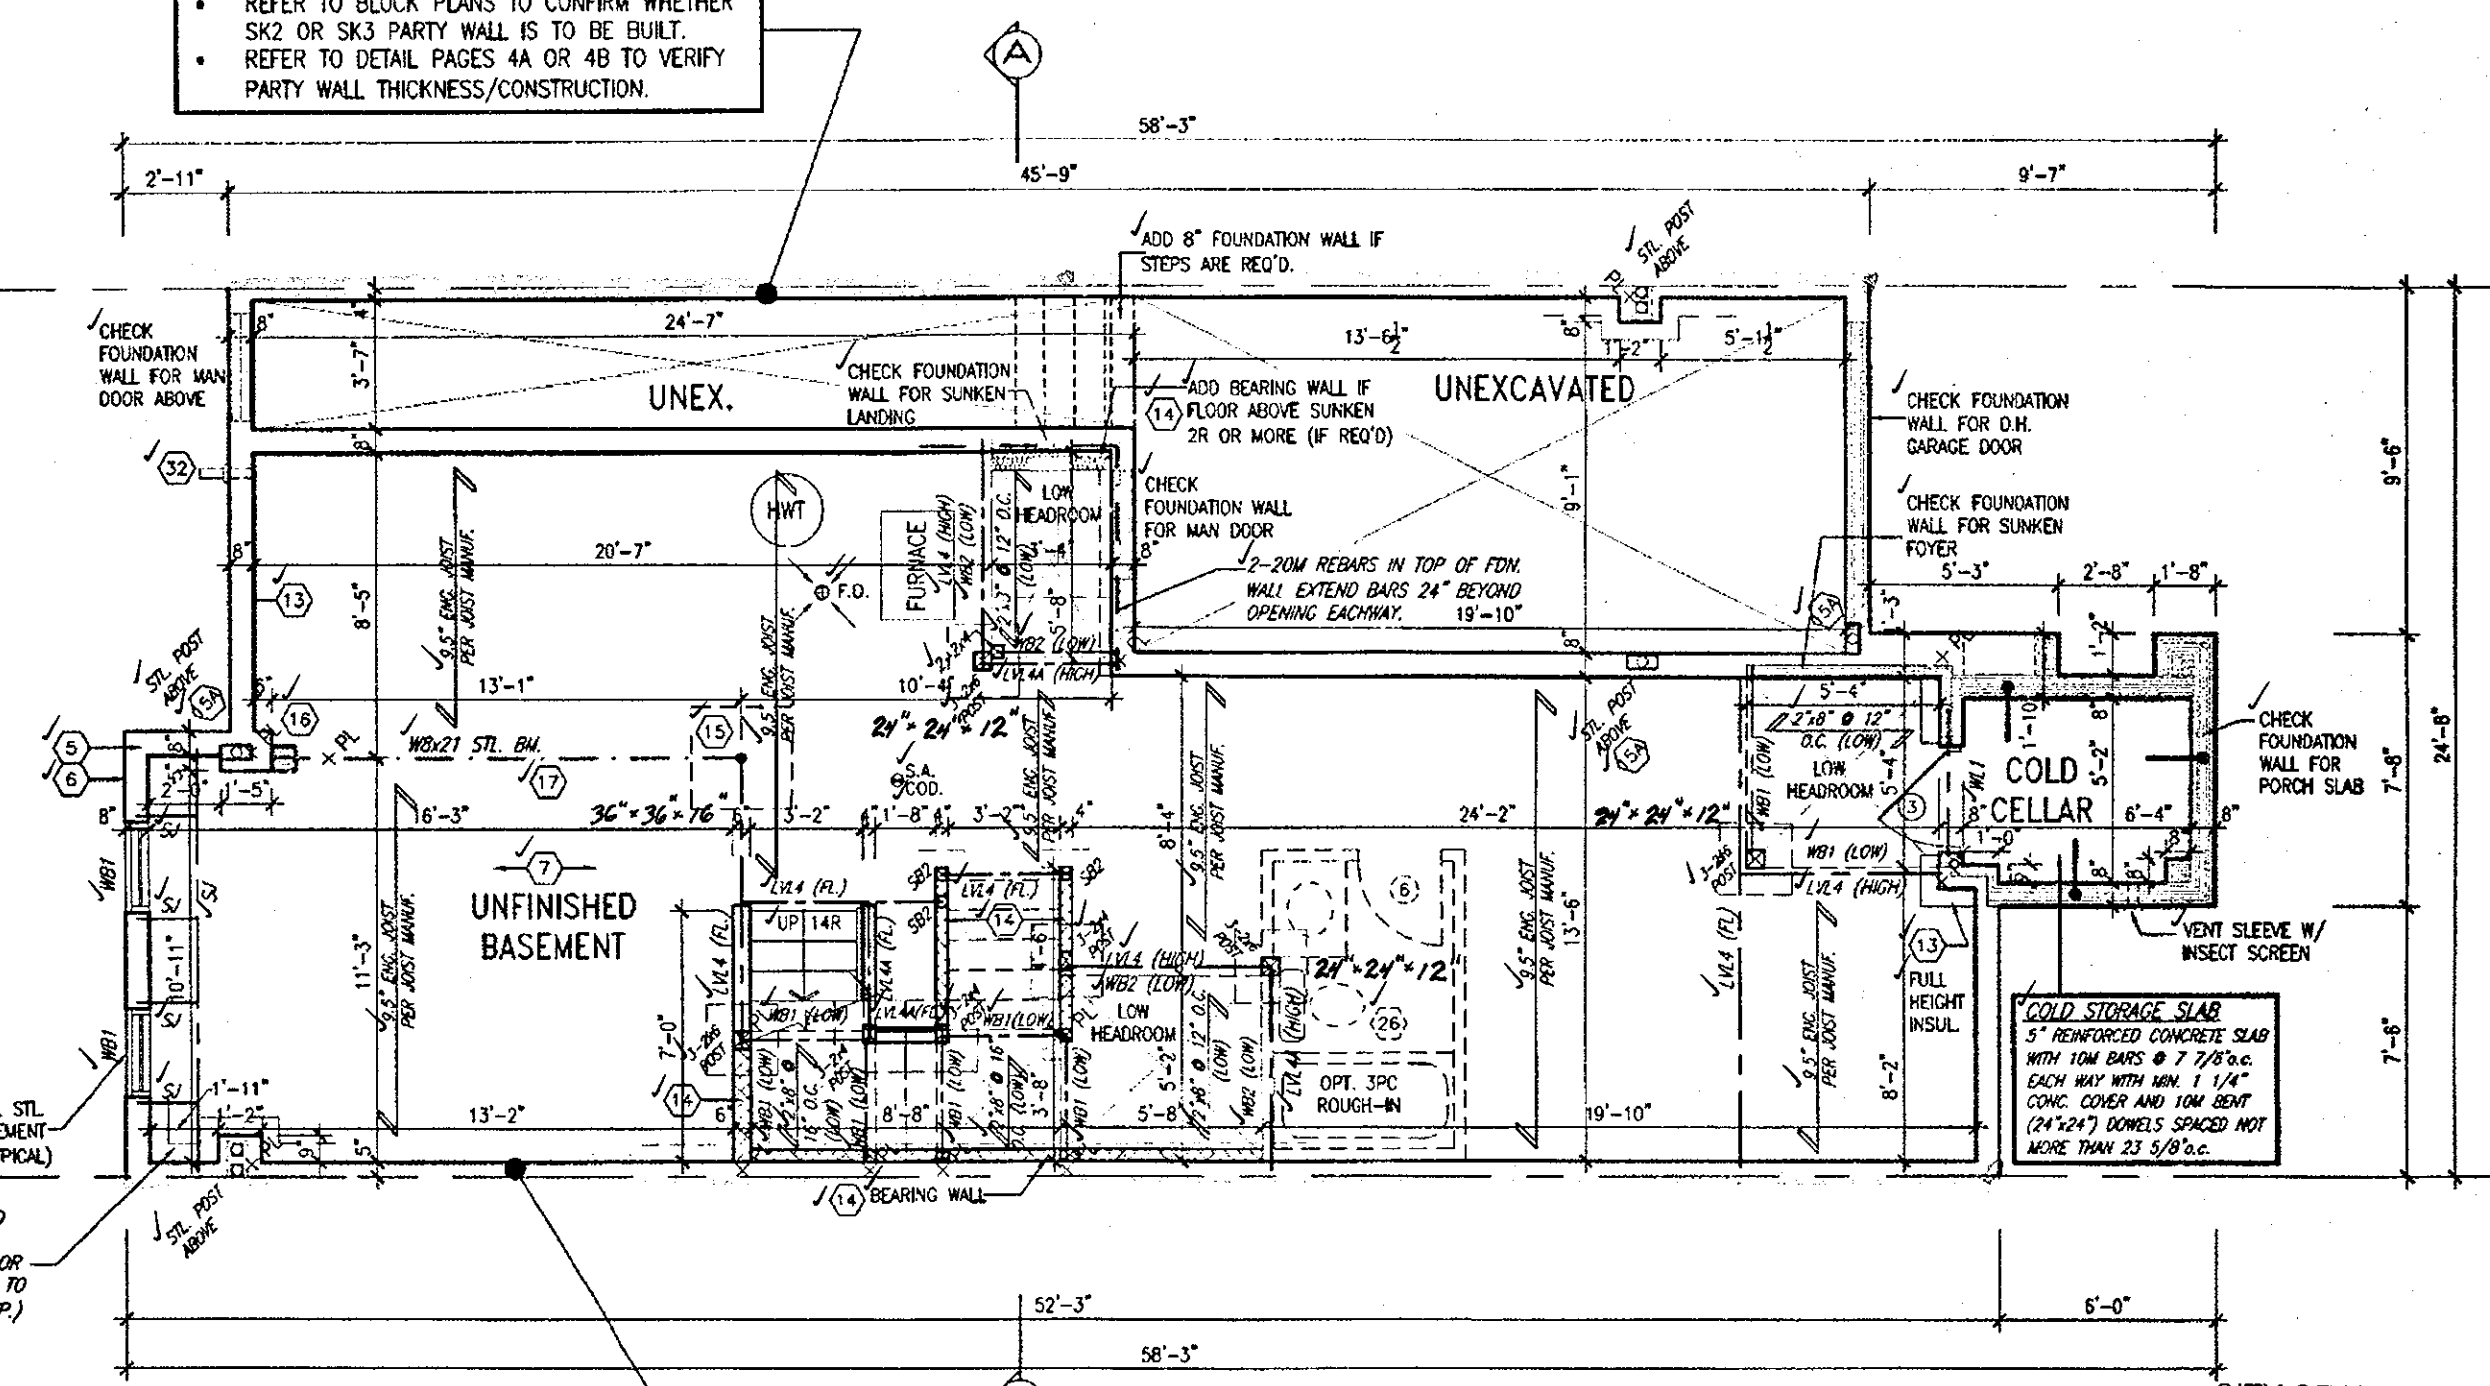

PARTY WALL AT HOUSE SIDE CONSTRUCTION
• REFER TO BLOCK PLANS TO CONFIRM WHETHER SK1 OR SK3 PARTY WALL IS TO BE BUILT.
• REFER TO DETAIL PAGES 4 OR 4B TO VERIFY PARTY WALL THICKNESS/CONSTRUCTION.

BASEMENT PLAN ELEV. '2'



ALL ELECTRICAL INSTALLATIONS MUST BE INSPECTED BY THE ELECTRICAL SAFETY AUTHORITY. SEPARATE INSPECTION APPLICATIONS MUST BE FILED. FOR MORE INFORMATION PLEASE CALL: ELECTRICAL SAFETY AUTHORITY 1-877-ESA-SAFE (372-7233). **PLUG IN SAFELY: HIRE A LICENSED ELECTRICAL CONTRACTOR. FIND A CONTRACTOR AT www.pluginsafely.ca**

CITY OF HAMILTON Building Division
Permit No. 17-132133-00-R9
THESE STAMPED DRAWINGS SHALL BE AVAILABLE ON SITE
THE OWNER AND/OR CONTRACTOR SHALL COMPLY WITH THE ONTARIO BUILDING CODE AND ALL OTHER APPLICABLE LAW
These drawings and/or specifications have been reviewed by *[Signature]* MAY 29/18
FOR CHIEF BUILDING OFFICIAL DATE

CITY OF HAMILTON BUILDING DIVISION
Planning & Development Department
REVISED
MAY 22 2018
REC. BY _____ DATE _____
REF'D TO _____ DATE _____

HIGHGROVE 4
COMPLIANCE PACKAGE 'A1'

It is the builder's complete responsibility to ensure that all plans submitted for approval fully comply with the Architectural Guidelines and all applicable regulations and requirements including zoning provisions and any provisions in the subdivision agreement. The Control Architect is not responsible in any way for examining or approving site (lotting) plans or working drawings with respect to any zoning or building code or permit matter or that any house can be properly built or located on its lot.

This is to certify that these plans comply with the applicable Architectural Design Guidelines approved by the City of HAMILTON.

JOHN G. WILLIAMS LTD., ARCHITECT
ARCHITECTURAL CONTROL REVIEW AND APPROVAL
APPROVED BY: *[Signature]*
DATE: APR 20, 2018
The stamp certifies compliance with the applicable Design Guidelines only and bears no further professional responsibility.



STRUDET INC.
FOR STRUCTURE ONLY

ALL GARAGE SLABS, PORCH SLABS, STAIRS (EXPOSED CONC. FLAT WORK) TO BE 32 MPa. WITH 5-8% AIR ENTRAINMENT.

NOTE: ROOF FRAMING
REFER TO ROOF TRUSS SHOP DRAWINGS AND TOWNHOUSE BLOCK PLANS FOR ALL ROOF FRAMING INFORMATION UNLESS OTHERWISE NOTED.

ENGINEERED FLOOR FRAMING INFO
REFER TO ENGINEERED FLOOR LAYOUTS FOR ALL FLOOR FRAMING INFORMATION AND DETAILS UNLESS OTHERWISE NOTED.

18				9	REVISED.	APR. 13/18	GW				
17				8	REVISED PER CITY COMMENTS. RESUED.	FEB. 15/18	GW				
16				7	REVISED. ISSUED FOR PERMIT.	SEP. 28/17	GW				
15				6	ISSUED FOR PRICING.	AUG. 23/17	GW				
14				5	STUCCO REPLACED.	JUL. 05/17	GW				
13				4	REVISED AS PER CLIENT COMMENTS.	JUN. 21/17	WT				
12				3	CHANGED JOIST DEPTH/ FLOOR HEIGHTS.	JUN. 13/17	GW				
11				2	REVISED PER CLIENT COMMENTS.	APR. 28/17	GW				
10				1	PRELIMINARY REVIEW.	APR. 12/17	GW				
no. description		date		by		no. description		date		by	

The undersigned has reviewed and takes responsibility for this design and has the qualifications and meets the requirements set out in the Ontario Building Code to be a Designer.
qualification information
Richard Vink 24488 BCR
name registration information
VA3 Design Inc. 42653
Contractor must verify all dimensions on the job and report any discrepancy to the Designer before proceeding with the work. All drawings and specifications are instruments of service and the property of the Designer which must be returned at the completion of the work. Drawings are not to be scaled.


VA3 DESIGN
255 Consumers Rd Suite 120
Toronto ON M2J 1R4
t 416.630.2255 f 416.630.4782
va3design.com

Greenpark.
Project name
RUSSELL GARDENS PH.2
Municipality
WATERDOWN, ON.
date
APRIL 2017
drawn by
WT
checked by
GW
scale
3/16" = 1'-0"
drawing no.
16035-HIGHGROVE-4
date
APR 17 2018

HIGHGROVE 4
project no.
16036
drawing no.
A1a

PARTY WALL AT GARAGE SIDE CONSTRUCTION

- REFER TO BLOCK PLANS TO CONFIRM WHETHER SK2 OR SK3 PARTY WALL IS TO BE BUILT.
- REFER TO DETAIL PAGES 4A OR 4B TO VERIFY PARTY WALL THICKNESS/CONSTRUCTION.

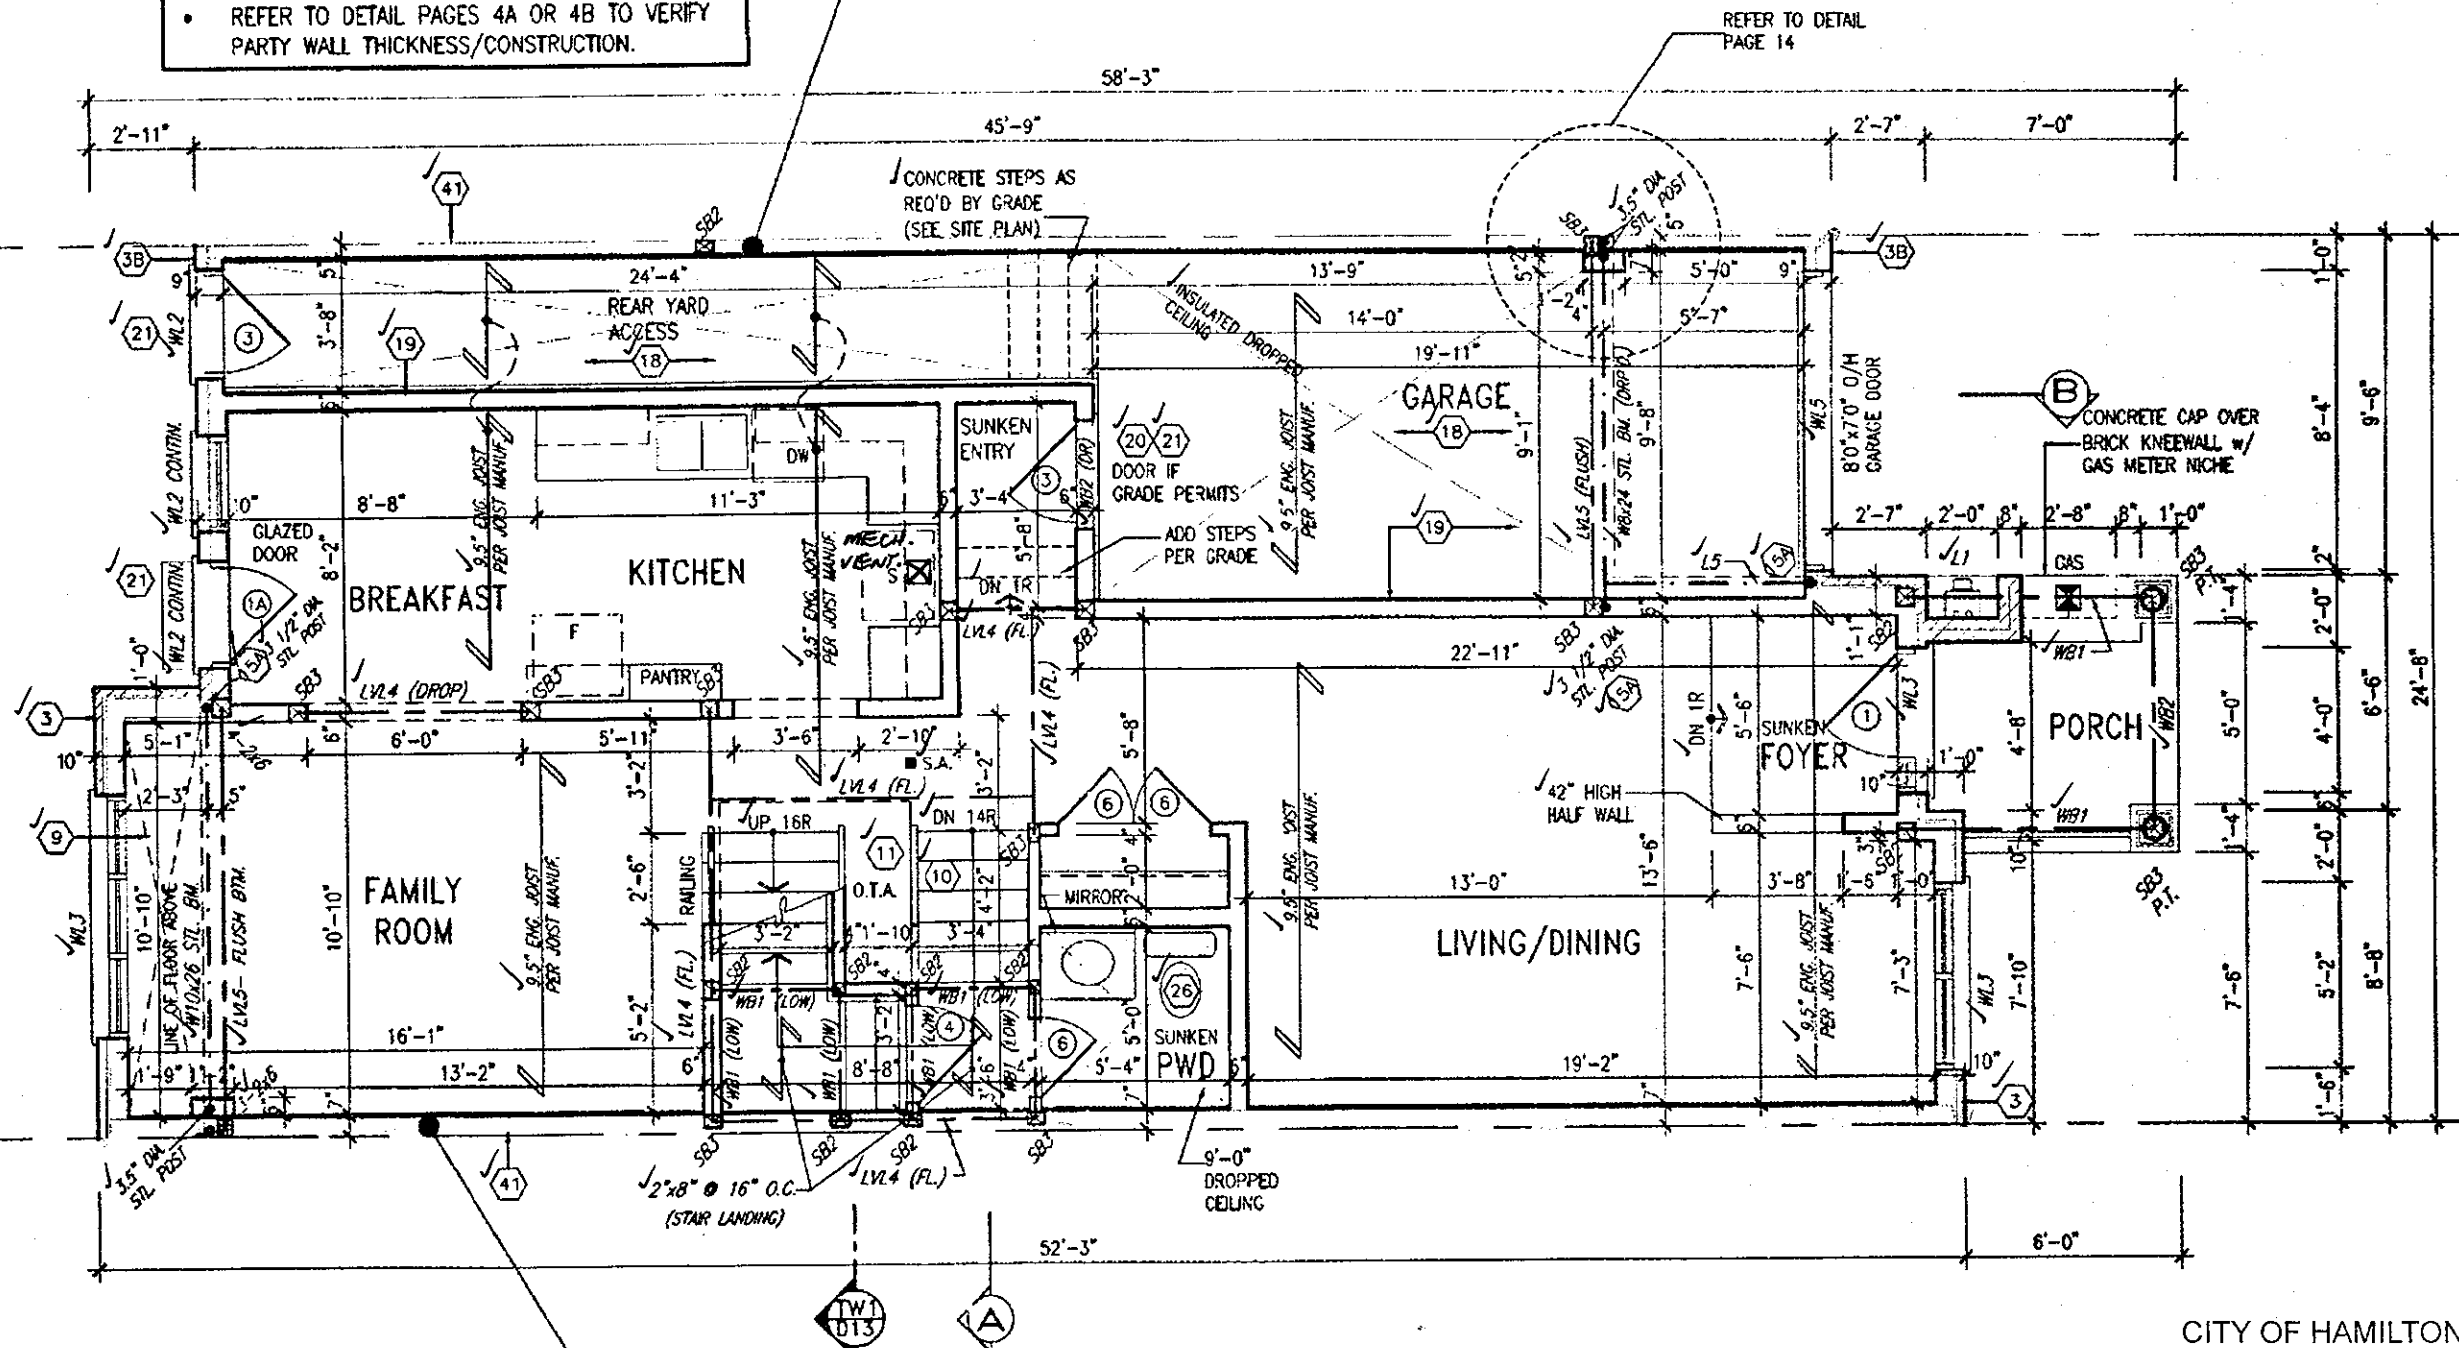

PARTY WALL AT HOUSE SIDE CONSTRUCTION

- REFER TO BLOCK PLANS TO CONFIRM WHETHER SK1 OR SK3 PARTY WALL IS TO BE BUILT.
- REFER TO DETAIL PAGES 4 OR 4B TO VERIFY PARTY WALL THICKNESS/CONSTRUCTION.

GROUND FLOOR PLAN ELEV. '2'



ALL ELECTRICAL INSTALLATIONS MUST BE INSPECTED BY THE ELECTRICAL SAFETY AUTHORITY. SEPARATE INSPECTION APPLICATIONS MUST BE FILED. FOR MORE INFORMATION PLEASE CALL: ELECTRICAL SAFETY AUTHORITY 1-877-ESA-SAFE (372-7233) PLUG IN SAFELY. HIRE A LICENSED ELECTRICAL CONTRACTOR. FIND A CONTRACTOR AT www.pluginsafely.ca

CITY OF HAMILTON
Building Division

Permit No. 17-130133-00-R9

THESE STAMPED DRAWINGS SHALL BE AVAILABLE ON SITE

THE OWNER AND/OR CONTRACTOR SHALL COMPLY WITH THE ONTARIO BUILDING CODE AND ALL OTHER APPLICABLE LAW

These drawings and/or specifications have been reviewed by

FOR CHIEF BUILDING OFFICIAL DATE

APR 17 2018

HIGHGROVE 4
COMPLIANCE PACKAGE 'A1'

It is the builder's complete responsibility to ensure that all plans submitted for approval fully comply with the Architectural Guidelines and all applicable regulations and requirements including zoning provisions and any provisions in the subdivision agreement. The Control Architect is not responsible in any way for examining or approving site (lotting) plans or working drawings with respect to any zoning or building code or permit matter or that any house can be properly built or located on its lot.

This is to certify that these plans comply with the applicable Architectural Design Guidelines approved by the City of HAMILTON.

JOHN G. WILLIAMS LTD., ARCHITECT
ARCHITECTURAL CONTROL REVIEW AND APPROVAL

APPROVED BY: [Signature]
DATE: APR 20 2018

This stamp certifies compliance with the applicable Design Guidelines only and bears no further professional responsibility



STRUDET INC.
FOR STRUCTURE ONLY

NOTE: ROOF FRAMING
REFER TO ROOF TRUSS SHOP DRAWINGS AND TOWNHOUSE BLOCK PLANS FOR ALL ROOF FRAMING INFORMATION UNLESS OTHERWISE NOTED.

CITY OF HAMILTON
BUILDING DIVISION
Planning & Development Department
REVISED
MAY 22 2018

REC. BY: _____ DATE: _____
REF'D TO: _____ DATE: _____


18	REVISED	APR 13/18	GW	
17	REVISED PER CITY COMMENTS REDISSUED	FEB 15/18	GW	
16	REVISED: ISSUED FOR PERMIT	SEP 28/17	GW	
15	ISSUED FOR PRICING	AUG 23/17	GW	
14	STUCCO REPLACED	JUL 05/17	GW	
13	REVISED AS PER CLIENT COMMENTS	JUN 21/17	WT	
12	CHANGED JOIST DEPTH/ FLOOR HEIGHTS	JUN 15/17	GW	
11	REVISED PER CLIENT COMMENTS	APR 28/17	GW	
10	PRELIMINARY REVIEW	APR 12/17	GW	
9				
8				
7				
6				
5				
4				
3				
2				
1				

The undersigned has reviewed and takes responsibility for this design and has the qualifications and meets the requirements set out in the Ontario Building Code to be a Designer.
Qualification information
Richard Vink
24488
BCN
42658
Contractor must verify all dimensions on the job and report any discrepancy to the Designer before proceeding with the work. All drawings and specifications are instruments of service and the property of the Designer which must be returned at the completion of the work. Drawings are not to be scaled.

VAS DESIGN
255 Consumers Rd Suite 120
Toronto ON M2N 1R4
416.630.2255 / 416.630.4782
vasdesign.com

Greenpark.
project name: RUSSELL GARDENS PH.2
municipality: WATERDOWN, ON.
date: APRIL 2017
checked by: GW
scale: 3/16" = 1'-0"

HIGHGROVE 4
project no: 16036
drawing no: A2a
file name: 16036-HIGHGROVE-4
date: Apr 13 2018 - 3:24 PM

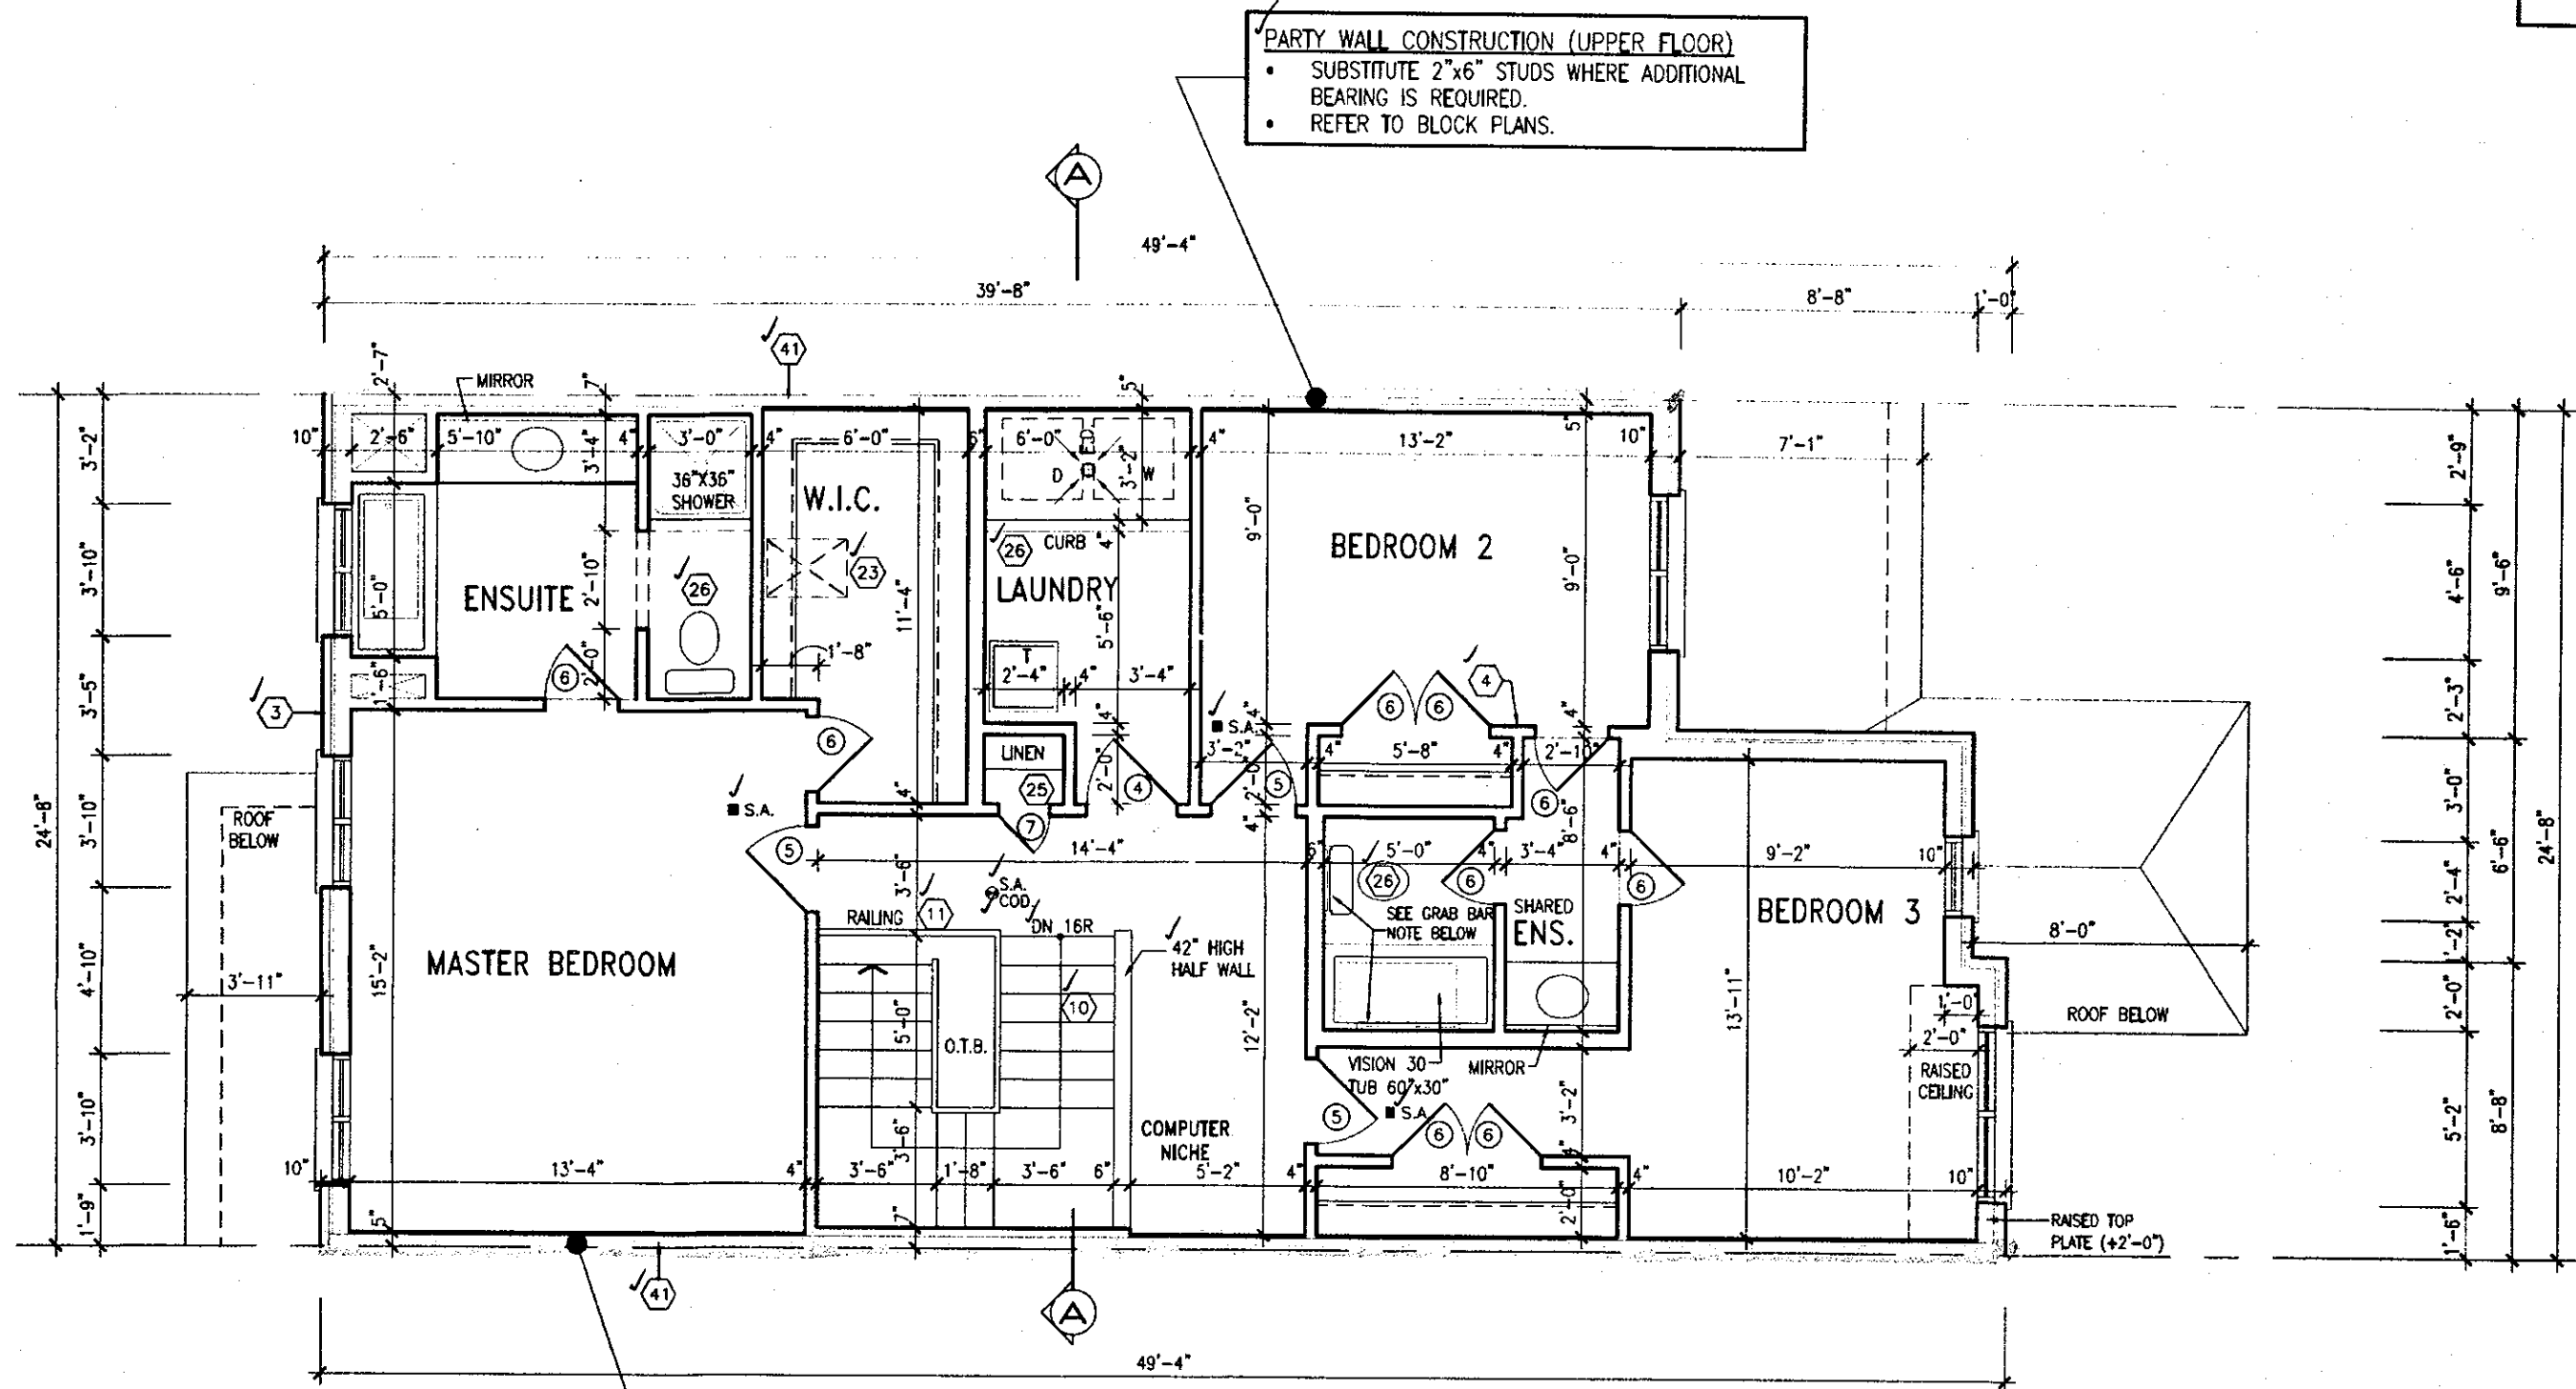

18			9																																																																																																																																																																																																																																																																																																																																																																																																																																																																																																																																																																																																																																																																																																																																																																																																																																																																																																																																																																																																																																																																																																																																																																																																																																																																																																																																																																																																																																																																																				
----	--	--	---	--	--	
2012 SF.


CITY OF HAMILTON
BUILDING DIVISION
Planning & Development Department
REVISED
MAY 22 2018
REC. BY _____ DATE _____
REF'D TO _____ DATE _____

CITY OF HAMILTON
Building Division

Permit No. 17-132133-00-R9

THESE STAMPED DRAWINGS SHALL BE AVAILABLE ON SITE
THE OWNER AND/OR CONTRACTOR SHALL COMPLY WITH
THE ONTARIO BUILDING CODE AND ALL OTHER APPLICABLE LAW


These drawings and/or specifications have been reviewed by
B. R. K. MAY 29/18
FOR CHIEF BUILDING OFFICIAL DATE

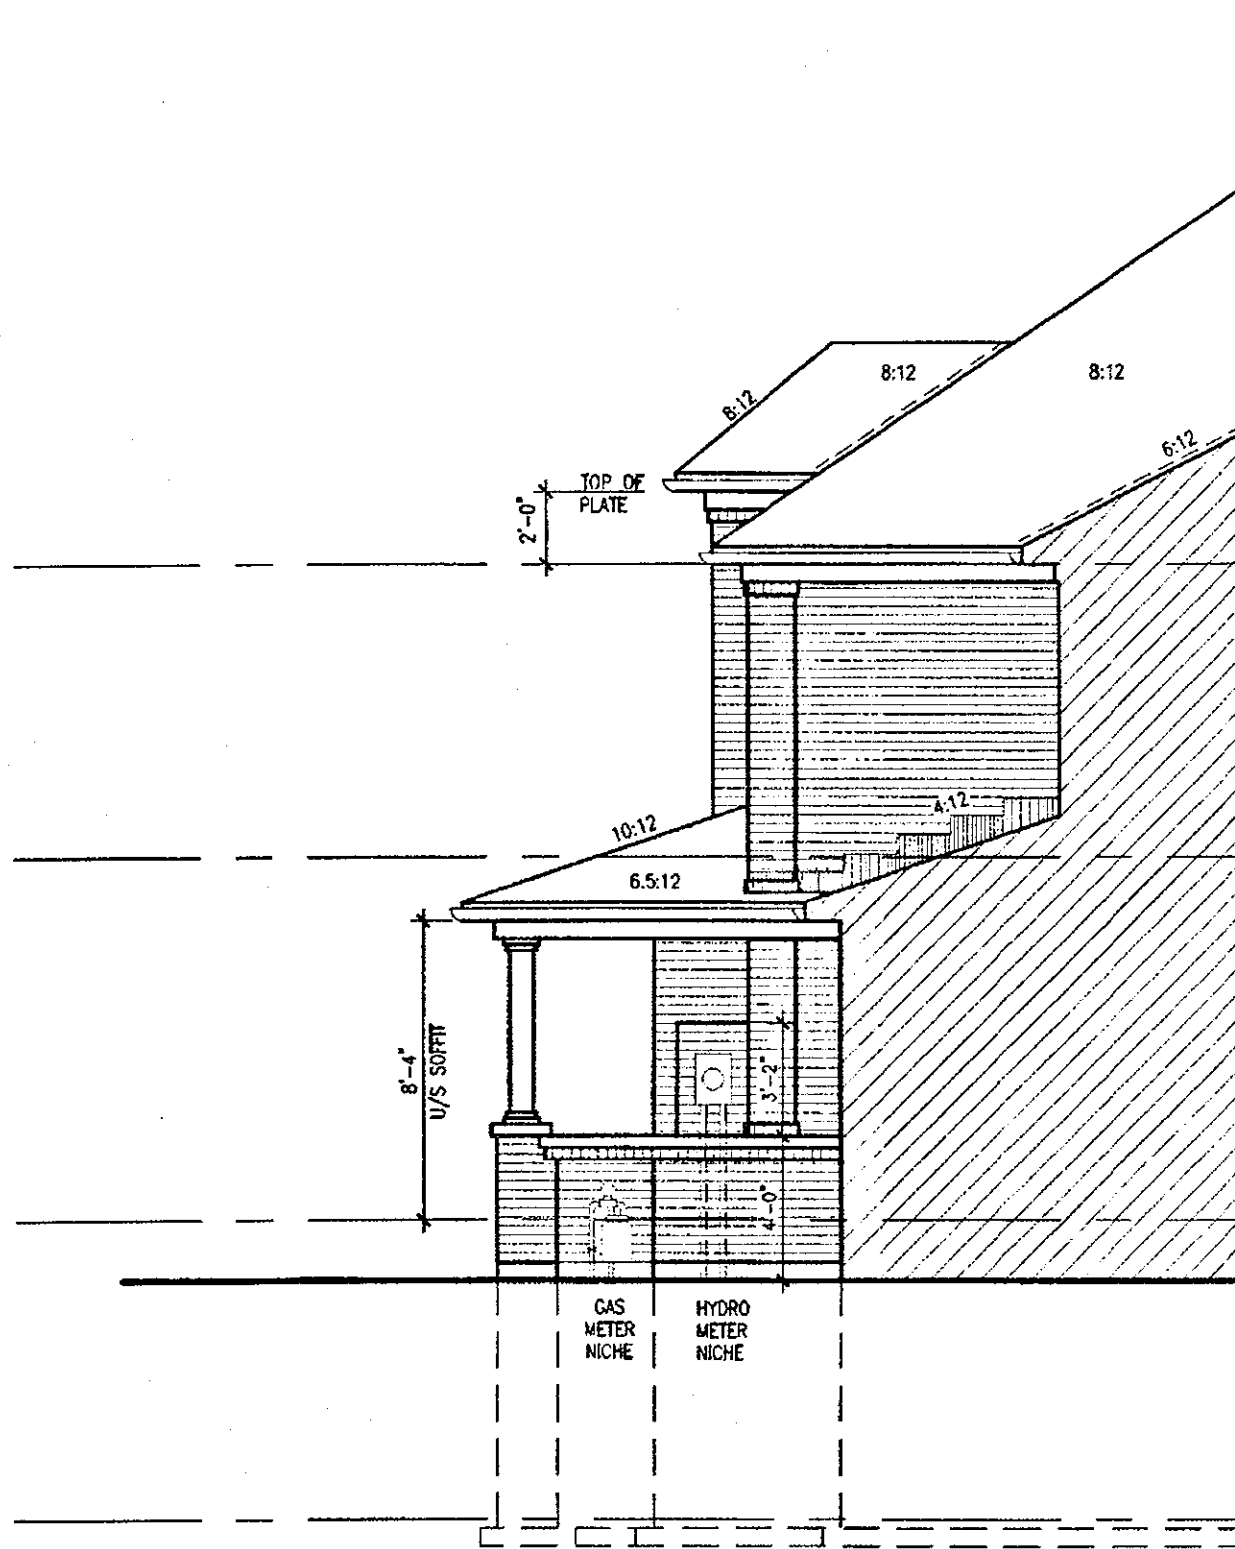

SECTION B ELEV. 2



STRUDET INC.
FOR STRUCTURE ONLY

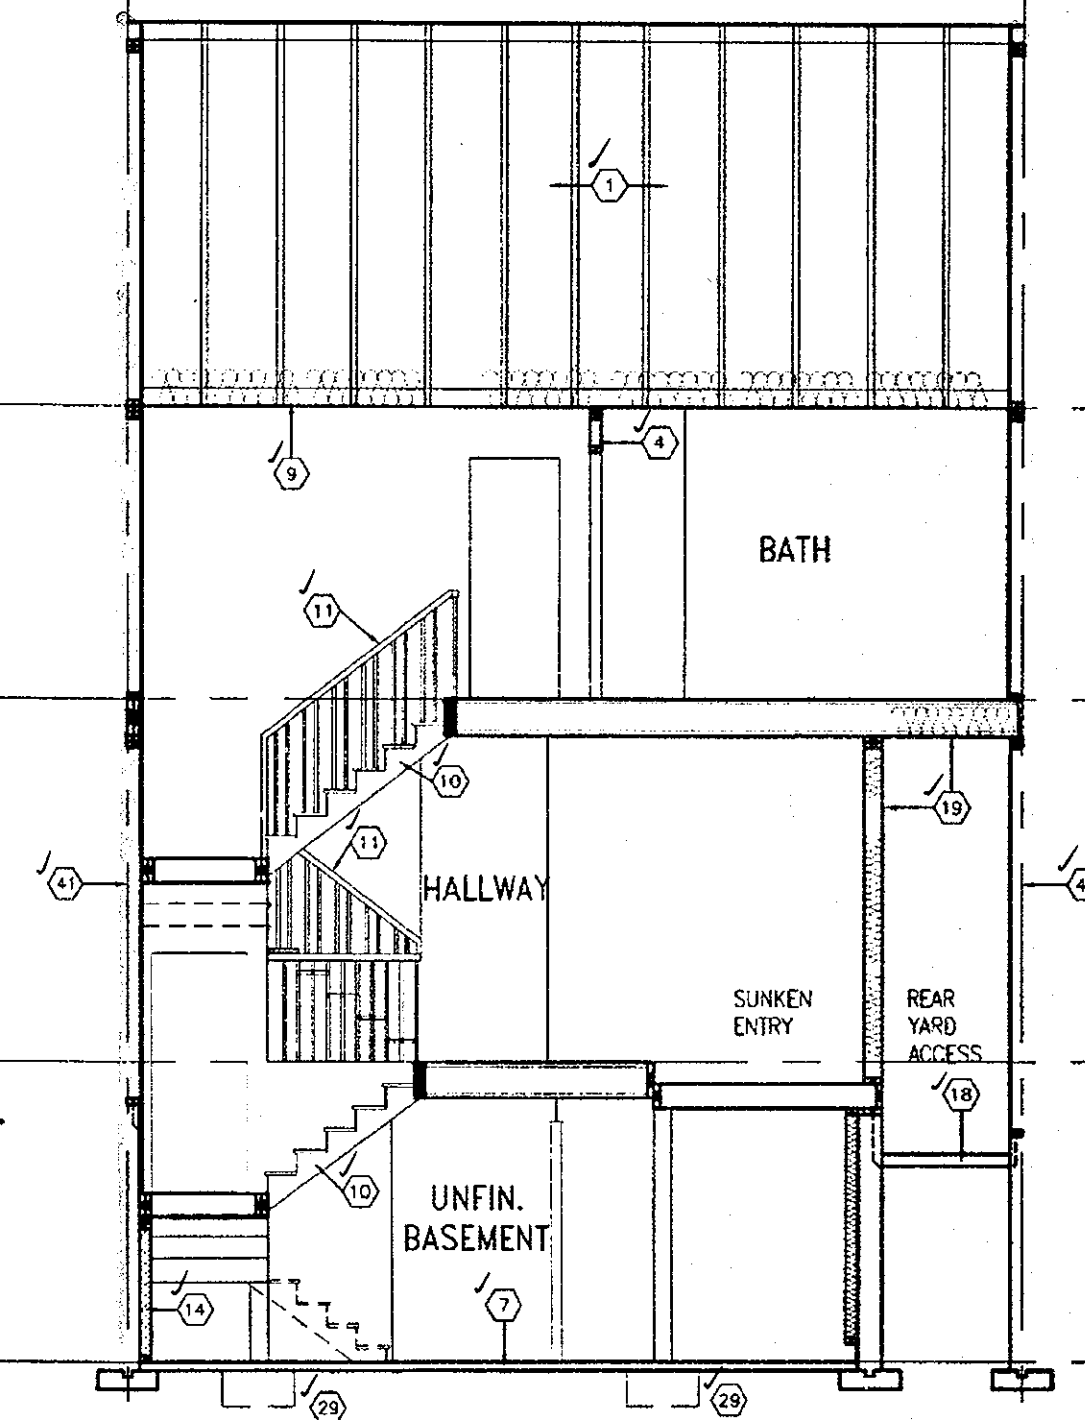

SECTION A-A ELEV. 2

APR 17 2018

HIGHGROVE 4 COMPLIANCE PACKAGE 'A1'

It is the builder's complete responsibility to ensure that all plans submitted for approval fully comply with the Architectural Guidelines and all applicable regulations and requirements including zoning provisions and any provisions in the subdivision agreement. The Control Architect is not responsible in any way for examining or approving site (lotting) plans or working drawings with respect to any zoning or building code or permit matter or that any house can be properly built or located on its lot.

This is to certify that these plans comply with the applicable Architectural Design Guidelines approved by the City of HAMILTON.

18		9	REVISED.	APR. 13/18	CW	The undersigned has reviewed and takes responsibility for this design and has the qualifications and meets the requirements set out in the Ontario Building Code to be a Designer. qualification information Richard Vink 24 <i>R Vink</i> signature name registration information VA3 Design Inc. 47 Contractor must verify all dimensions on the job and report any discrepancy to the Designer before proceeding with the work. All drawings and specifications are instruments of service and the property of the Designer which must be retained at the completion of the work. Drawings are not to be scaled.	
17		8	REVISED PER CITY COMMENTS REISSUED.	FEB. 15/18	CW		
16		7	REVISED ISSUED FOR PERMIT.	SEP. 28/17	CW		
15		6	ISSUED FOR PRICING.	AUG. 23/17	CW		
14		5	STUCCO REPLACED.	JUL. 05/17	CW		
13		4	REVISED AS PER CLIENT COMMENTS	JUN. 21/17	WT		
12		3	CHANGED JOIST DEPTH/ FLOOR HEIGHTS	JUN. 13/17	CW		
11		2	REVISED PER CLIENT COMMENTS.	APR. 28/17	CW		
10		1	PRELIMINARY REVIEW.	APR. 12/17	CW		
9							
no.	description	date	by	no.	description	date	by

VA3
DESIGN
255 Consumers Rd Suite 120
Toronto ON M2J 1R4
416.630.2255 / 416.630.4782
va3design.com

Greenpark.

Project name
RUSSELL GARDENS PH.2 municipality
WATERDOWN, ON.

HIGHGROVE 4

Project no.
16036
Date
APRIL 2017
Drawn by
WT
checked by
CW
Scale
3/16" = 1'-0"
Section
SECTION A-A ELEV. '2'
File name
16036-HIGHGROVE-4
Drawing no.
A6a

All drawings, specifications, related documents and design are the copyright property of VA3 DESIGN. Reproduction of this property in whole or in part is strictly prohibited without VA3 DESIGN's written permission.

2012 SF.

It is the builder's complete responsibility to ensure that all plans submitted for approval fully comply with the Architectural Guidelines and all applicable regulations and requirements including zoning provisions and any provisions in the subdivision agreement. The Control Architect is not responsible in any way for examining or approving site (lotting) plans or working drawings with respect to any zoning or building code or permit matter or that any house can be properly built or located on its lot.

This is to certify that these plans comply with the applicable Architectural Design Guidelines approved by the City of Hamilton.

JOHN G. WILLIAMS LTD., ARCHITECT
ARCHITECTURAL CONTROL REVIEW
AND APPROVAL
APPROVED BY:
DATE: Apr 20 2018
This stamp certifies compliance with the applicable Design Guidelines only and bears no further professional responsibility.

CITY OF HAMILTON
BUILDING DIVISION
Planning & Development Department
REVISED
MAY 22 2018
REC. BY: _____ DATE: _____
REF'D TO: _____ DATE: _____

WOOD DECK DETAILS
REFER TO STANDARD DETAIL PACKAGE (PAGE 6)
FOR ADDITIONAL WOOD DECK INFORMATION.

NOTE:
REFER TO STANDARD DRAWINGS FOR ADDITIONAL INFORMATION.
CITY OF HAMILTON
Building Division

Permit No. 17-138133-00-R9

THESE STAMPED DRAWINGS SHALL BE AVAILABLE ON SITE

THE OWNER AND/OR CONTRACTOR SHALL COMPLY WITH THE ONTARIO BUILDING CODE AND ALL OTHER APPLICABLE LAW

These drawings and/or specifications have been reviewed by

FOR CHIEF BUILDING OFFICIAL DATE: MAY 29/18



STRUDET INC.
FOR STRUCTURE ONLY

APR 17 2018

HIGHGROVE 4
COMPLIANCE PACKAGE 'A1'

PART. BASEMENT PLAN W.O.D
CONDITION (8R OR MORE)

PART. GROUND FLOOR PLAN
W.O.D CONDITION (8R OR MORE)

PART. BASEMENT PLAN W.O.D
CONDITION (4R TO 7R)

PART. GROUND FLOOR PLAN
W.O.D CONDITION (4R TO 7R)

VENEER CUT
WHEN VENEER CUT IS GREATER
THAN 26", A 10" POURED
CONCRETE FOUNDATION WALL IS
REQUIRED.

18				3	REVISED.	APR 13/18	GW
17				8	REVISED PER CITY COMMENTS. REISSUED.	FEB. 15/18	GW
16				7	REVISED. ISSUED FOR PERMIT.	SEP. 28/17	GW
15				6	ISSUED FOR PRICING.	AUG. 23/17	GW
14				5	STUCCO REPLACED.	JUL 05/17	GW
13				4	REVISED AS PER CLIENT COMMENTS.	JUN 21/17	WT
12				3	CHANGED JOIST DEPTH/ FLOOR HEIGHTS	JUN 13/17	GW
11				2	REVISED PER CLIENT COMMENTS.	APR. 28/17	GW
10				1	ISSUED FOR CLIENT PRELIMINARY REVIEW		
no.	Description	date	by	no.	Description	date	by

The undersigned has reviewed and takes responsibility for the design and has the qualifications and meets the requirements set out in the Ontario Building Code to be a Designer.
qualification information
Richard Vink
signature
24488
BCI
42658
name
registration information
VAS Design Inc.
Contractor must verify all dimensions on the job and report any discrepancy to the Designer before proceeding with the work. All drawings and specifications are instruments of service and the property of the Designer which must be retained at the completion of the work. Drawings are not to be scaled.

VAS
DESIGN
255 Consumers Rd Suite 126
Toronto ON M2J 1R4
416.630.2255 / 416.630.4782
vasdesign.com

Greenpark.
Project name
RUSSELL GARDENS PH.2
City
WATERDOWN, ON.
Date
APRIL 2017
checked by
GW
scale
3/16" = 1'-0"

HIGHGROVE 4
Project no.
16036
drawing no.
A7
16036-HIGHGROVE-4
Rev
16036-HIGHGROVE-4.dwg - Fri - Apr 13 2018 - 2:24 PM

All drawings, specifications, related documents and design are the copyright property of VAS DESIGN. Reproduction of this property in whole or in part is strictly prohibited without VAS DESIGN's written permission.

