


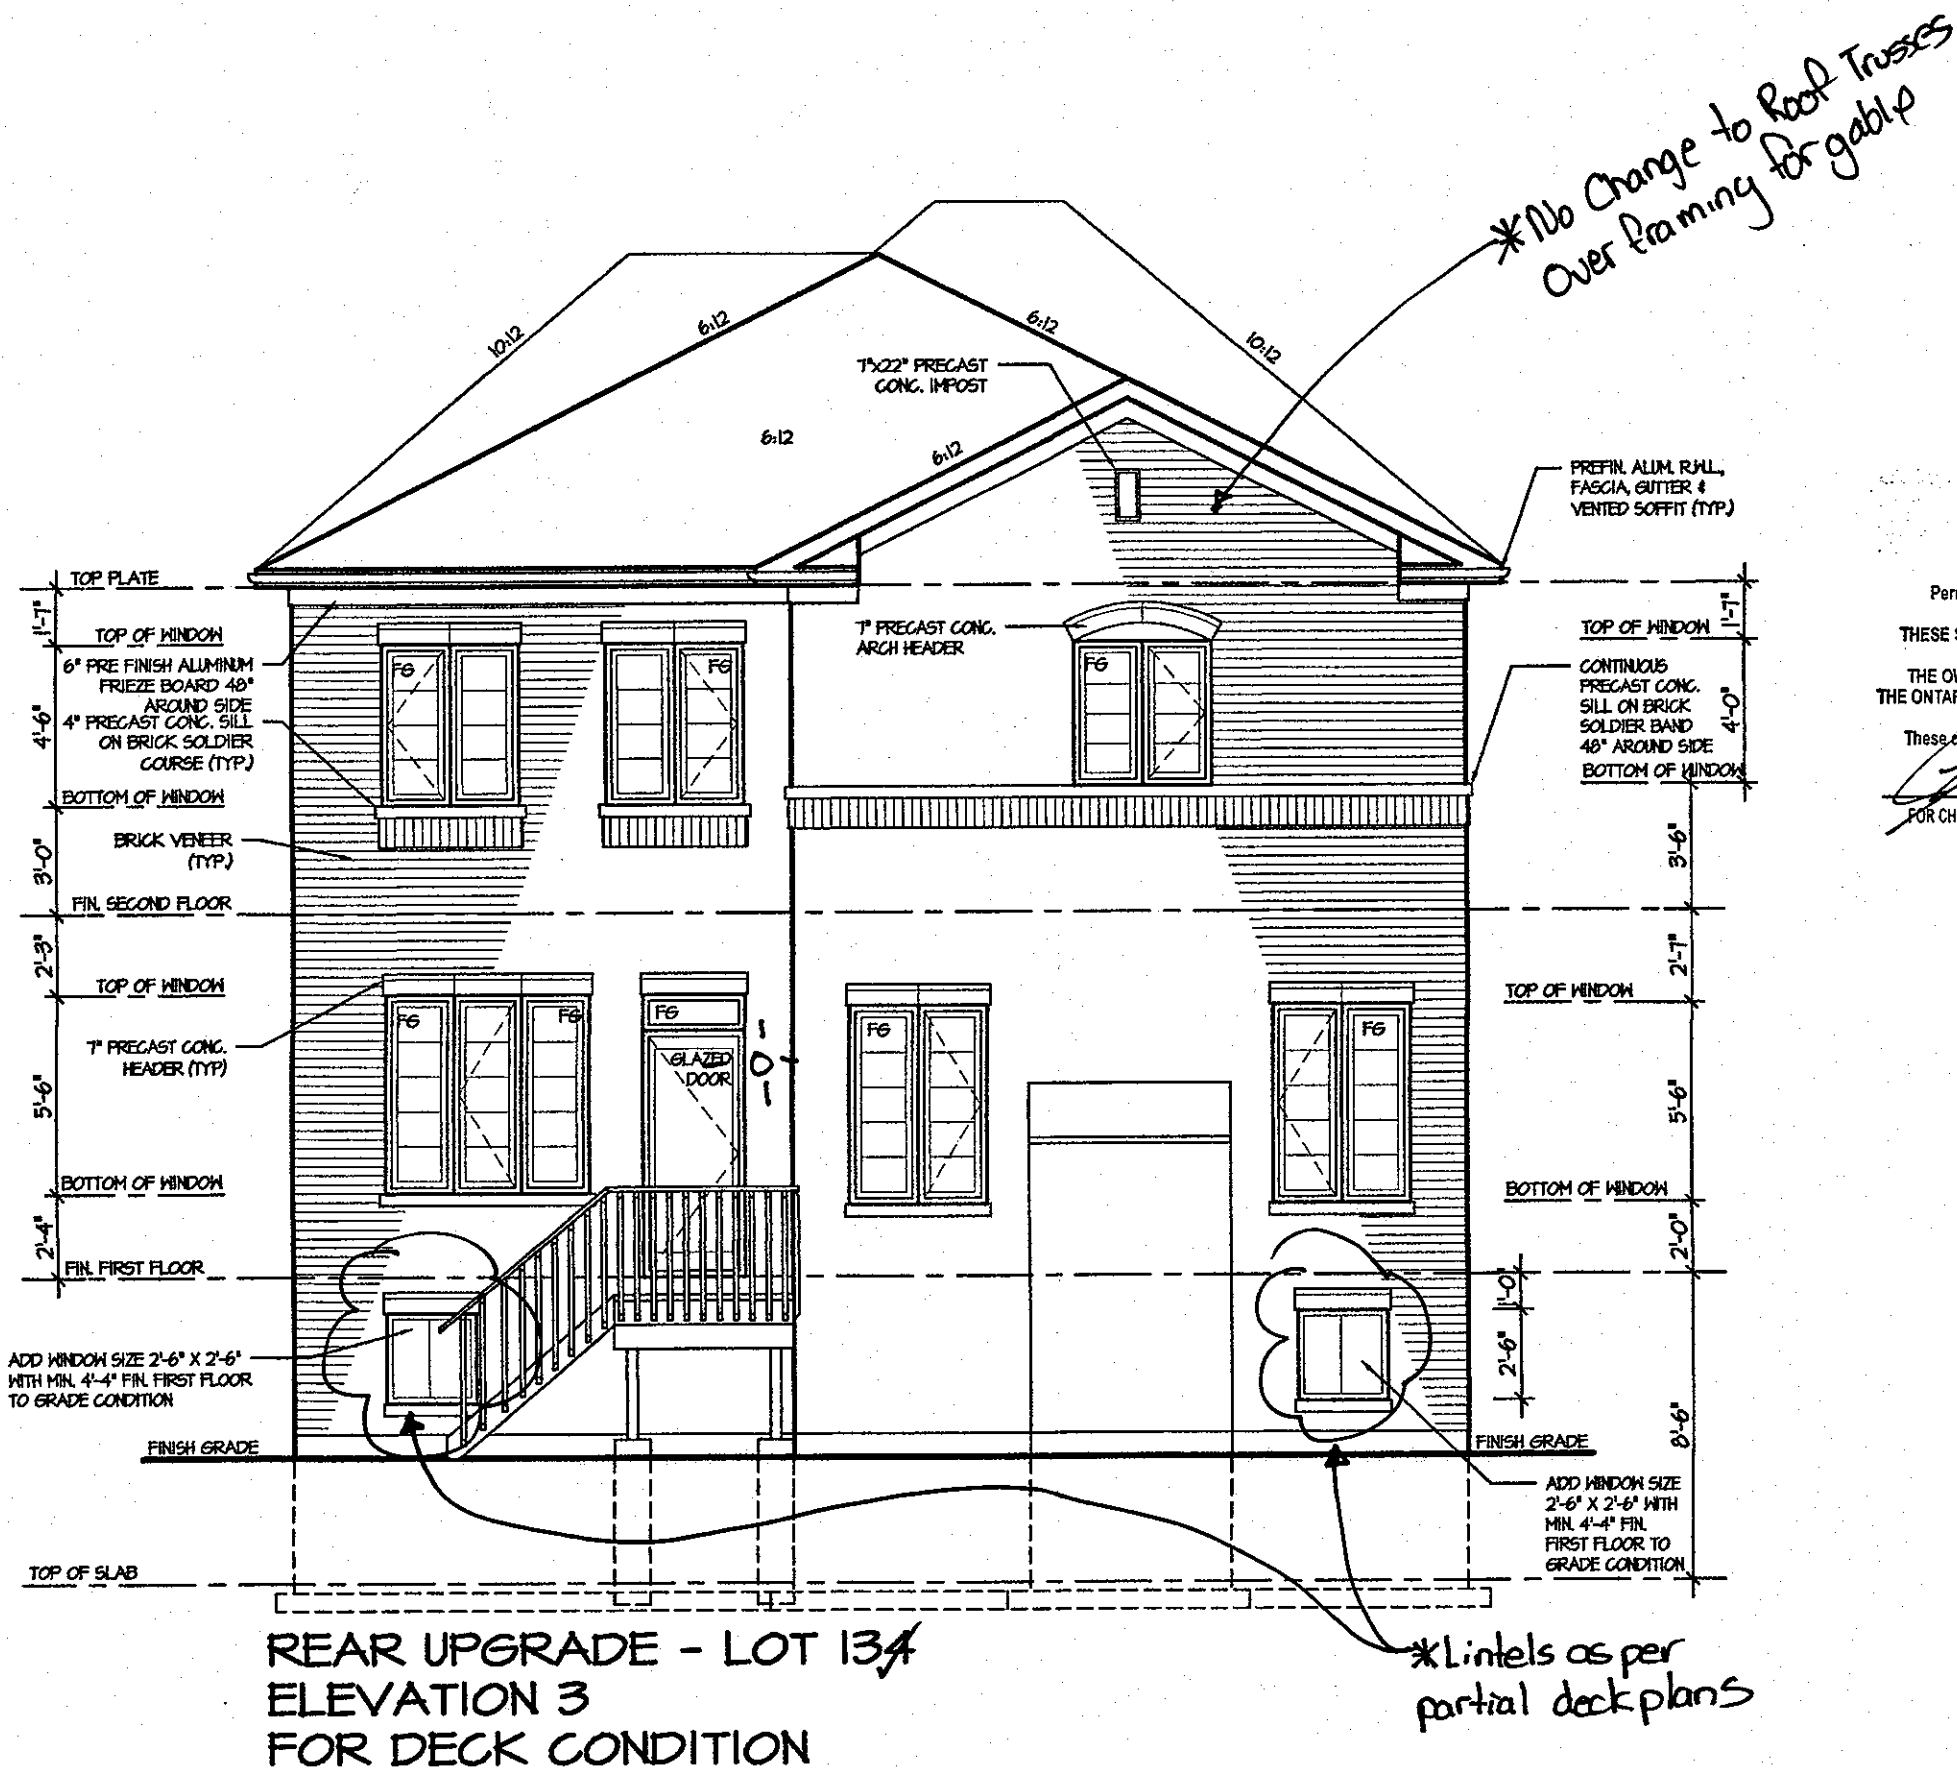

CITY OF HAMILTON
Building Division

Permit No. **18-131371**

THESE STAMPED DRAWINGS SHALL BE AVAILABLE ON SITE
THE OWNER AND/OR CONTRACTOR SHALL COMPLY WITH
THE ONTARIO BUILDING CODE AND ALL OTHER APPLICABLE LAW

These drawings and/or specifications have been reviewed by
[Signature] **Aug. 28/18**
FOR CHIEF BUILDING OFFICIAL DATE

COPY

CITY OF HAMILTON BUILDING DIVISION Planning & Development Department	
AUG 15 2018	
REC BY _____	DATE _____
REF'D TO CB	DATE _____

It is the builder's complete responsibility to ensure that all plans submitted for approval fully comply with the Architectural Guidelines and all applicable regulations and requirements including zoning provisions and any provisions in the subdivision agreement. The Control Architect is not responsible in any way for examining or approving site (lotting) plans or working drawings with respect to any zoning or building code or permit matter or that any house can be properly built or located on its lot.

This is to certify that these plans comply with the applicable Architectural Design Guidelines approved by the City of HAMILTON

JOHN G. WILLIAMS LTD., ARCHITECT
ARCHITECTURAL CONTROL REVIEW
AND APPROVAL
APPROVED BY: *[Signature]*
DATE: **AUG 13, 2018**
This stamp certifies compliance with the applicable Design Guidelines only and bears no further professional responsibility.

ROSEWOOD 6
COMPLIANCE PACKAGE "A1"

5.		The undersigned has reviewed and takes responsibility for this design, and has the qualifications and meets the requirements set out in the Ontario Building Code to be a designer. QUALIFICATION INFORMATION Required unless design is exempt under Division C, Subsection 3.2.5 of the building code VIKAS GAJJAR 28770 NAME SIGNATURE BCIN	REGION DESIGN INC. 8700 DUFFERIN ST. CONCORD, ONTARIO L4K 4S8 P (416) 736-4096 F (905) 680-0746	REGION DESIGN INC.	SHEET TITLE WALK OUT BASEMNT UPGRADE ELEV. 3 LOT 134	CONTRACTOR SHALL CHECK ALL DIMENSIONS AND ELEVATIONS BEFORE COMMENCING WITH WORK AND REPORT ANY DISCREPANCIES TO THE DESIGNER. PRINTS ARE NOT TO BE SCALED.		Greenpark™ PROJECT NAME RUSSEL GARDENS II	
4.					SCALE 3/16"=1'-0"	BY V.G.	AREA 3,030		PAGE No. 9-6C
3.					DATE MAY 2017	TYPE	PROJECT 03-13-08		
2.									
1.	ISSUED FOR REVIEW				MAY 2017				
REVISIONS									