



CONSTRUCTION SUMMARY

Mountainview Heights (G) - Russell Gardens Building Ltd.

RECEIVED OCT 26 2018

PURCHASERS: MAZEN AL TAHER and ASMAA MOUSTAFA LOTF

TEL:

LOT / PHASE 118 / 2	REG. PLAN # 62M-1238	HOUSE TYPE Rosewood 11 Elev 2		
------------------------	-------------------------	----------------------------------	--	--

ELECTRICAL

1 - PLUG - ELECTRICAL PLUG - TO BE INSTALLED OVER FIREPLACE 24Oct18 Note:	
1 - 200 AMP ELECTRICAL SERVICE 24Oct18 Note:	
1 - LIGHT AND SWITCH - NO FIXTURE INCLUDED - LIVING ROOM 24Oct18 Note:	




PROMOTIONAL

1 - PARTIAL REDEMPTION OF PROMOTIONAL PACKAGE \$18,760.00 BALANCE FORWARD TO BE USED AT A LATER DATE. ORIGINAL PROMOTIONAL PACKAGE OF \$20,000.00AS PER SCHEDULE PE 24Oct18 Note:	
---	--

EXTRAS AS PER OFFER

The Purchaser acknowledges that the Purchase Price is inclusive of all credits and promotional packages available at the time of purchase. Worksheet Note:	
The Vendor agrees that notwithstanding any other term or provision in this Agreement included in the Purchase Price and in addition to those items detailed in Schedule GP to the Agreement of Purchase and Sale, the Purchaser is entitled to a credit of Two Worksheet Note:	

This Document is Extremely Time Sensitive - Printed 24 Oct 18 at 15:51

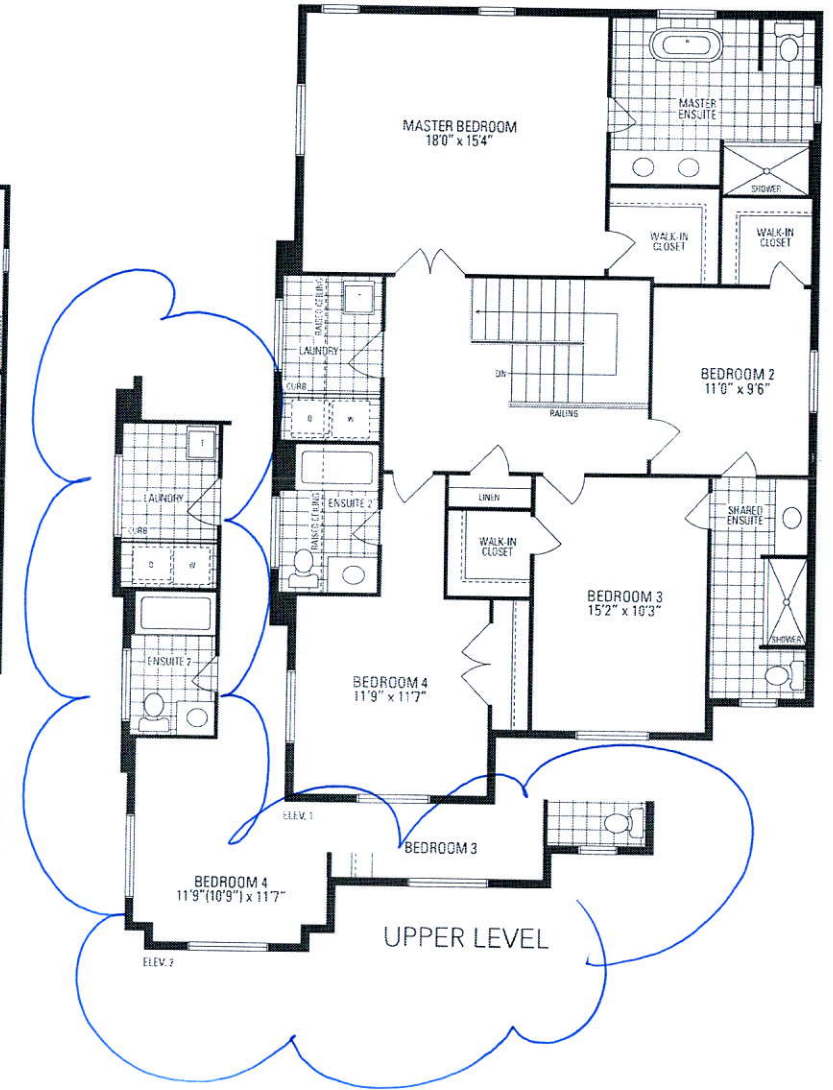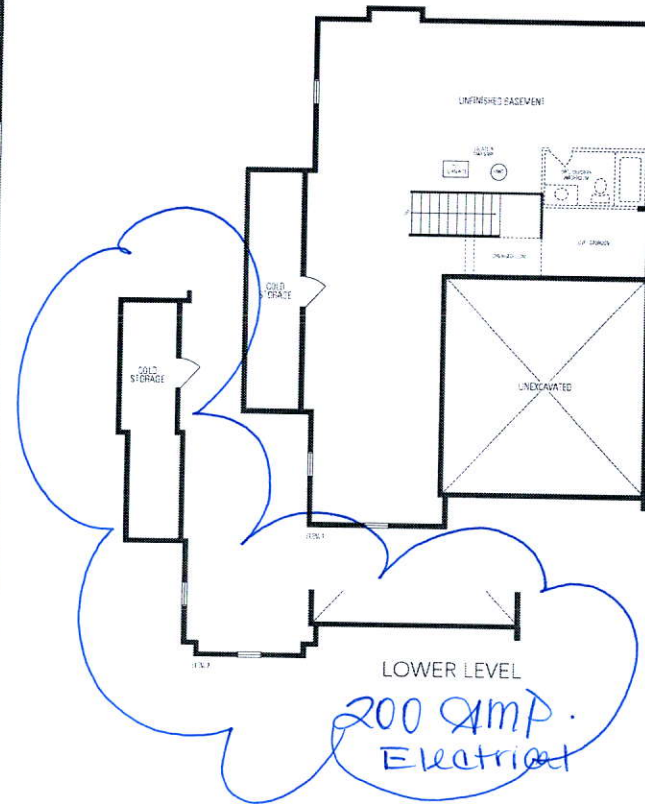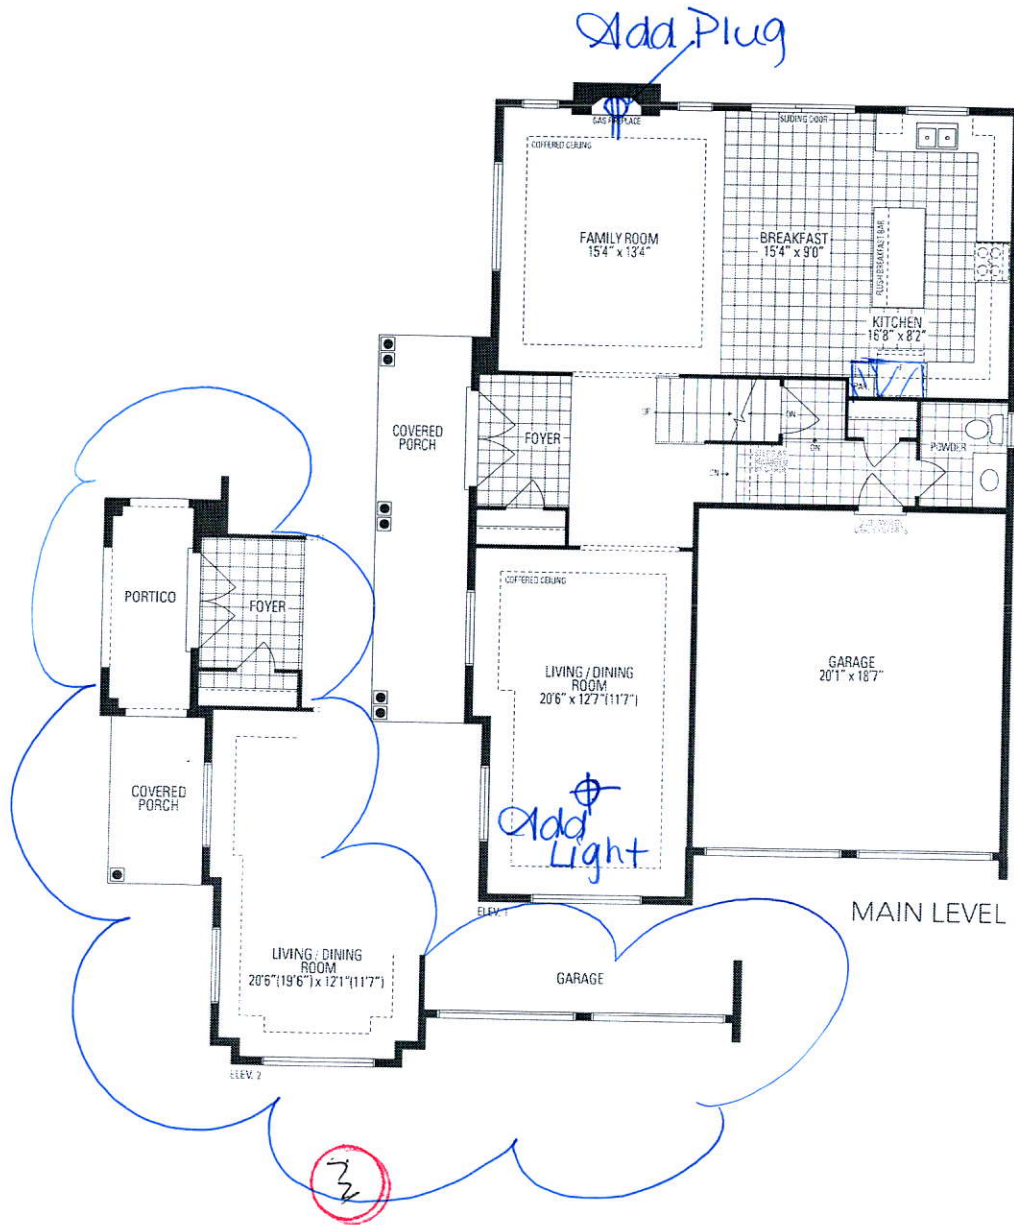

ROSEWOOD 11 2,617 SQ.FT.

Orientation of home may be reversed and purchaser agrees to accept the same. Steps and porches may vary at any exterior entrance ways due to grading variance. Actual usable floor space may vary from the stated floor area. All renderings are artist's concept. Dimensions, specifications and architectural detailing subject to minor modifications. Final location of sump pump is based on site conditions. Footline and adjoining model types may vary due to siting. E. & O.E. LEC Rosewood 11 • Copyright Sept. 2017