



CONSTRUCTION SUMMARY

Mountainview Heights (G) - Russell Gardens Building Ltd.

PURCHASERS: SAFIA GOURANI and GOURANI AZIM

TEL: RES.: 508-287-9365

LOT / PHASE 173 / 2	REG. PLAN # 62M-1238	HOUSE TYPE Rosewood 1 Elev 3		
------------------------	-------------------------	---------------------------------	--	--

ELECTRICAL

1 - PLUG - ELECTRICAL PLUG - TO BE INSTALLED OVER FIREPLACE 09Nov18 Note:	
1 - ABOVE KITCHEN ISLAND - ADD LIGHT AND SWITCH - NO FIXTURE INCLUDED 09Nov18 Note:	
1 - STANDARD DINING ROOM LIGHT TO BE CENTERED BETWEEN LIVING AND DINING ROOM 09Nov18 Note:	
1 - 200 AMP ELECTRICAL SERVICE 09Nov18 Note:	
1 - PLUG - ELECTRICAL PLUG - FOR MICROWAVE SHELF 09Nov18 Note:	

PLUMBING

1 - TOE TESTER - ADD TOE TESTER TO SHOWER 09Nov18 Note: MASTER ENSUITE BATHROOM	
--	--




PROMOTIONAL

1 - PARTIAL REDEMPTION OF PROMOTIONAL PACKAGE \$8385.00 BALANCE FORWARD TO BE USED AT A LATER DATE. ORIGINAL PROMOTIONAL PACKAGE OF \$10,000.00 AS PER SCHEDULE PE 09Nov18 Note:	
--	--

This Document is Extremely Time Sensitive - Printed 9 Nov 18 at 11:06

RECEIVED NOV 09 2018

penpark
GROUP

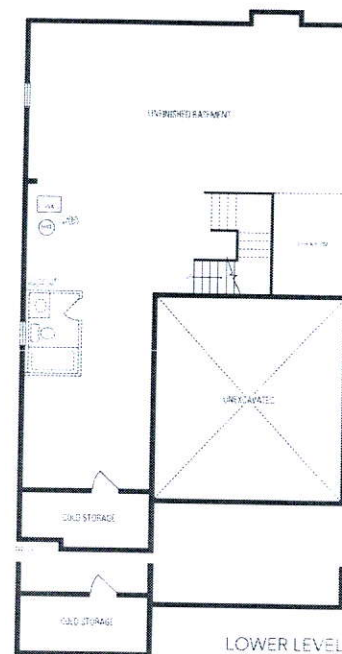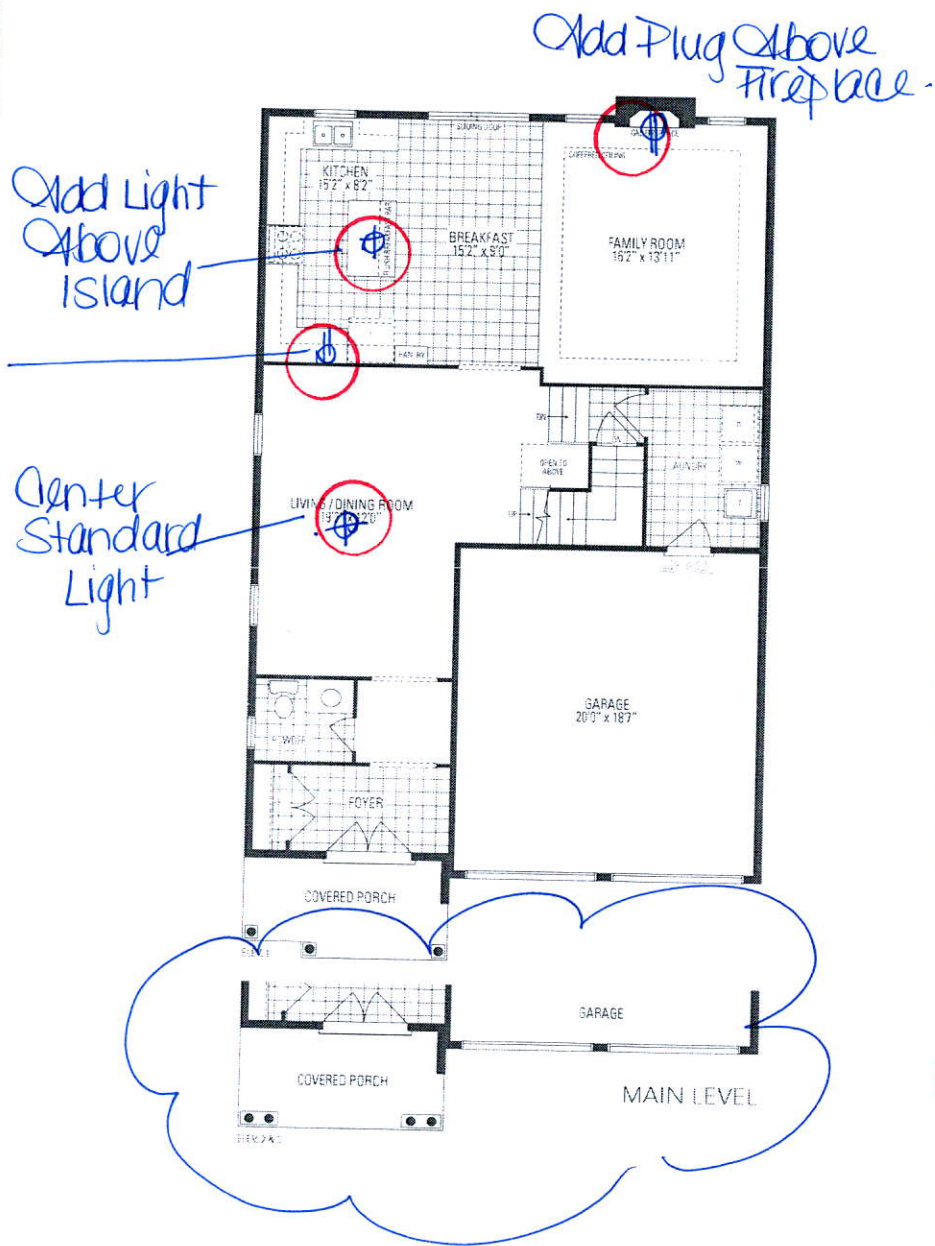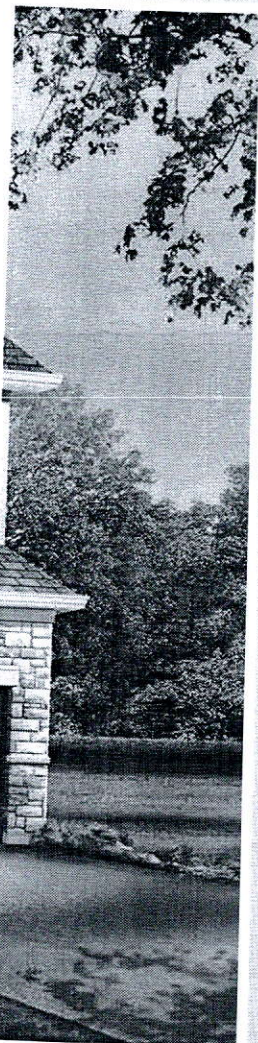



200 AMP Electrical.

SG GA

ROSEWOOD 1

2,655 sq.ft. includes 12 sq.ft. of open area

Add Tol Tester

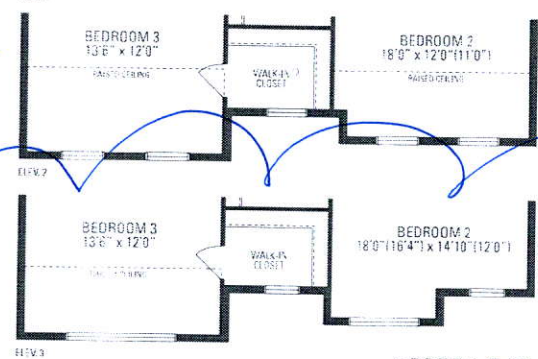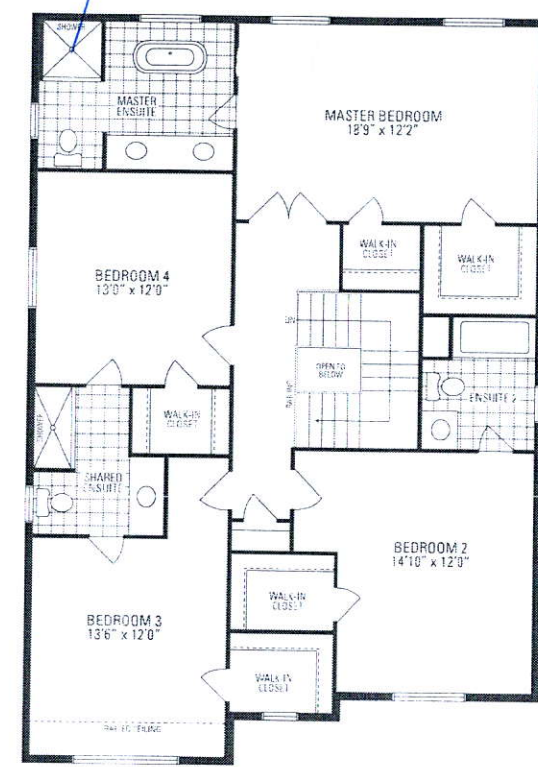

Orientation of home may be reversed and purchaser agrees to accept the same. Steps and porches may vary at any exterior entrance ways due to grading variance. Actual usable floor space may vary from the stated floor area. All renderings are artist's concept. Dimensions, specifications and architectural details subject to minor modifications. Final for about of sump pump is based on site conditions. Roofing and plumbing model types may vary due to pricing. E. & G.E. LEC Rosewood 1 • Copyright Sept. 2017