



## CONSTRUCTION SUMMARY

Mountainview Heights (G) - Russell Gardens Building Ltd.

PURCHASERS: KEVIN RAMBHAJUE and ROSHINY SELVARAJAH

TEL: RES.: 647-761-3880

LOT / PHASE	REG. PLAN #	HOUSE TYPE		
163 / 2	62M-1238	Rosewood 1 Elev 1		

**ELECTRICAL**

1 - PLUG - ELECTRICAL PLUG - TO BE INSTALLED OVER FIREPLACE

13Nov18 Note:

1 - RELOCATE STANDARD KITCHEN LIGHT TO BE CENTERED OVER ISLAND

13Nov18 Note:

**MIRRORS AND GLASS**

1 - FRAMELESS GLASS SHOWER ENCLOSURE

13Nov18 Note: MASTER ENSUITE BATHROOM

**PROMOTIONAL**1 - PARTIAL REDEMPTION OF PROMOTIONAL PACKAGE \$16,825.00 BALANCE FORWARD TO BE USED AT A LATER DATE.  
ORIGINAL PROMOTIONAL PACKAGE OF \$20,000.00 AS PER SCHEDULE PE

13Nov18 Note:

**EXTRAS AS PER OFFER**


The Vendor agrees that notwithstanding any other term or provision in this Agreement included in the Purchase Price and in addition to those items detailed in Schedule GP to the Agreement of Purchase and Sale, the Purchaser is entitled to a credit of TWE

Worksheet Note:

The Purchaser acknowledges that the Purchase Price is inclusive of all credits and promotional packages available at the time of purchase.



Worksheet Note:

This Document is Extremely Time Sensitive - Printed 13 Nov 18 at 11:44


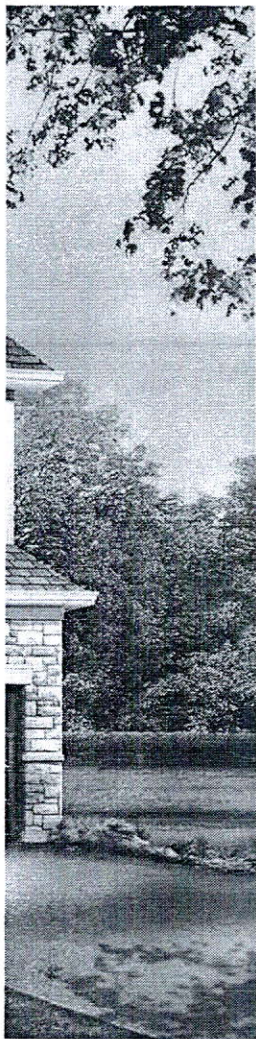


Relocate  
Std.  
Light

Add Plug  
Above  
Fireplace

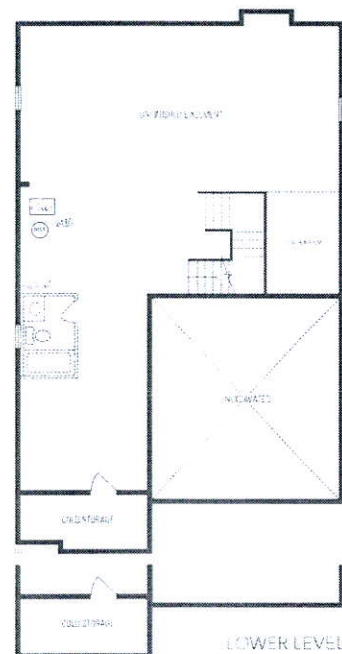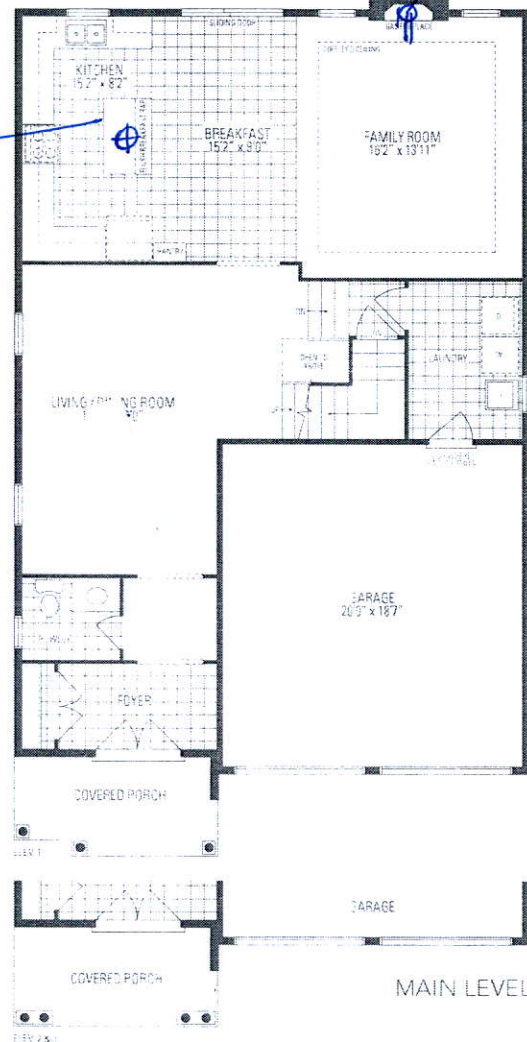

Frameless Glass Enclosure.  
Delete Wall

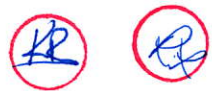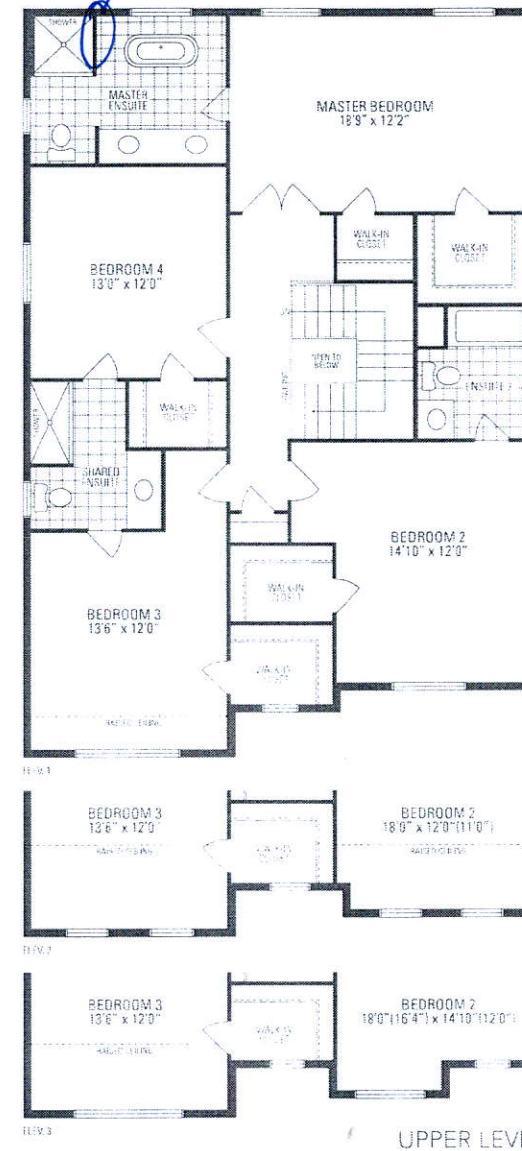

# ROSEWOOD 1

2,655 sq.ft. includes 12 sq.ft. of open area

Orientation of home may be revised and purchaser agrees to accept the same. Stairs and porches may vary at any exterior entrance ways due to grading variations. Actual usable floor space may vary from the stated floor area. All measurements are artist's concept. Dimensions, specifications and architectural detailing is subject to manufacturer's specifications. Final location of sump pump is based on site conditions. Routine and adjusting model types may vary due to change. © 2017 Greenpark Group LLC. Rosewood 1 • Copyright Sept. 2017