

CONSTRUCTION SUMMARY

Mountainview Heights (G) - Russell Gardens Building Ltd.



PURCHASERS: SAFIA GOURANI and GOURANI AZIM

TEL: RES.: 508-287-9365

LOT / PHASE	REG. PLAN #	HOUSE TYPE		
173 / 2	62M-1238	Rosewood 1 Elev 3		

CABINETS

1 - KITCHEN - DELETE CABINETS ABOVE STOVE - VENDOR WILL SUPPLY 6 INCH VENT AS PER CONSTRUCTION SPECIFICATIONS AND VENT MAY NOT BE IN THE APPROPRIATE LOCATION FOR INSTALLATION OF PURCHASER SUPPLIED VENT - PURCHASER TO SUPPLY OWN FAN AFTER CLOSING (TEMP. FAN MA

02Jan19 Note:

NEW

RECEIVED JAN 03 2019

CABINETS ACCESSORIES

1 - PANTRY UNIT UPGRADE - TO GO FROM 300MM TO 600MM DEEP - PRICE IS PER FOOT - STANDARD

13Dec18 Note:

1 - KITCHEN CABINETS UPPER - FULL DEPTH ABOVE FRIDGE - WITH GABLES - 600MM - PRICE IS EACH - STANDARD

13Dec18 Note:

1 - KITCHEN CABINETS UPPER - MICROWAVE SHELF STANDARD - 700MM WIDE - STANDARD

13Dec18 Note:

CERAMIC TILE

1 - TILE - UPGRADE 1 FLOOR TILE - - KITCHEN

13Dec18 Note:

CONSTRUCTION

1 - MASTER BEDROOM ENTRANCE & CLOSET RE-DESIGN FEE - SEE SKETCH - IF CONSTRUCTION PERMITS

13Dec18 Note:

1 - DELETE BULK HEADS IN KITCHEN IF CONSTRUCTION PERMITS

13Dec18 Note:

ELECTRICAL

1 - PLUG - ELECTRICAL PLUG - TO BE INSTALLED OVER FIREPLACE

09Nov18 Note:

1 - ABOVE KITCHEN ISLAND - ADD LIGHT AND SWITCH - NO FIXTURE INCLUDED

09Nov18 Note:

1 - STANDARD DINING ROOM LIGHT TO BE CENTERED BETWEEN LIVING AND DINING ROOM

09Nov18 Note:

1 - 200 AMP ELECTRICAL SERVICE

09Nov18 Note:

1 - PLUG - ELECTRICAL PLUG - FOR MICROWAVE SHELF

09Nov18 Note:

FIREPLACE AND ACCESSORIES

1 - GAS LINE ROUGH-IN FOR STOVE (INCLUDES ELECTRICAL OUTLET) - FIRST FLOOR

13Dec18 Note:

HARDWOOD FLOORING

1 - LAMINATE -UPGRADE TO CLASSIC PLUS SERIES IN LIEU OF STANDARD LAMINATE

13Dec18 Note:

1 - HARDWOOD - GROUP A SERIES 5 INCH - IN LIEU OF 2 1/4 INCH NATURAL RED OAK - - FIRST FLOOR COMPLETE

13Dec18 Note:

PLUMBING

1 - WATER LINE FOR FRIDGE - ROUGH-IN ONLY

02Jan19 Note:

NEW

RECEIVED JAN 03 2019

CONSTRUCTION SUMMARY

Mountainview Heights (G) - Russell Gardens Building Ltd.

PURCHASERS: SAFIA GOURANI and GOURANI AZIM

TEL: RES.: 508-287-9365

LOT / PHASE	REG. PLAN #	HOUSE TYPE		
173 / 2	62M-1238	Rosewood 1 Elev 3		
I - VIEIRA 2 PC TOILET #4792BOV/4791BOVU (UNLINED TANK) WITH SMOOTH CLOSE TOILET SEAT 13Dec18 Note: MASTER ENSUITE BATHROOM				
I - TOE TESTER - ADD TOE TESTER TO SHOWER 09Nov18 Note: MASTER ENSUITE BATHROOM				

PROMOTIONAL

I - LESS BALANCE OF CREDIT FROM PURCHASER EXTRA SHEET IN OFFER 13Dec18 Note:	
I - PARTIAL REDEMPTION OF PROMOTIONAL PACKAGE \$8385.00 BALANCE FORWARD TO BE USED AT A LATER DATE. ORIGINAL PROMOTIONAL PACKAGE OF \$10,000.00 AS PER SCHEDULE PE 09Nov18 Note:	

STAIRS AND RAILINGS

I - ***INSERT - STAINED HANDRAIL, TREADS, RISERS AND STRINGER EXCLUDING PICKETS (FOR IRON PICKETS) - STANDARD STAIRCASE - PRICE IS PER SET*** 02Jan19 Note:	NEW RECEIVED JAN 03 2019
I - ***DELETE - STAINED STAIRS, RAILING AND PICKETS - STANDARD STAIRCASE - PRICE IS PER SET*** 02Jan19 Note:	
I - STAIRCASE - EUROLINE 1 IRON PICKETS - BLACK 02Jan19 Note:	NEW RECEIVED JAN 03 2019
I - STAINED STAIRS, RAILING AND PICKETS - STANDARD STAIRCASE - PRICE IS PER SET 13Dec18 Note:	Revised

This Document is Extremely Time Sensitive - Printed 3 Jan 19 at 16:15

Greenpark.

INTERIOR COLOUR SCHEME

Purchasers: SAFIA GOURANI & GOURANI AZIM
 Telephone Res. / Bus: (508) 287-9365 /
 Decor Advisor: Candace Forza
 Lock Date: 2-Jan-19

Property: 173
 Project: Russell Gardens Building Ltd.
 Model and Elevation: Rosewood 1 Elev 3
 Plan #: 62M-1238

Layout Changes: Yes No Sketch Attached: Yes No Exterior Colour Scheme:

1. Cabinetry

	Style and Colour	Hardware
Kitchen / Breakfast	CONTINENTAL W350XZ4	2004
Laundry Room	ELISSE	Standard
Powder Room	EVEREST WHITE	2004
Master Ensuite Bathroom	EVEREST WHITE	2002
Ensuite Bath - Bedroom 2	HASTING CHOCOLATE	1001
Ensuite Bath - Bedroom 3/4	MONACO W350XZ4	2004
	N/A	N/A
	N/A	N/A
	N/A	N/A
	N/A	N/A

Appliances:

Dishwasher Cabinet

Stove Opening

Fridge Opening

Built In Appliances Yes No

Closed Open

41" Upper Cabinets Yes No

Slide In Stove Yes No

Please NOTE: Standard Cabinet Height is 30"

36"

NOTE: If not specified, opening will be set to builder's standard opening of approximately 30" width

NOTE: If not specified, opening will be set to builder's standard opening of approximately 37" width x 74" height

** Refer to Construction Summary

2. Counters

	Counter	Edge
Kitchen / Breakfast	LAMINATE-PORTICO MARBLE 7735-58	
Laundry Room	N/A	
Powder Room	LAMINATE-PORTICO MARBLE 7735-58	
Master Ensuite Bathroom	LAMINATE-CARRARA BIANCO 6696-46	
Ensuite Bath - Bedroom 2	LAMINATE-PALOMA POLAR 6698-46	
Ensuite Bath - Bedroom 3/4	LAMINATE-WHITE CARRARA 4924-38	
	N/A	
	N/A	
	N/A	

** Refer to Construction Summary

Initials: SG

Greenpark

INTERIOR COLOUR SCHEME

Purchasers: SAFIA GOURANI & GOURANI AZIM
 Telephone Res. / Bus: (508) 287-9365 /
 Decor Advisor: Candace Forza
 Lock Date: 2-Jan-19

Property: 173
 Project: Russell Gardens Building Ltd.
 Model and Elevation: Rosewood 1 Elev 3
 Plan #: 62M-1238

13-Dec-18

3. Ceramic Flooring

		At a 45	Threshold-If App.
Entrance Vestibule	TILE-ESSENZE GRIGIO-13X13	<input type="checkbox"/>	metal strip where applicable
Main Hall	STRIP	<input type="checkbox"/>	
Kitchen / Breakfast	TILE-FM45GL001S GLOSSY WHITE-18X18	<input type="checkbox"/>	
Laundry Room	TILE-ESSENZE GRIGIO-13X13	<input type="checkbox"/>	
Powder Room	TILE-ESSENZE GRIGIO-13X13	<input type="checkbox"/>	
Master Ensuite Bathroom	TILE-RAINBOW LIGHT GREY-13X13	<input type="checkbox"/>	
Ensuite Bath - Bedroom 2	TILE-RAINBOW WHITE-13X13	<input type="checkbox"/>	
Ensuite Bath - Bedroom 3/4	TILE-ESSENZE GRIGIO-13X13	<input type="checkbox"/>	
LOWER LANDING	TILE-ESSENZE GRIGIO-13X13	<input type="checkbox"/>	
	N/A	<input type="checkbox"/>	
	N/A	<input type="checkbox"/>	

** Refer to Construction Summary

4. Ceramic Wall Tile

	Selection	Describe
Master Ensuite Bathroom		
Tub Deck Wall	N/A	
Tub Deck	N/A	
Tub Deck Skirt	N/A	
Shower Stall	TILE-LUC. CONCEPT NEVE-8X16	
Bathtub Enclosure Walls	N/A	
Ensuite Bath - Bedroom 2	TILE-LUC. BLANC GROENLANDIA-8X16	
Ensuite Bath - Bedroom 3/4	TILE-SAT.BLANC GROENLANDIA-8X16	
LOWER LANDING	N/A	
	N/A	
	N/A	
	N/A	
Kitchen Backsplash	N/A	

** Refer to Construction Summary - STANDARD GROUT THROUGHOUT UNLESS SPECIFIED

5. Plumbing Fixtures

All Bathrooms

White

N/A

N/A

Whirlpool

N/A Yes No

Dishwasher Rough-In Yes No

Waterline for Fridge Yes No

** Refer to Construction Summary

SG

6. Trim Carpentry

Interior Doors	CLASSIQUE
Interior Trim	As Per Construction Specifications
Door Handles	As Per Construction Specifications
Exterior Front Door Handle	As Per Construction Specifications

** Refer to Construction Summary

Initials: SG

Greenpark.

INTERIOR COLOUR SCHEME

Purchasers: SAFIA GOURANI & GOURANI AZIM
Telephone Res. / Bus: (508) 287-9365 /
Decor Advisor: Candace Forza
Lock Date: 2-Jan-19

Property: 173
Project: Russell Gardens Building Ltd.
Model and Elevation: Rosewood 1 Elev 3
Plan #: 62M-1238

13-Dec-18

Plan #: 62M-1238

7. Other Flooring

Main Hall	STRIP-MIRAGE-ADMIRATION-ENGINEERED-MAPLE-CASHMERE-PLATINUM-5"	
Living Room	STRIP-MIRAGE-ADMIRATION-ENGINEERED-MAPLE-CASHMERE-PLATINUM-5"	
Dining Room	STRIP-MIRAGE-ADMIRATION-ENGINEERED-MAPLE-CASHMERE-PLATINUM-5"	
Family Room	STRIP-MIRAGE-ADMIRATION-ENGINEERED-MAPLE-CASHMERE-PLATINUM-5"	
Den / Library / Study	N/A	
Basement Landing (If Applies)	N/A	
Lower Landing (If Applies)	TILE	
Upper Landing	STRIP-MIRAGE-ADMIRATION-ENGINEERED-MAPLE-CASHMERE-PLATINUM-5"	
Upper Hall	LAMINATE-CLASSIC PLUS - HAVANA OAK DRK SAW CUT QS-UM1657	
Master Bedroom	LAMINATE-CLASSIC PLUS - HAVANA OAK DRK SAW CUT QS-UM1657	
Bedroom #2	LAMINATE-CLASSIC PLUS - HAVANA OAK DRK SAW CUT QS-UM1657	
Bedroom #3	LAMINATE-CLASSIC PLUS - HAVANA OAK DRK SAW CUT QS-UM1657	
Bedroom #4	LAMINATE-CLASSIC PLUS - HAVANA OAK DRK SAW CUT QS-UM1657	
Bedroom #5	N/A	
	N/A	
	N/A	
	N/A	
Underpad	Type	Area
	N/A	N/A

** Refer to Construction Summary

8. Railings and Pickets

Railing Type	AS PER CONSTRUCTION SPECIFICATIONS	Colour	MIRAGE PLATINUM
Picket Type	EUROLINE 1	Colour	BLACK
Stringer / Riser	AS PER CONSTRUCTION SPECIFICATIONS	Colour	MIRAGE PLATINUM
Treads	AS PER CONSTRUCTION SPECIFICATIONS	Colour	MIRAGE PLATINUM
Red Oak Stairs with Semi Gloss Finish			
		<input checked="" type="radio"/> Yes	<input type="radio"/> No

** Refer to Construction Summary

9. Wall Paint Flat Finish

Main & Upper Hall	22 WARM GREY	Master Bedroom	22 WARM GREY
Living Room	22 WARM GREY	Bedroom #2	22 WARM GREY
Dining Room	22 WARM GREY	Bedroom #3	22 WARM GREY
Kitchen / Breakfast	22 WARM GREY	Bedroom #4	22 WARM GREY
Family Room	22 WARM GREY	Bedroom #5	N/A
Powder Room	22 WARM GREY	Master Ensuite	22 WARM GREY
Laundry Room	22 WARM GREY	Ensuite Bath - Bedroom 2	22 WARM GREY
Den/Library	N/A	Ensuite Bath - Bedroom 3/4	22 WARM GREY
Trim Paint-Semi Gloss	BIRCH WHITE		N/A
	N/A		N/A
	N/A		N/A
	N/A		N/A

Smooth Ceilings First Floor Yes No

** Refer to Construction Summary

SG

Initials: _____

Greenpark.

INTERIOR COLOUR SCHEME

Purchasers: SAFIA GOURANI & GOURANI AZIM
Telephone Res. / Bus: (508) 287-9365 /
Decor Advisor: Candace Forza
Lock Date: 2-Jan-19

Property: 173
Project: Russell Gardens Building Ltd.
Model and Elevation: Rosewood 1 Elev 3
Plan #: 62M-1238

13-Dec-18

10. Plaster Mouldings and Medallions

Entrance Vestibule	N/A	N/A	Kitchen/Breakfast	N/A	N/A
Main Hall	N/A	N/A	Den/Library	N/A	N/A
Living Room	N/A	N/A	Lower Landing	N/A	N/A
Dining Room	N/A	N/A			
Family Room	N/A	N/A			

** Refer to Construction Summary

11. Fireplace

	Living Room			Family Room			Other Room - Specify		
	Purchased	As Per Plan	N/A	Purchased	As Per Plan	N/A	Purchased	As Per Plan	N/A
Fireplace Type	<input type="radio"/>	<input type="radio"/>	<input checked="" type="radio"/>	<input type="radio"/>	<input checked="" type="radio"/>	<input type="radio"/>	<input type="radio"/>	<input type="radio"/>	<input checked="" type="radio"/>
Mantle Type	N/A			FLAT ON WALL			N/A		
Colour / Stain	N/A			MANTLE M1-STANDARD			N/A		
Surround	N/A			AS PER CONSTRUCTION SPECIFICATIONS			N/A		
Hearth	N/A			NERO			N/A		
	N/A			NO			N/A		

** Refer to Construction Summary

12. Heating and Air Conditioning

Air Conditioning	NO	Gas Provisions Stove	YES
Gas Provisions Dryer	NO	Gas Provisions Barbecue	NO

** Refer to Construction Summary

13. Electrical

Plugs and Switches	<input checked="" type="radio"/> White	DECOR	Above Kitchen Cabinet Light	<input type="radio"/> Yes	<input checked="" type="radio"/> No
Hood Fan	STANDARD WHITE TEMP.	SG	Below Kitchen Cabinet Light	<input type="radio"/> Yes	<input checked="" type="radio"/> No
Appliances	Built in Cooktop	Built in Oven	Gas Stove	<input checked="" type="radio"/> Yes	<input type="radio"/> No
	<input type="radio"/> Yes <input checked="" type="radio"/> No	<input type="radio"/> Yes <input checked="" type="radio"/> No	Microwave	<input type="radio"/> Yes	<input checked="" type="radio"/> No
Dishwasher Rough-in	Yes				


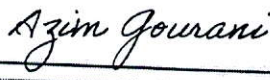
** Refer to Construction Summary


14. General Comments

** Refer to Construction Summary

Disclaimers and Notes

- Colours of all materials are as close as possible to builder's selection, but not necessarily identical due to variances in manufacturing.
- Any extras listed above are null and void unless accompanied by a separate invoice/amendment. Said invoice must be paid in full.
- The Purchaser agrees that this colour selection is final and that no changes will be permitted, unless required by the Vendor.
- The Purchaser acknowledges reading and accepting document which contains other miscellaneous disclaimers.

Signature:  Safia Abdullah Date: 1/2/2019 Signature:  Azim Gourani Date: 1/2/2019

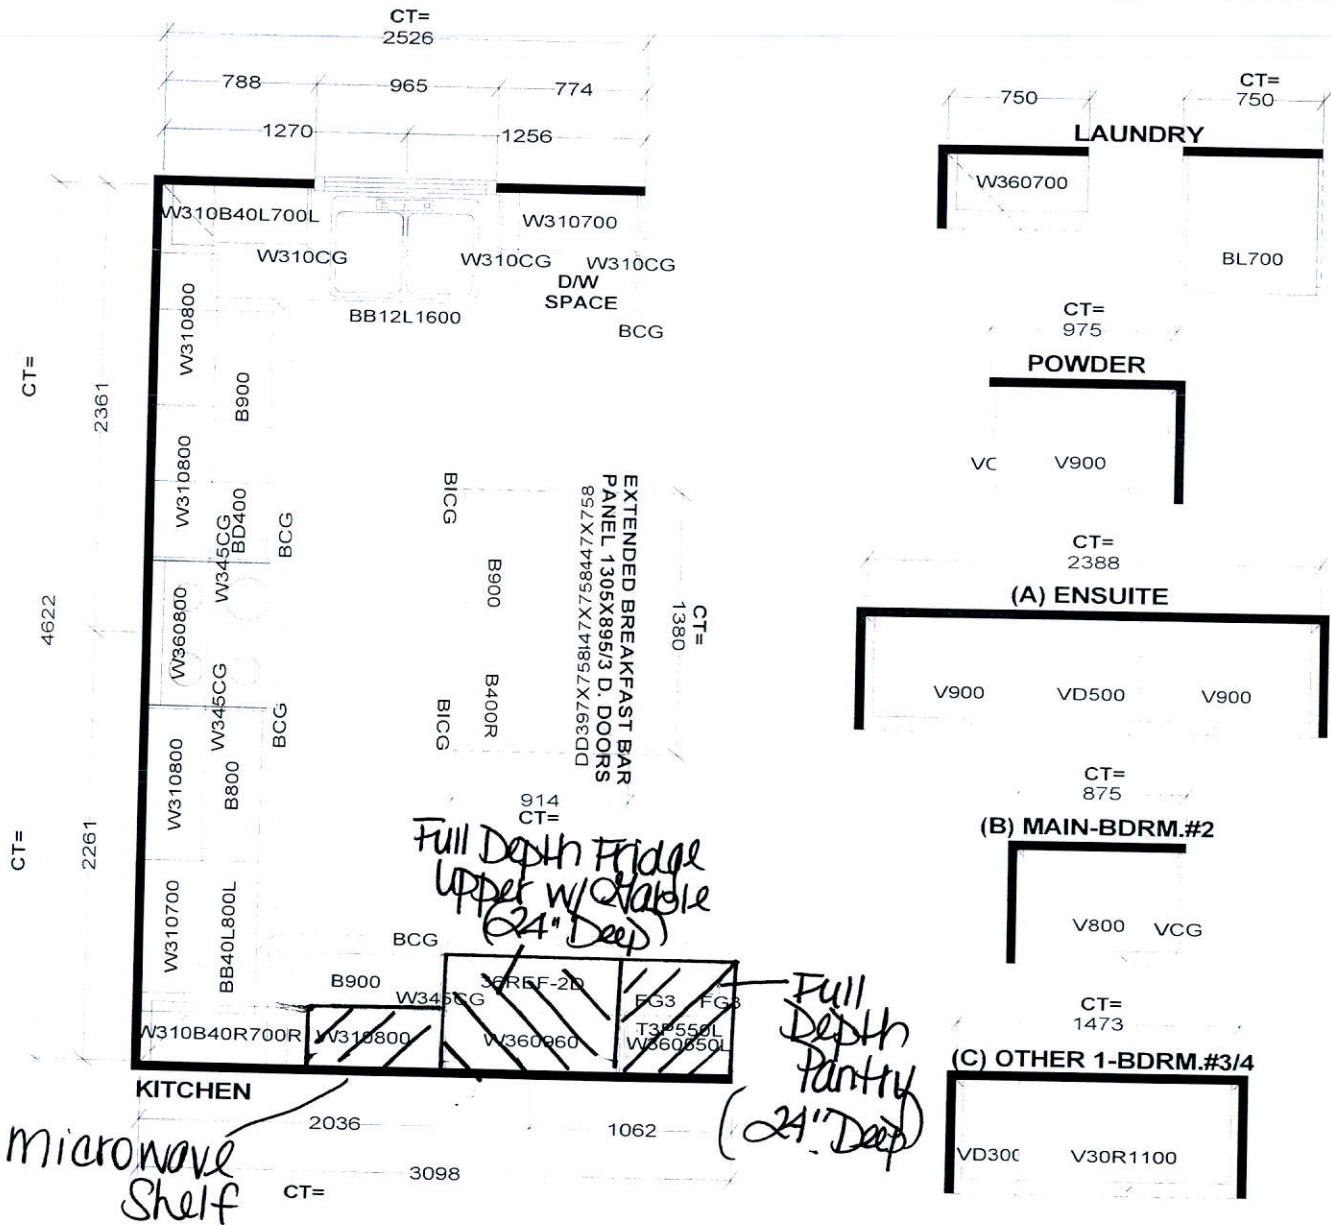

SG

AG

Selba Industries


W WIDTH W HGHT W CNT FL HGHT DWY H ST CENT 2X4 VENT BOX COVER

STANDARD FEATURES:
 1040MM HIGH UPPERS (9' Ceiling-No D/C Box)
 DUMMY DOORS
 D/W SPACE
 LAMINATE KITCHEN & VANITY COUNTERTOPS



This drawing is the intellectual property of SELBA INDUSTRIES INC. and is an original design which must not be released or copied unless applicable fee has been paid or job order placed.



JOB NUMBER:
 BUILDER: GREENPARK
 SITE NAME: RUSSEL GARDENS
 MODEL: ROSEWOOD 1X ELEV 1,2,3
 LOT #:
 DESIGNER: KS
 DATE: AUG 29 17

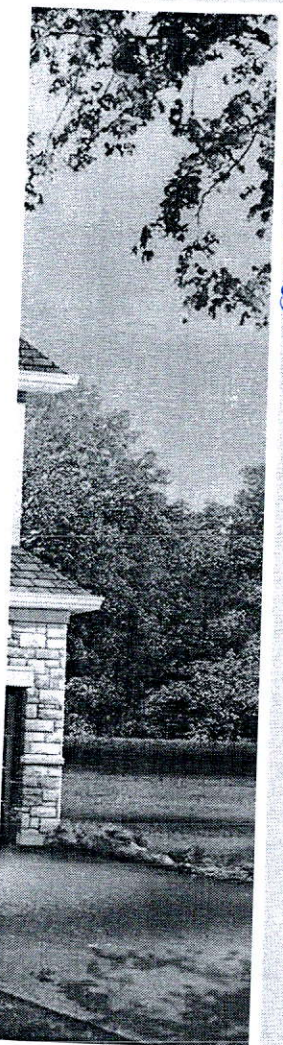

Plug for
micro
shelf.

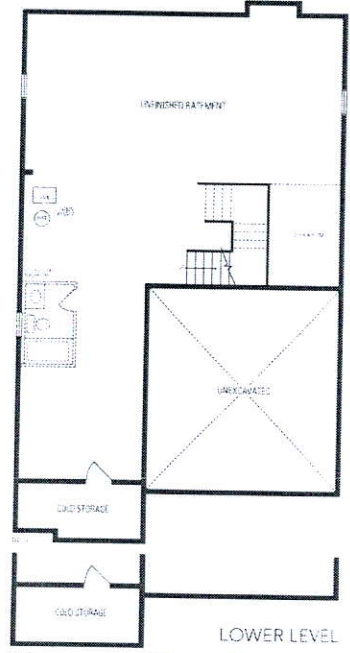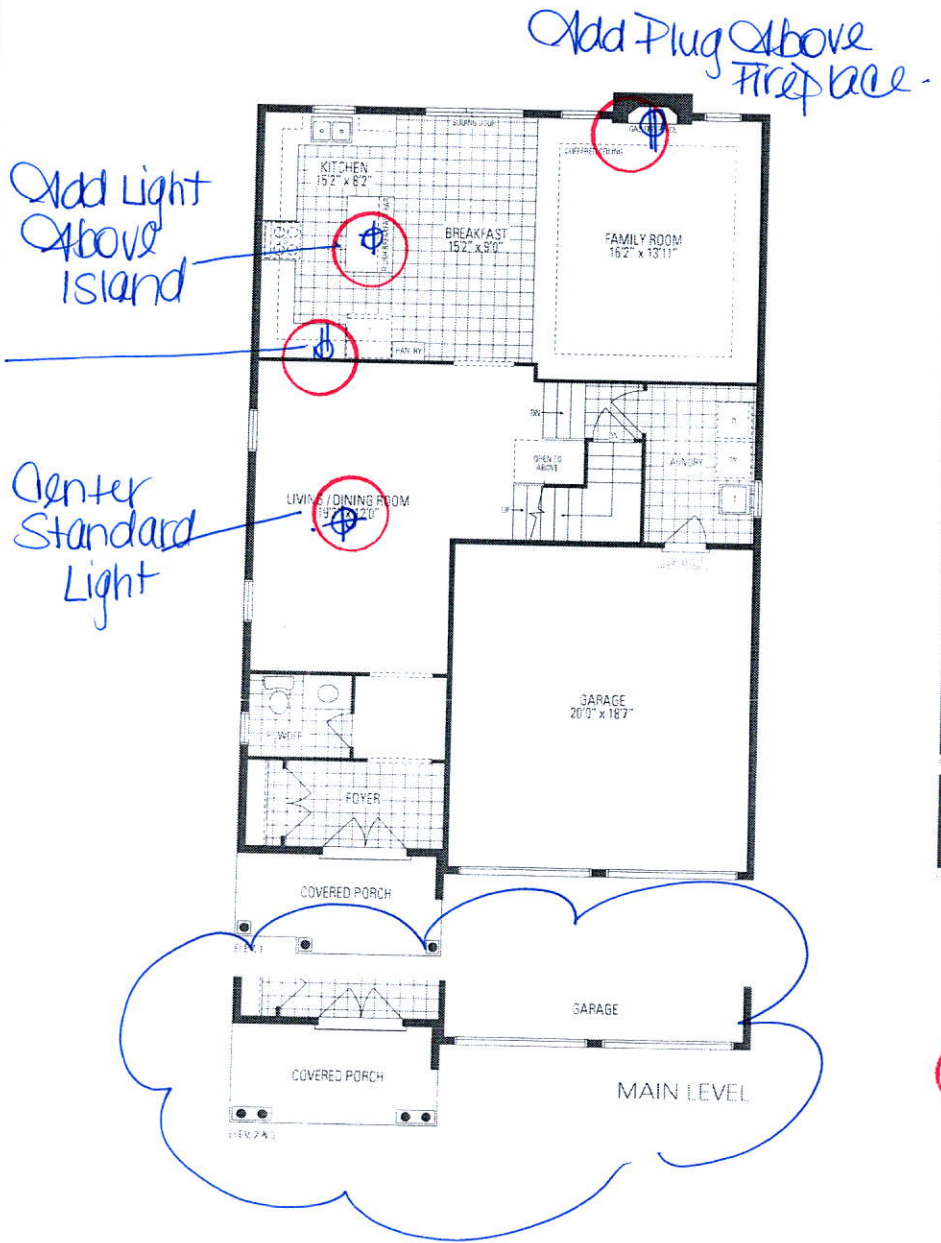

200 AMP Electrical.


SG

GA

ROSEWOOD 1

2,655 sq.ft. includes 12 sq.ft. of open area

Add Tol Tester

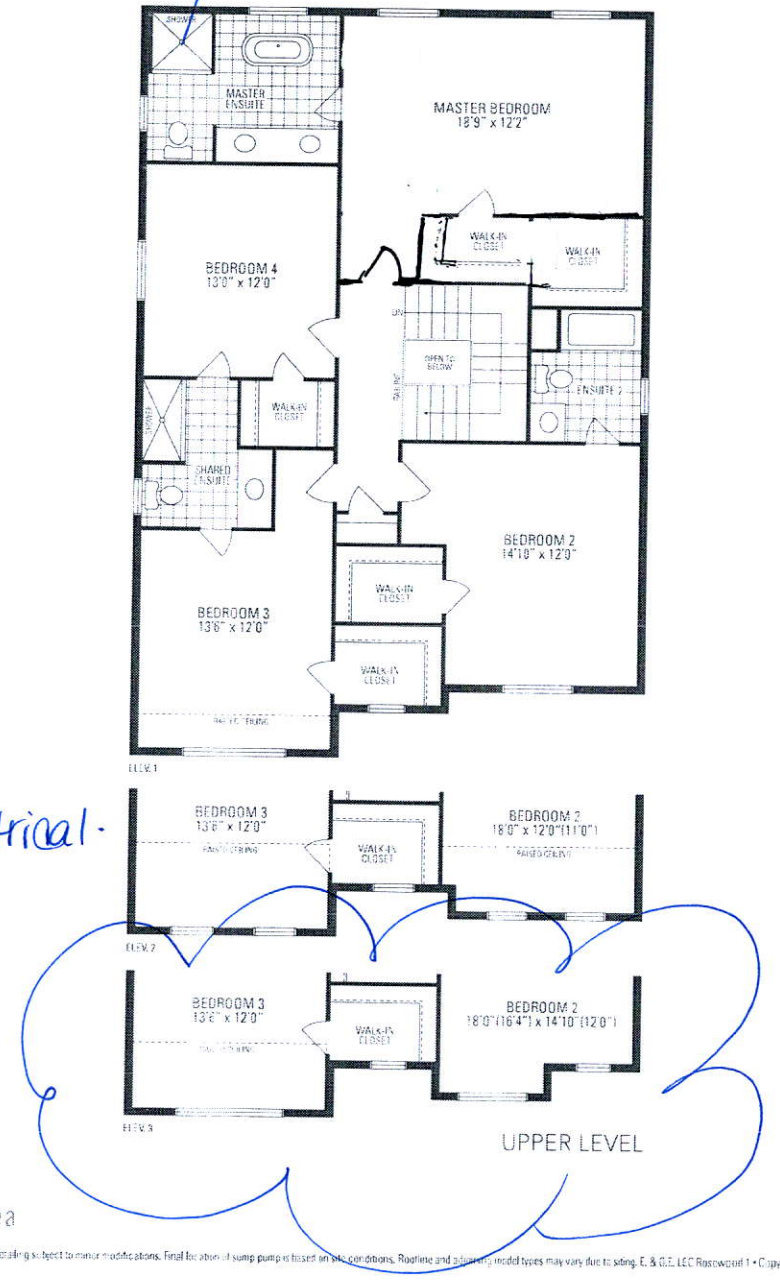

Orientation of home may be reversed and/or buyer agreed to accept the same. Steps and porches may vary at any exterior entrance ways due to grading variance. Actual usable floor space may vary from the stated floor area. All renderings are artist's concept. Dimensions, specifications and architectural detailing subject to minor modifications. Final location of sump pump is based on site conditions. Roofline and plumbing model types may vary due to pricing. E. & G.E. LLC Rosewood 1 • Copyright Sept. 2019